


*BLOCK: 5158 MODULE: 71* *WM 44 10*  
**CORNER RECORD** Document Number 2000-333  
City of UNINCORPORATED County of ORANGE, California  
Brief Legal Description CENTERLINE TIE NOTES FOR TRACT 15582, MM 771/19-22

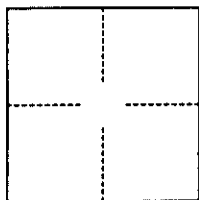

**CORNER TYPE**

Government Corner ☐ Control ☐  
Meander ☐ Property ☒  
Rancho ☐ Other ☐ Zone \_\_\_\_\_  
Date of Survey MAY 23, 2000

**COORDINATES  
(Optional)**

N \_\_\_\_\_  
E \_\_\_\_\_  
Datum \_\_\_\_\_  
Elev \_\_\_\_\_

Corner — Left as found ☐ Found and tagged ☐ Established ☒ Reestablished ☐ Rebuilt ☐

Identification and type of corner found Evidence used to identify or procedure used to establish or reestablish the corner  
A PORTION OF THE CENTERLINE TIE NOTE'S FOR THE ABOVE MENTIONED TRACT

A description of the physical condition of the monument as found and as set or reset \_\_\_\_\_

**SURVEYOR'S STATEMENT**

This Corner Record was prepared by me or under my direction in conformance with the

Land Surveyors' Act on MAY 23, 2000

Signed Tom R. McGannon R C E Number 23956


**COUNTY SURVEYOR'S STATEMENT**

This Corner Record was received 7/3 2000 and examined

and filed July 5th, 2000

Signed Robert Jelinek Title DEPUTY COUNTY SURVEYOR

County Surveyor's Comment \_\_\_\_\_

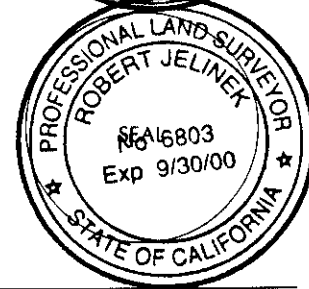

MONUMENT NOTES

• SET SPIKE & WASHER  
STAMPED R C E 23956,  
UNLESS OTHERWISE NOTED

ALL TIE POINTS ARE LEAD &  
TACK TAGGED R C E 23956  
IN TOP OF CURB



SCALE 1" = 40'

