


CORNER RECORD

Document Number 2000-500

City of Unincorporated Territory County of Orange, California

Brief Legal Description Tract No. 15600, M.M. 774/4-9

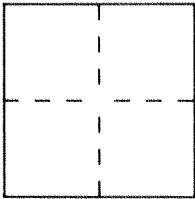

CORNER TYPE

Government Corner ☐ Control ☐
Meander ☐ Property ☐
Rancho ☐ Other ☒
Date of Survey 10/06/00

COORDINATES (Optional)

N. _____
E. _____
Zone _____ Datum _____
Elev. _____

Corner — Left as found ☐ Found and tagged ☐ Established ☒ Reestablished ☐ Rebuilt ☐

Identification and type of corner found: Evidence used to identify or procedure used to establish or reestablish the corner:

See sketch

A description of the physical condition of the monument as found and as set or reset: _____

See sketch

SURVEYOR'S STATEMENT

This Corner Record was prepared by me or under my direction in conformance with the Land Surveyors' Act on Oct. 9 2000.


Signed Robert N. Mimmack L.S. ~~5314~~ Number 5314



COUNTY SURVEYOR'S STATEMENT

This Corner Record was received October 12, 2000 ~~19~~ and examined and filed November 20th 2000

Signed Robert Jelinek Title DEPUTY COUNTY SURVEYOR

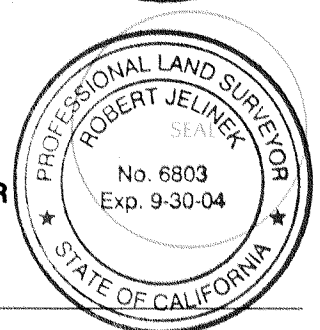

County Surveyor's Comment _____

LEGEND:

- INDICATES SET SPIKE AND WASHER STAMPED L.S. 5314
- INDICATES SET LEAD AND TAG STAMPED L.S. 5314
- ⊕ INDICATES TANGENT OVER

TRACT NO. 15600
M.M. 774/4-9

BLOOMFIELD LANE
(PRIVATE)

SCALE: 1" = 20'

MORNING TRAIL

TRACT NO. 15396
M.M. 757/17-21