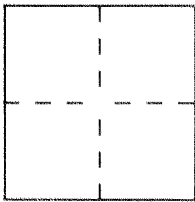


CORNER RECORD

Document Number 2000-501City of Unincorporated Territory County of Orange, CaliforniaBrief Legal Description Tract No. 15600, M.M. 774/4-9

CORNER TYPE

Government Corner ☐ Control ☐
Meander ☐ Property ☐
Rancho ☐ Other ☒
Date of Survey 10/06/00

COORDINATES (Optional)

N. _____
E. _____
Zone _____ Datum _____
Elev. _____

Corner — Left as found ☐ Found and tagged ☐ Established ☒ Reestablished ☐ Rebuilt ☐

Identification and type of corner found: Evidence used to identify or procedure used to establish or reestablish the corner:

See sketch

A description of the physical condition of the monument as found and as set or reset:

See sketch

SURVEYOR'S STATEMENT

This Corner Record was prepared by me or under my direction in conformance with the Land Surveyors' Act on Oct. 9 2000


Signed Robert N. Mimmack L.S. 5314 Number 5314



COUNTY SURVEYOR'S STATEMENT

This Corner Record was received October 12, 2000 and examined and filed November 20th 2000

Signed Robert Jelinek Title DEPUTY COUNTY SURVEYOR

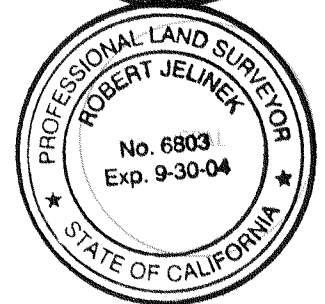

County Surveyor's Comment _____

LEGEND:

● INDICATES SET SPIKE AND
WASHER STAMPED L.S. 5314

○ INDICATES SET LEAD AND
TAG STAMPED L.S. 5314

⊘ INDICATES TANGENT OVER

POPPYFIELD LANE
(PRIVATE)

TRACT NO. 15600
M.M. 774/4-9

MEANDERING
TRAIL

SCALE: 1" = 20'

