


# CORNER RECORD

Document Number 2001- 1143

City of UNINCORPORATED County of ORANGE, California

Brief Legal Description CENTERLINE TIE NOTES FOR TRACT 15593

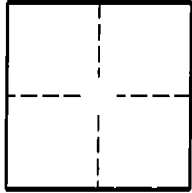

## CORNER TYPE

Government Corner ☐ Control ☐  
Meander ☐ Property ☒  
Rancho ☐ Other ☐  
Date of Survey JUNE 6, 2001

## COORDINATES (OPTIONAL)

N. \_\_\_\_\_  
E. \_\_\_\_\_  
Zone \_\_\_\_\_ NAD27 ☐ NAD83 ☐  
NAD83 Epoch \_\_\_\_\_  
Elev. \_\_\_\_\_  
Vert. Datum: NGVD29 ☐ NAVD88 ☐  
Meas. Units: Metric ☐ Imperial ☐

Corner- Left as found ☐ Found and tagged ☐ Established ☒ Reestablished ☐ Rebuilt ☐

Identification and type of corner found: Evidence used to identify or procedure used to establish or reestablish the corner:  
A PORTION OF THE CENTERLINE TIE NOTE'S FOR THE ABOVE MENTIONED TRACT

CALADIUM

A description of the physical condition of the monument as found and as set or reset:

## SURVEYOR'S STATEMENT

This Corner Record was prepared by me or under my direction in conformance with  
the Land Surveyors' Act on JUNE 6, 2001

Signed Rory S. Williams P.L.S. or R.C.E. Number L.S. 6654




## COUNTY SURVEYOR'S STATEMENT

This Corner Record was received JUL 09 2001

and examined and filed July 17th 2001

Signed Robert Jelinek P.L.S. or R.C.E. Number 6803

Title DEPUTY COUNTY SURVEYOR

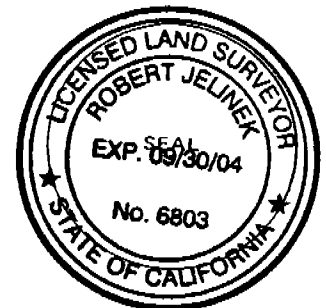

County Surveyor's Comment

CR 2001-1143

MONUMENT NOTES

• SET SPIKE & WASHER  
STAMPED L.S. 6654.  
UNLESS OTHERWISE NOTED.

ALL TIE POINTS ARE LEAD &  
TACK TAGGED L.S. 6654 IN  
TOP OF CURB.



SCALE 1" = 40'

