
CORNER RECORD

Agency Index

Document Number

2022-3570

| ty of | UNINCORPORATED TERRITORY | | County of | ORANGE | , California |
|---|--|---|--|--|--|
| ief Legal De | scription INTERSECTION OF | ANTONIO PKWY AN | O OSO PKWY | | |
| | Government Corner | Control X Property Other | Elevation Units Horizontal Zone | Metric ☐ U DatumEpoch Date | J.S. Survey Foot 🛛 |
| | Date of Survey <u>DECEME</u> | DEN 2022 | Complies w | atum vith Public Resources vith Public Resources | Code §§8801-8819 |
| S Act Ref: | ☐ 8765(d) 877 | 71 🗆 | 8773 | ☐ Othe | er: |
| orner/ onument: | ☑ Left as found☐ Est☐ Found and tagged☐ Re | tablished [| Rebuilt Referenced | | Construction -Construction |
| S ACT SECTION UNDARY LOCA BEARINGS SH PARCEL/LOT MEASURED DI BY A FULLY I DR DOUBLE I GROUND DIST. RECORD DIST. DISTANCES MA This Corne the Profes Signed | IOWN HEREON ARE ASSUMED A LINES AND PARCEL/LOT NUME ISTANCES SHOWN HERON ARE REDUNDANT LEAST SQUARES N DETERMINED, PER CHAPTERS S ANCE DIVIDE GRID DISTANCE E ANCES SHOWN HERON ARE AS AY BE EITHER GRID OR GROUN SURVEYOR THE RECORD OF THE RESIDENCE OF THE RESIDE | AND ARE DISPLAYER BERS ARE SHOWN GRID DISTANCES, BETWORK ADJUSTING & 11 OF THE OBY 0.999944. STHEY APPEAR ON ND, AS PER SAID STATEMENT OF UNDER SAID DECEMBER 12, YOR'S STATEMENT | D FOR ANGULAR HEREON FOR GR DERIVED BY INVE ENT. ALL POINTS C SURVEY STAND N THE DOCUMENT RECORD. ction in conformal 2022 or R.C.E. No | RELATIONSHIP ONLY APHICAL REPRESENT RSE FROM POSITION WERE EITHER TRAVE ARDS MANUAL. TO OF RECORD. nce with 7172 | ECON TO TRUE ATION ONLY. IS ESTABLISHED ERSED THROUGH |
| | er Record was received | | | | |
| | ined and filed | | | | |
| • | | | or K.C.E. No | | |
| | urveyor's Comment | | | | |

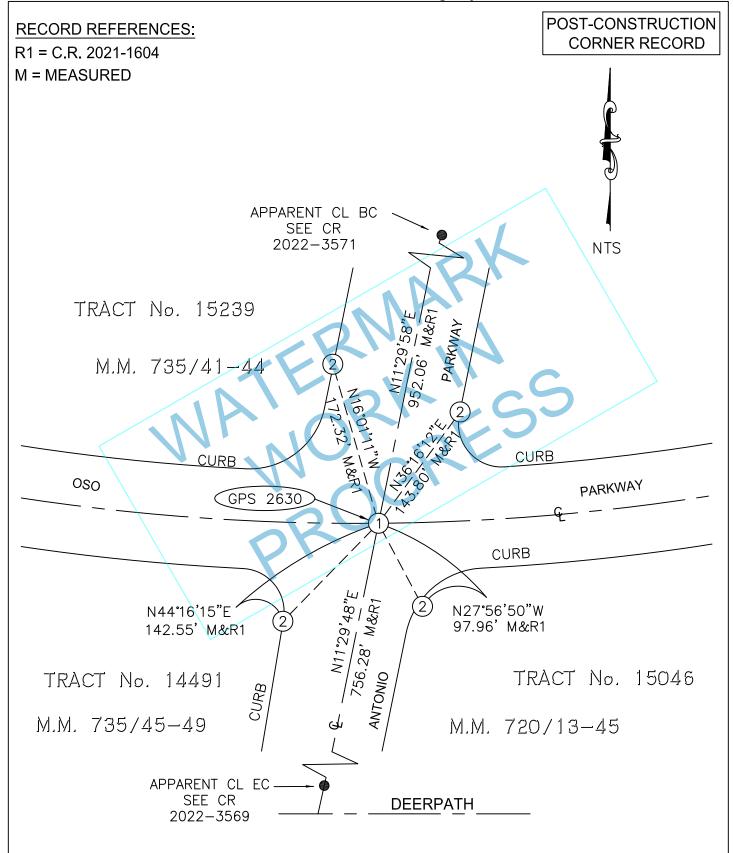

MONUMENT NOTES:

- 1) FOUND 2" BRASS CAP STAMPED "LS 5557", PER R1, DOWN 1.7' IN OCS WELL. NOTE, WAS MISTAKENLY NOTED AS "PLS 5557" ON PRE-CONSTRUCTION CORNER RECORD.
- ② FOUND LEAD, TACK AND TAG STAMPED "TIE PT PLS 7172", IN CURB PER R1