
CORNER RECORD

Agency Index

Document Number

2022-3572

ity of	JNINCORPORATED TERRIT	IUKI	Cou	nty of	URANGE	, California
rief Legal Des	scription	INTERS	SECTION OF A	NTONIO PKWY	AND SWEETWATE	ER
	CORN	NER TYPE		NI.	COORDINA	ATES (Optional)
	Government Corner Meander	Contro		Elevation	 Metric. □	U.S. Survey Foot
	Rancho	Other		Horizontal	Datum	Date
	Date of Survey <u>DE</u>	ECEMBER 2022		Vertical Da		
						ces Code §§8801-8819 ces Code §§8890-8902
LS Act Ref:	☐ 8765(d) 🗵	8771	□ 8	773		Other:
	☐ Left as found ☐ ☐ Found and tagged ☑	☐ Established ☐ Reestablish		Rebuilt Referenced		Pre-Construction Post-Construction
S ACT SECTIO	OF THIS RECORD IS TO NN 8771. NO CLAIM IS N	MADE AS TO T	HE RELATIONS	SHIP OF THE	POINTS SHOWN	HEREON TO TRUE
LS ACT SECTION OUNDARY LOCATION BEARINGS SHOW PARCEL/LOT IT MEASURED DISTATES OR DOUBLE DOWN DISTATES RECORD DISTATES DISTANCES MA This Corne	ON 8771. NO CLAIM IS A ATIONS. OWN HEREON ARE ASSUI LINES AND PARCEL/LOT STANCES SHOWN HERON REDUNDANT LEAST SQUAF DETERMINED, PER CHAPTE ANCE DIVIDE GRID DISTAN ANCES SHOWN HERON AF AY BE EITHER GRID OR O	MADE AS TO TOMED AND ARE NUMBERS AR ARE GRID DI RES NETWORK ERS 5 & 11 NCE BY 0.999 RE AS THEY AGROUND, AS FEYOR'S STATE by me or und Act on DECE	DISPLAYED FE SHOWN HEF STANCES, DEF ADJUSTMENT OF THE OC S1944. APPEAR ON TIPER SAID RECTEMENT OF THE OC S1944. APPEAR ON TIPER SAID RECTEMENT OF THE OC S1944. APPEAR ON TIPER SAID RECTEMENT OF THE OC S1944.	OR ANGULAR REON FOR GRA RIVED BY INVEL ALL POINTS GURVEY STAND HE DOCUMENT ORD.	RELATIONSHIP OF APPLICAL REPRESEMENT FROM POSITION OF RECORD.	ONLY. SENTATION ONLY. TIONS ESTABLISHED RAVERSED THROUGH TO OBTAIN A ONAL LAND STAND. FRANCES




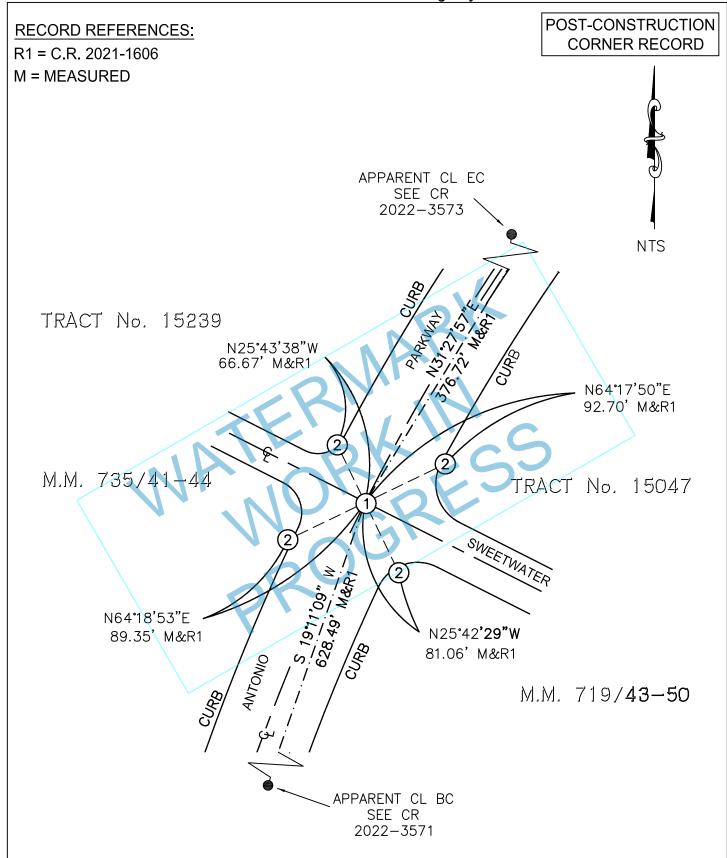

MONUMENT NOTES:

- ① SET SPIKE AND 1.5 INCH BRASS WASHER STAMPED "PLS 7172" FLUSH IN ASPHALT.
- (2) FOUND LEAD, TACK AND TAG STAMPED "TIE PLS 7172", PER R1. NOTE, WAS MISTAKENLY NOTED AS "TIE PT PLS 7172" ON PRE—CONSTRUCTION CORNER RECORD.