



## C01 LOS ALAMITOS CHANNEL CL




EXISTING CONDITION 2019  
MODIFIED RECORD PLAN C01-701-1-A  
DATED 01/23/2008  
DATE PREPARED: 08/02/2019

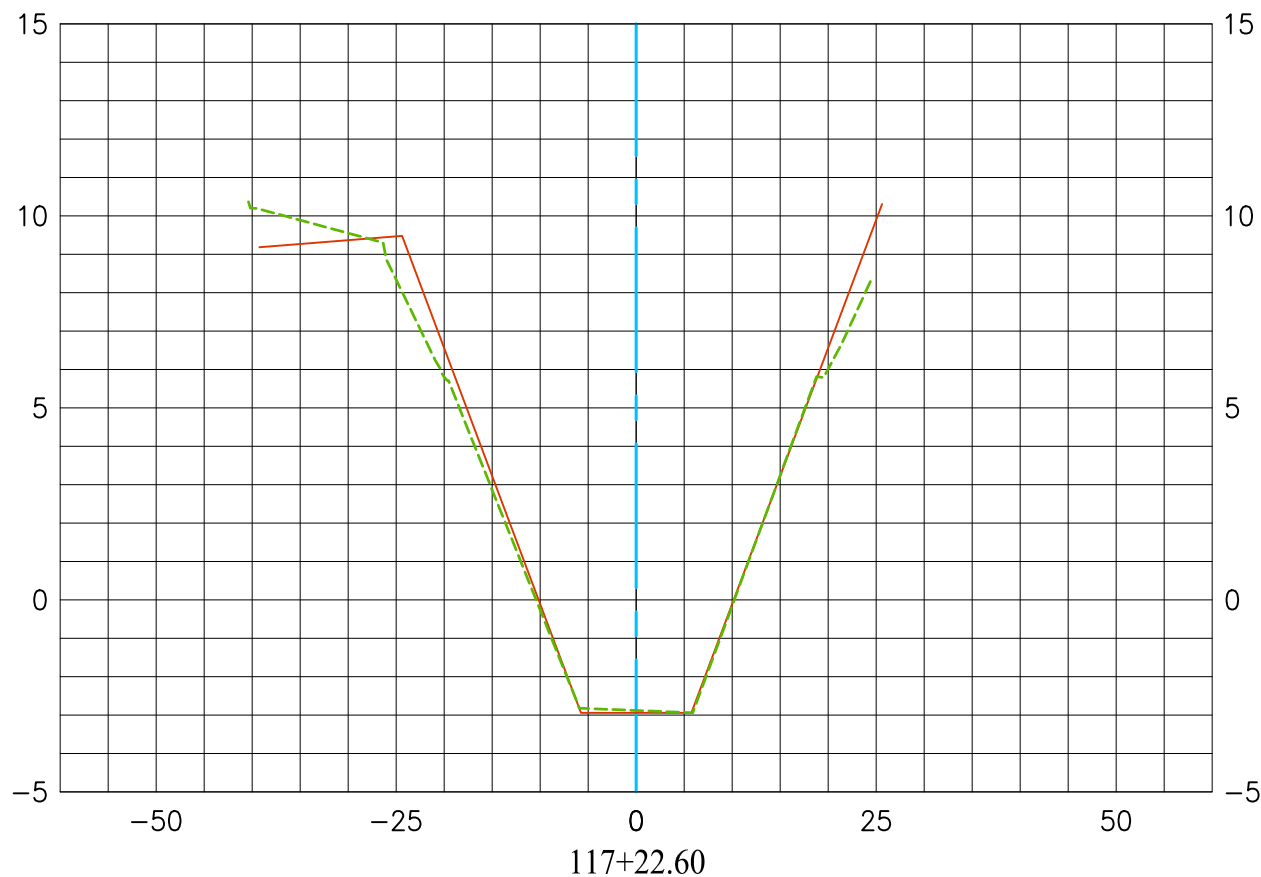

Vert. Scale: 1"=5'  
Hor. Scale: 1"=20'

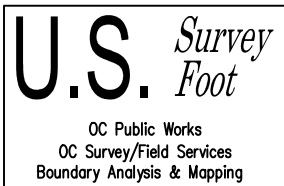

## C01 LOS ALAMITOS CHANNEL CL

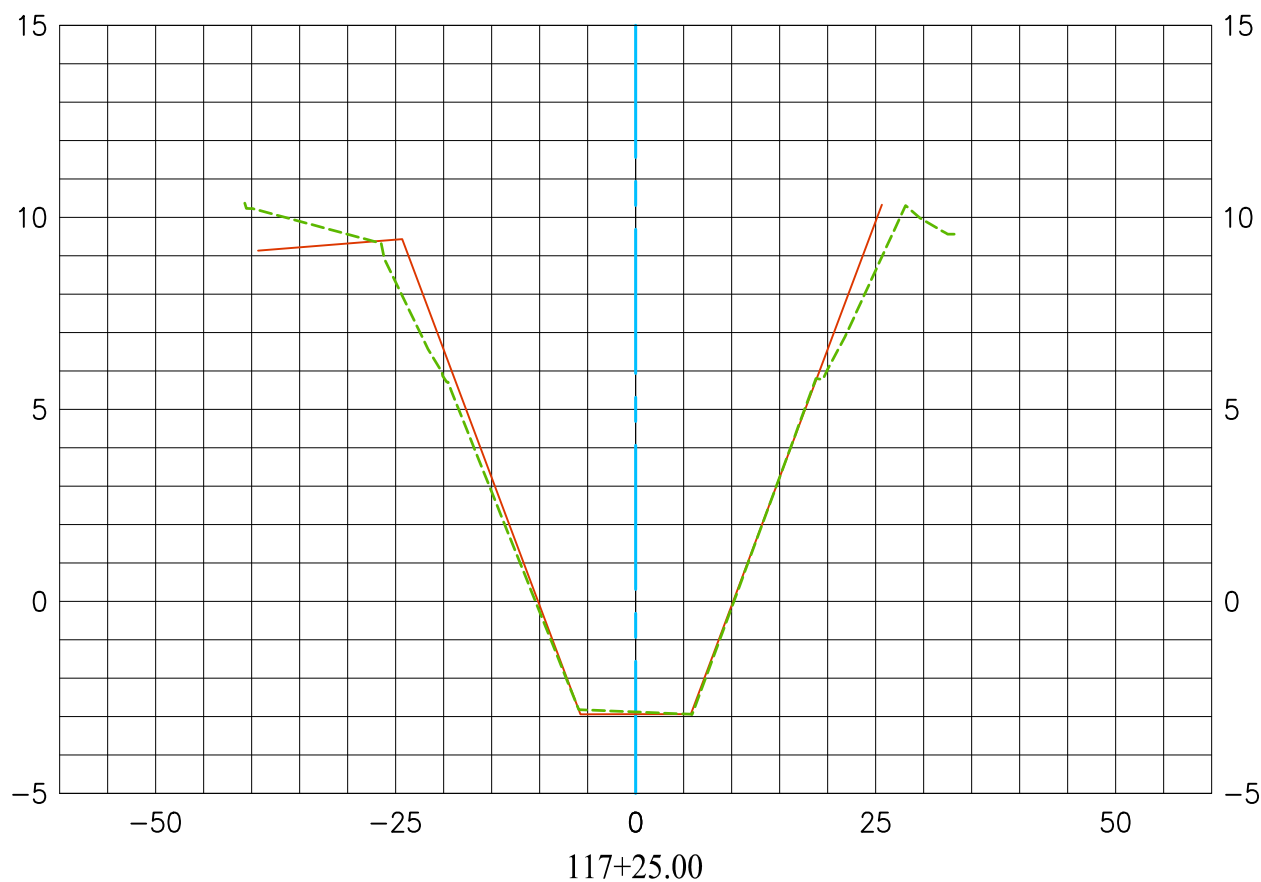


EXISTING CONDITION 2019  
MODIFIED RECORD PLAN C01-701-1-A  
DATED 01/23/2008  
DATE PREPARED: 08/02/2019



Vert. Scale: 1"=5'  
Hor. Scale: 1"=20'


# C01 LOS ALAMITOS CHANNEL CL

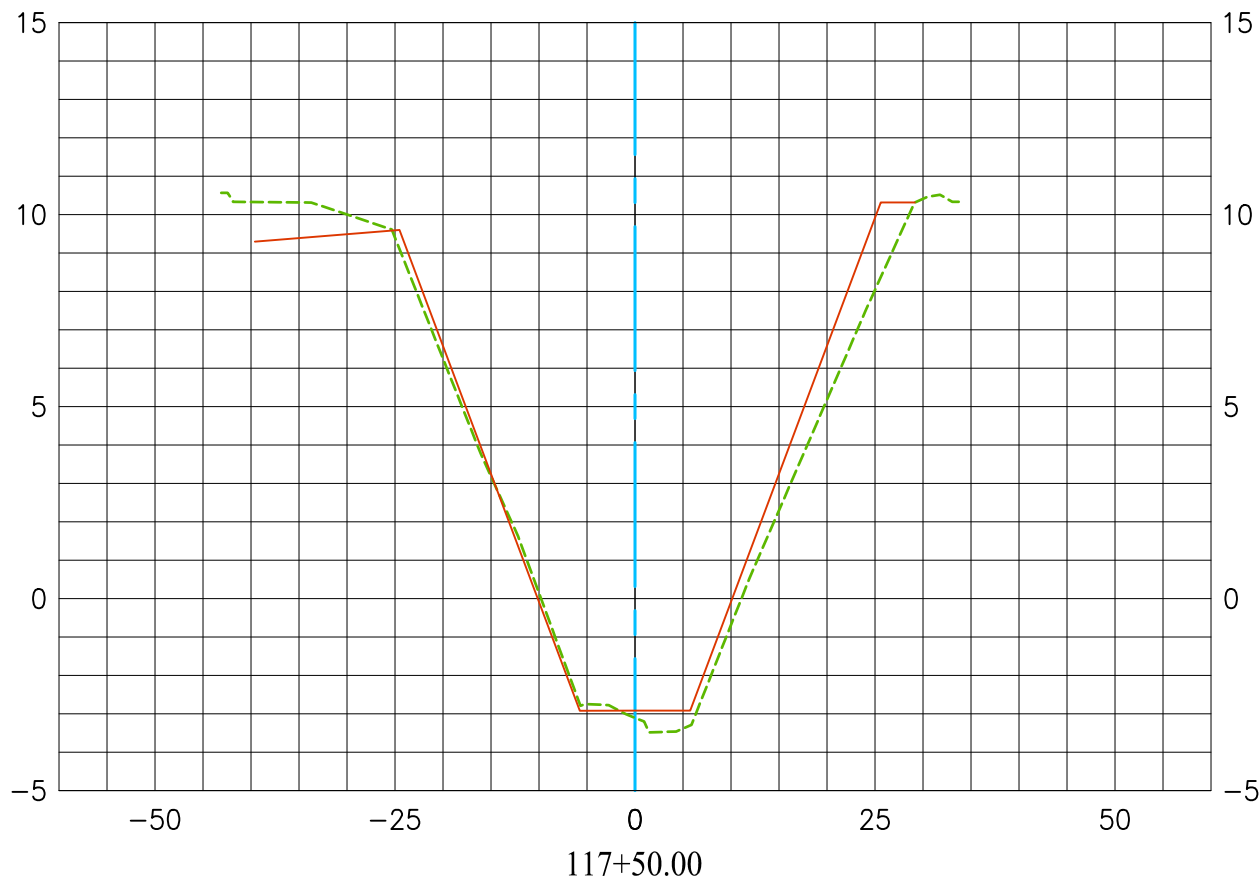

EXISTING CONDITION 2019  
 MODIFIED RECORD PLAN C01-701-1-A  
 DATED 01/23/2008  
 DATE PREPARED: 08/02/2019

Vert. Scale: 1"=5'  
 Hor. Scale: 1"=20'

## C01 LOS ALAMITOS CHANNEL CL

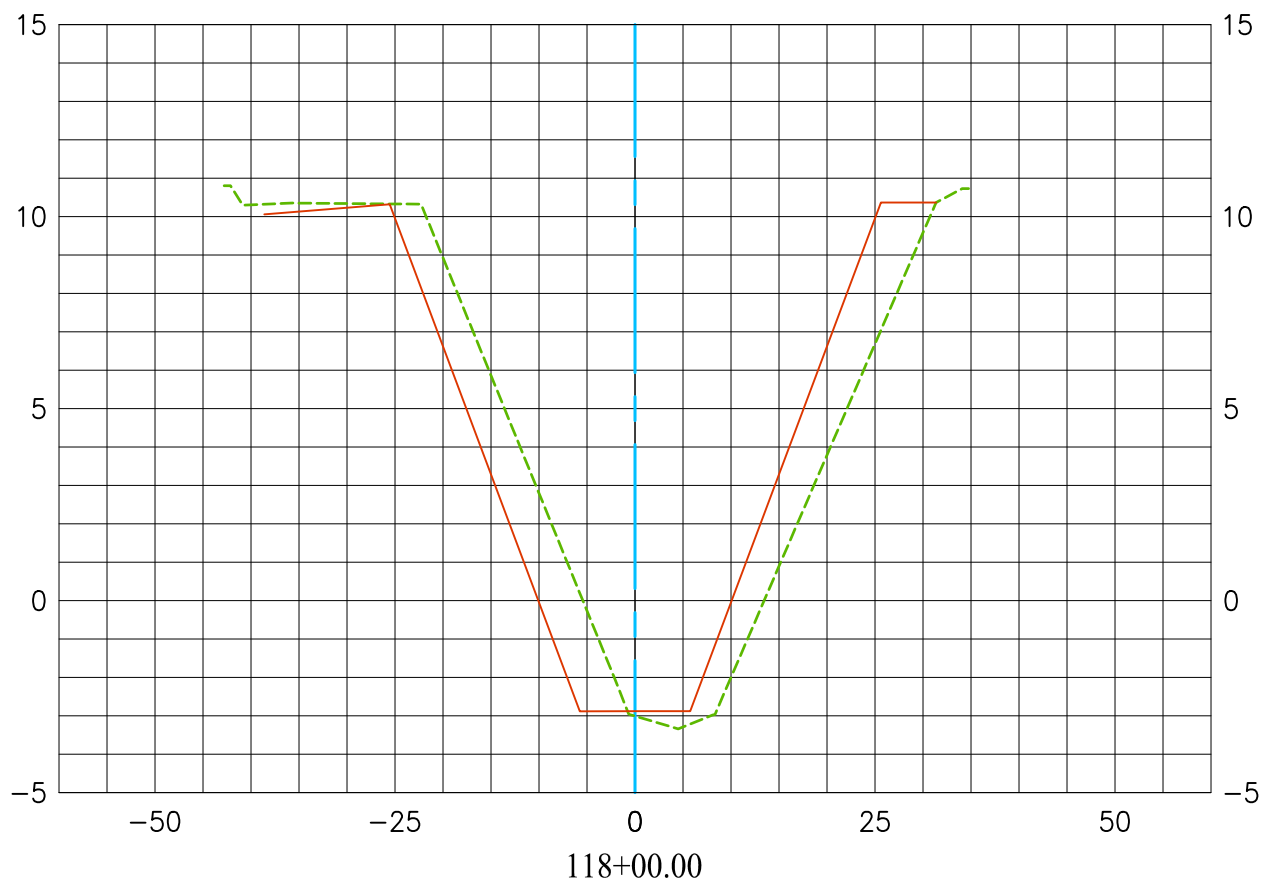


EXISTING CONDITION 2019  
 MODIFIED RECORD PLAN C01-701-1-A  
 DATED 01/23/2008  
 DATE PREPARED: 08/02/2019



Vert. Scale: 1"=5'  
 Hor. Scale: 1"=20'

## C01 LOS ALAMITOS CHANNEL CL

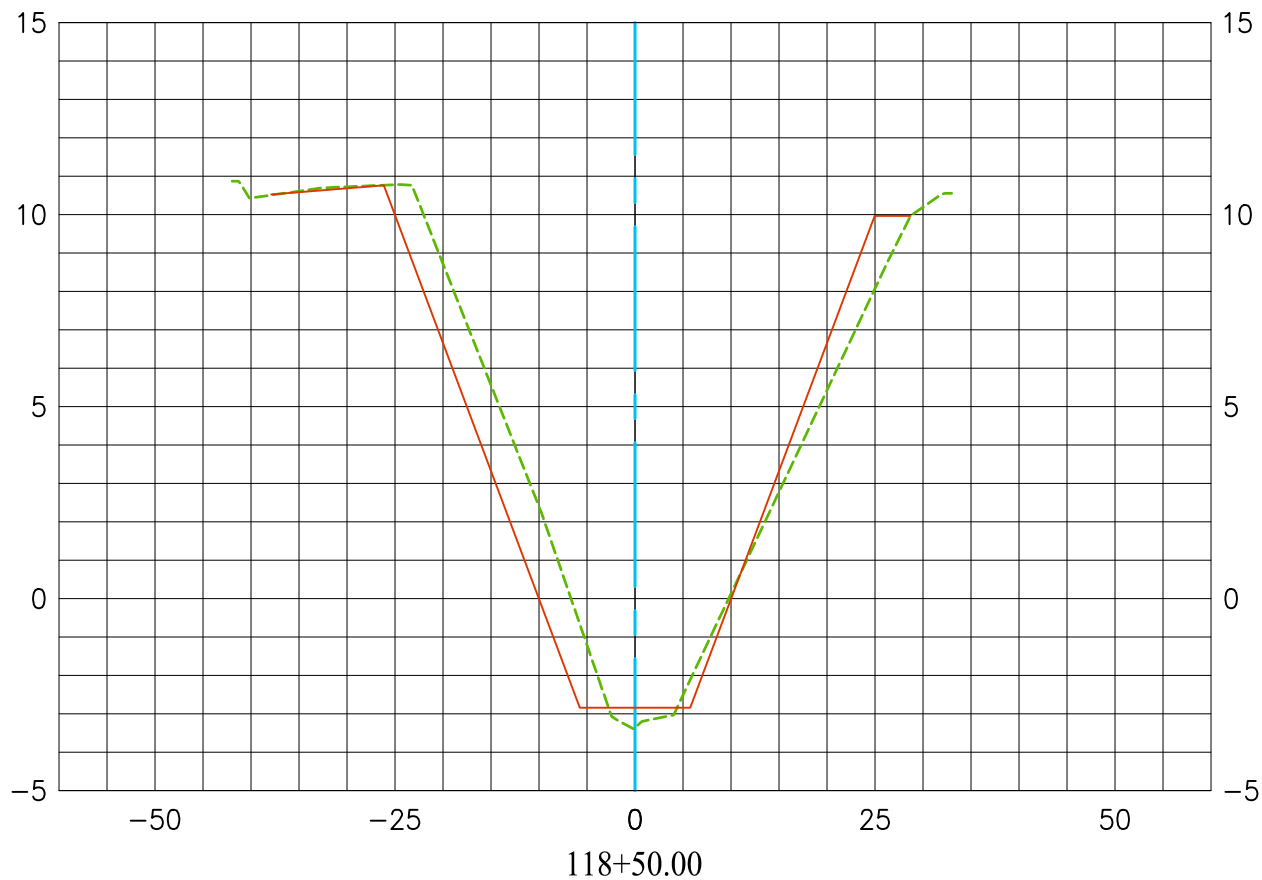


EXISTING CONDITION 2019  
MODIFIED RECORD PLAN C01-701-1-A  
DATED 01/23/2008  
DATE PREPARED: 08/02/2019

---  
---

Vert. Scale: 1"=5'  
Hor. Scale: 1"=20'


# C01 LOS ALAMITOS CHANNEL CL

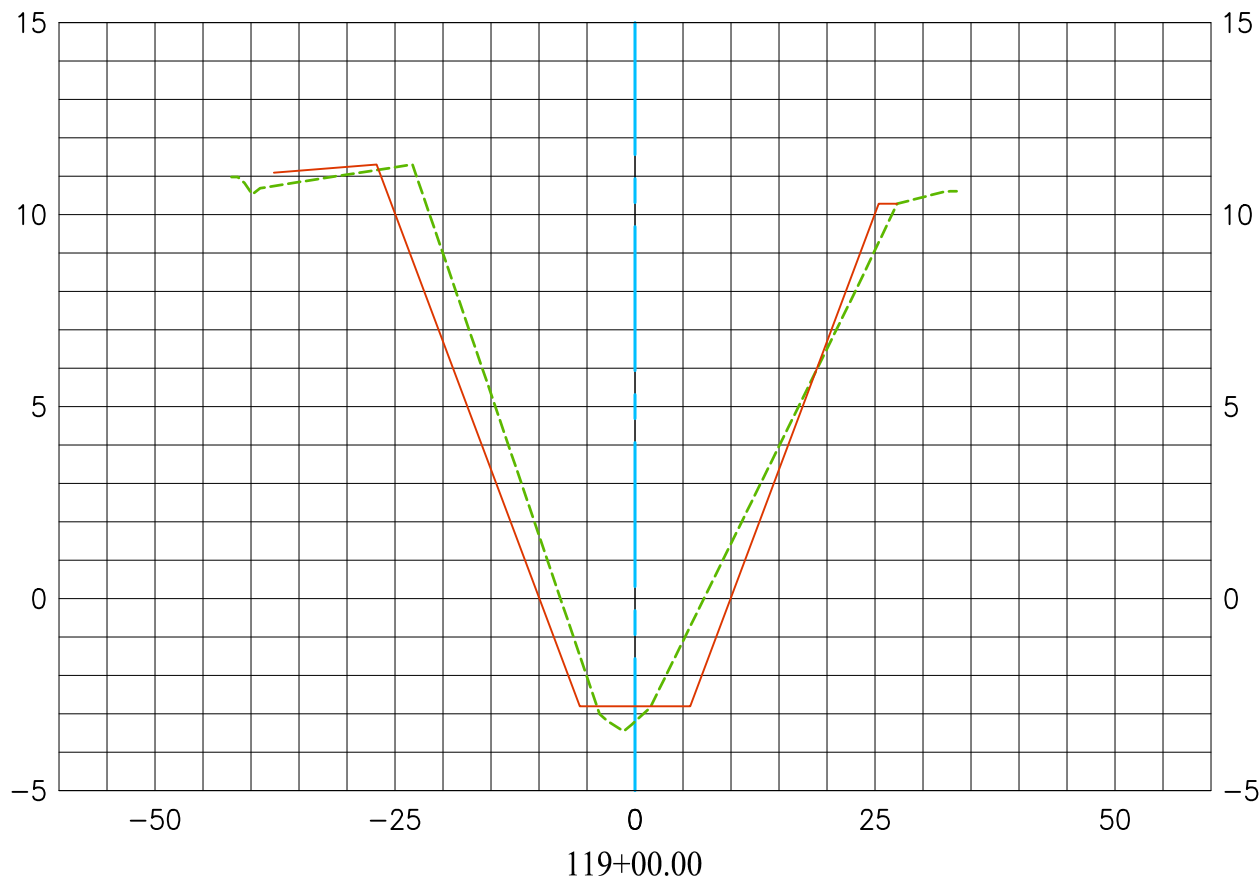

EXISTING CONDITION 2019  
 MODIFIED RECORD PLAN C01-701-1-A  
 DATED 01/23/2008  
 DATE PREPARED: 08/02/2019

Vert. Scale: 1"=5'  
 Hor. Scale: 1"=20'


# C01 LOS ALAMITOS CHANNEL CL

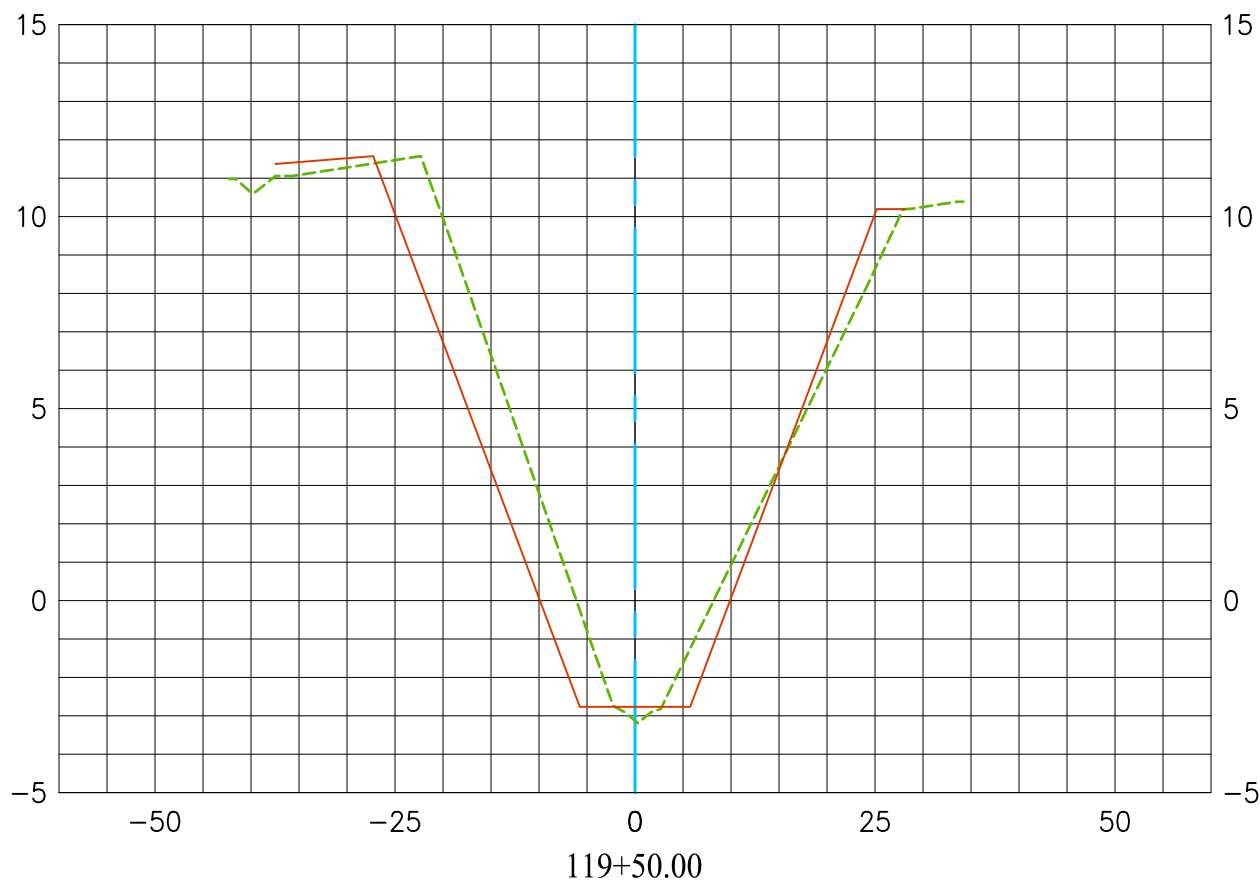

EXISTING CONDITION 2019  
 MODIFIED RECORD PLAN C01-701-1-A  
 DATED 01/23/2008  
 DATE PREPARED: 08/02/2019

Vert. Scale: 1"=5'  
 Hor. Scale: 1"=20'

# C01 LOS ALAMITOS CHANNEL CL

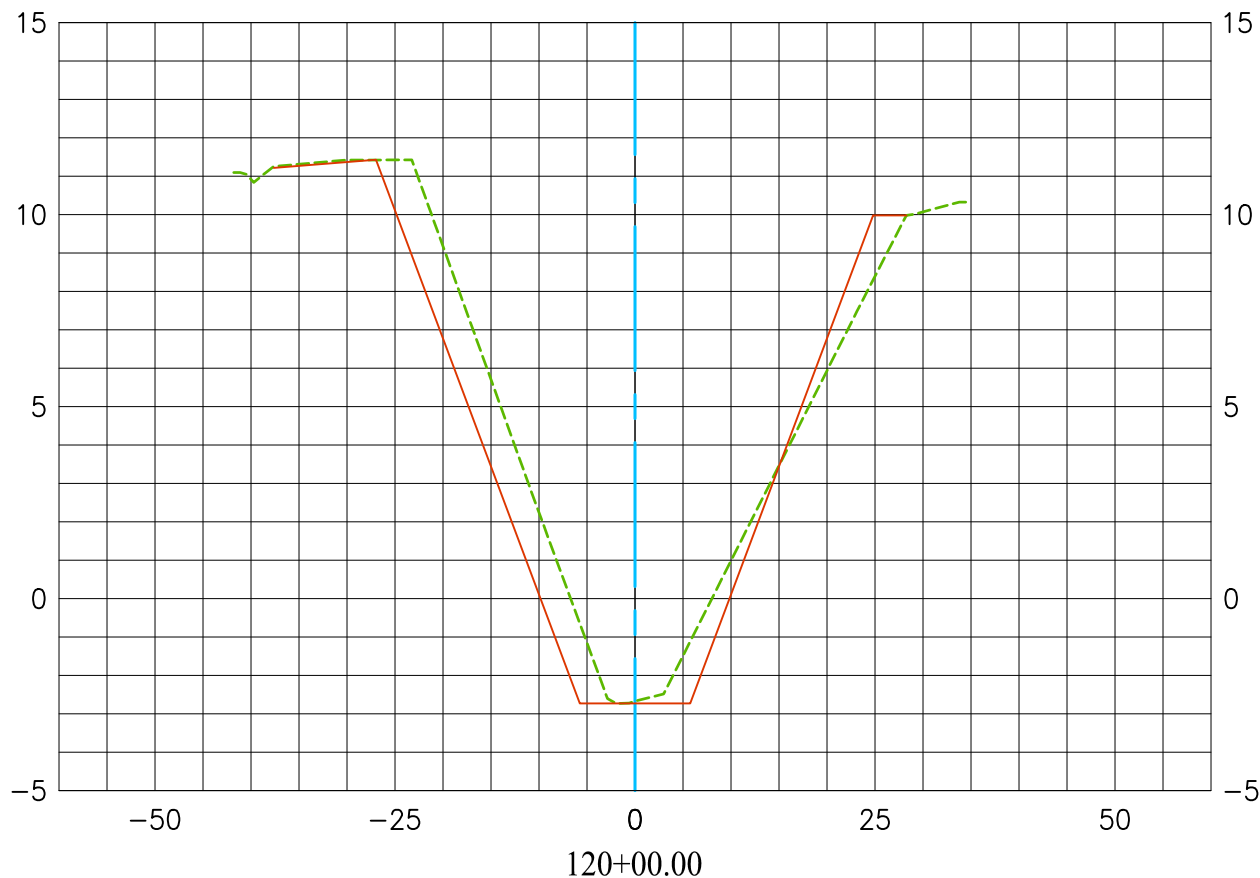


EXISTING CONDITION 2019  
 MODIFIED RECORD PLAN C01-701-1-A  
 DATED 01/23/2008  
 DATE PREPARED: 08/02/2019

---  
 ---

Vert. Scale: 1"=5'  
 Hor. Scale: 1"=20'



## C01 LOS ALAMITOS CHANNEL CL

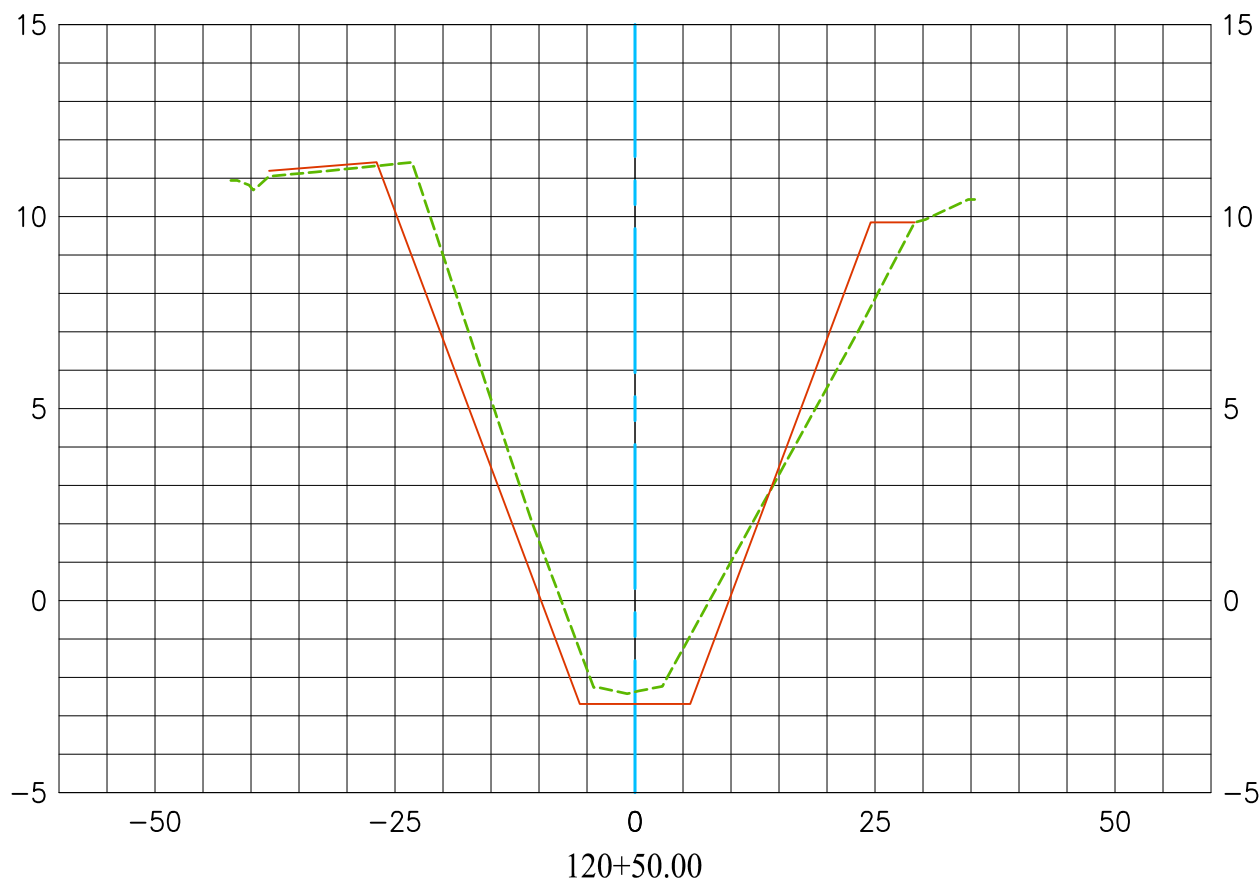


EXISTING CONDITION 2019  
 MODIFIED RECORD PLAN C01-701-1-A  
 DATED 01/23/2008  
 DATE PREPARED: 08/02/2019

-----  
 \_\_\_\_\_


Vert. Scale: 1"=5'  
 Hor. Scale: 1"=20'

# C01 LOS ALAMITOS CHANNEL CL

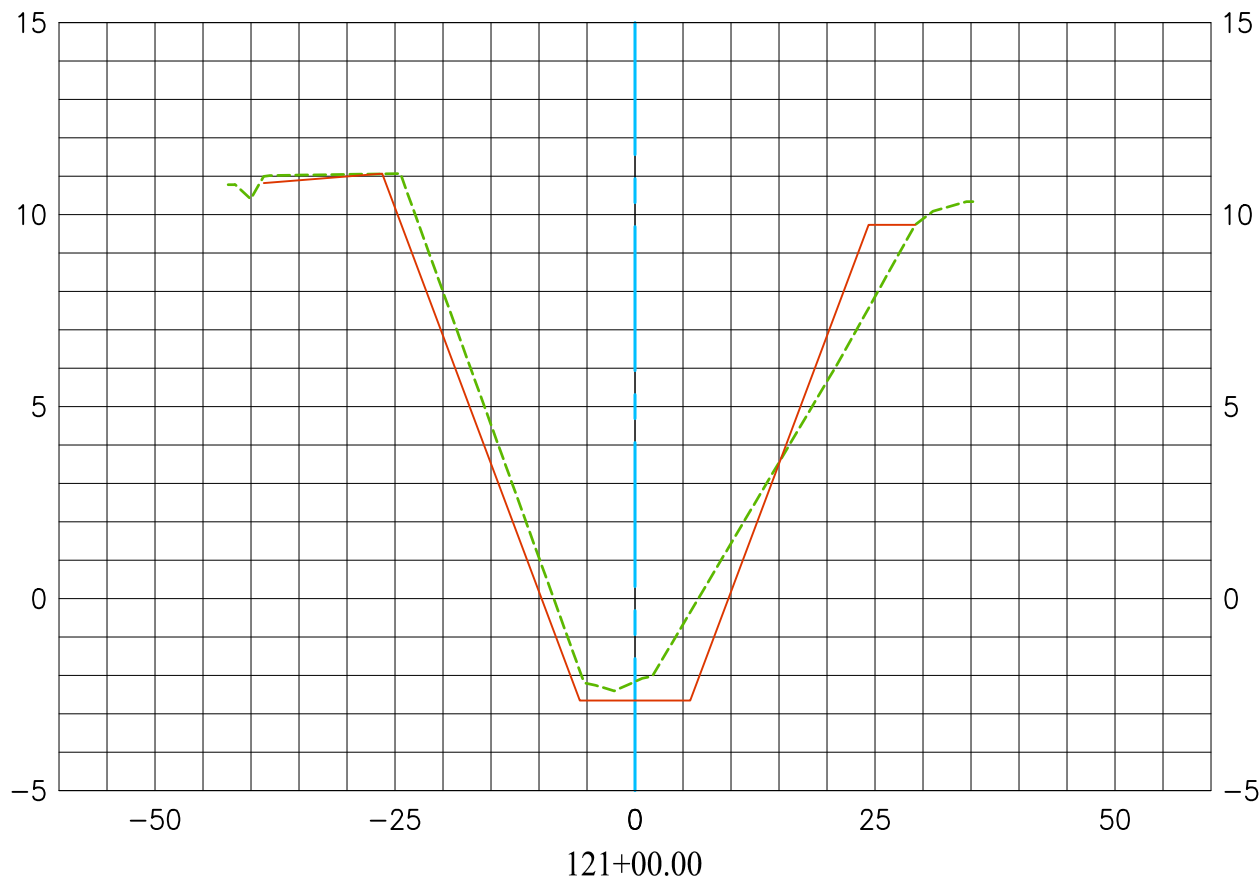


EXISTING CONDITION 2019  
 MODIFIED RECORD PLAN C01-701-1-A  
 DATED 01/23/2008  
 DATE PREPARED: 08/02/2019

Vert. Scale: 1"=5'  
 Hor. Scale: 1"=20'

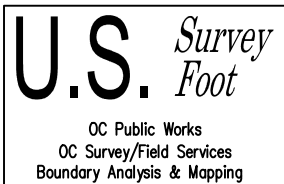


## C01 LOS ALAMITOS CHANNEL CL

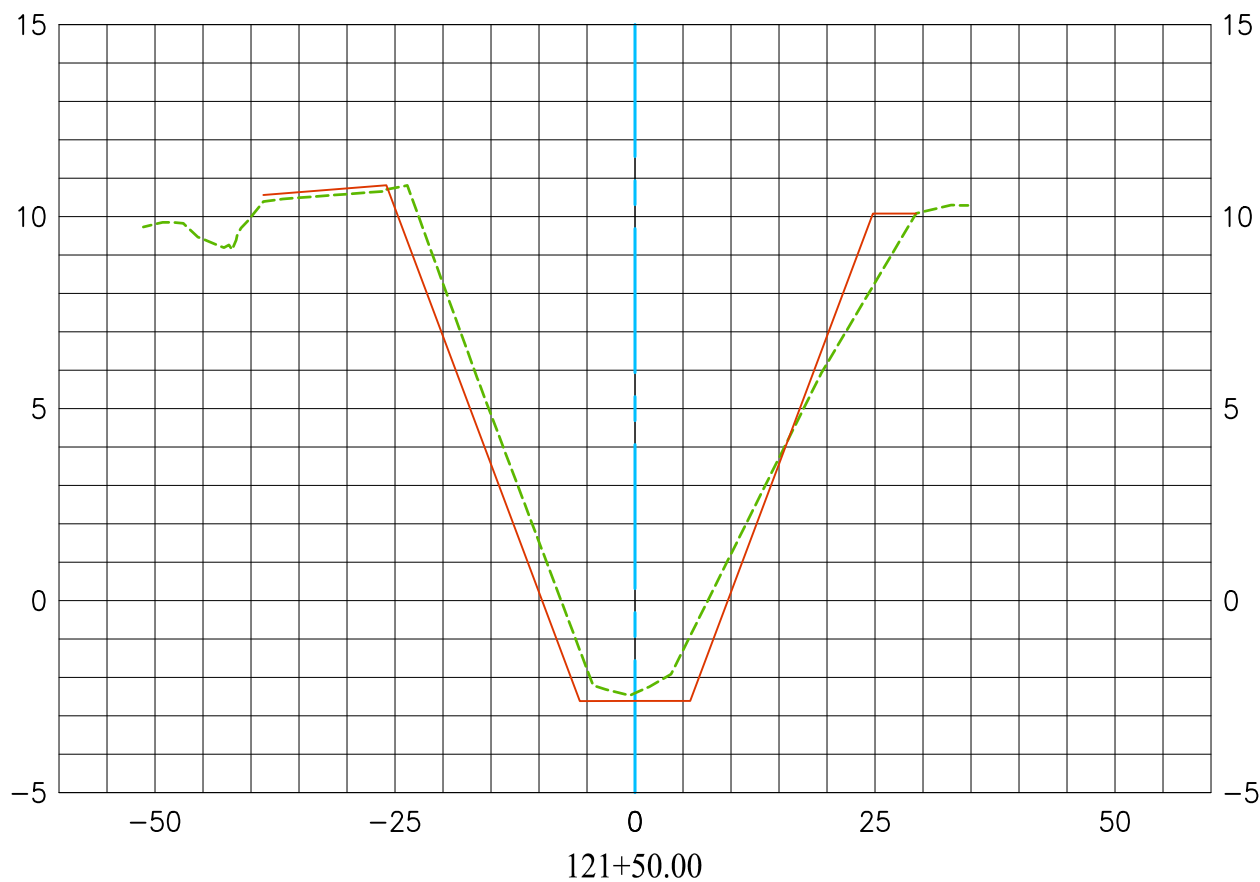

EXISTING CONDITION 2019  
MODIFIED RECORD PLAN C01-701-1-A  
DATED 01/23/2008  
DATE PREPARED: 08/02/2019

Vert. Scale: 1"=5'  
Hor. Scale: 1"=20'

# C01 LOS ALAMITOS CHANNEL CL

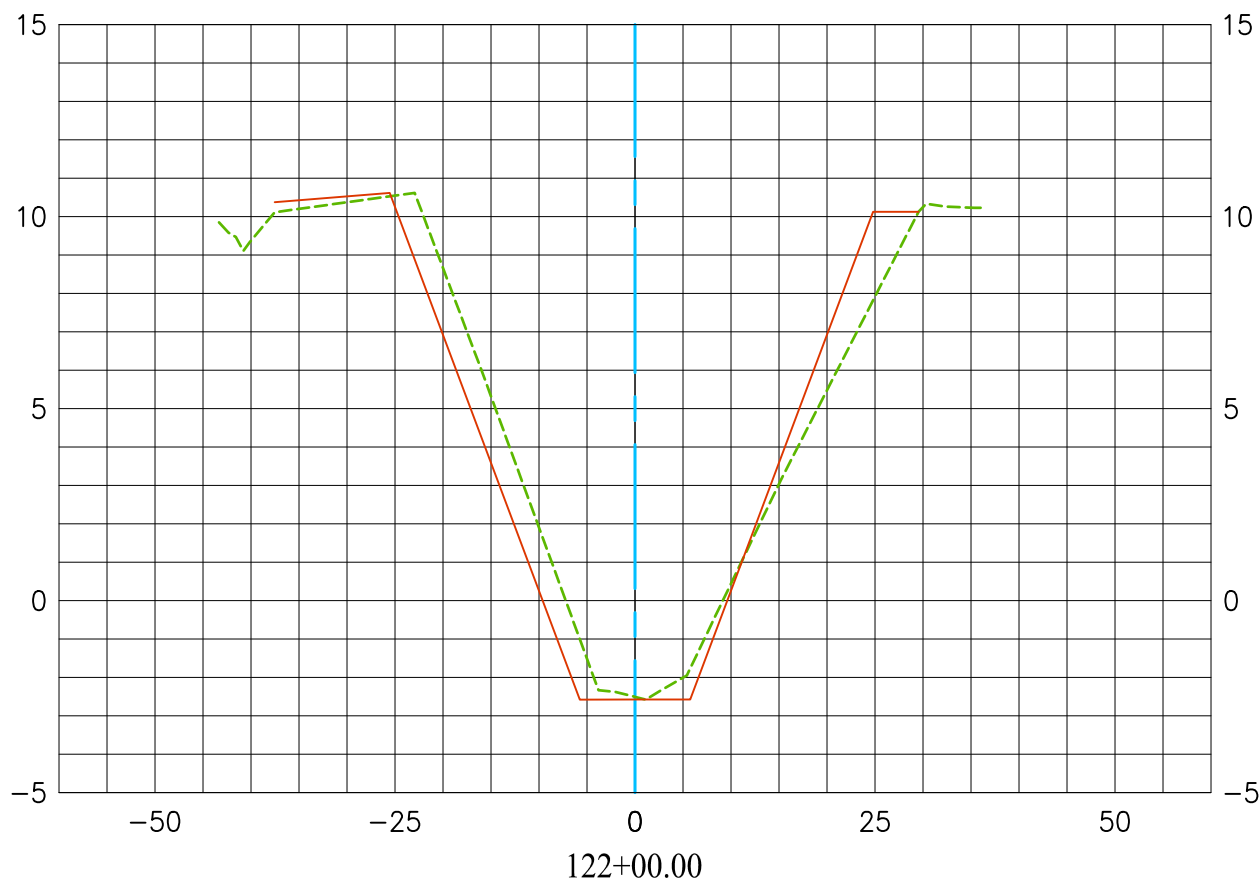


EXISTING CONDITION 2019  
 MODIFIED RECORD PLAN C01-701-1-A  
 DATED 01/23/2008  
 DATE PREPARED: 08/02/2019

---  
 ---

Vert. Scale: 1"=5'  
 Hor. Scale: 1"=20'


# C01 LOS ALAMITOS CHANNEL CL

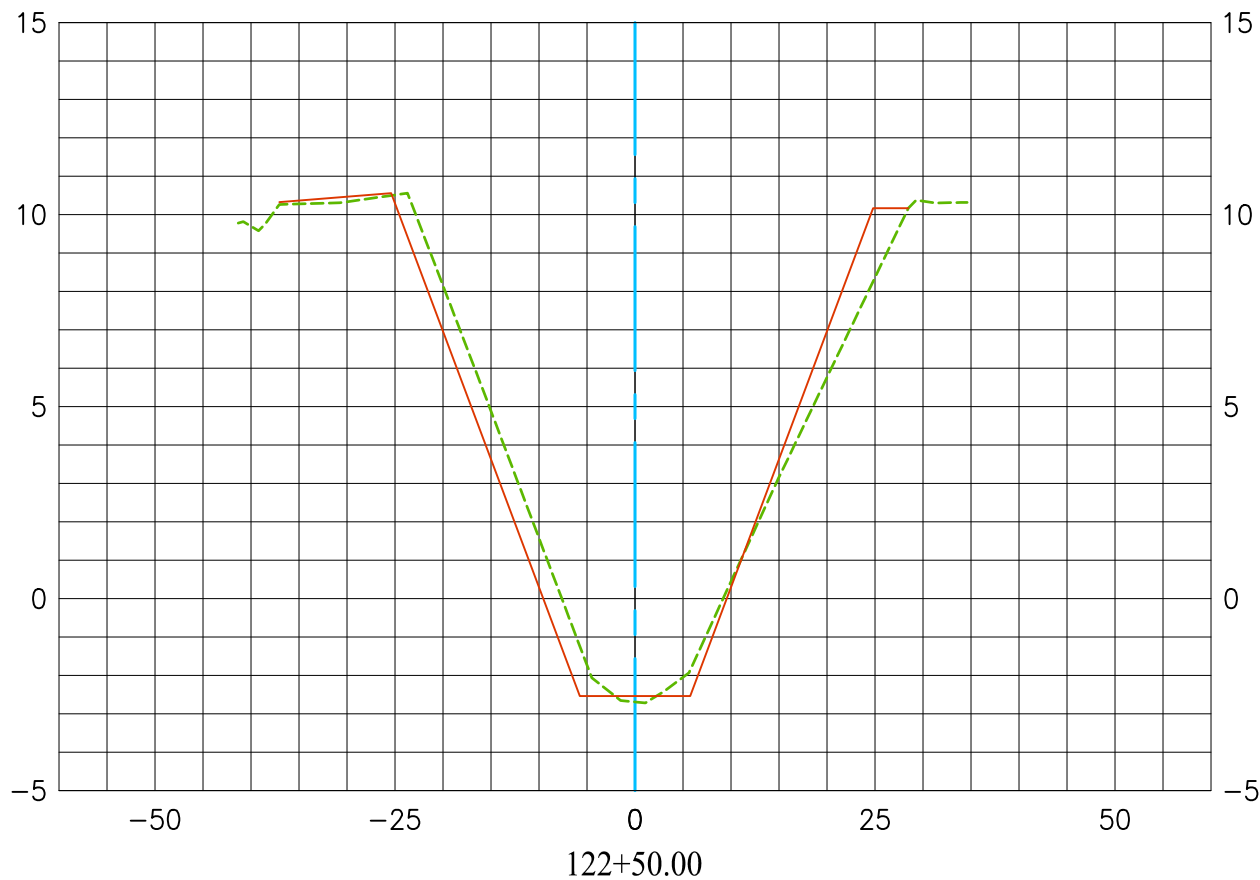

EXISTING CONDITION 2019  
 MODIFIED RECORD PLAN C01-701-1-A  
 DATED 01/23/2008  
 DATE PREPARED: 08/02/2019

Vert. Scale: 1"=5'  
 Hor. Scale: 1"=20'


# C01 LOS ALAMITOS CHANNEL CL

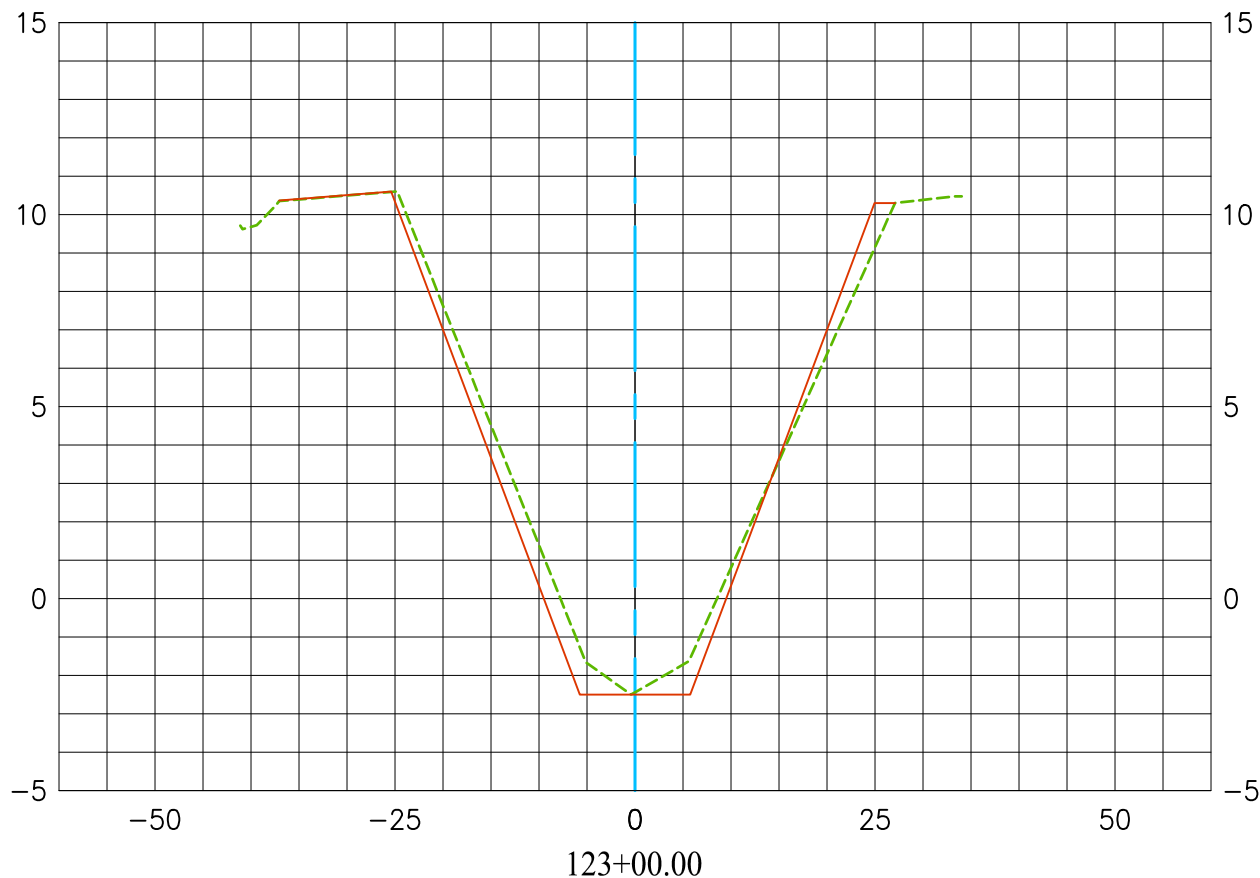

EXISTING CONDITION 2019  
 MODIFIED RECORD PLAN C01-701-1-A  
 DATED 01/23/2008  
 DATE PREPARED: 08/02/2019

Vert. Scale: 1"=5'  
 Hor. Scale: 1"=20'

# C01 LOS ALAMITOS CHANNEL CL

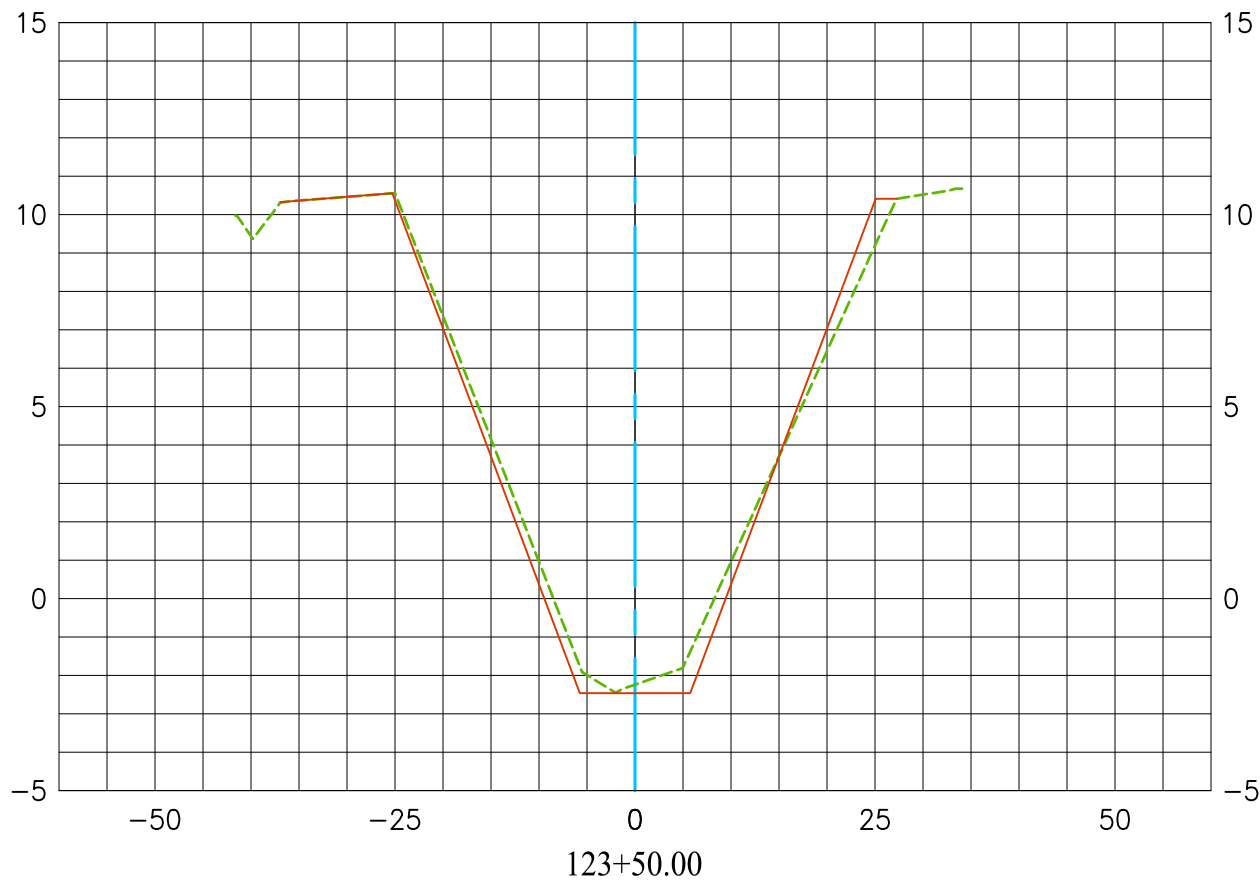


EXISTING CONDITION 2019  
 MODIFIED RECORD PLAN C01-701-1-A  
 DATED 01/23/2008  
 DATE PREPARED: 08/02/2019

Vert. Scale: 1"=5'  
 Hor. Scale: 1"=20'



## C01 LOS ALAMITOS CHANNEL CL

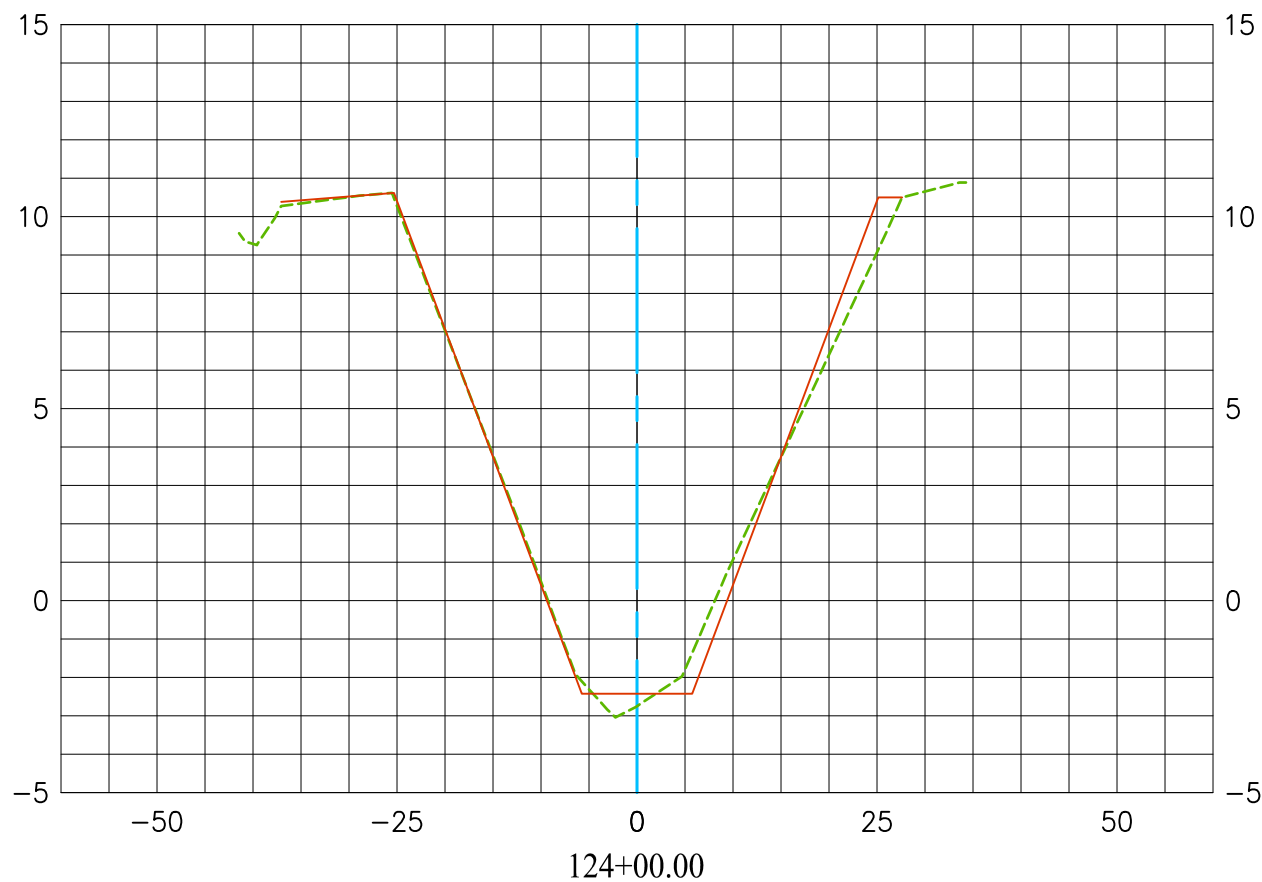


EXISTING CONDITION 2019  
MODIFIED RECORD PLAN C01-701-1-A  
DATED 01/23/2008  
DATE PREPARED: 08/02/2019

Vert. Scale: 1"=5'  
Hor. Scale: 1"=20'



# C01 LOS ALAMITOS CHANNEL CL

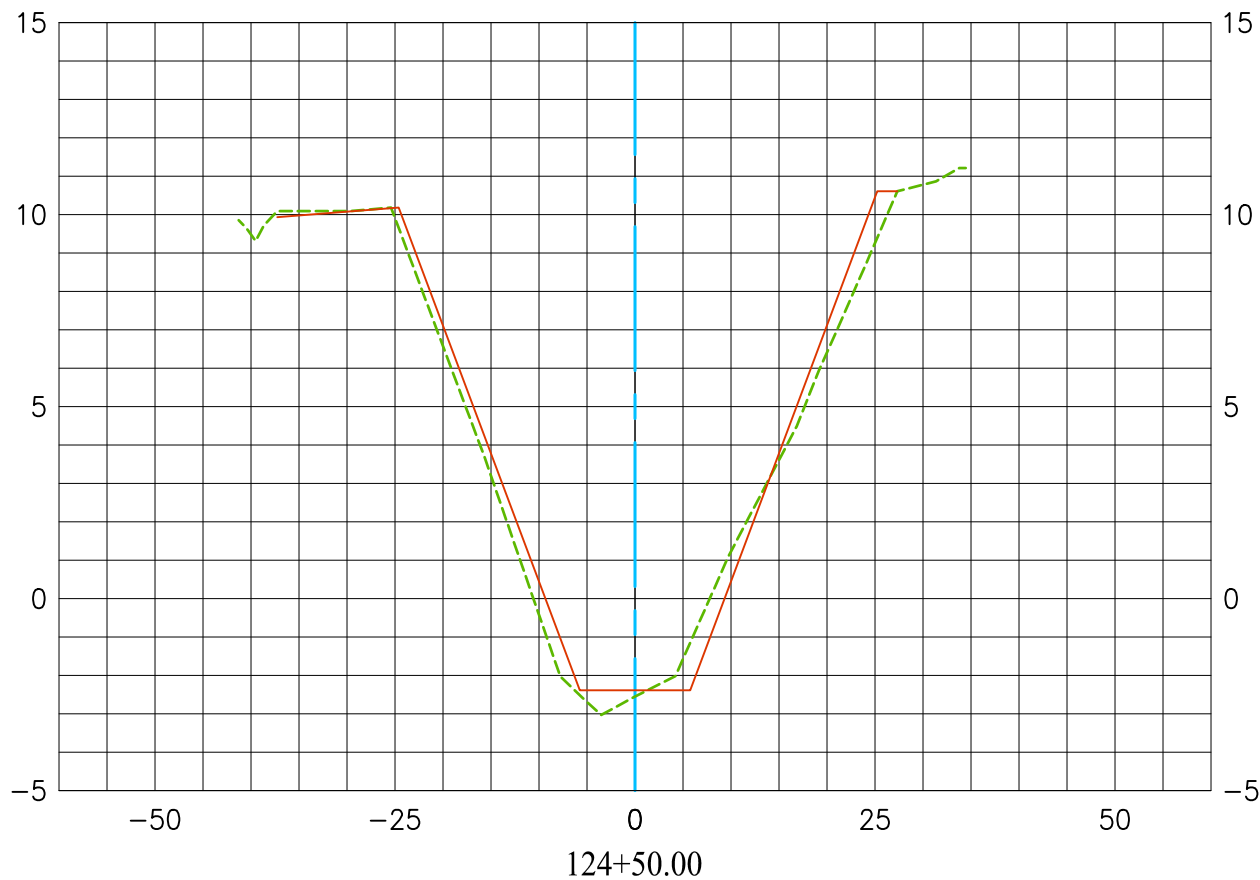


EXISTING CONDITION 2019  
 MODIFIED RECORD PLAN C01-701-1-A  
 DATED 01/23/2008  
 DATE PREPARED: 08/02/2019

---  
 ---

Vert. Scale: 1"=5'  
 Hor. Scale: 1"=20'



## C01 LOS ALAMITOS CHANNEL CL

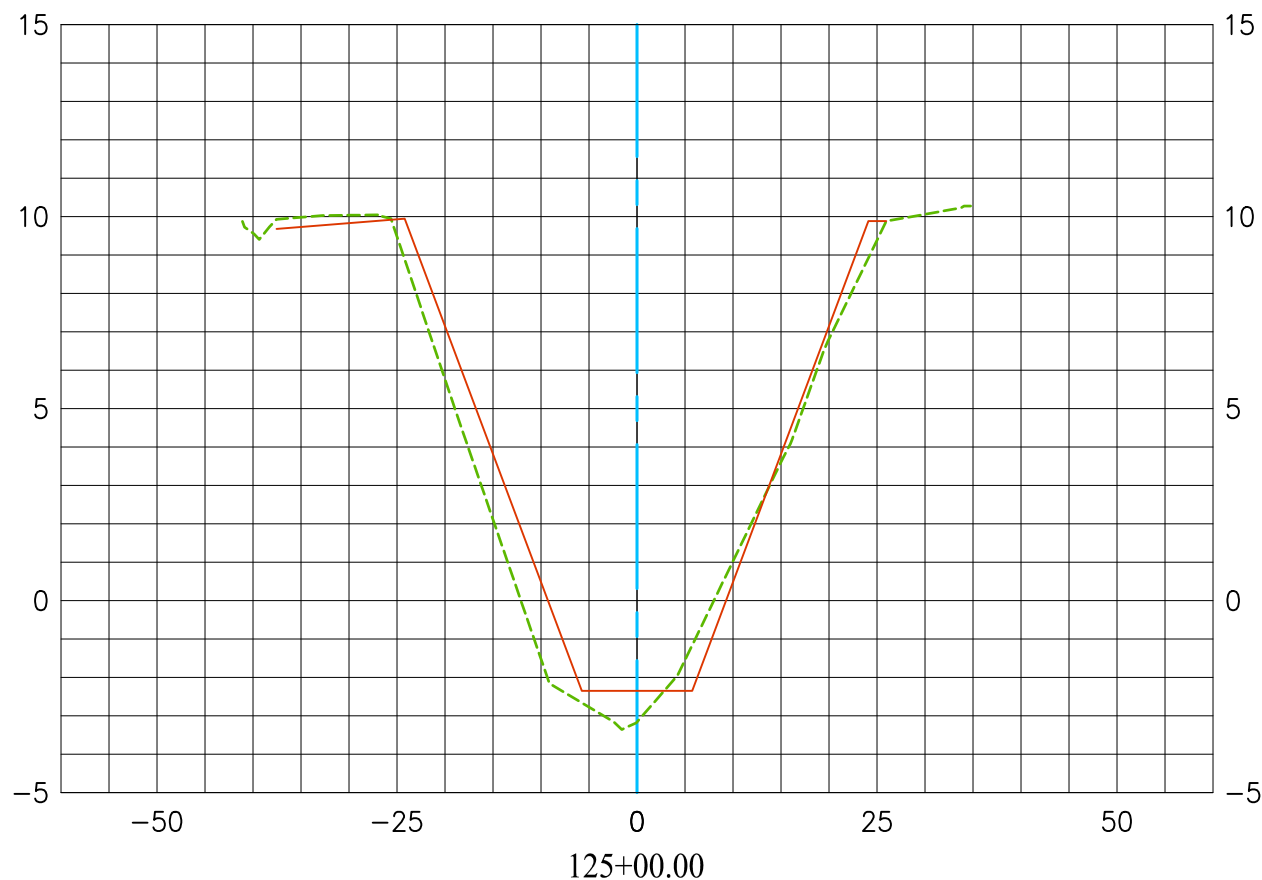


EXISTING CONDITION 2019  
MODIFIED RECORD PLAN C01-701-1-A  
DATED 01/23/2008  
DATE PREPARED: 08/02/2019

Vert. Scale: 1"=5'  
Hor. Scale: 1"=20'




## C01 LOS ALAMITOS CHANNEL CL

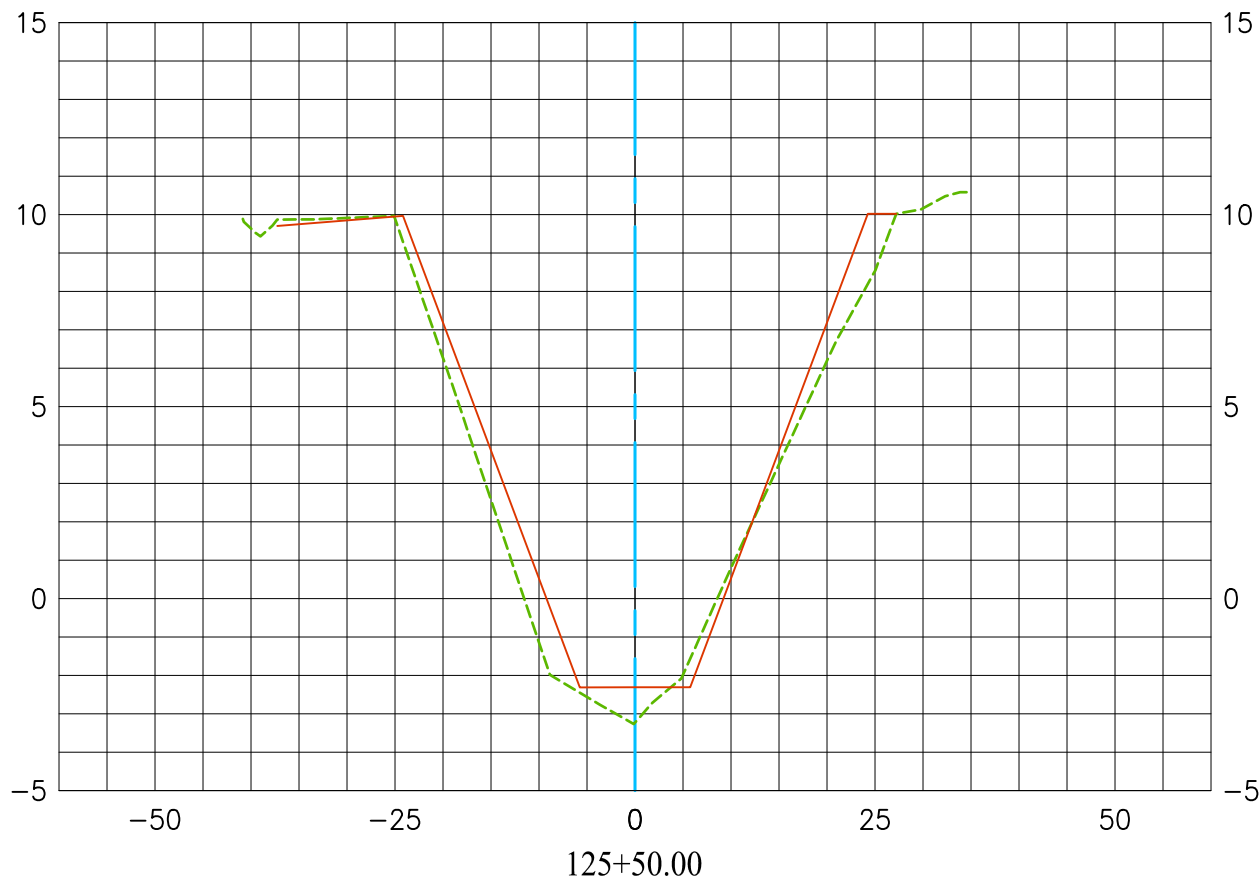


EXISTING CONDITION 2019  
MODIFIED RECORD PLAN C01-701-1-A  
DATED 01/23/2008  
DATE PREPARED: 08/02/2019



Vert. Scale: 1"=5'  
Hor. Scale: 1"=20'

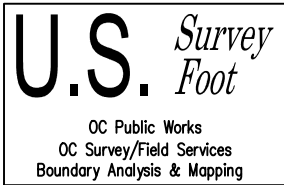

## C01 LOS ALAMITOS CHANNEL CL

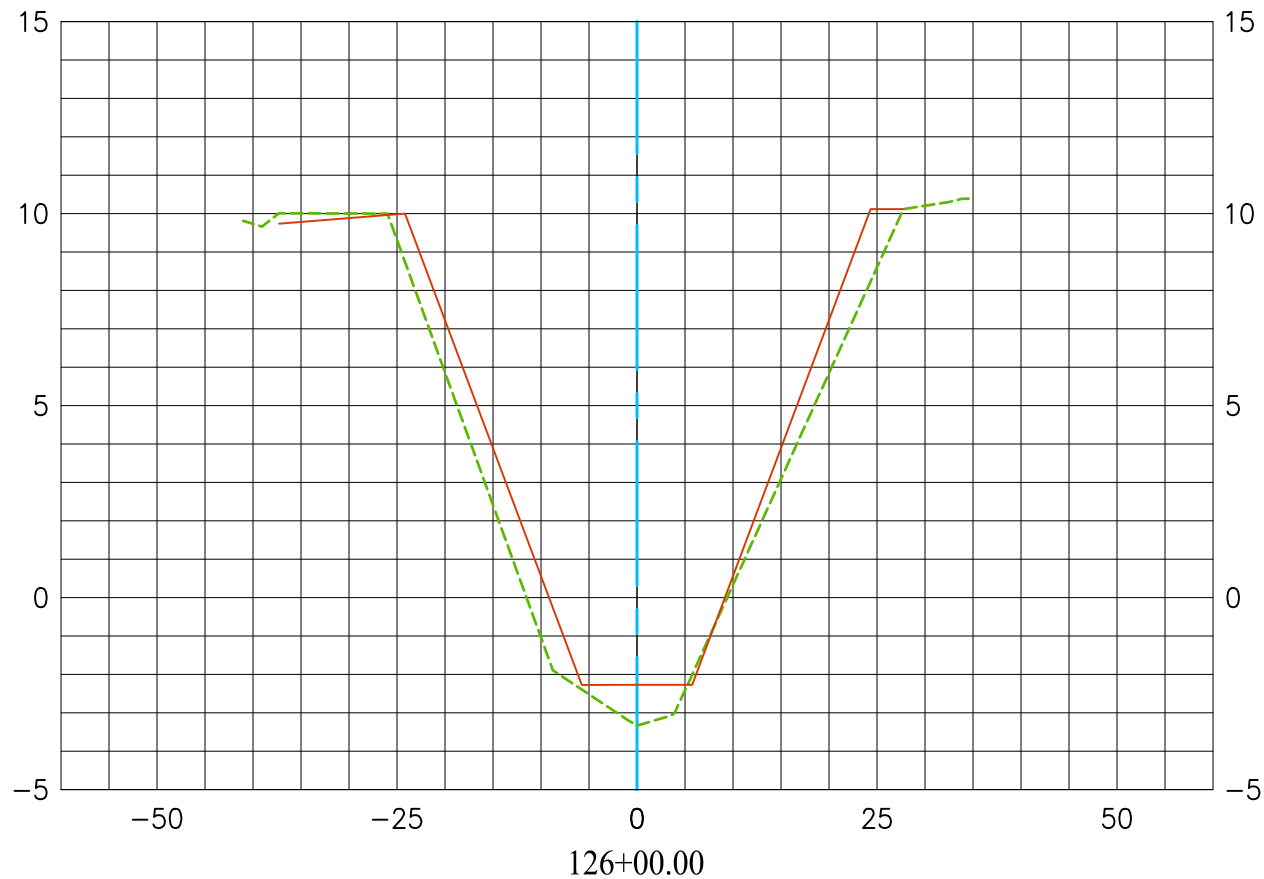


EXISTING CONDITION 2019  
MODIFIED RECORD PLAN C01-701-1-A  
DATED 01/23/2008  
DATE PREPARED: 08/02/2019

Vert. Scale: 1"=5'  
Hor. Scale: 1"=20'



## C01 LOS ALAMITOS CHANNEL CL

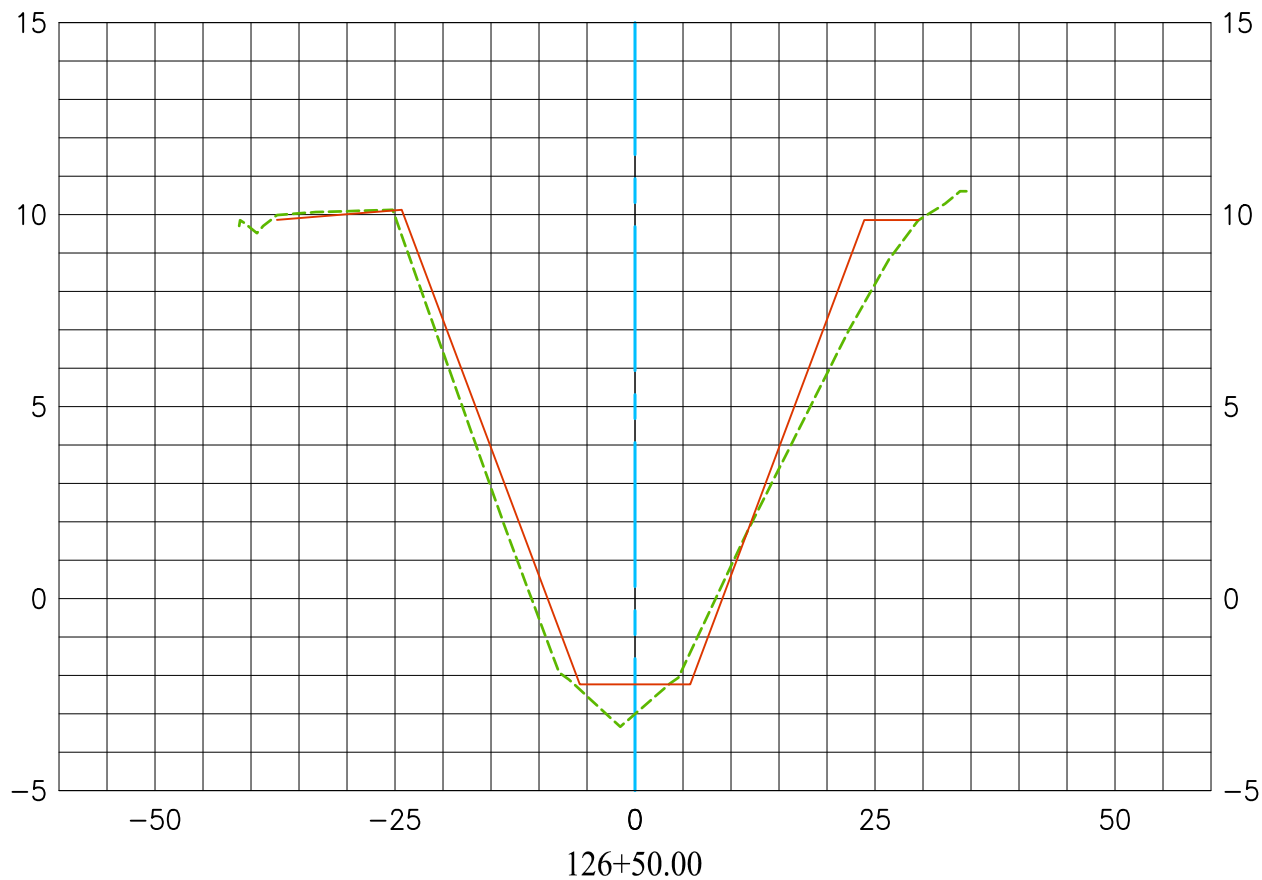


EXISTING CONDITION 2019  
MODIFIED RECORD PLAN C01-701-1-A  
DATED 01/23/2008  
DATE PREPARED: 08/02/2019

Vert. Scale: 1"=5'  
Hor. Scale: 1"=20'




## C01 LOS ALAMITOS CHANNEL CL

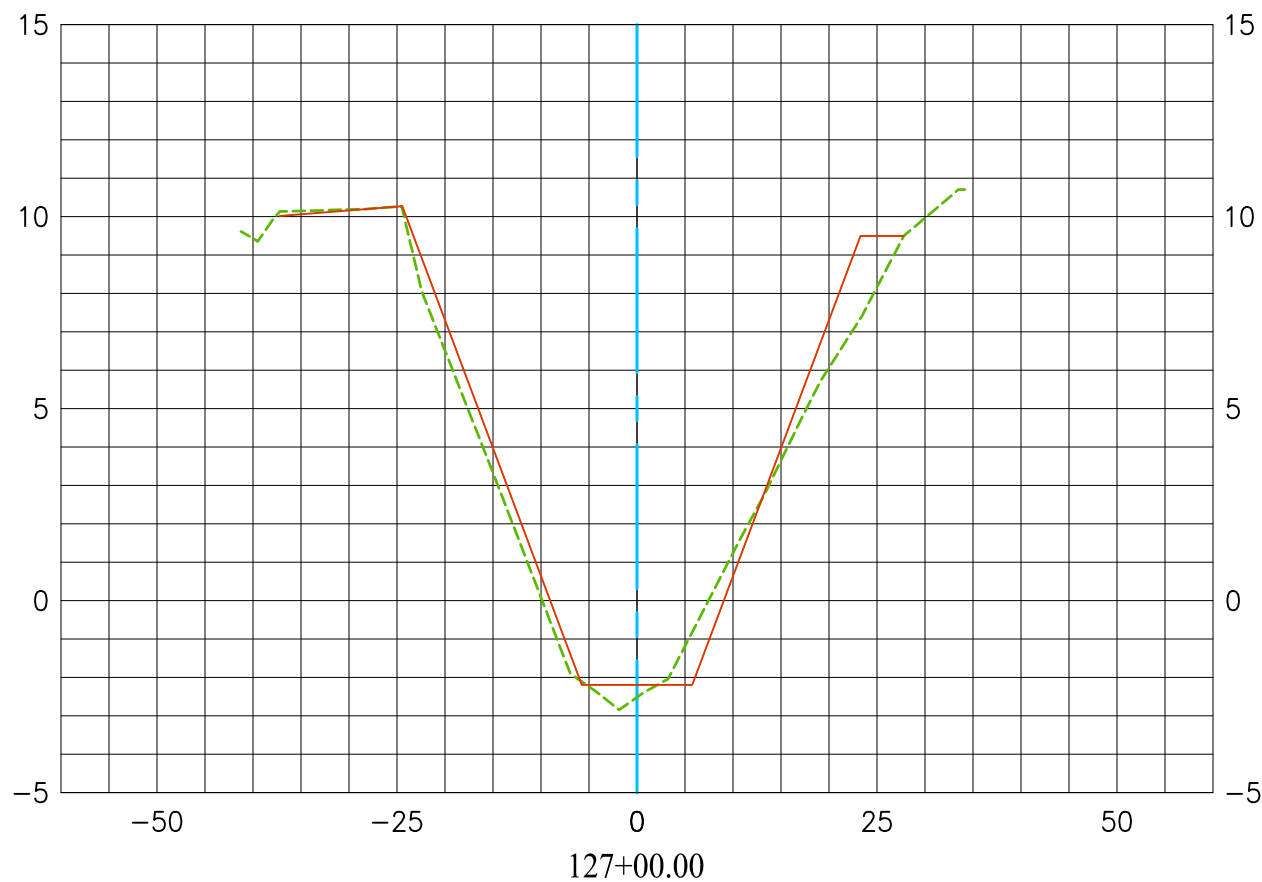


EXISTING CONDITION 2019  
MODIFIED RECORD PLAN C01-701-1-A  
DATED 01/23/2008  
DATE PREPARED: 08/02/2019

Vert. Scale: 1"=5'  
Hor. Scale: 1"=20'

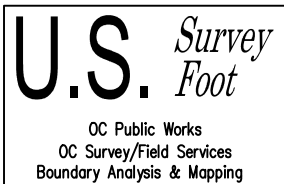

# C01 LOS ALAMITOS CHANNEL CL

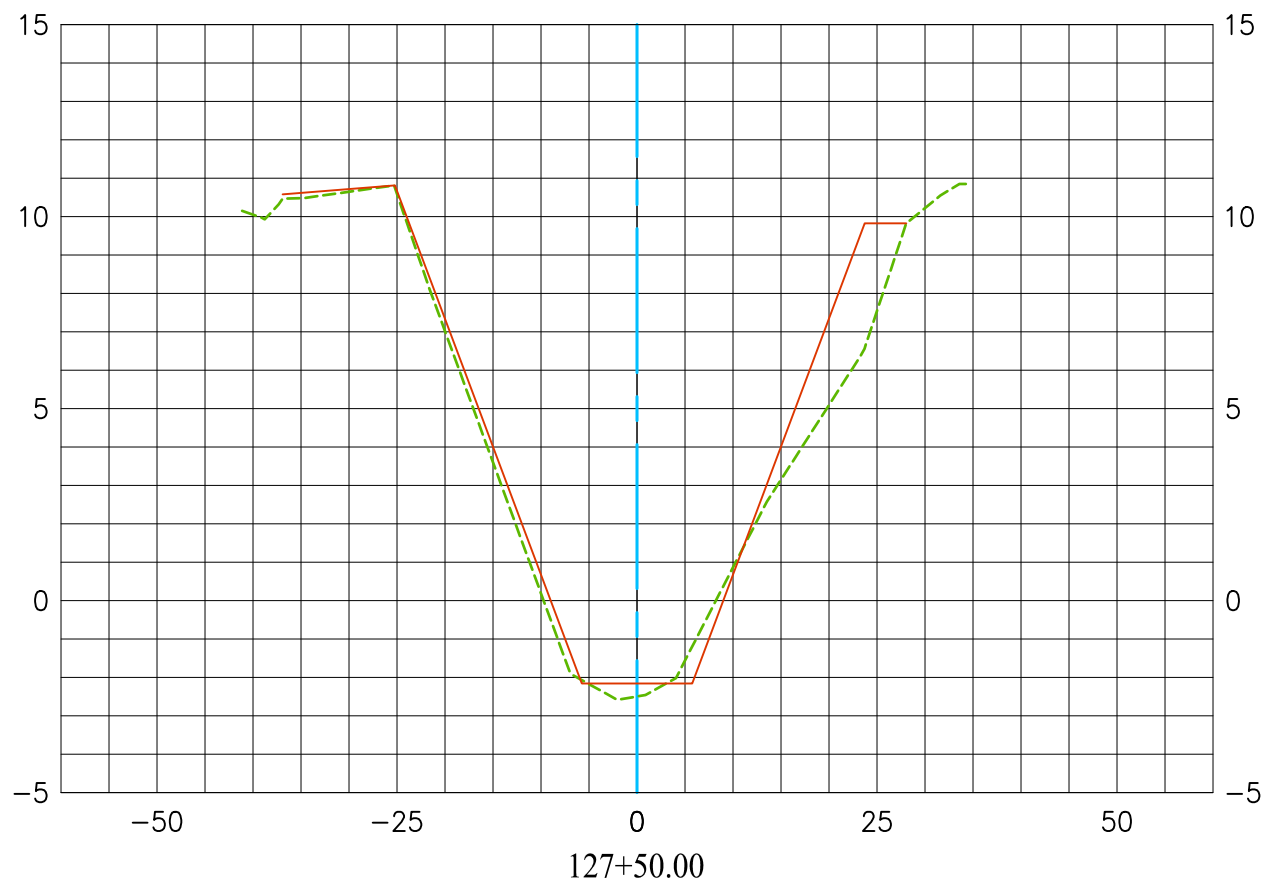


EXISTING CONDITION 2019  
MODIFIED RECORD PLAN C01-701-1-A  
DATED 01/23/2008  
DATE PREPARED: 08/02/2019



Vert. Scale: 1"=5'  
Hor. Scale: 1"=20'



## C01 LOS ALAMITOS CHANNEL CL

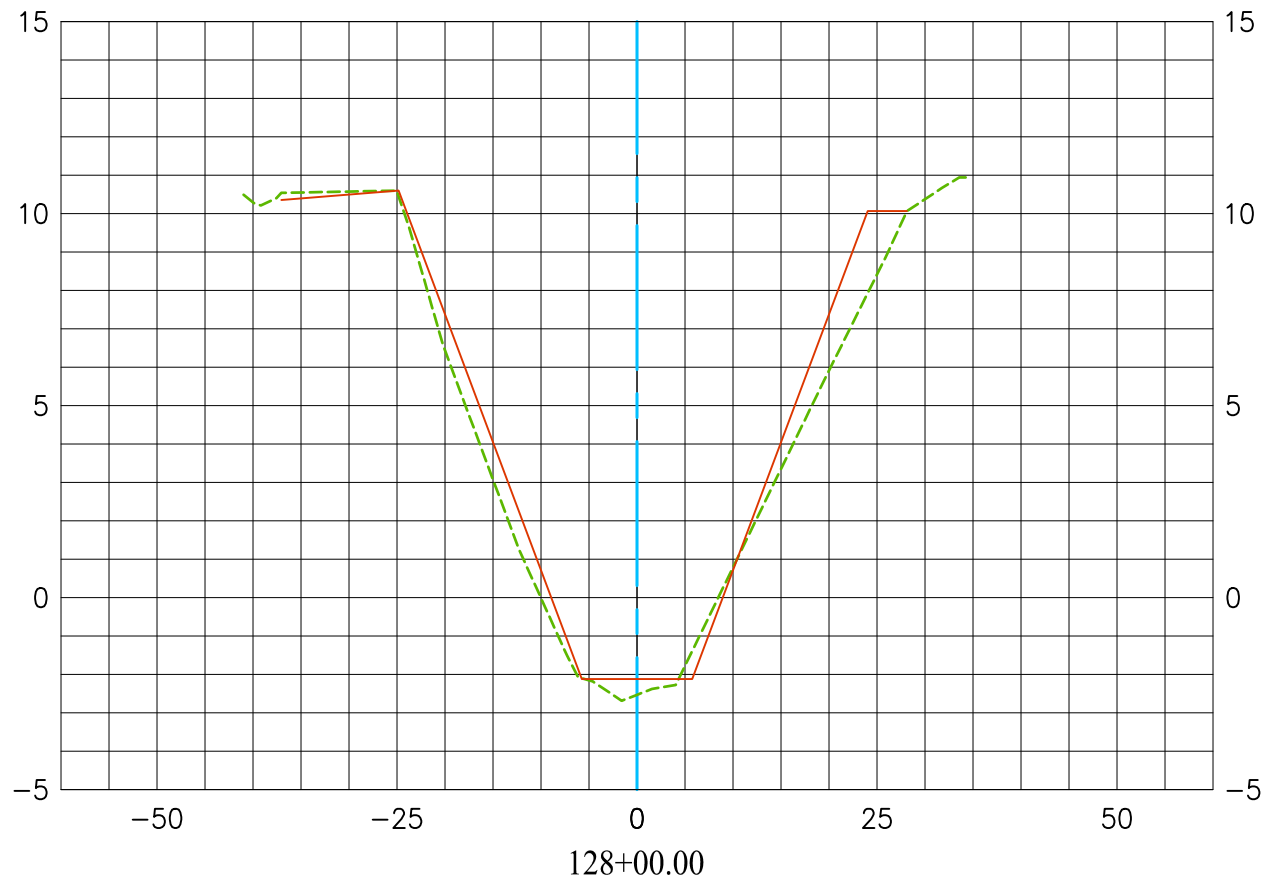


EXISTING CONDITION 2019  
MODIFIED RECORD PLAN C01-701-1-A  
DATED 01/23/2008  
DATE PREPARED: 08/02/2019



Vert. Scale: 1"=5'  
Hor. Scale: 1"=20'




# C01 LOS ALAMITOS CHANNEL CL

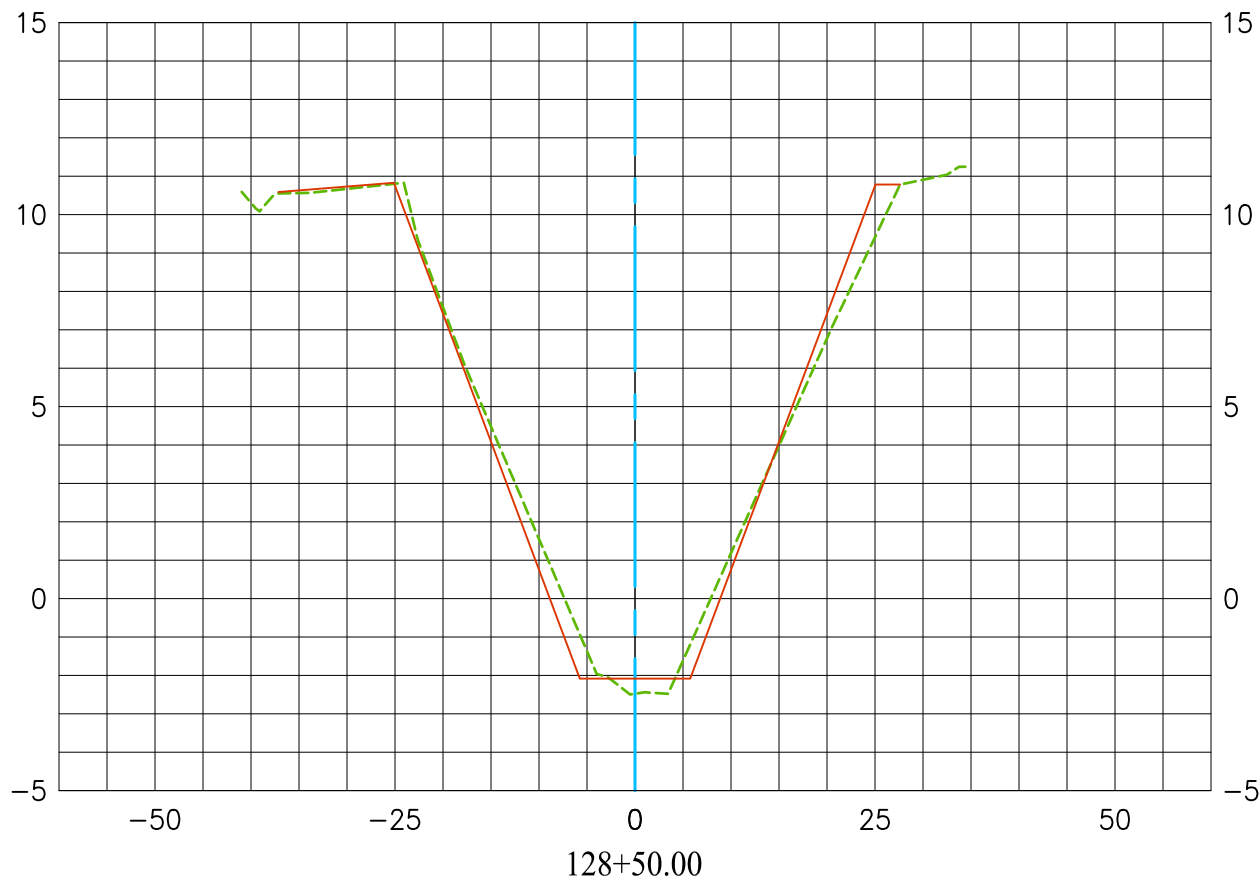

EXISTING CONDITION 2019  
 MODIFIED RECORD PLAN C01-701-1-A  
 DATED 01/23/2008  
 DATE PREPARED: 08/02/2019

Vert. Scale: 1"=5'  
 Hor. Scale: 1"=20'

# C01 LOS ALAMITOS CHANNEL CL

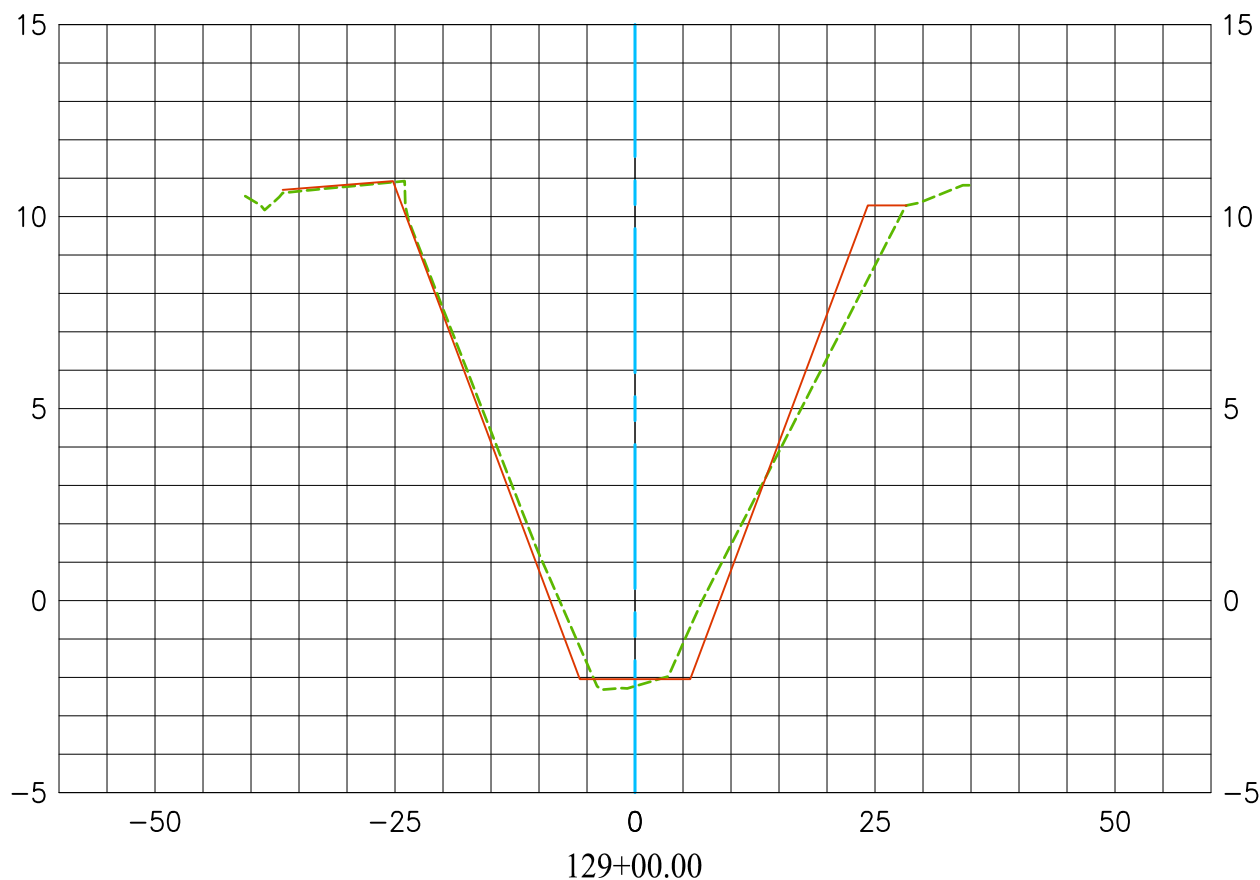


EXISTING CONDITION 2019  
 MODIFIED RECORD PLAN C01-701-1-A  
 DATED 01/23/2008  
 DATE PREPARED: 08/02/2019

---  
 ---

Vert. Scale: 1"=5'  
 Hor. Scale: 1"=20'


# C01 LOS ALAMITOS CHANNEL CL

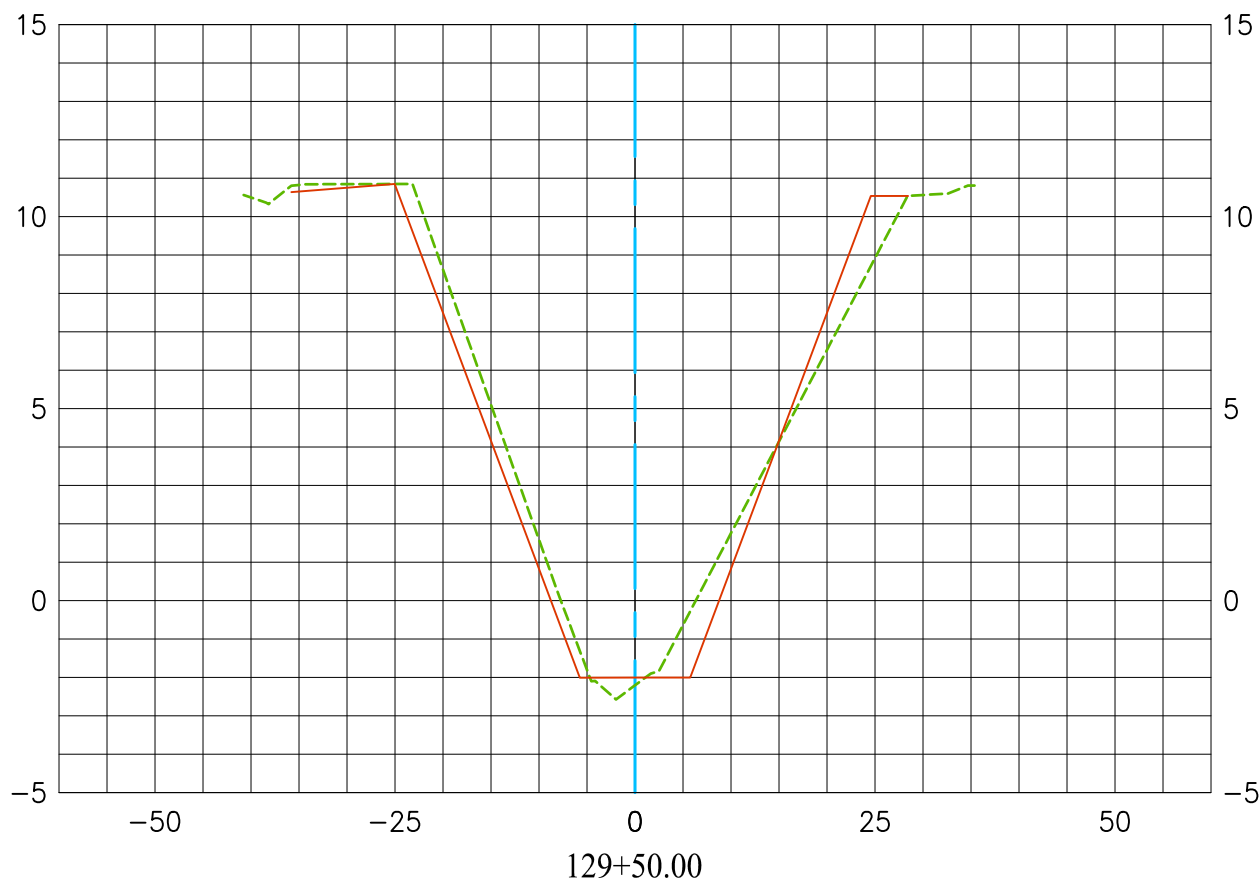

EXISTING CONDITION 2019  
 MODIFIED RECORD PLAN C01-701-1-A  
 DATED 01/23/2008  
 DATE PREPARED: 08/02/2019

Vert. Scale: 1"=5'  
 Hor. Scale: 1"=20'

# C01 LOS ALAMITOS CHANNEL CL

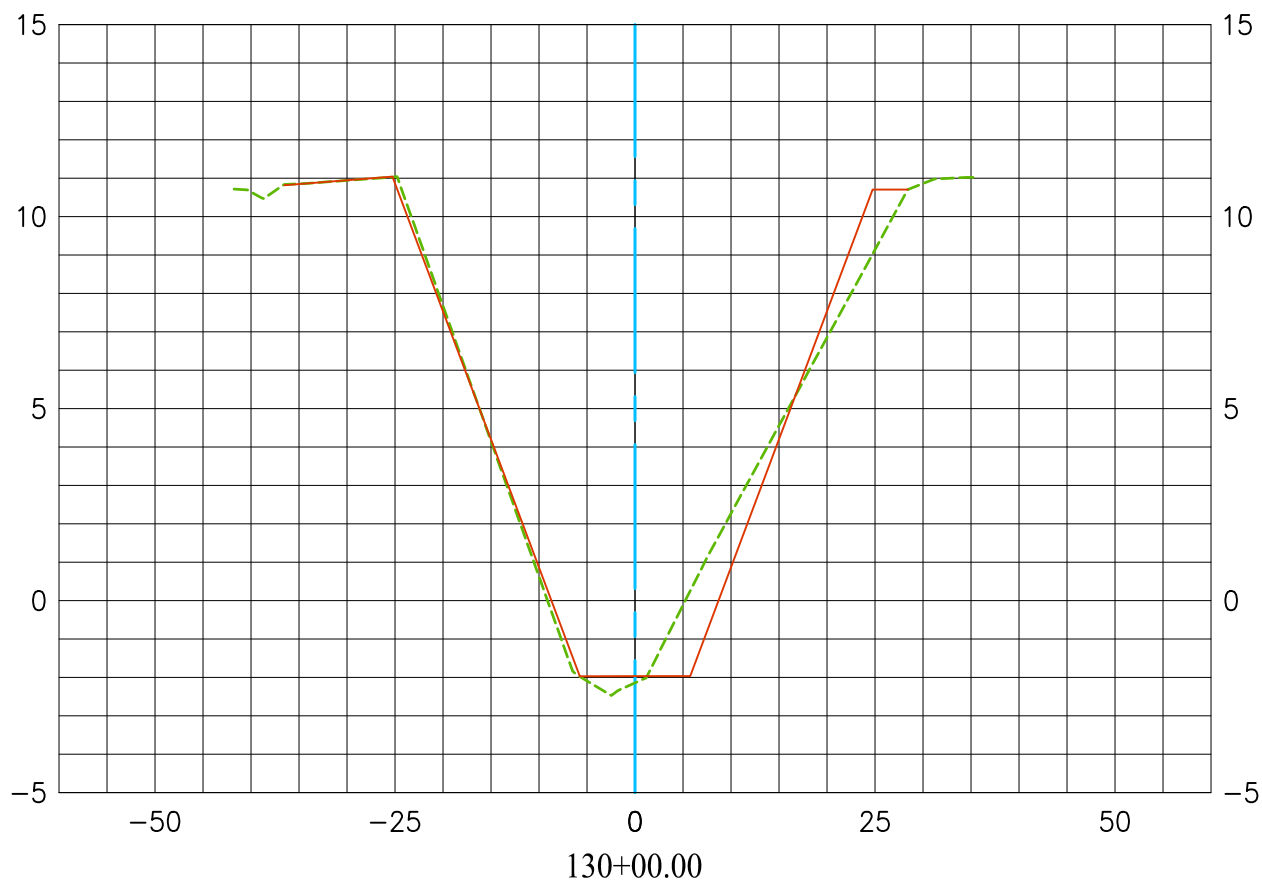


EXISTING CONDITION 2019  
 MODIFIED RECORD PLAN C01-701-1-A  
 DATED 01/23/2008  
 DATE PREPARED: 08/02/2019

---  
 —

Vert. Scale: 1"=5'  
 Hor. Scale: 1"=20'

## C01 LOS ALAMITOS CHANNEL CL

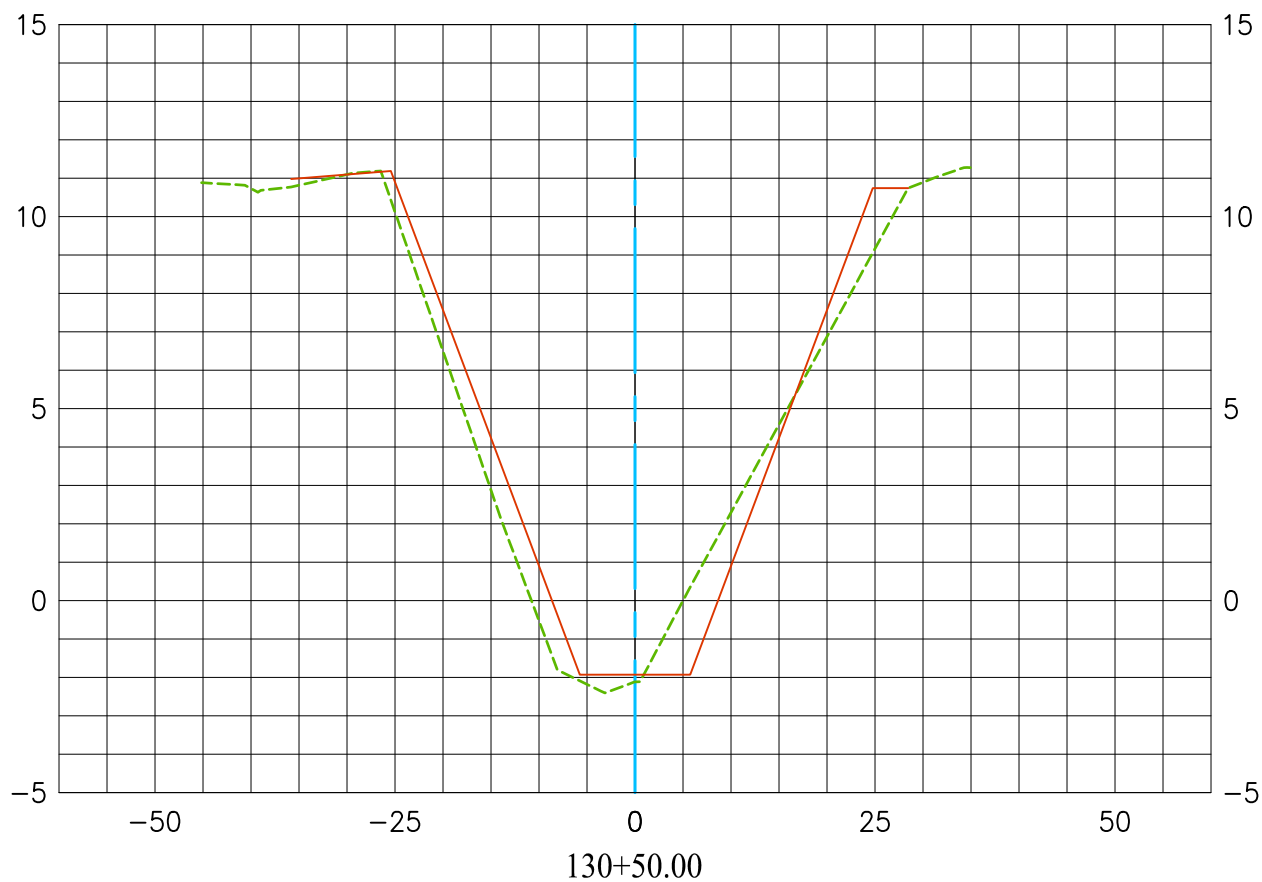


EXISTING CONDITION 2019  
 MODIFIED RECORD PLAN C01-701-1-A  
 DATED 01/23/2008  
 DATE PREPARED: 08/02/2019

---  
 ---

Vert. Scale: 1"=5'  
 Hor. Scale: 1"=20'




## C01 LOS ALAMITOS CHANNEL CL

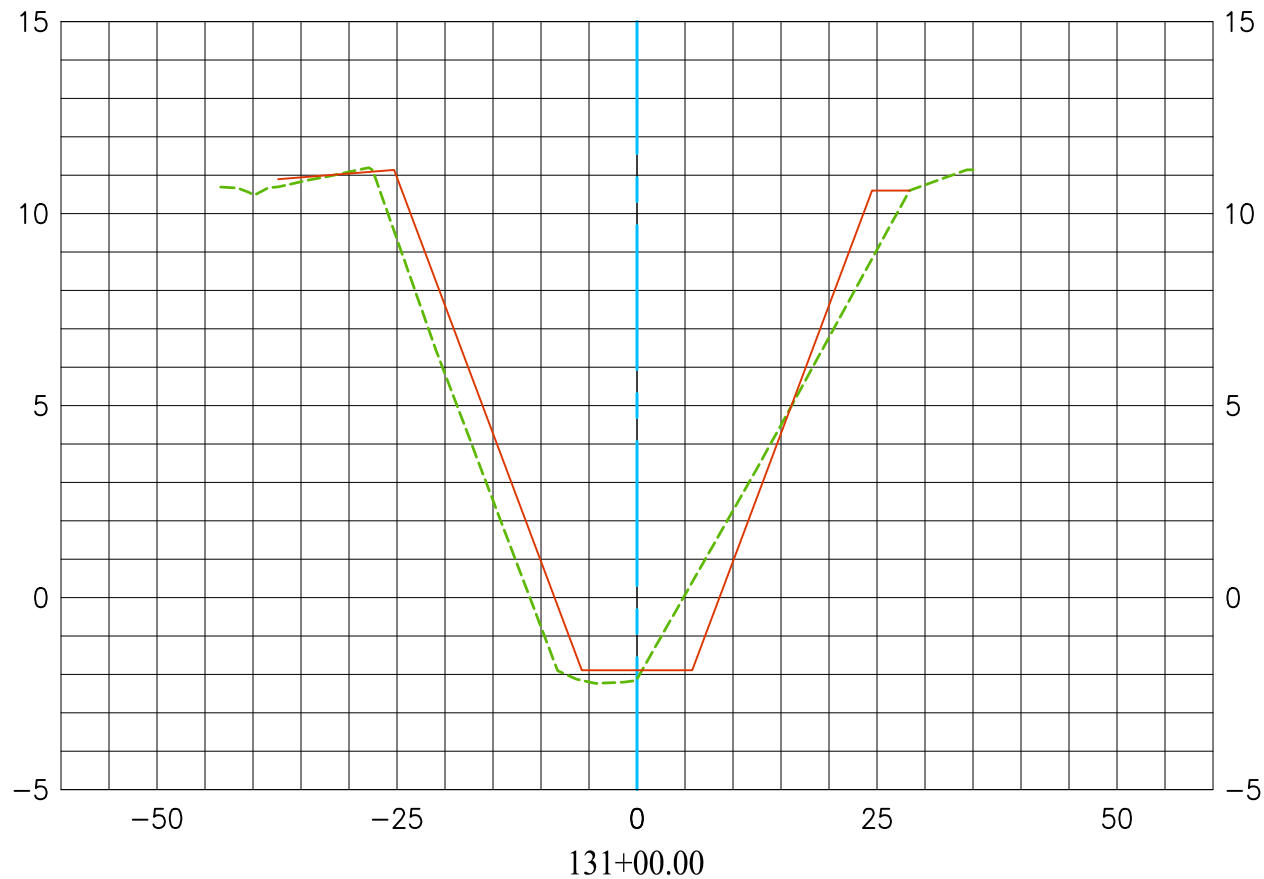

EXISTING CONDITION 2019  
MODIFIED RECORD PLAN C01-701-1-A  
DATED 01/23/2008  
DATE PREPARED: 08/02/2019

Vert. Scale: 1"=5'  
Hor. Scale: 1"=20'


# C01 LOS ALAMITOS CHANNEL CL

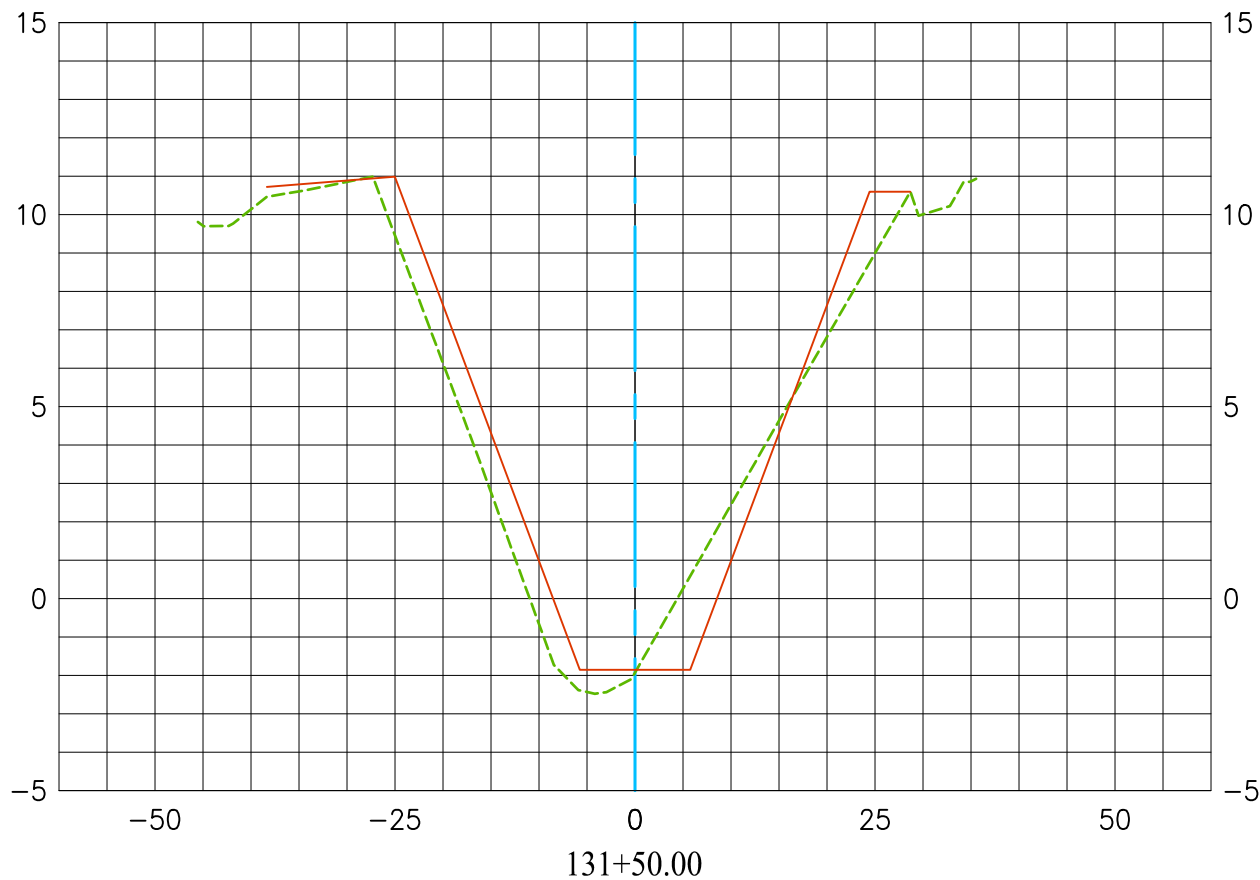

EXISTING CONDITION 2019  
 MODIFIED RECORD PLAN C01-701-1-A  
 DATED 01/23/2008  
 DATE PREPARED: 08/02/2019

Vert. Scale: 1"=5'  
 Hor. Scale: 1"=20'

## C01 LOS ALAMITOS CHANNEL CL

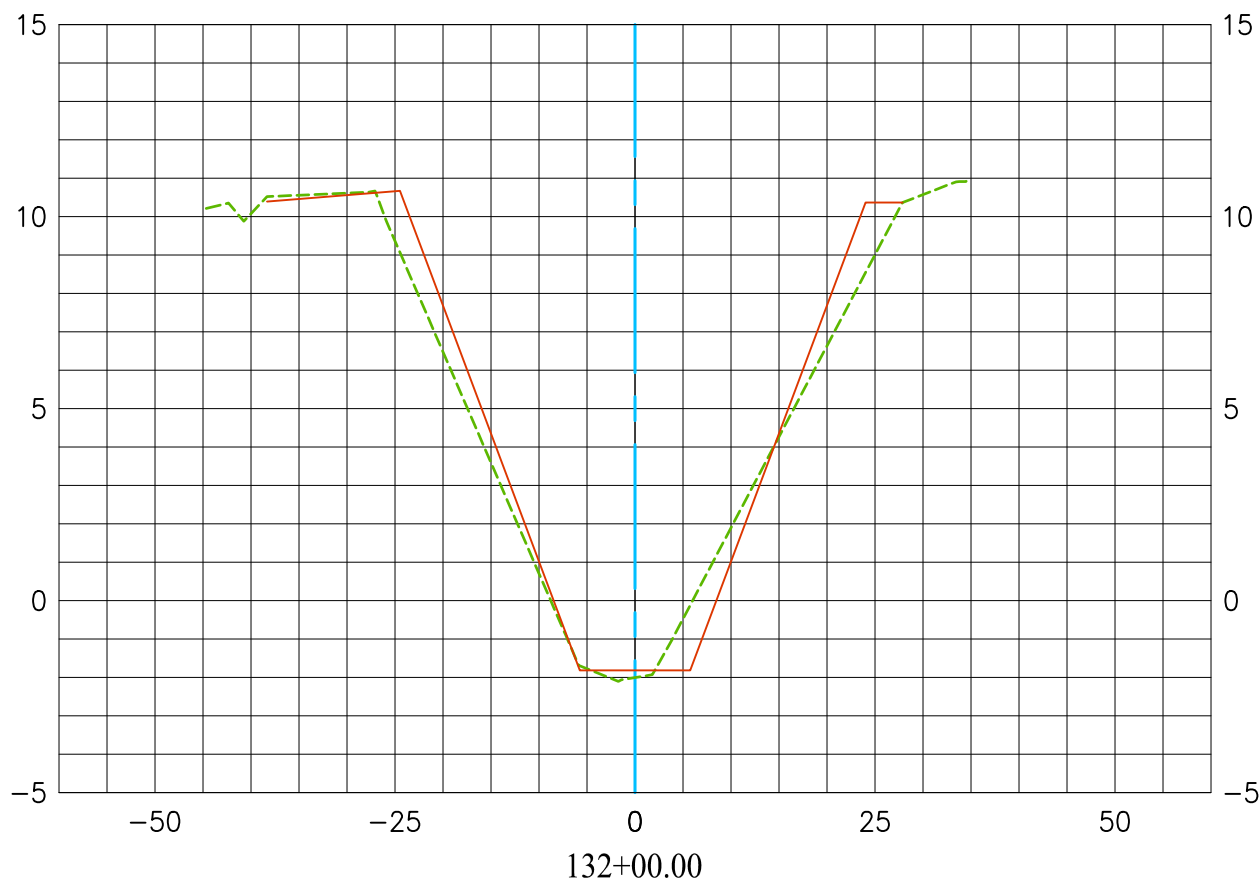


EXISTING CONDITION 2019  
MODIFIED RECORD PLAN C01-701-1-A  
DATED 01/23/2008  
DATE PREPARED: 08/02/2019

---  
---

Vert. Scale: 1"=5'  
Hor. Scale: 1"=20'



# C01 LOS ALAMITOS CHANNEL CL

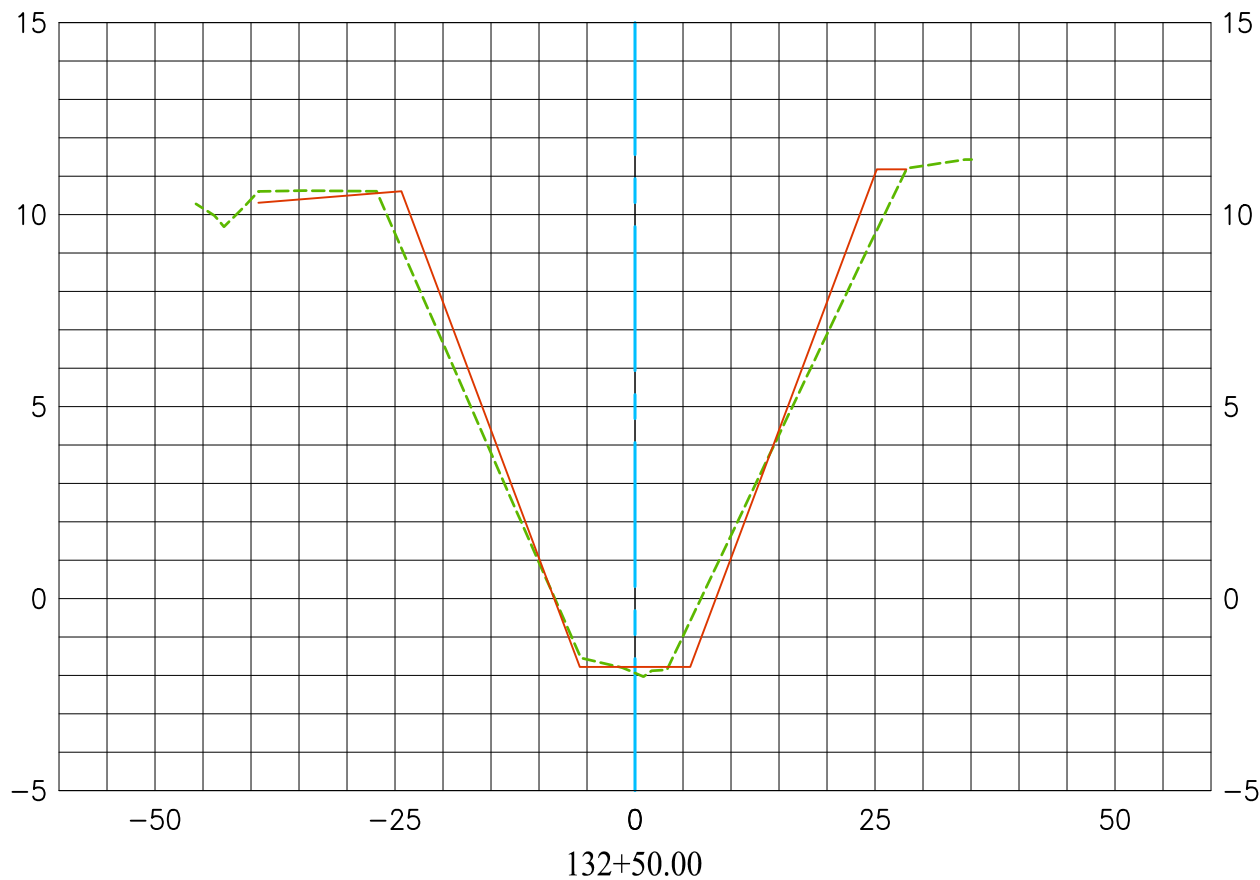


EXISTING CONDITION 2019  
 MODIFIED RECORD PLAN C01-701-1-A  
 DATED 01/23/2008  
 DATE PREPARED: 08/02/2019

Vert. Scale: 1"=5'  
 Hor. Scale: 1"=20'



## C01 LOS ALAMITOS CHANNEL CL

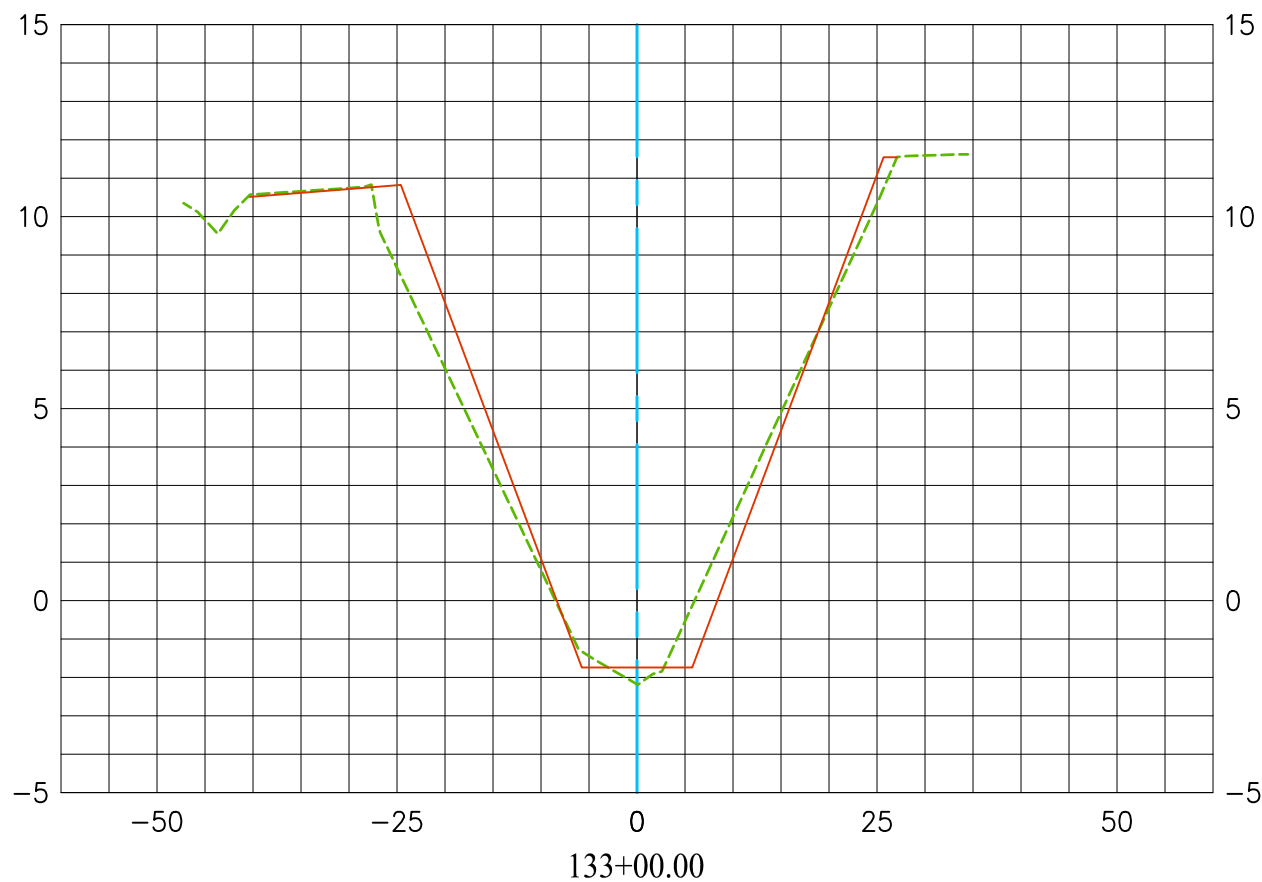


EXISTING CONDITION 2019  
MODIFIED RECORD PLAN C01-701-1-A  
DATED 01/23/2008  
DATE PREPARED: 08/02/2019



Vert. Scale: 1"=5'  
Hor. Scale: 1"=20'

## C01 LOS ALAMITOS CHANNEL CL

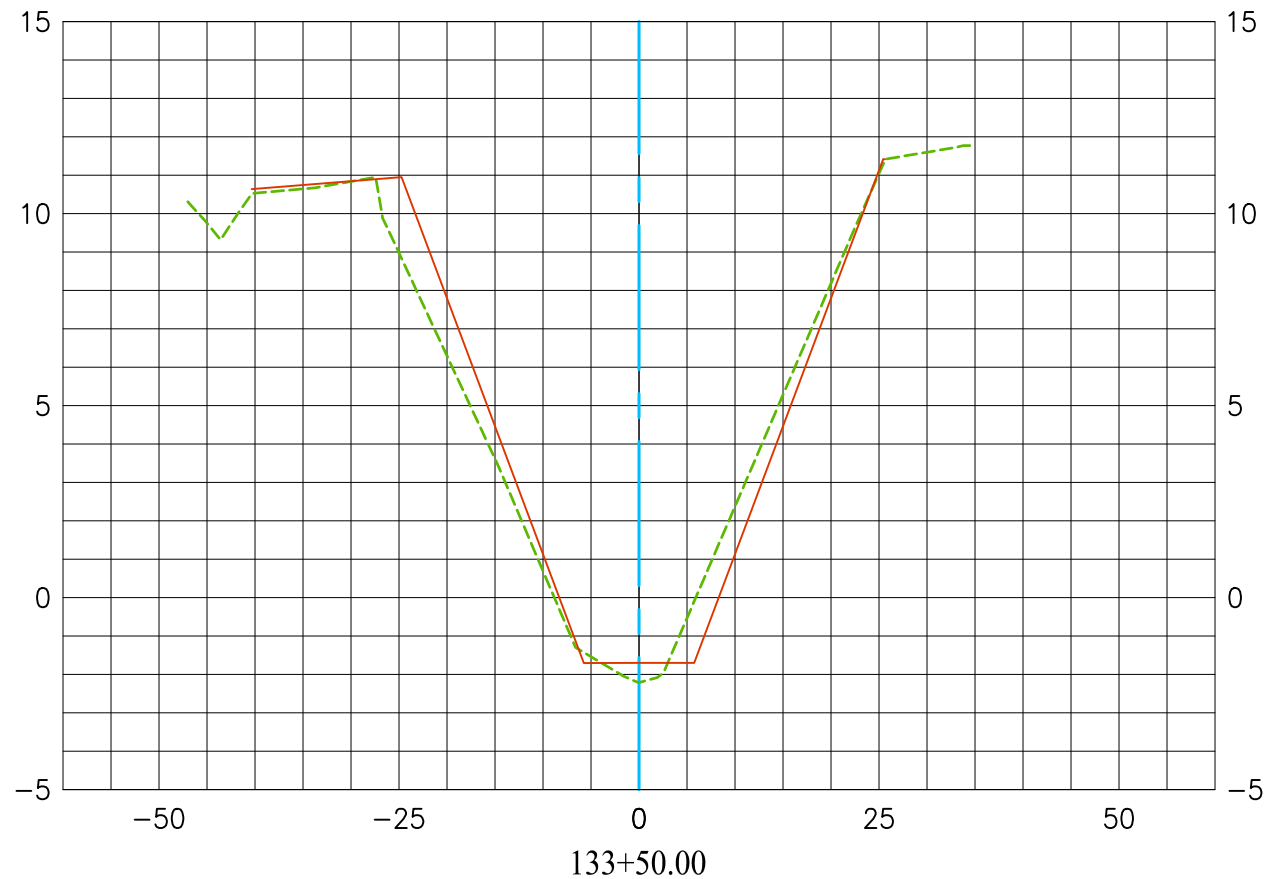


EXISTING CONDITION 2019  
 MODIFIED RECORD PLAN C01-701-1-A  
 DATED 01/23/2008  
 DATE PREPARED: 08/02/2019



Vert. Scale: 1"=5'  
 Hor. Scale: 1"=20'



## C01 LOS ALAMITOS CHANNEL CL

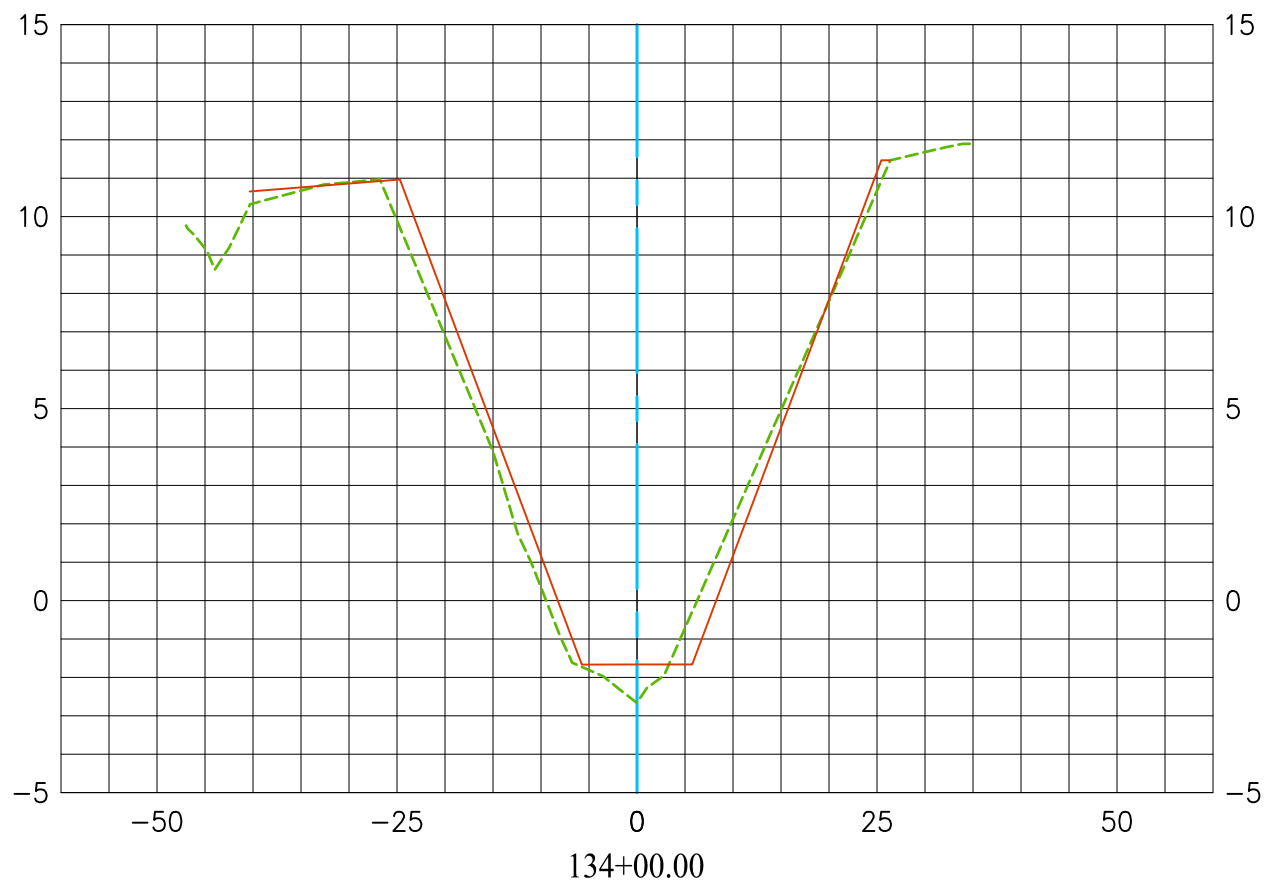


EXISTING CONDITION 2019  
MODIFIED RECORD PLAN C01-701-1-A  
DATED 01/23/2008  
DATE PREPARED: 08/02/2019



Vert. Scale: 1"=5'  
Hor. Scale: 1"=20'

## C01 LOS ALAMITOS CHANNEL CL

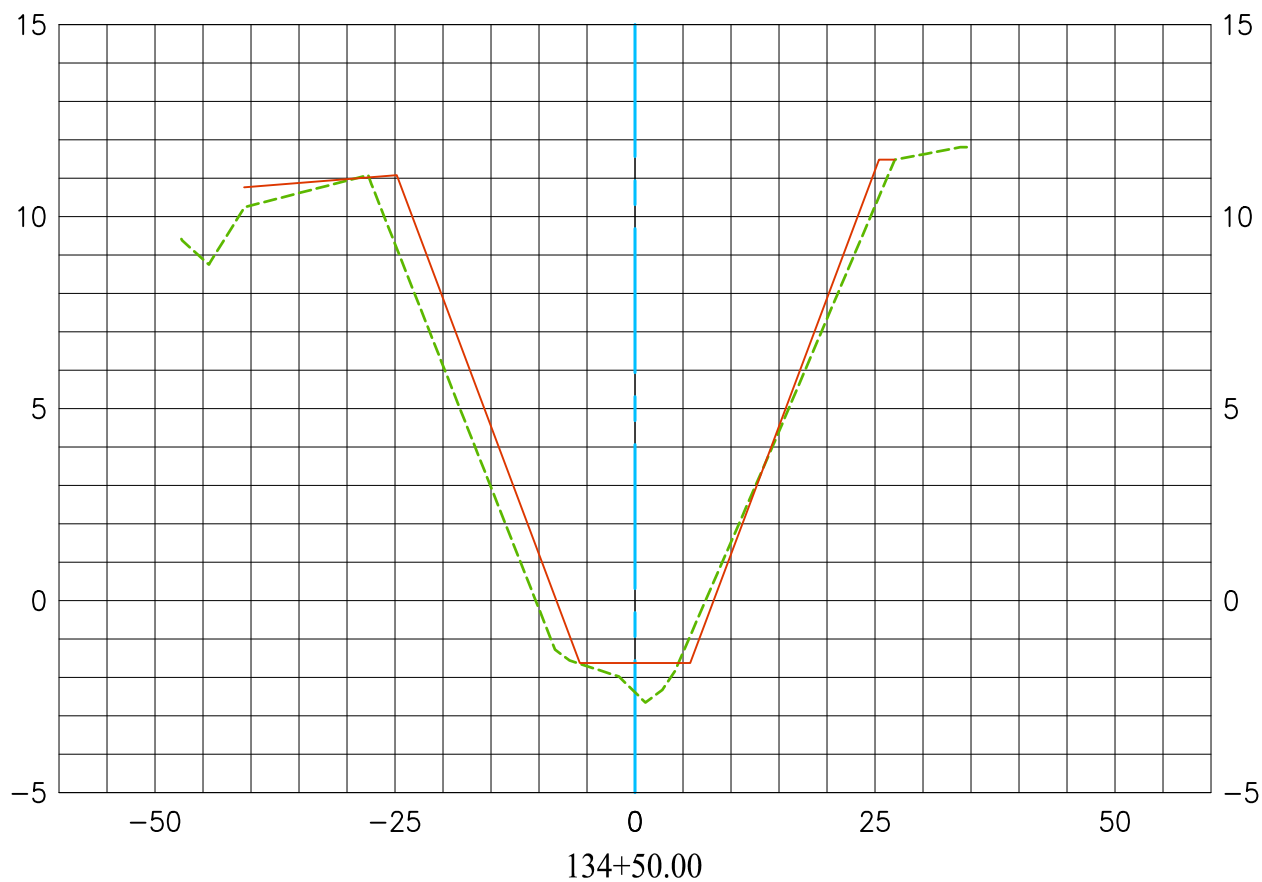


EXISTING CONDITION 2019  
 MODIFIED RECORD PLAN C01-701-1-A  
 DATED 01/23/2008  
 DATE PREPARED: 08/02/2019

---  
 ---

Vert. Scale: 1"=5'  
 Hor. Scale: 1"=20'

## C01 LOS ALAMITOS CHANNEL CL

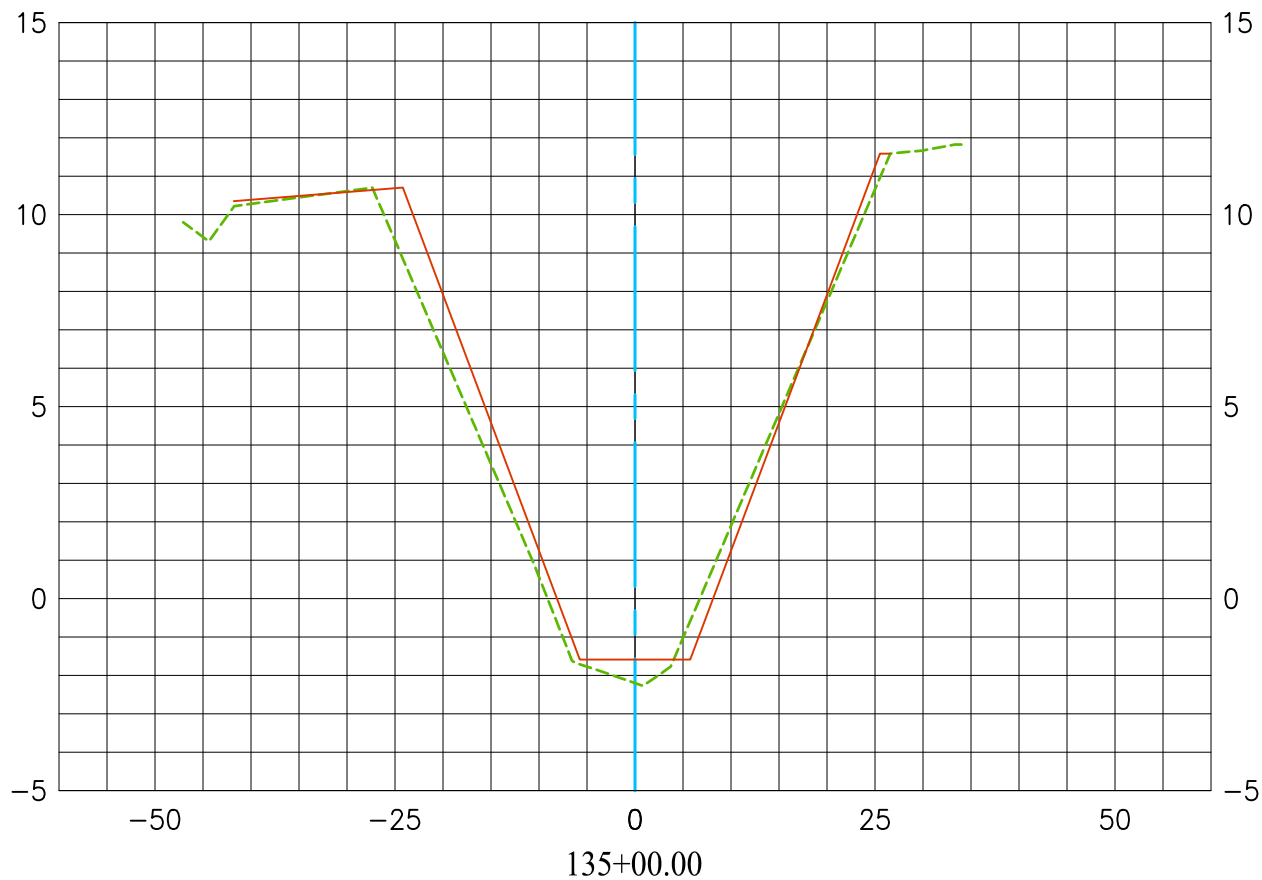


EXISTING CONDITION 2019  
 MODIFIED RECORD PLAN C01-701-1-A  
 DATED 01/23/2008  
 DATE PREPARED: 08/02/2019

---  
 ---

Vert. Scale: 1"=5'  
 Hor. Scale: 1"=20'




## C01 LOS ALAMITOS CHANNEL CL

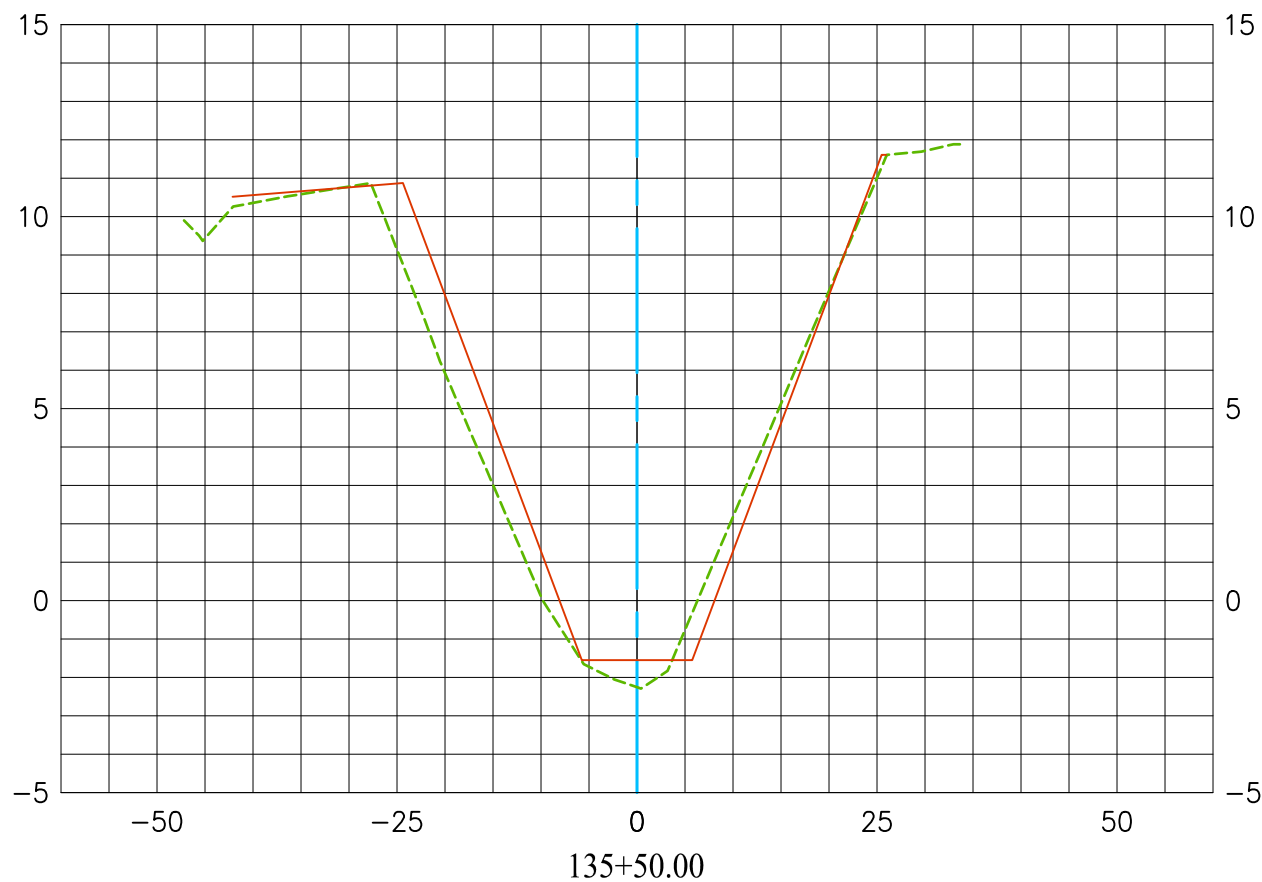


EXISTING CONDITION 2019  
MODIFIED RECORD PLAN C01-701-1-A  
DATED 01/23/2008  
DATE PREPARED: 08/02/2019

Vert. Scale: 1"=5'  
Hor. Scale: 1"=20'

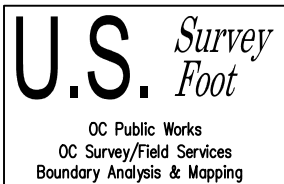

# C01 LOS ALAMITOS CHANNEL CL

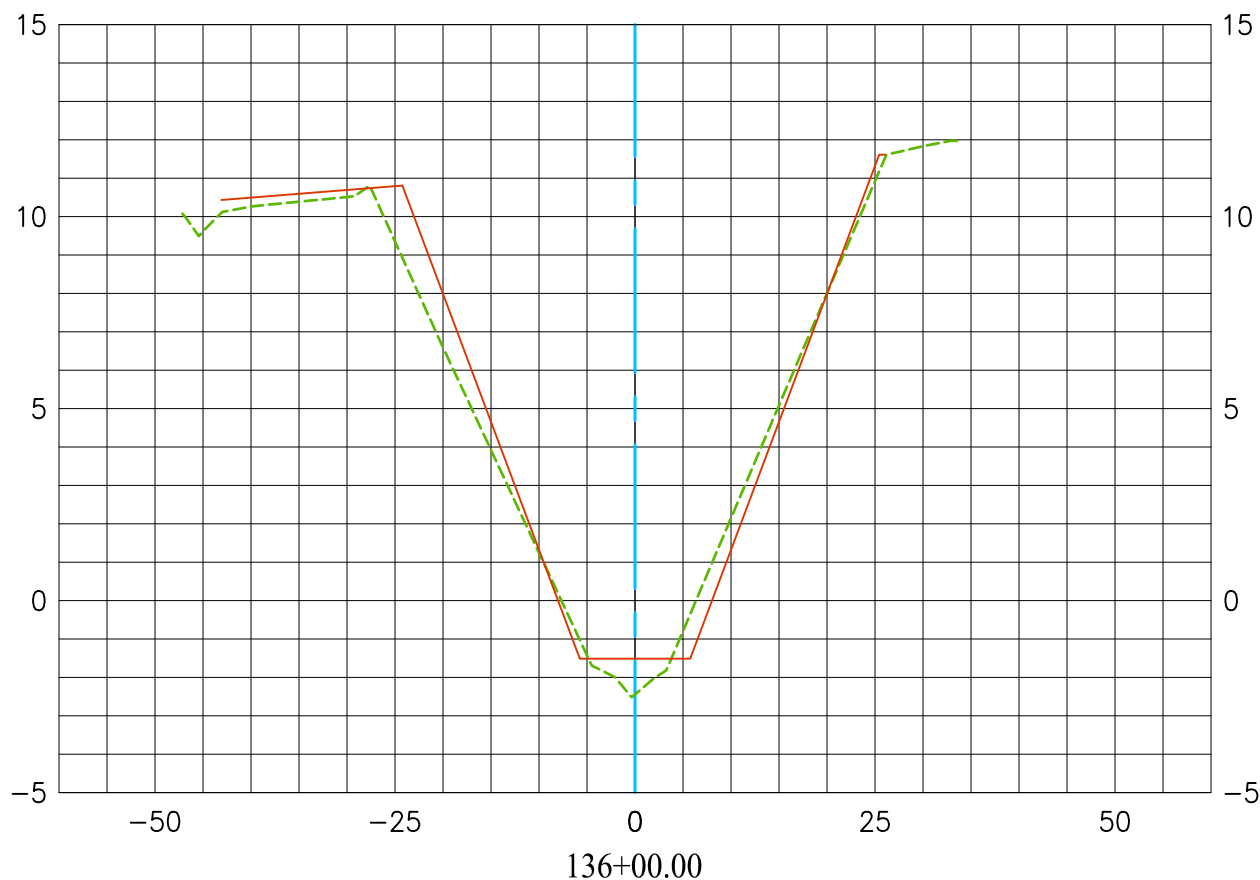


EXISTING CONDITION 2019  
MODIFIED RECORD PLAN C01-701-1-A  
DATED 01/23/2008  
DATE PREPARED: 08/02/2019

Vert. Scale: 1"=5'  
Hor. Scale: 1"=20'



## C01 LOS ALAMITOS CHANNEL CL

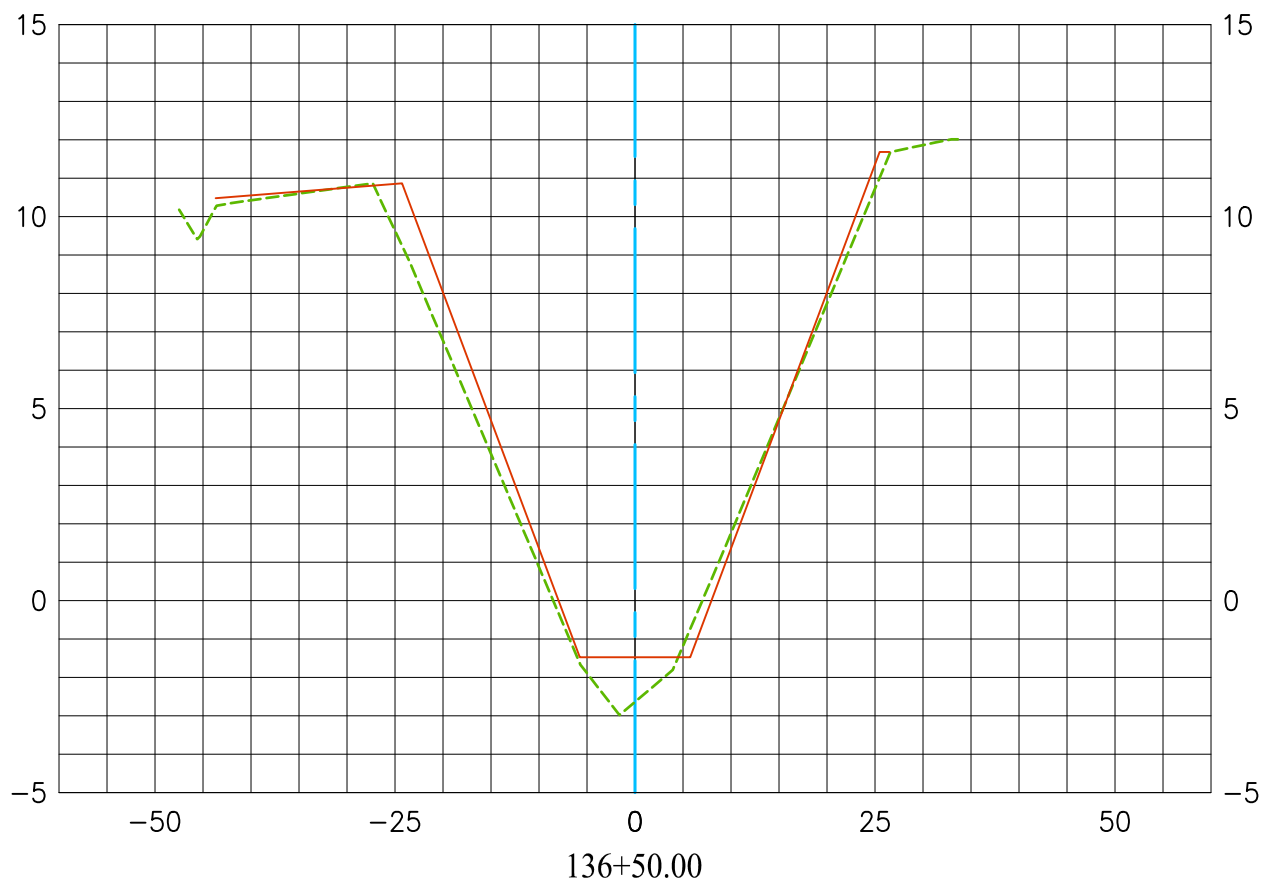


EXISTING CONDITION 2019  
 MODIFIED RECORD PLAN C01-701-1-A  
 DATED 01/23/2008  
 DATE PREPARED: 08/02/2019

---  
 —

Vert. Scale: 1"=5'  
 Hor. Scale: 1"=20'




## C01 LOS ALAMITOS CHANNEL CL

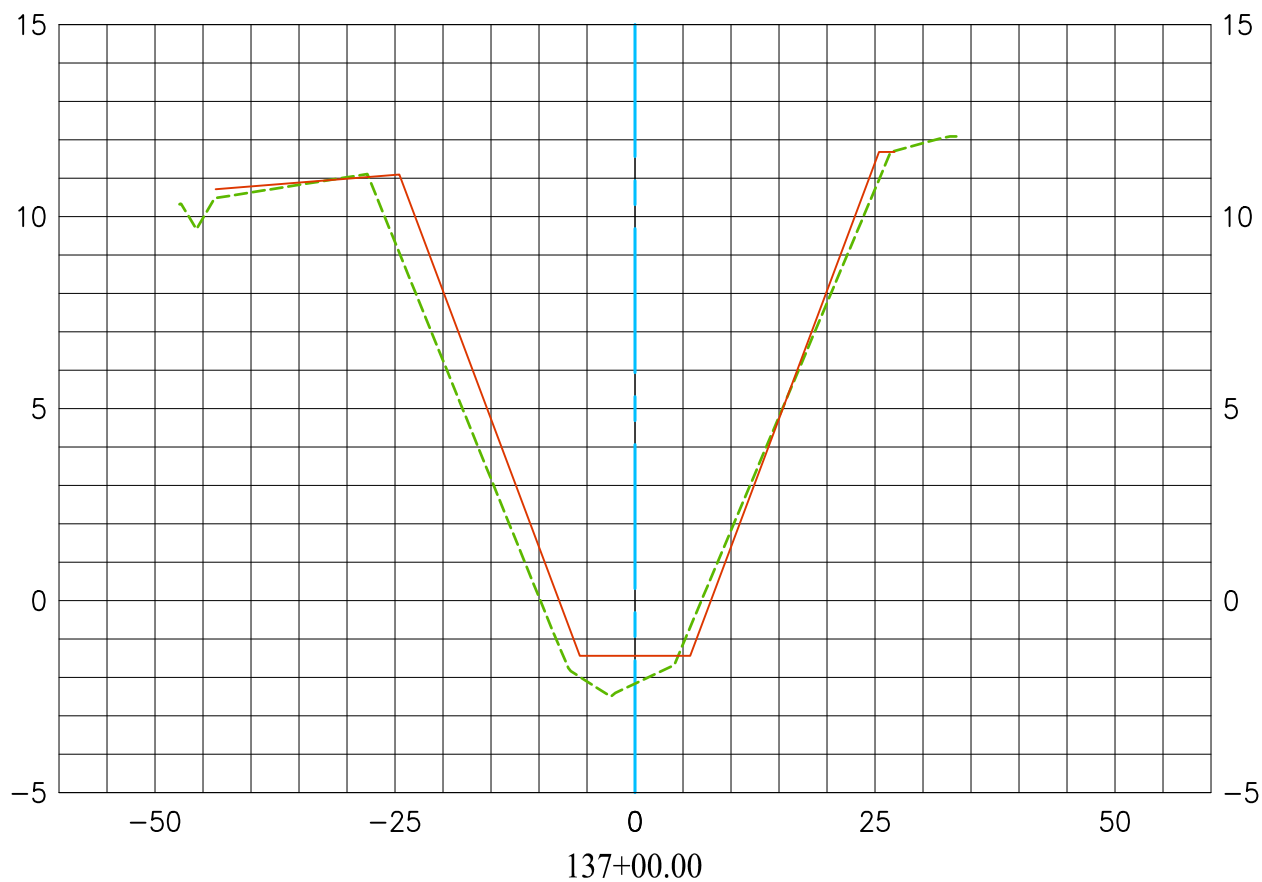

EXISTING CONDITION 2019  
MODIFIED RECORD PLAN C01-701-1-A  
DATED 01/23/2008  
DATE PREPARED: 08/02/2019

Vert. Scale: 1"=5'  
Hor. Scale: 1"=20'

# C01 LOS ALAMITOS CHANNEL CL

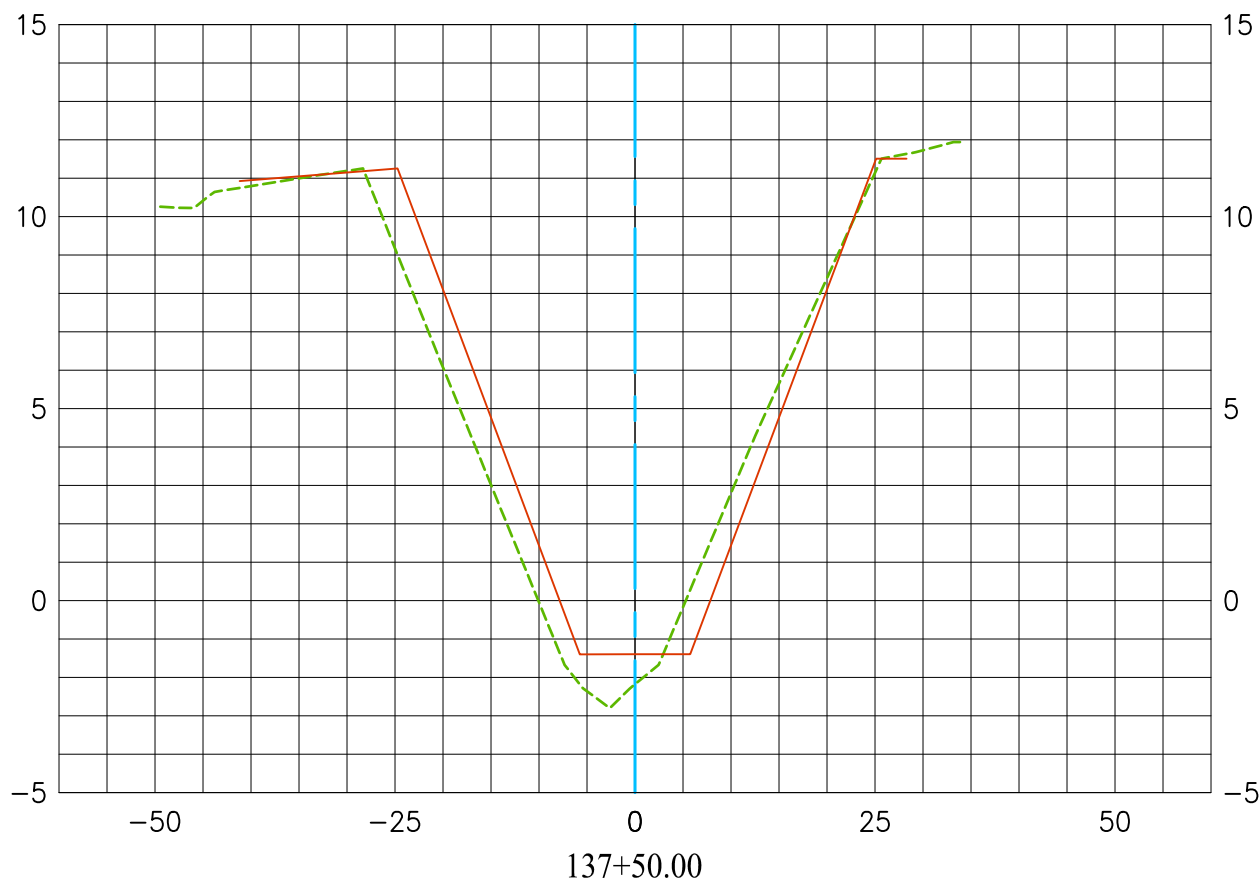


EXISTING CONDITION 2019  
 MODIFIED RECORD PLAN C01-701-1-A  
 DATED 01/23/2008  
 DATE PREPARED: 08/02/2019

Vert. Scale: 1"=5'  
 Hor. Scale: 1"=20'



## C01 LOS ALAMITOS CHANNEL CL

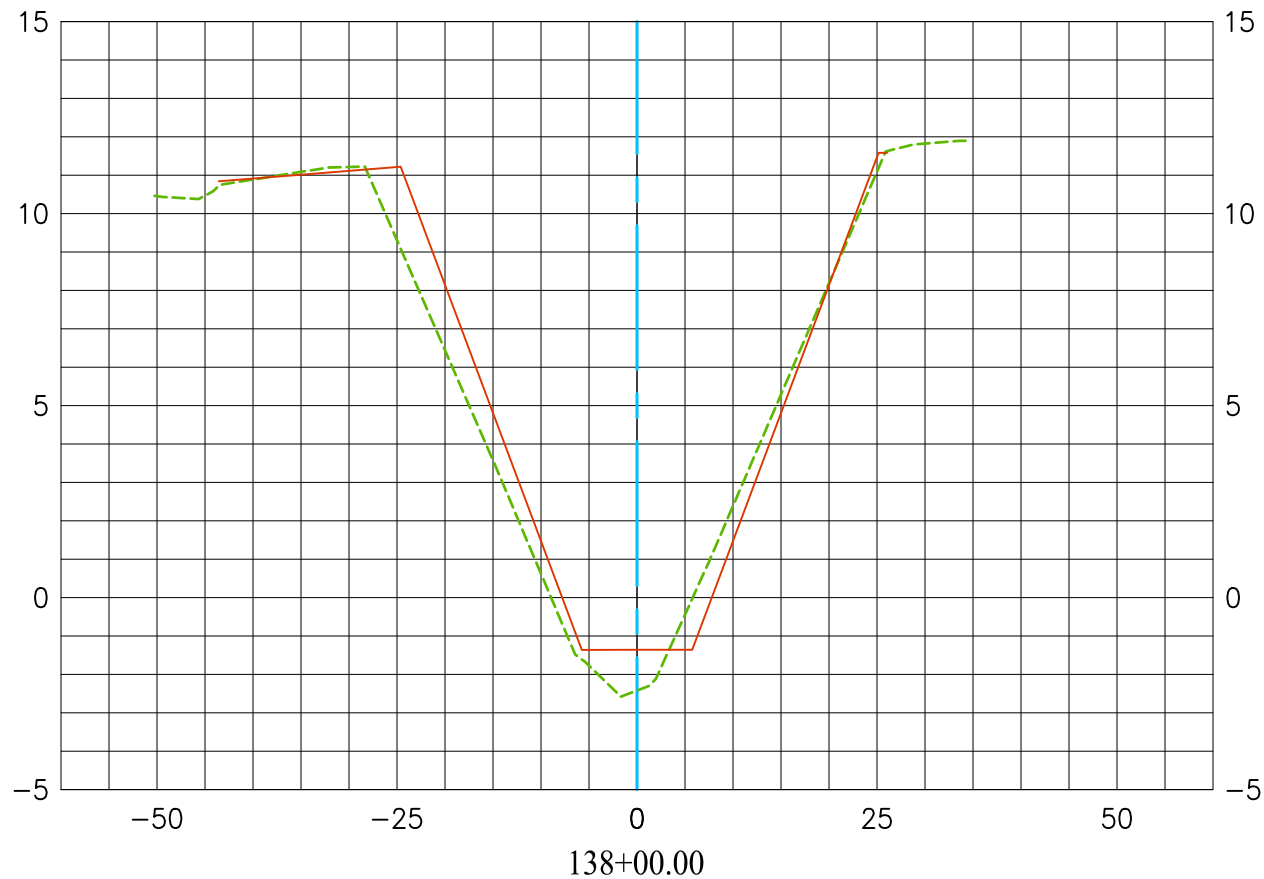


EXISTING CONDITION 2019  
MODIFIED RECORD PLAN C01-701-1-A  
DATED 01/23/2008  
DATE PREPARED: 08/02/2019



Vert. Scale: 1"=5'  
Hor. Scale: 1"=20'

## C01 LOS ALAMITOS CHANNEL CL

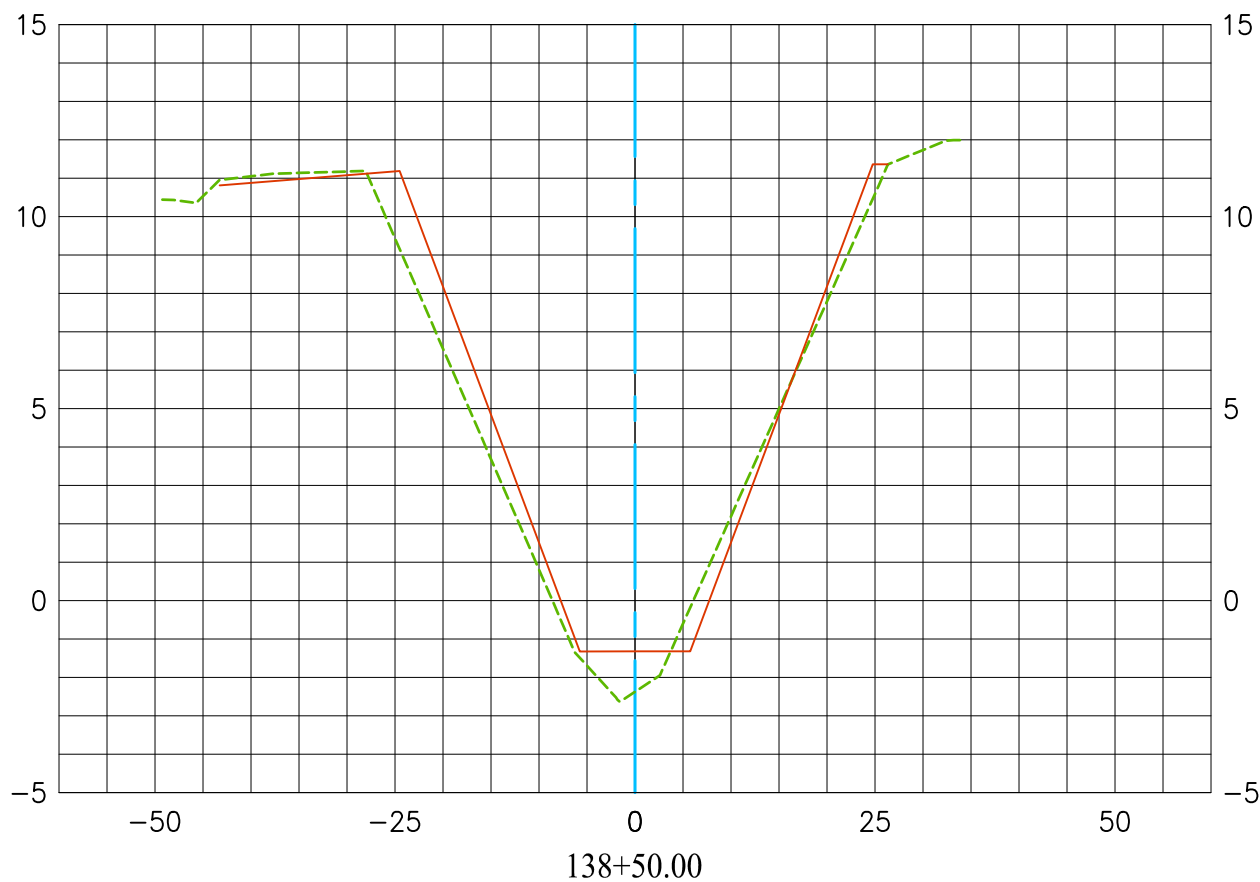


EXISTING CONDITION 2019  
 MODIFIED RECORD PLAN C01-701-1-A  
 DATED 01/23/2008  
 DATE PREPARED: 08/02/2019

---  
 —

Vert. Scale: 1"=5'  
 Hor. Scale: 1"=20'



## C01 LOS ALAMITOS CHANNEL CL

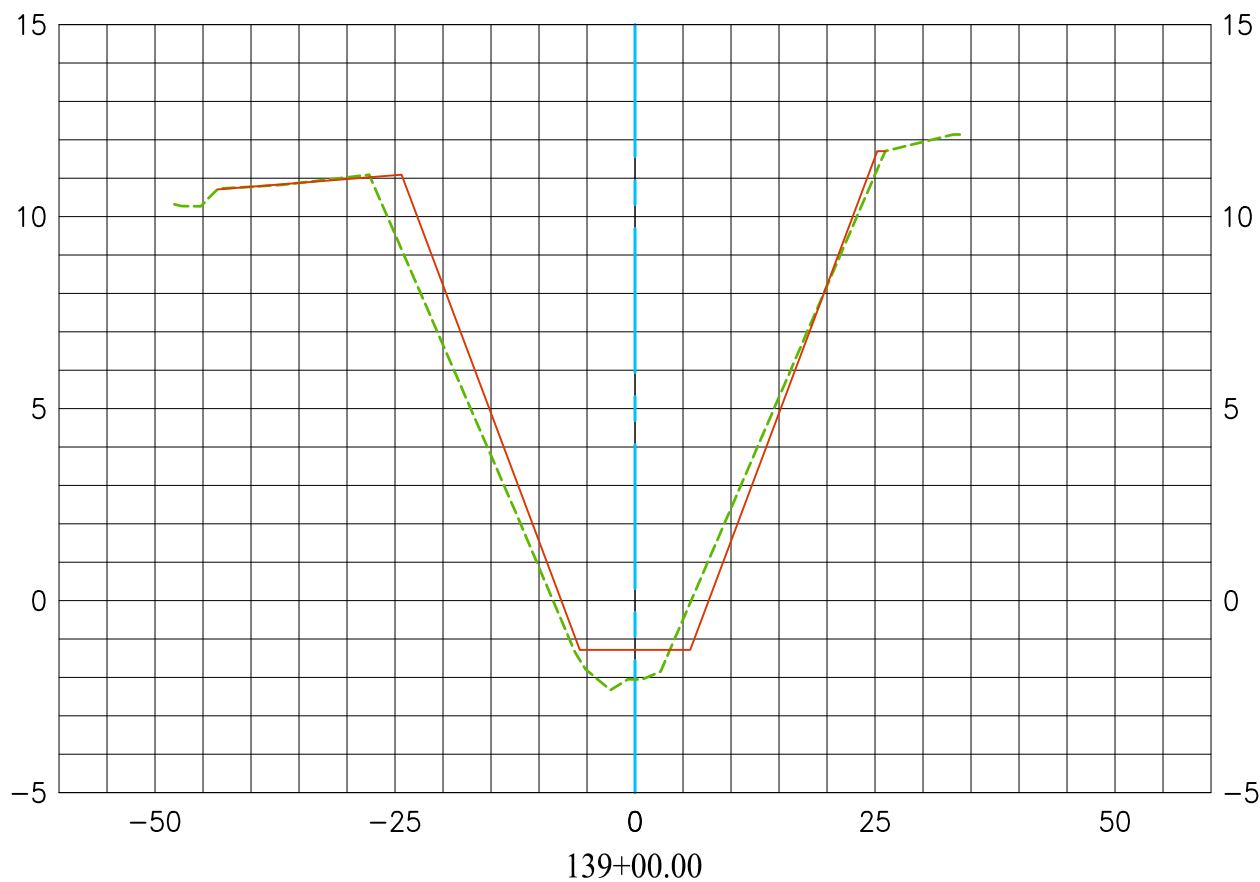


EXISTING CONDITION 2019  
 MODIFIED RECORD PLAN C01-701-1-A  
 DATED 01/23/2008  
 DATE PREPARED: 08/02/2019

---  
 —

Vert. Scale: 1"=5'  
 Hor. Scale: 1"=20'

# C01 LOS ALAMITOS CHANNEL CL

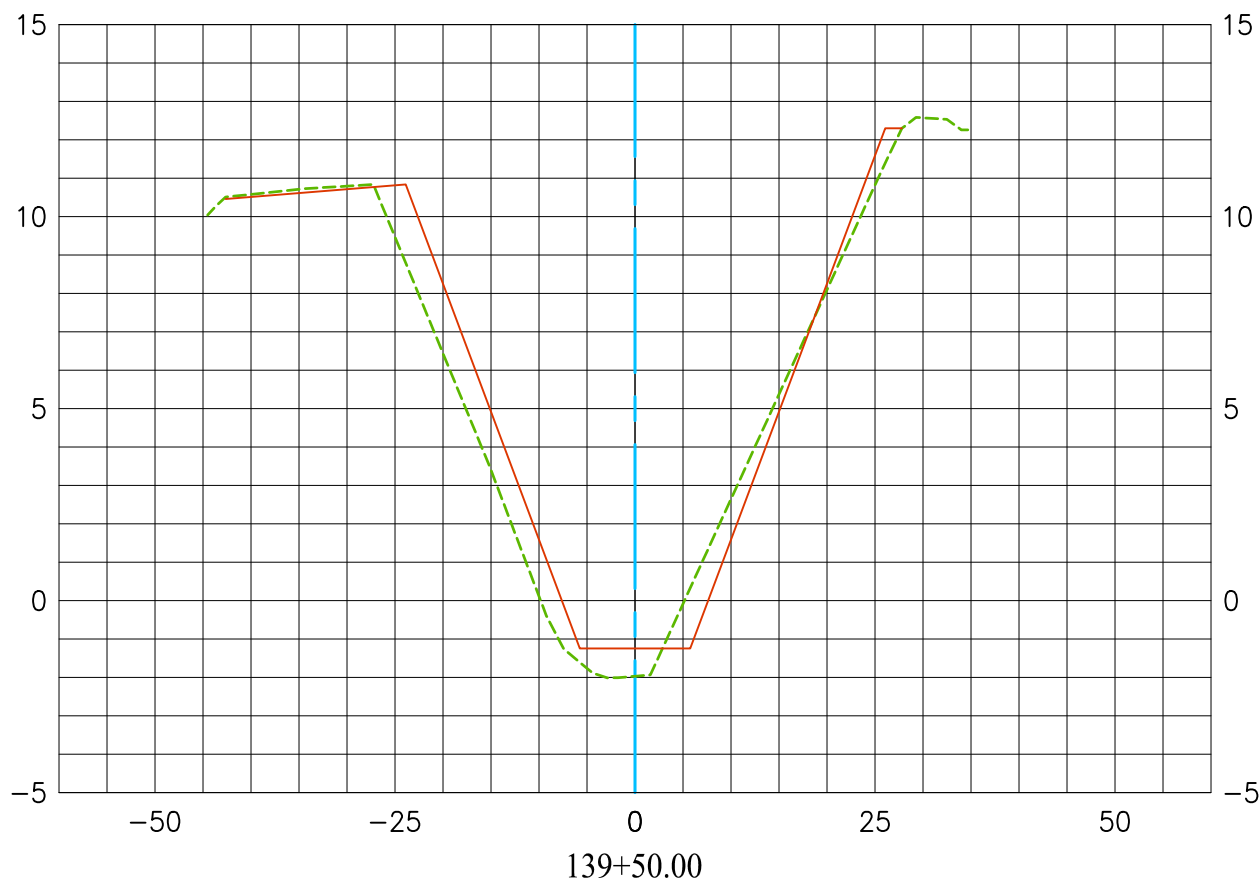


EXISTING CONDITION 2019  
 MODIFIED RECORD PLAN C01-701-1-A  
 DATED 01/23/2008  
 DATE PREPARED: 08/02/2019

---  
 —

Vert. Scale: 1"=5'  
 Hor. Scale: 1"=20'

## C01 LOS ALAMITOS CHANNEL CL

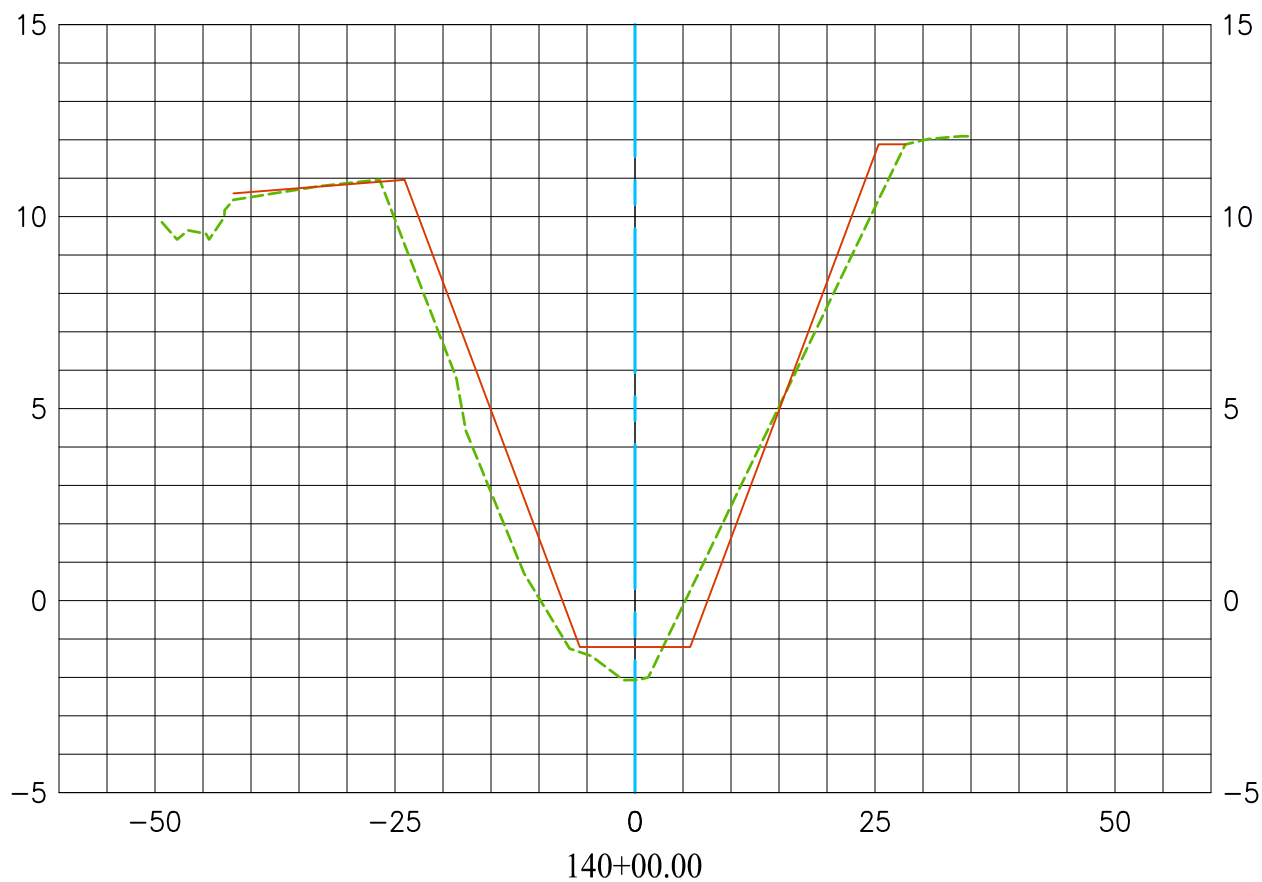


EXISTING CONDITION 2019  
 MODIFIED RECORD PLAN C01-701-1-A  
 DATED 01/23/2008  
 DATE PREPARED: 08/02/2019

---  
 —

Vert. Scale: 1"=5'  
 Hor. Scale: 1"=20'



## C01 LOS ALAMITOS CHANNEL CL

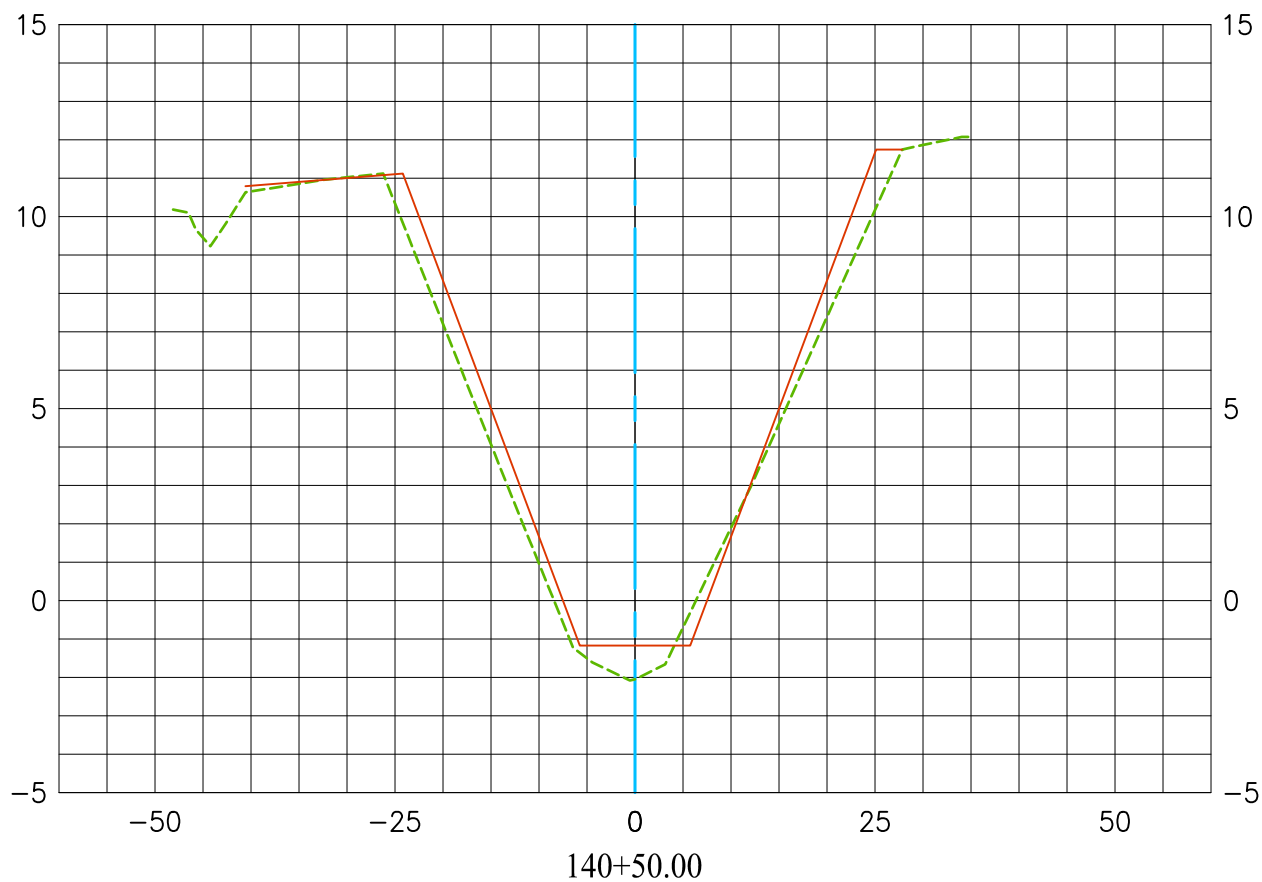


EXISTING CONDITION 2019  
 MODIFIED RECORD PLAN C01-701-1-A  
 DATED 01/23/2008  
 DATE PREPARED: 08/02/2019



Vert. Scale: 1"=5'  
 Hor. Scale: 1"=20'


# C01 LOS ALAMITOS CHANNEL CL

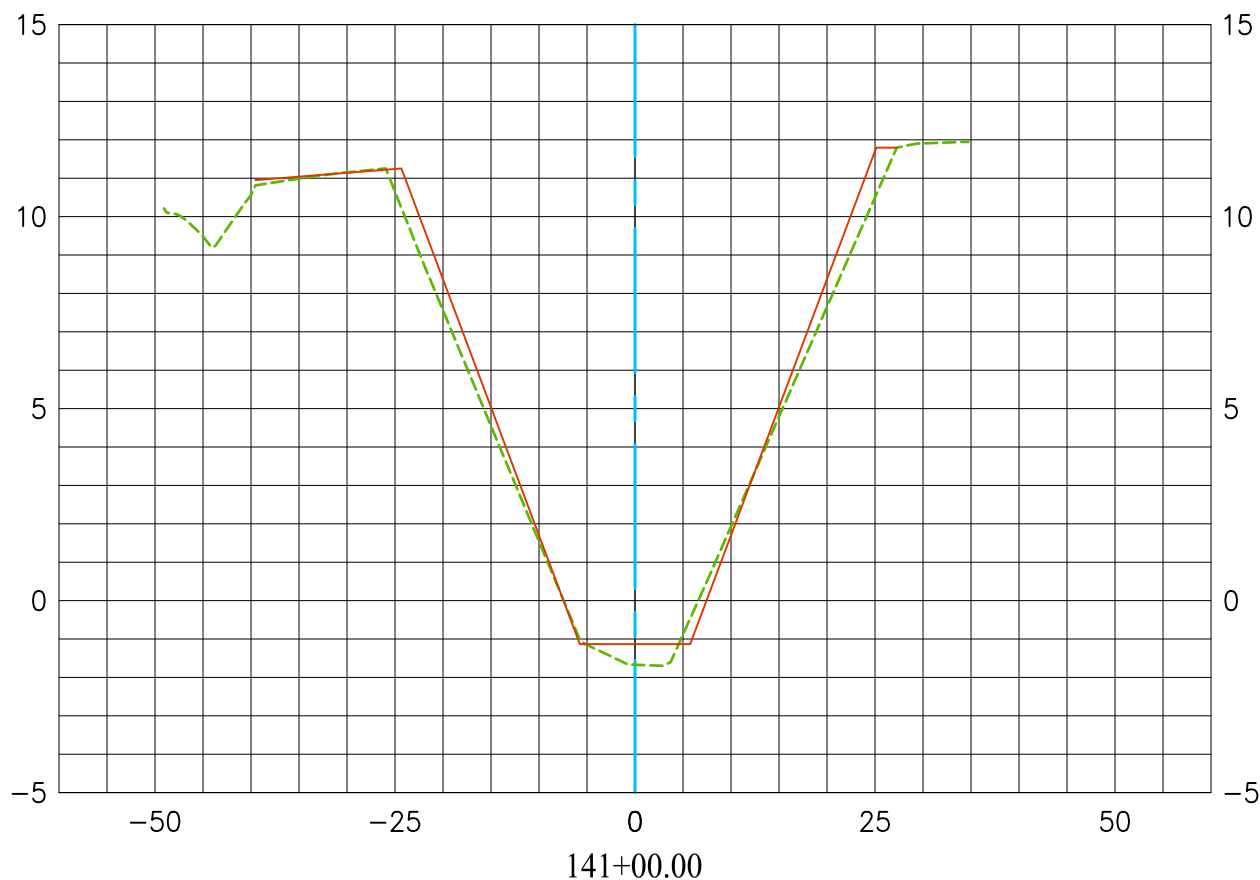

EXISTING CONDITION 2019  
 MODIFIED RECORD PLAN C01-701-1-A  
 DATED 01/23/2008  
 DATE PREPARED: 08/02/2019

Vert. Scale: 1"=5'  
 Hor. Scale: 1"=20'

## C01 LOS ALAMITOS CHANNEL CL

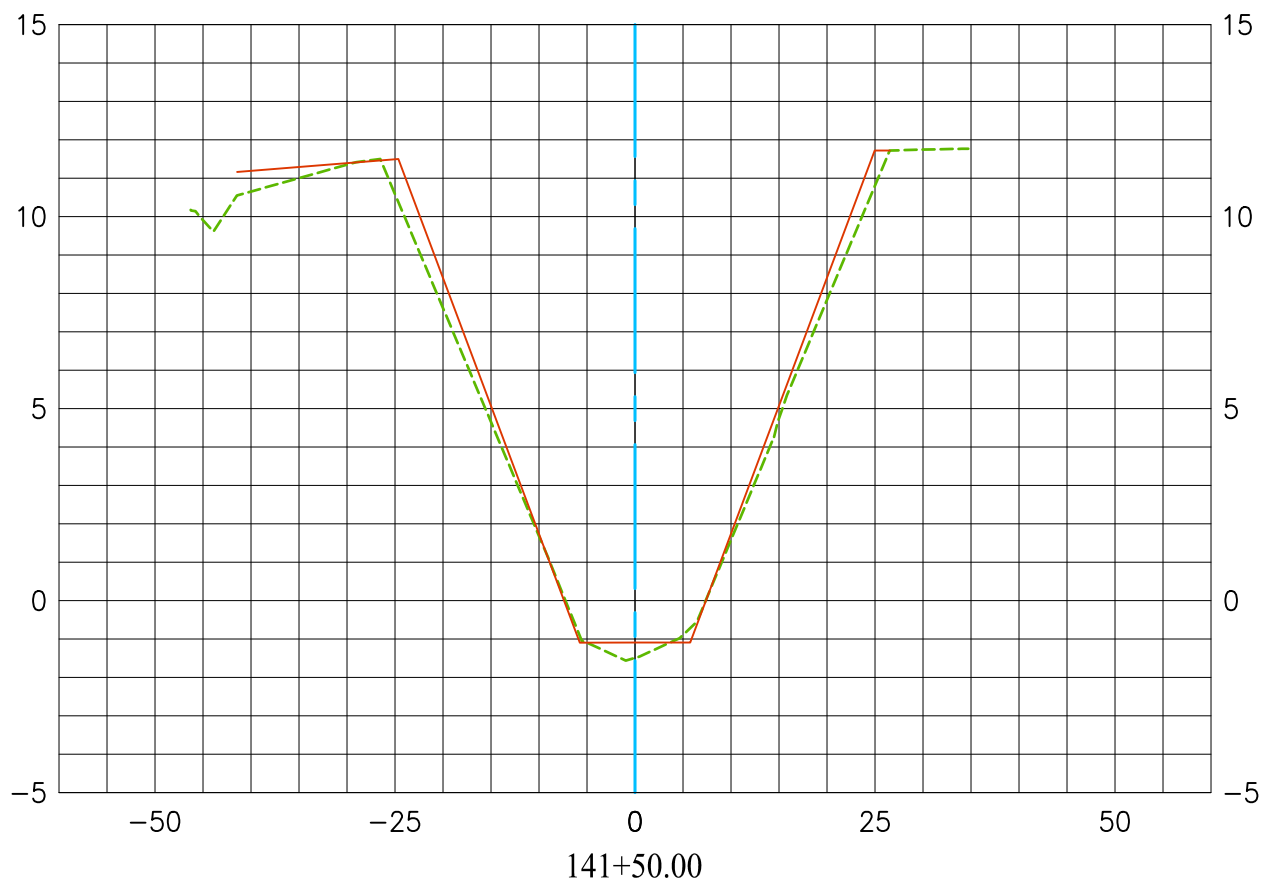


EXISTING CONDITION 2019  
 MODIFIED RECORD PLAN C01-701-1-A  
 DATED 01/23/2008  
 DATE PREPARED: 08/02/2019

---  
 —

Vert. Scale: 1"=5'  
 Hor. Scale: 1"=20'

# C01 LOS ALAMITOS CHANNEL CL

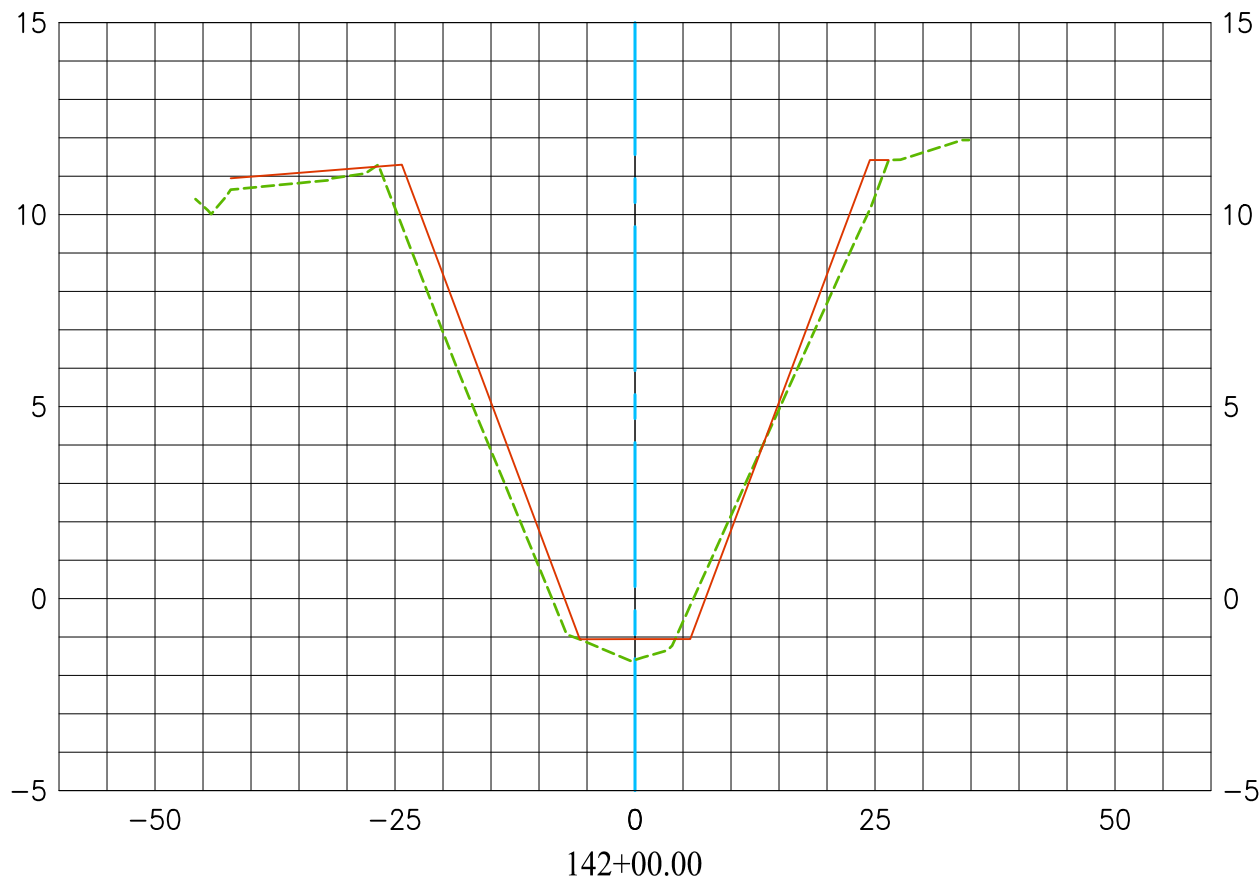


EXISTING CONDITION 2019  
 MODIFIED RECORD PLAN C01-701-1-A  
 DATED 01/23/2008  
 DATE PREPARED: 08/02/2019

---  
 ---

Vert. Scale: 1"=5'  
 Hor. Scale: 1"=20'

## C01 LOS ALAMITOS CHANNEL CL

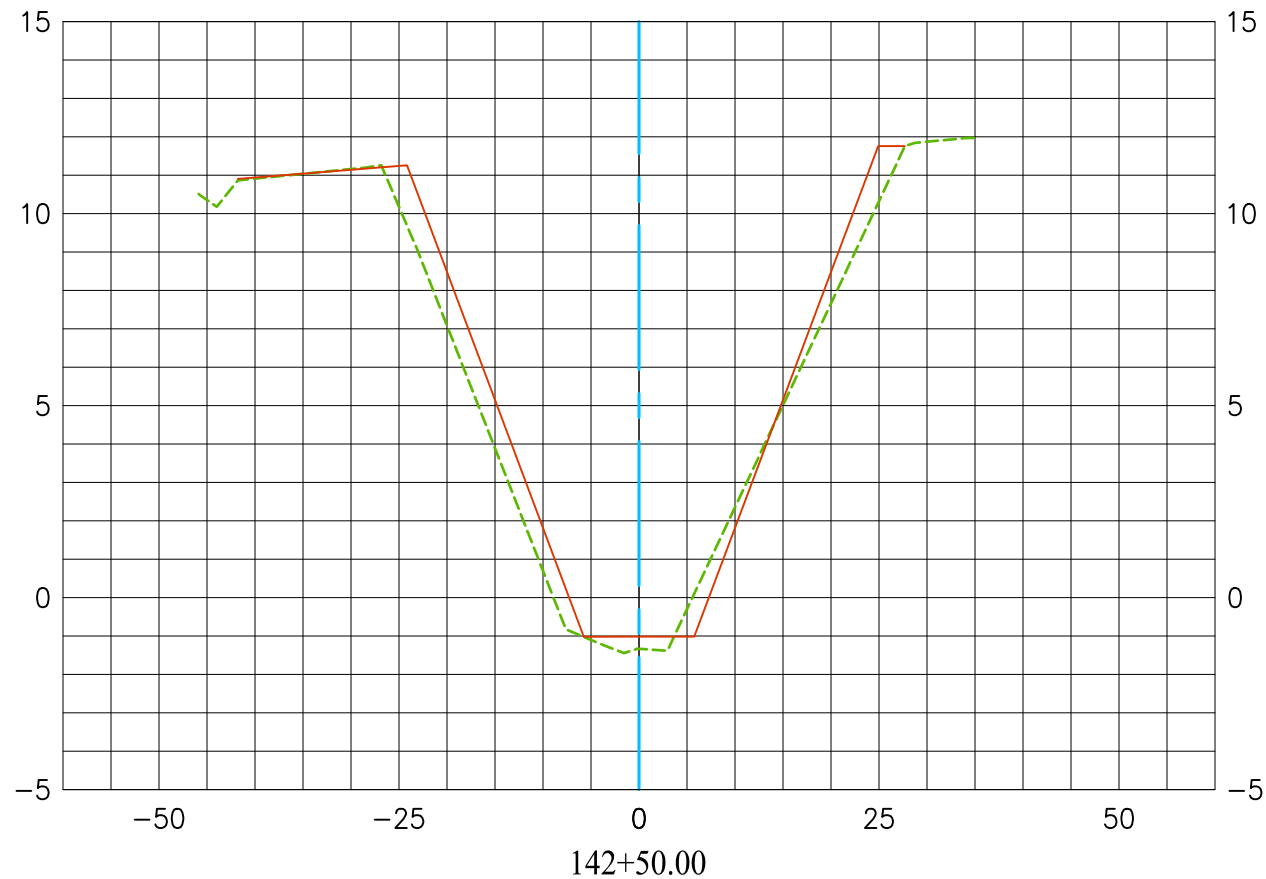


EXISTING CONDITION 2019  
 MODIFIED RECORD PLAN C01-701-1-A  
 DATED 01/23/2008  
 DATE PREPARED: 08/02/2019

---  
 —

Vert. Scale: 1"=5'  
 Hor. Scale: 1"=20'

# C01 LOS ALAMITOS CHANNEL CL

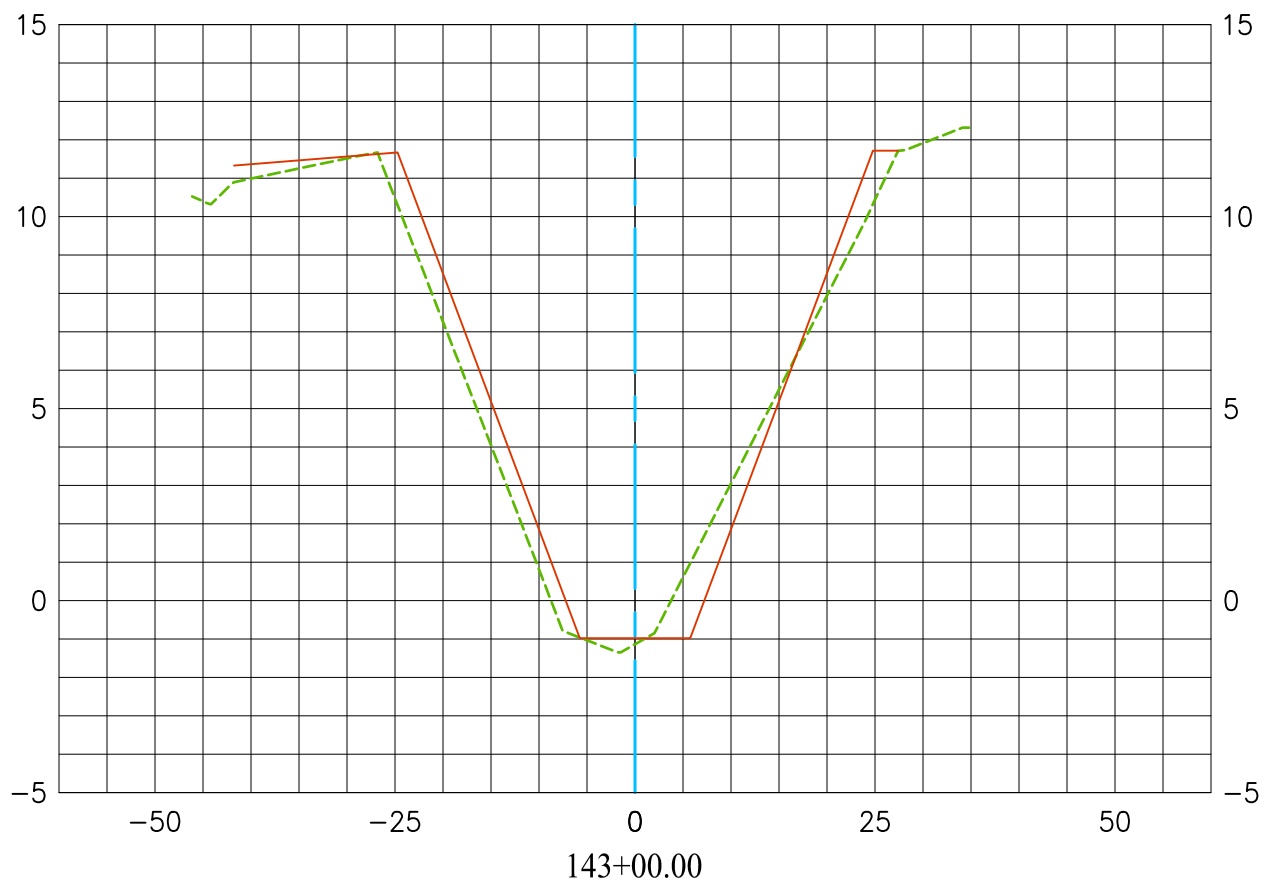


EXISTING CONDITION 2019  
 MODIFIED RECORD PLAN C01-701-1-A  
 DATED 01/23/2008  
 DATE PREPARED: 08/02/2019

---  
 —

Vert. Scale: 1"=5'  
 Hor. Scale: 1"=20'



## C01 LOS ALAMITOS CHANNEL CL

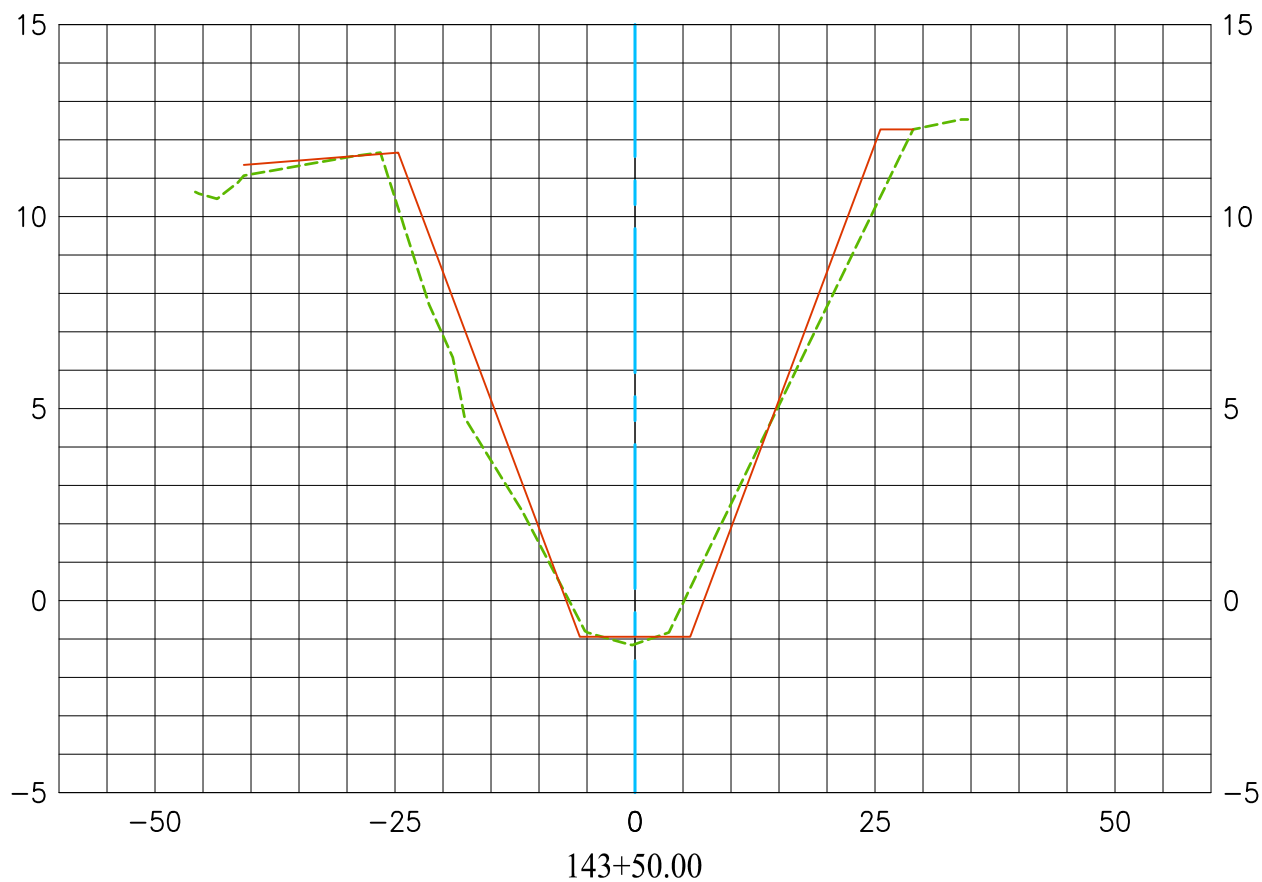


EXISTING CONDITION 2019  
MODIFIED RECORD PLAN C01-701-1-A  
DATED 01/23/2008  
DATE PREPARED: 08/02/2019



Vert. Scale: 1"=5'  
Hor. Scale: 1"=20'

## C01 LOS ALAMITOS CHANNEL CL

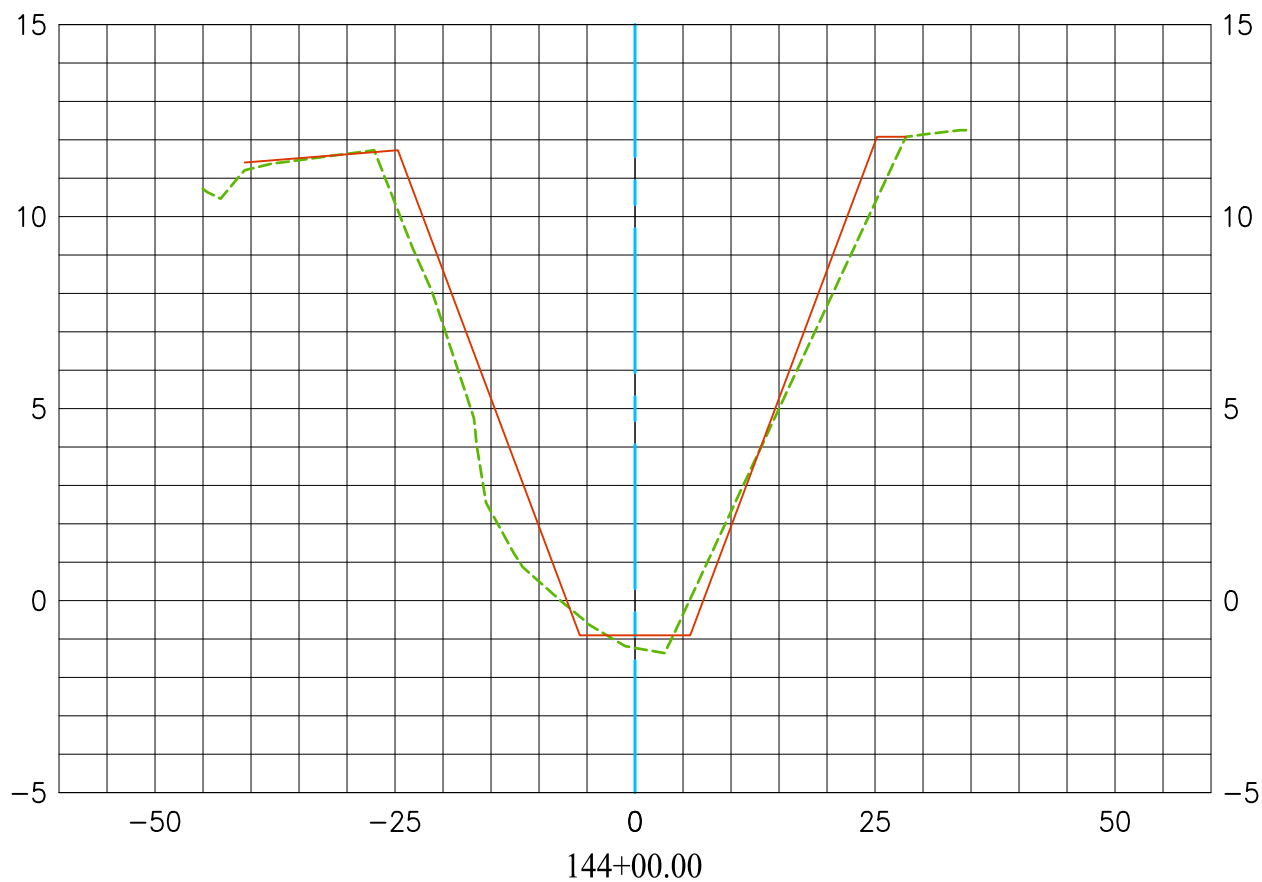


EXISTING CONDITION 2019  
 MODIFIED RECORD PLAN C01-701-1-A  
 DATED 01/23/2008  
 DATE PREPARED: 08/02/2019

-----  
 \_\_\_\_\_

Vert. Scale: 1"=5'  
 Hor. Scale: 1"=20'



## C01 LOS ALAMITOS CHANNEL CL

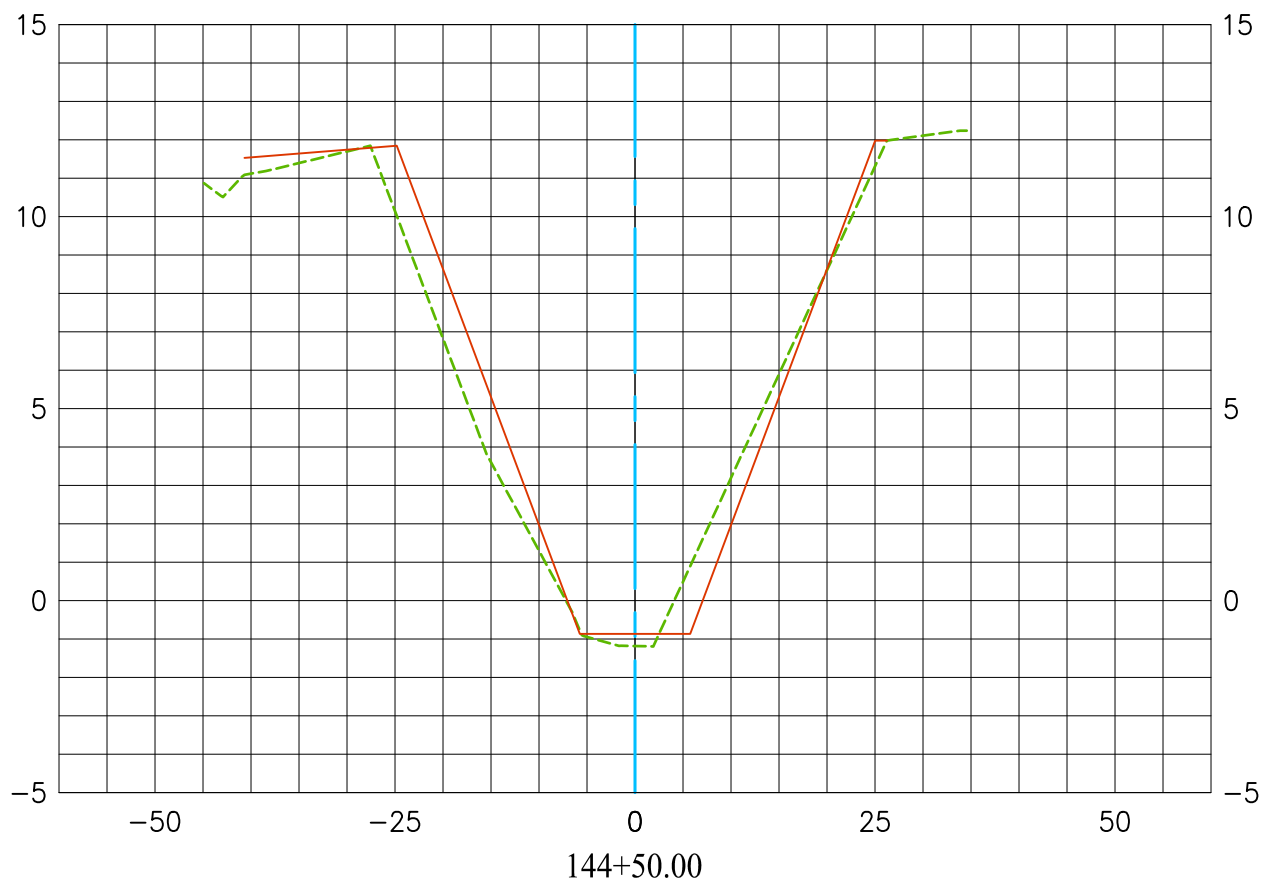


EXISTING CONDITION 2019  
 MODIFIED RECORD PLAN C01-701-1-A  
 DATED 01/23/2008  
 DATE PREPARED: 08/02/2019

-----  
 \_\_\_\_\_


Vert. Scale: 1"=5'  
 Hor. Scale: 1"=20'

# C01 LOS ALAMITOS CHANNEL CL

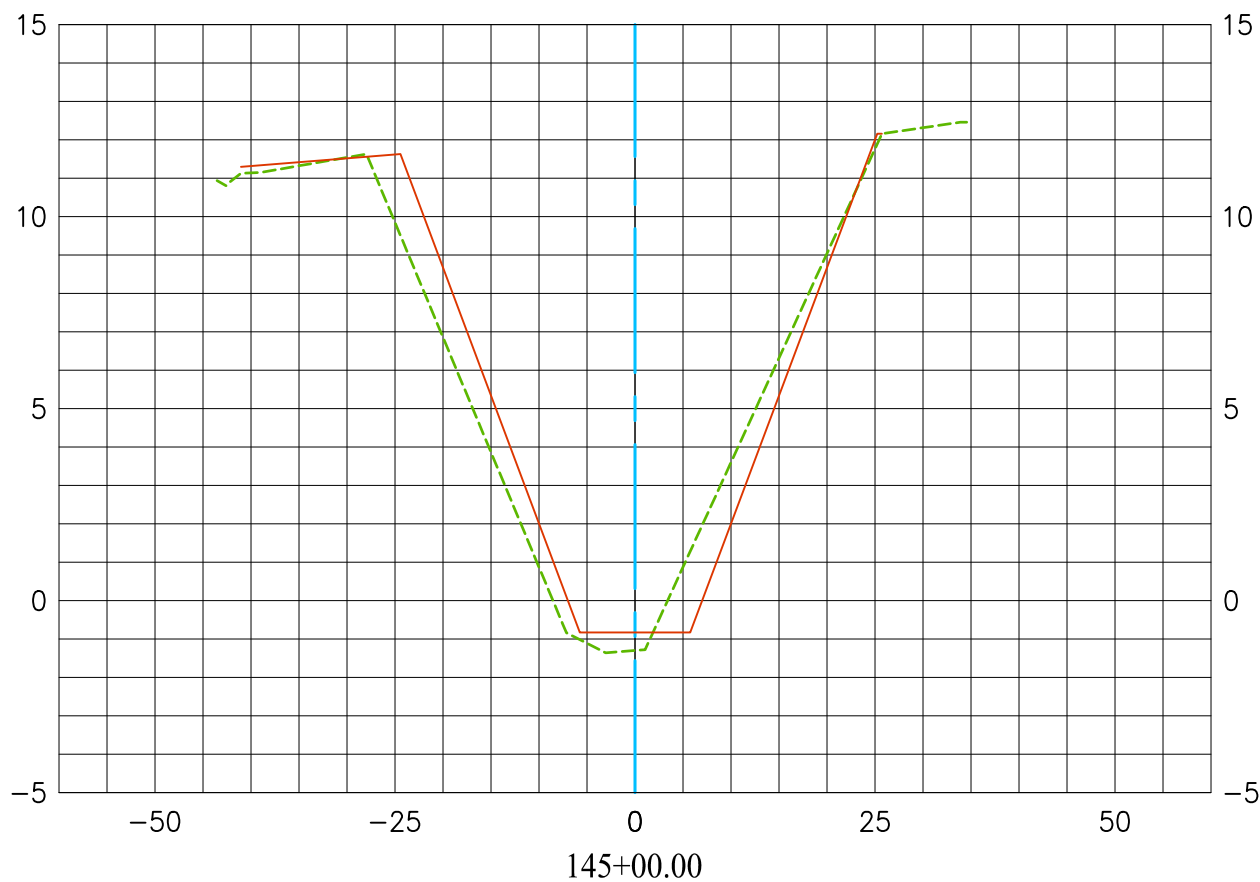


EXISTING CONDITION 2019  
 MODIFIED RECORD PLAN C01-701-1-A  
 DATED 01/23/2008  
 DATE PREPARED: 08/02/2019

Vert. Scale: 1"=5'  
 Hor. Scale: 1"=20'

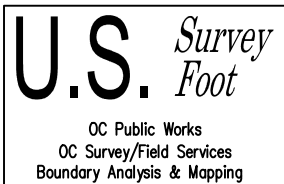


## C01 LOS ALAMITOS CHANNEL CL

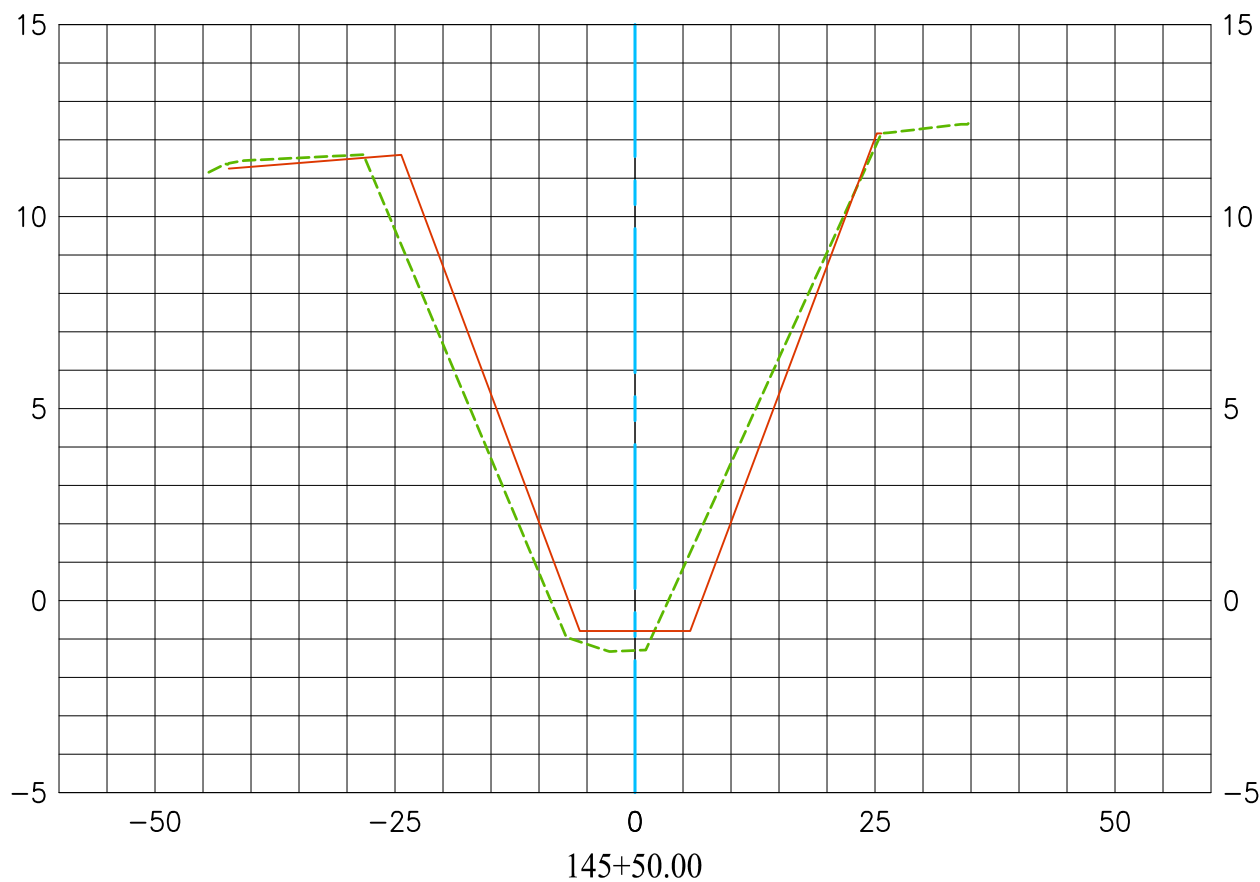

EXISTING CONDITION 2019  
MODIFIED RECORD PLAN C01-701-1-A  
DATED 01/23/2008  
DATE PREPARED: 08/02/2019

Vert. Scale: 1"=5'  
Hor. Scale: 1"=20'

# C01 LOS ALAMITOS CHANNEL CL

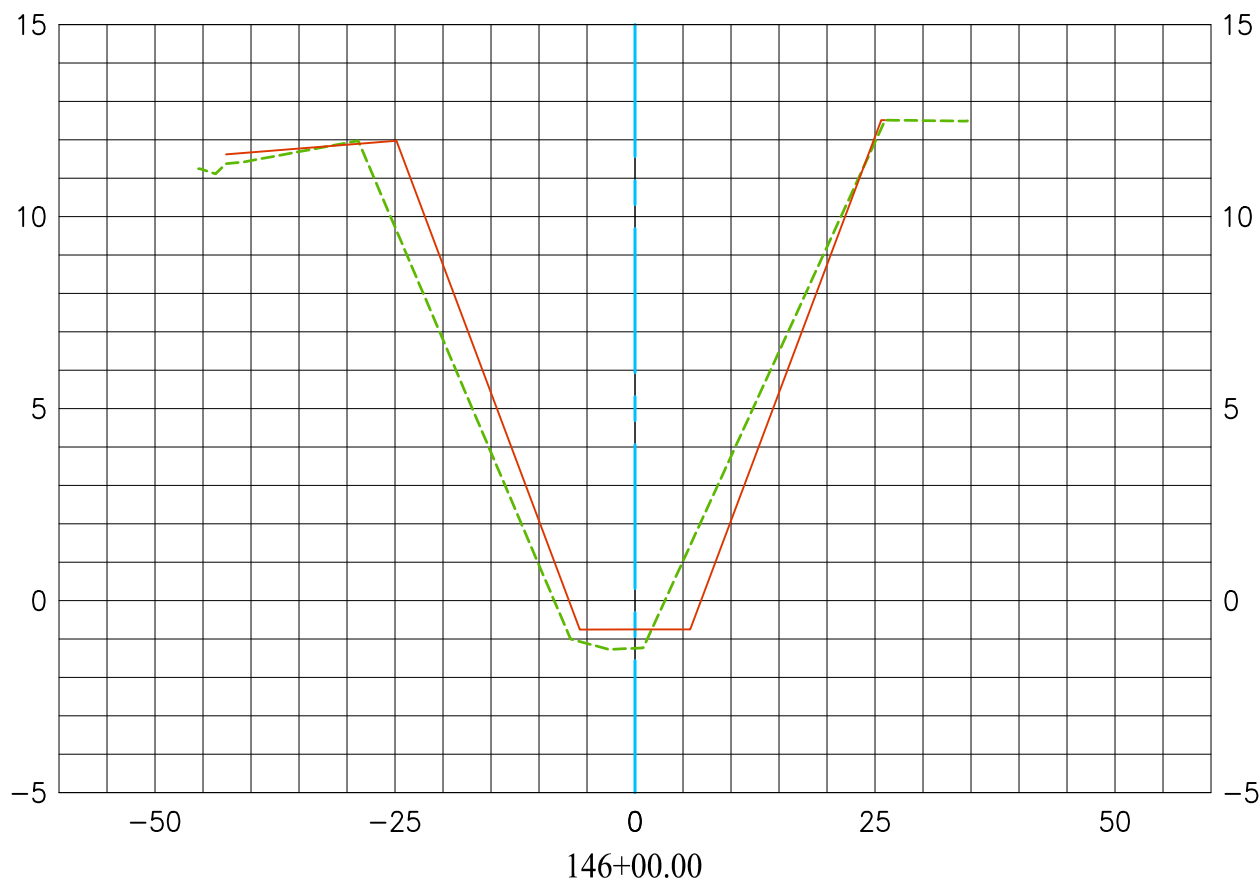


EXISTING CONDITION 2019  
 MODIFIED RECORD PLAN C01-701-1-A  
 DATED 01/23/2008  
 DATE PREPARED: 08/02/2019

---  
 —

Vert. Scale: 1"=5'  
 Hor. Scale: 1"=20'



## C01 LOS ALAMITOS CHANNEL CL

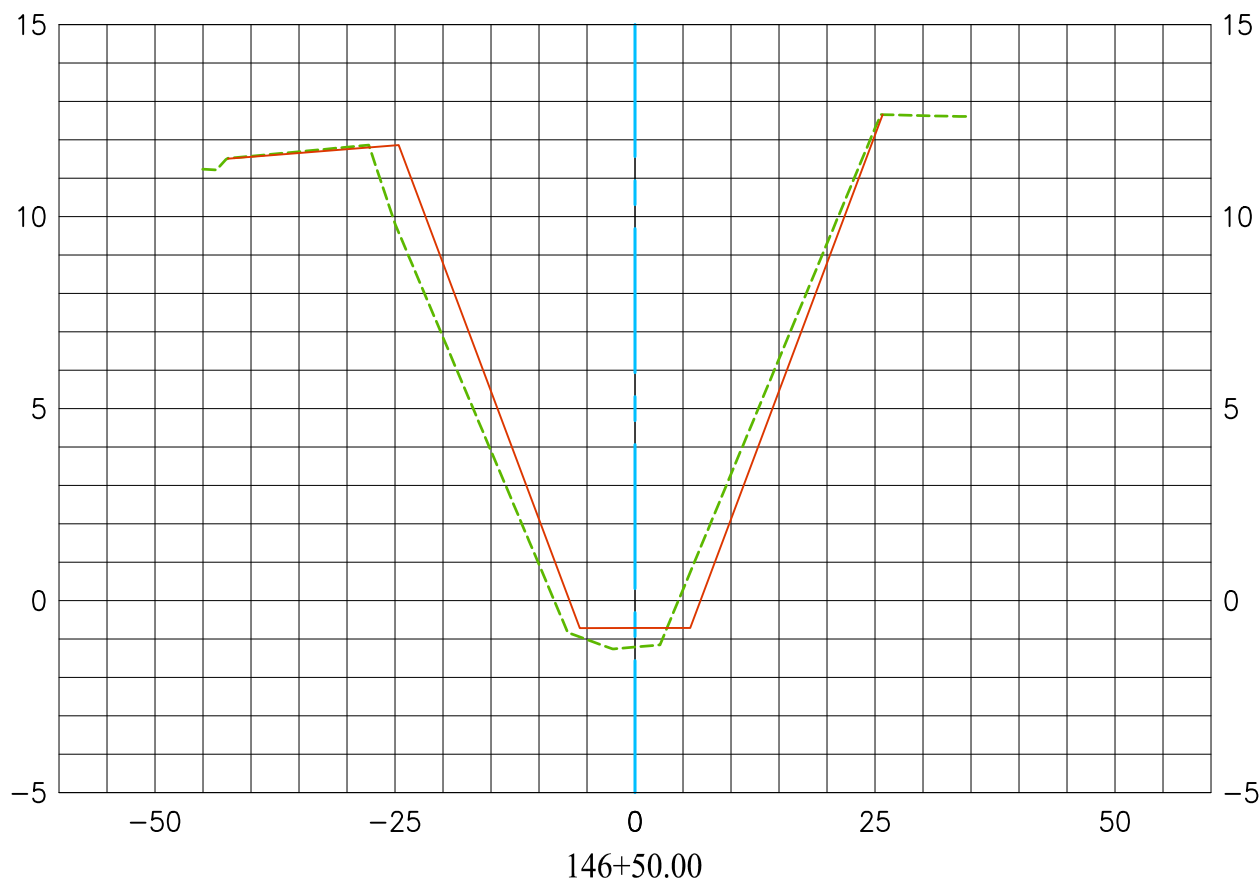


EXISTING CONDITION 2019  
MODIFIED RECORD PLAN C01-701-1-A  
DATED 01/23/2008  
DATE PREPARED: 08/02/2019



Vert. Scale: 1"=5'  
Hor. Scale: 1"=20'



## C01 LOS ALAMITOS CHANNEL CL

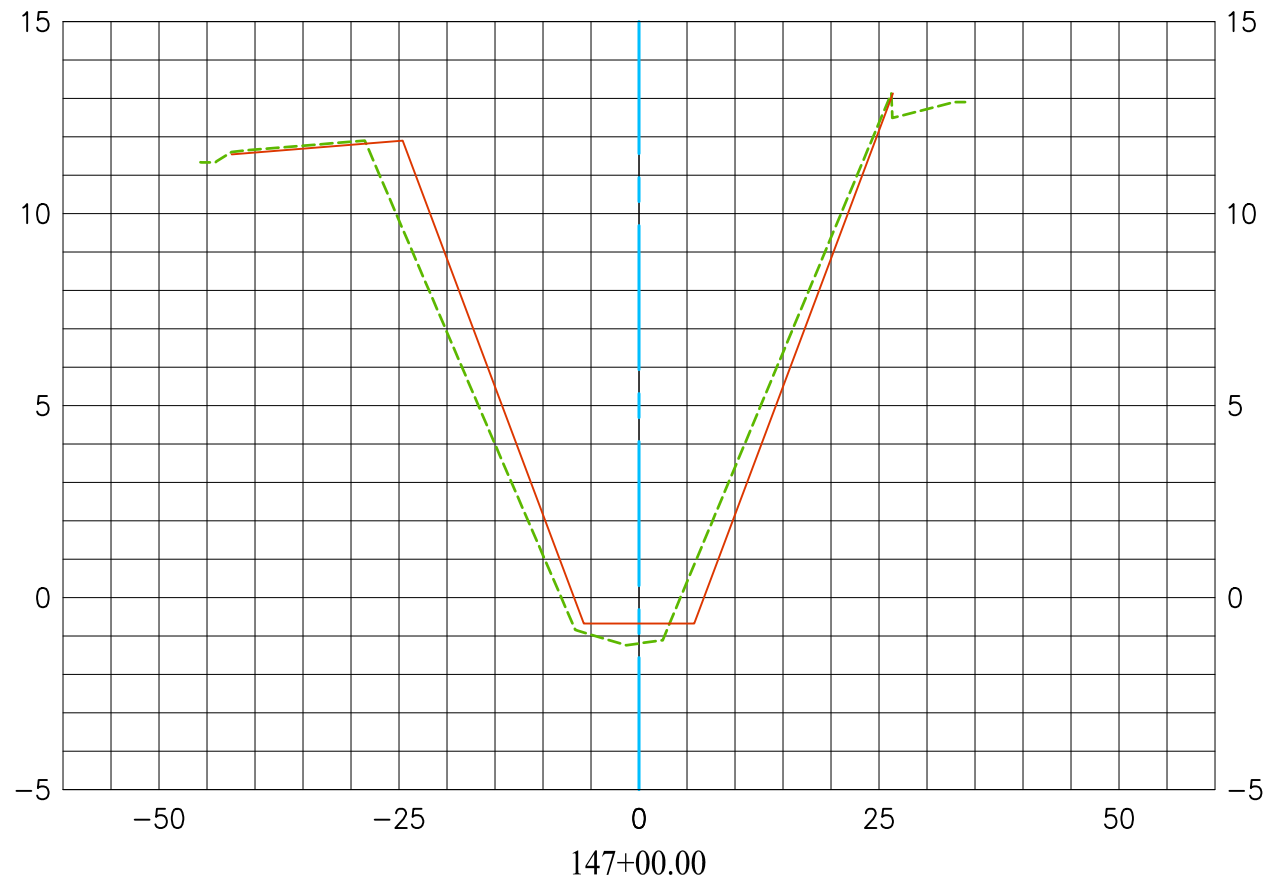


EXISTING CONDITION 2019  
MODIFIED RECORD PLAN C01-701-1-A  
DATED 01/23/2008  
DATE PREPARED: 08/02/2019



Vert. Scale: 1"=5'  
Hor. Scale: 1"=20'



## C01 LOS ALAMITOS CHANNEL CL

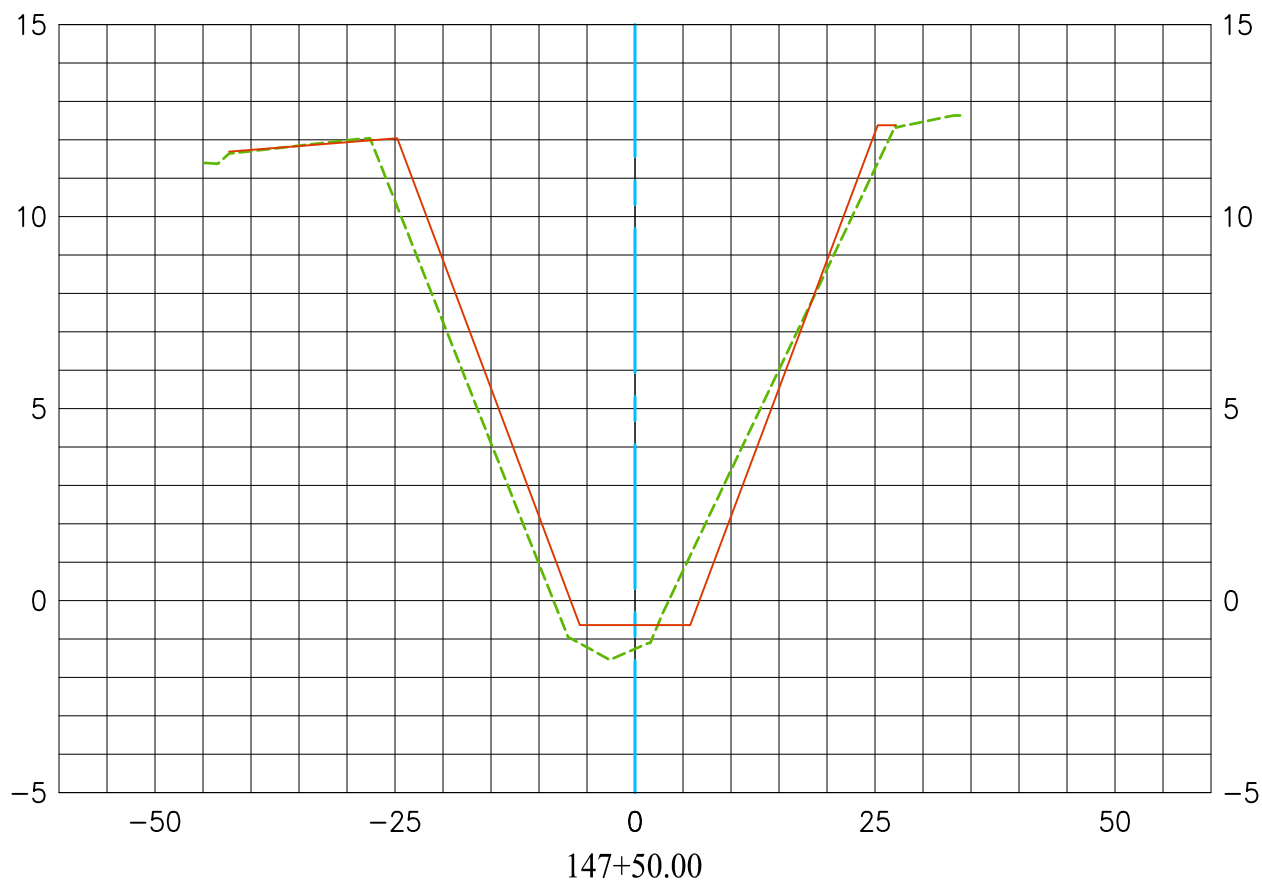


EXISTING CONDITION 2019  
MODIFIED RECORD PLAN C01-701-1-A  
DATED 01/23/2008  
DATE PREPARED: 08/02/2019



Vert. Scale: 1"=5'  
Hor. Scale: 1"=20'

# C01 LOS ALAMITOS CHANNEL CL

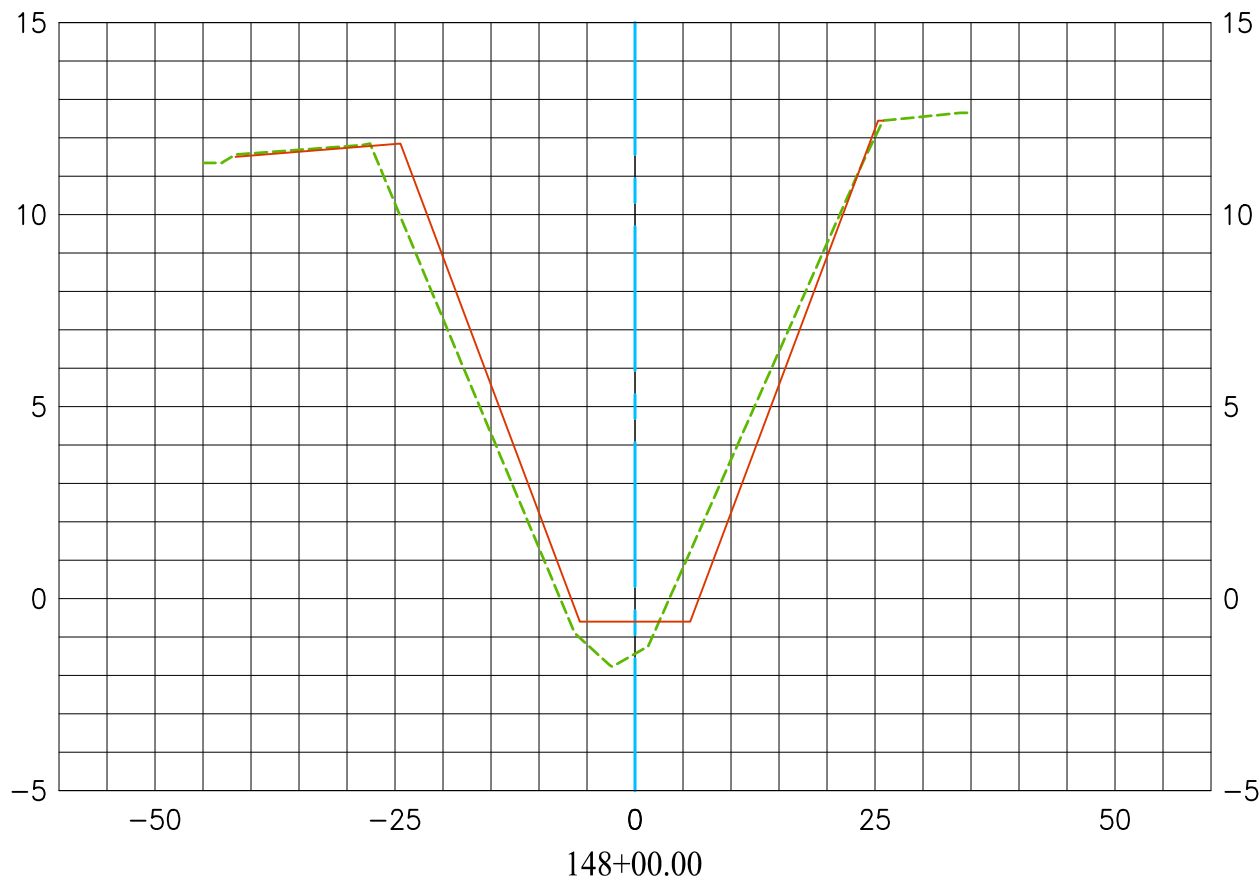


EXISTING CONDITION 2019  
 MODIFIED RECORD PLAN C01-701-1-A  
 DATED 01/23/2008  
 DATE PREPARED: 08/02/2019

Vert. Scale: 1"=5'  
 Hor. Scale: 1"=20'



## C01 LOS ALAMITOS CHANNEL CL

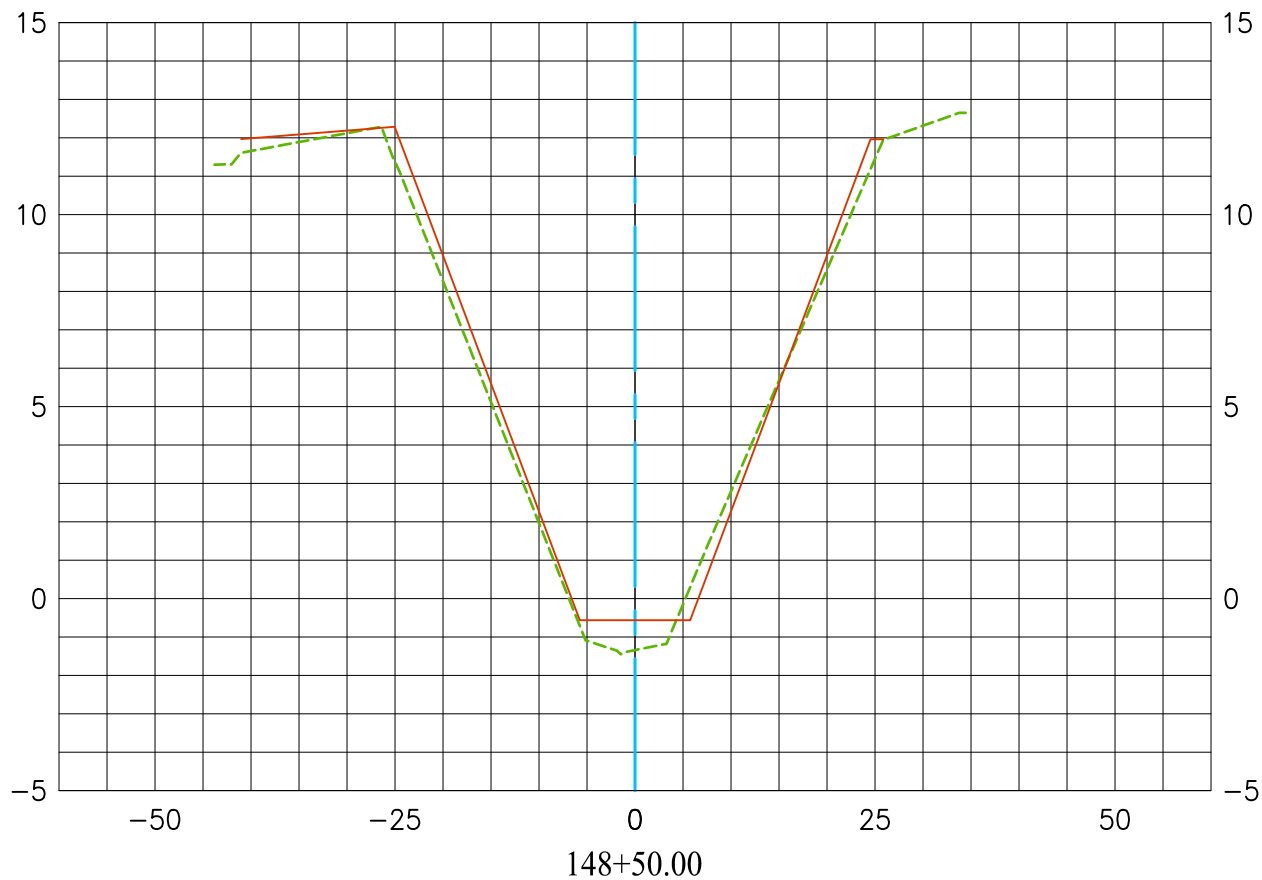


EXISTING CONDITION 2019  
MODIFIED RECORD PLAN C01-701-1-A  
DATED 01/23/2008  
DATE PREPARED: 08/02/2019

---  
---

Vert. Scale: 1"=5'  
Hor. Scale: 1"=20'


## C01 LOS ALAMITOS CHANNEL CL

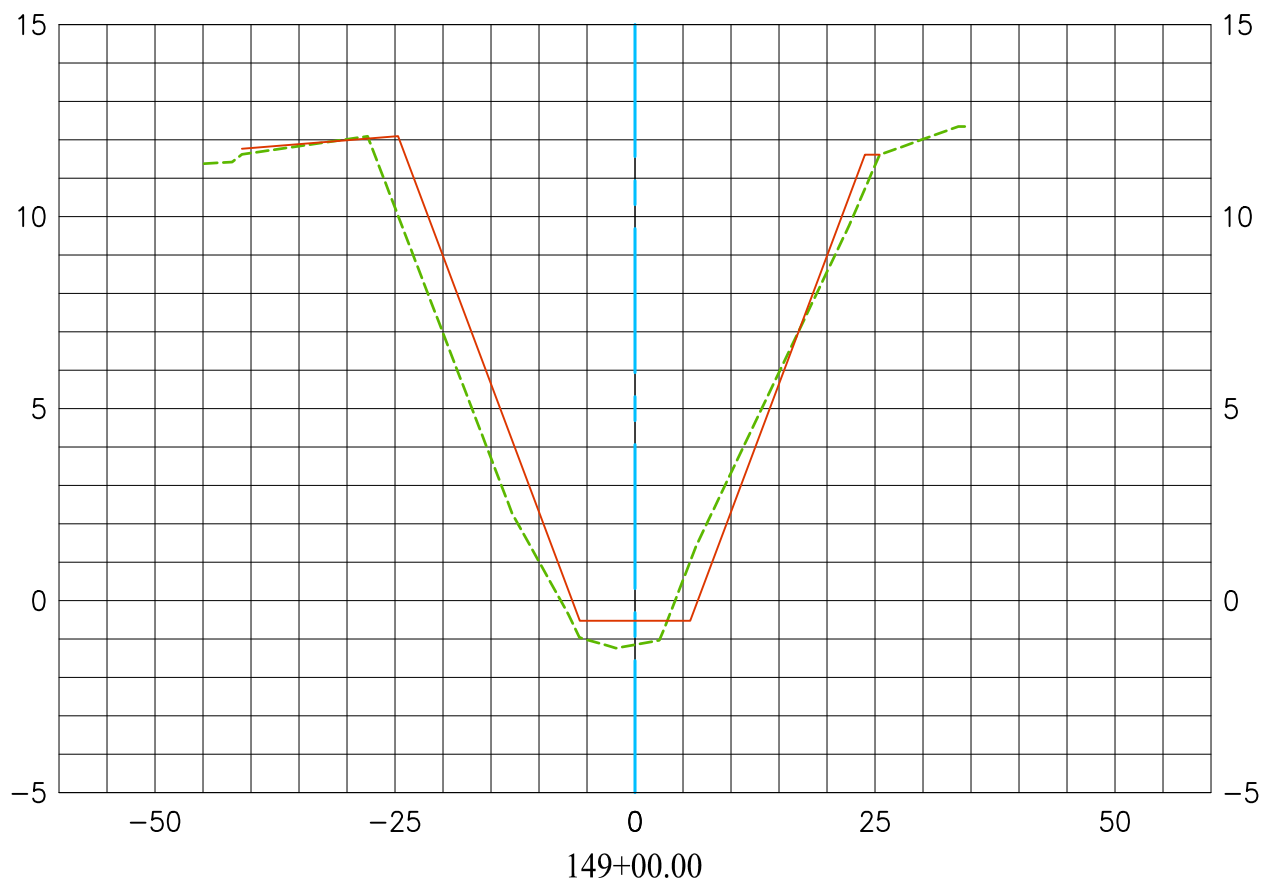


EXISTING CONDITION 2019  
 MODIFIED RECORD PLAN C01-701-1-A  
 DATED 01/23/2008  
 DATE PREPARED: 08/02/2019

---  
 —

Vert. Scale: 1"=5'  
 Hor. Scale: 1"=20'

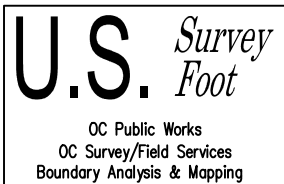


## C01 LOS ALAMITOS CHANNEL CL

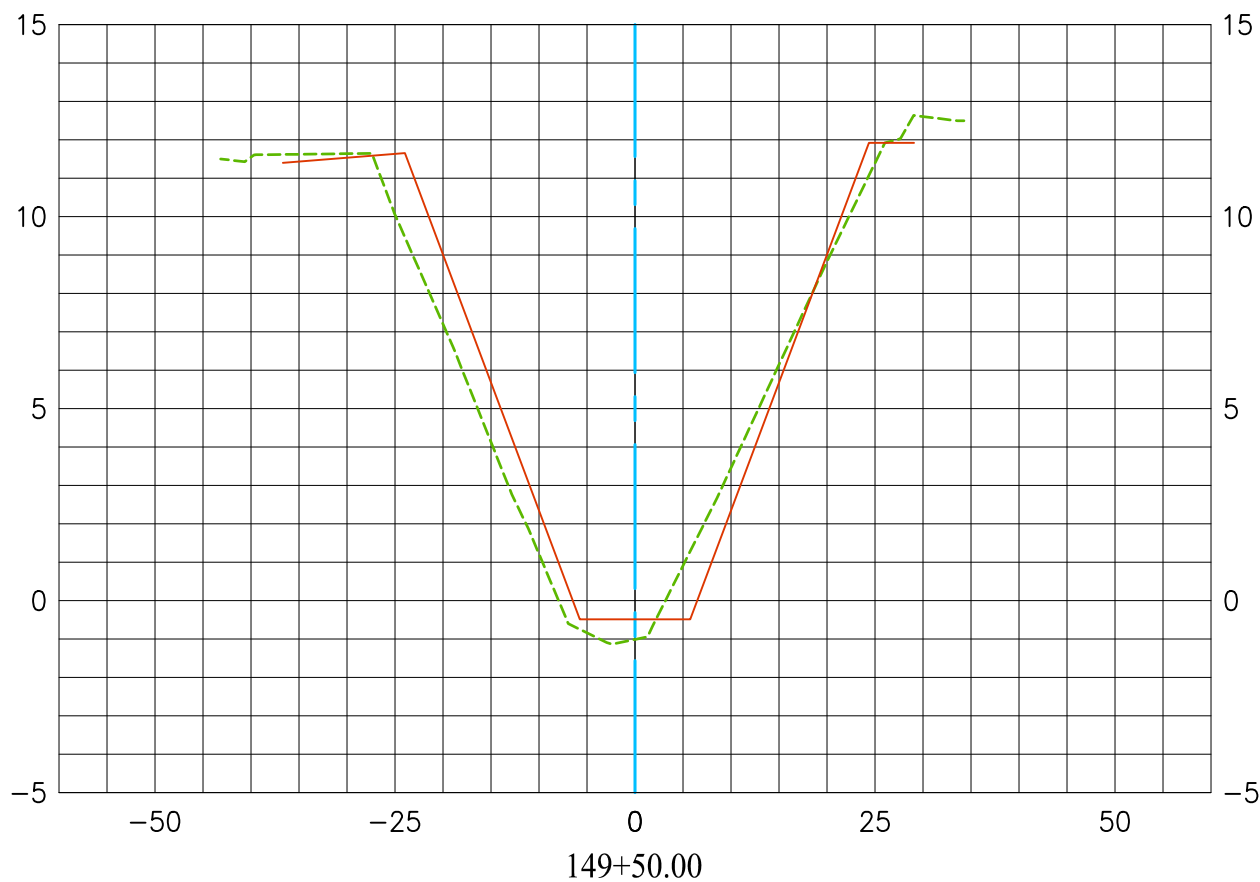


EXISTING CONDITION 2019  
MODIFIED RECORD PLAN C01-701-1-A  
DATED 01/23/2008  
DATE PREPARED: 08/02/2019



Vert. Scale: 1"=5'  
Hor. Scale: 1"=20'

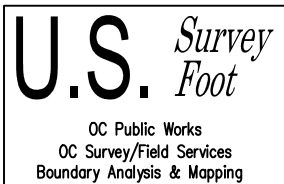

## C01 LOS ALAMITOS CHANNEL CL

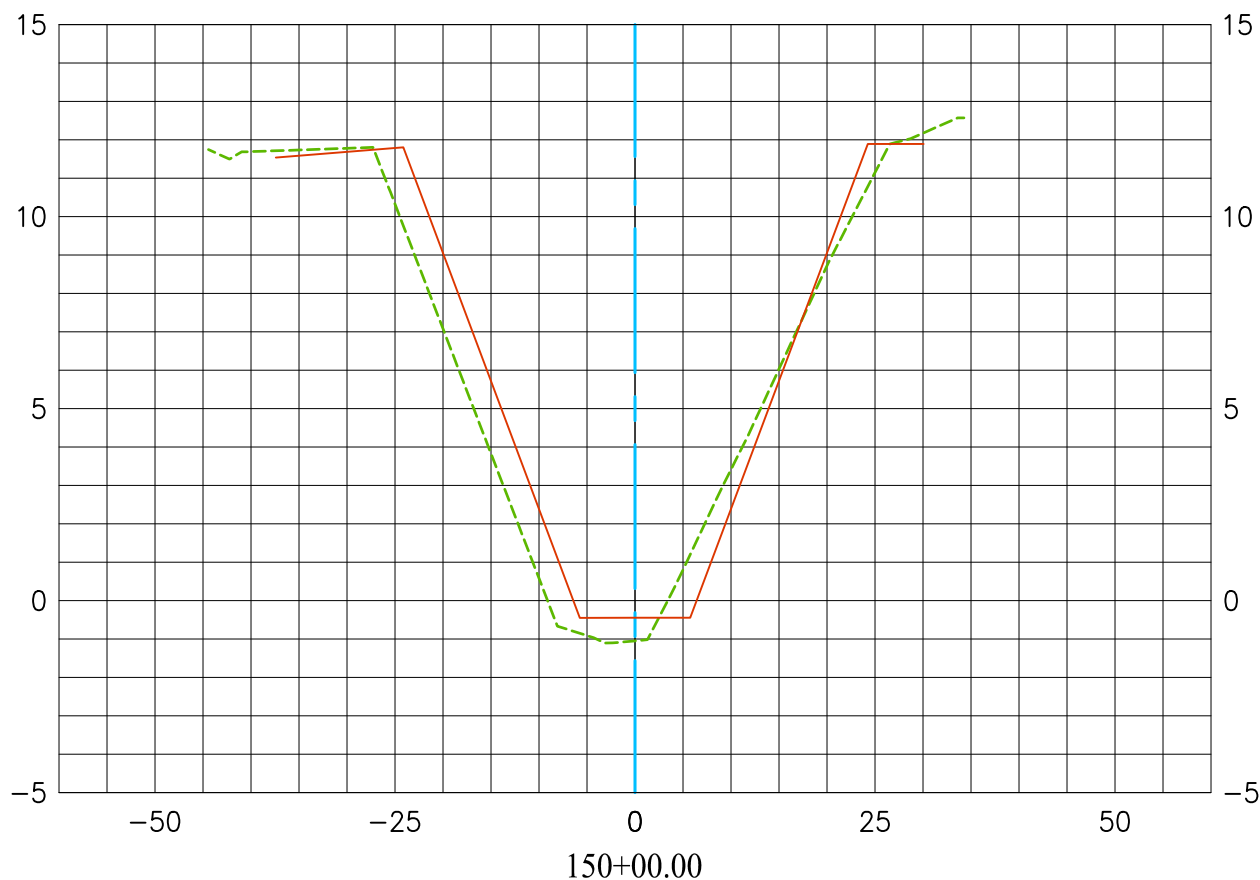


EXISTING CONDITION 2019  
MODIFIED RECORD PLAN C01-701-1-A  
DATED 01/23/2008  
DATE PREPARED: 08/02/2019



Vert. Scale: 1"=5'  
Hor. Scale: 1"=20'



## C01 LOS ALAMITOS CHANNEL CL

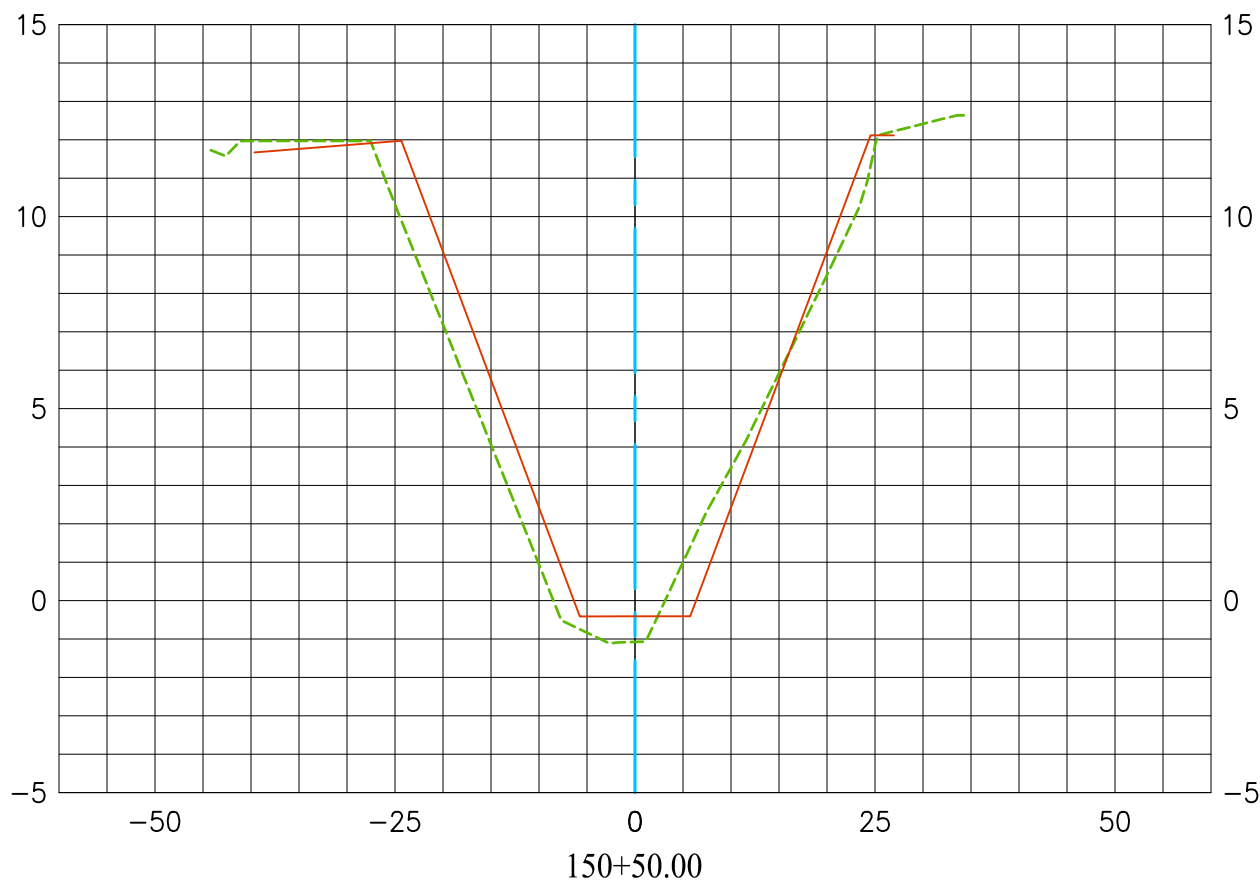


EXISTING CONDITION 2019  
MODIFIED RECORD PLAN C01-701-1-A  
DATED 01/23/2008  
DATE PREPARED: 08/02/2019



Vert. Scale: 1"=5'  
Hor. Scale: 1"=20'



## C01 LOS ALAMITOS CHANNEL CL

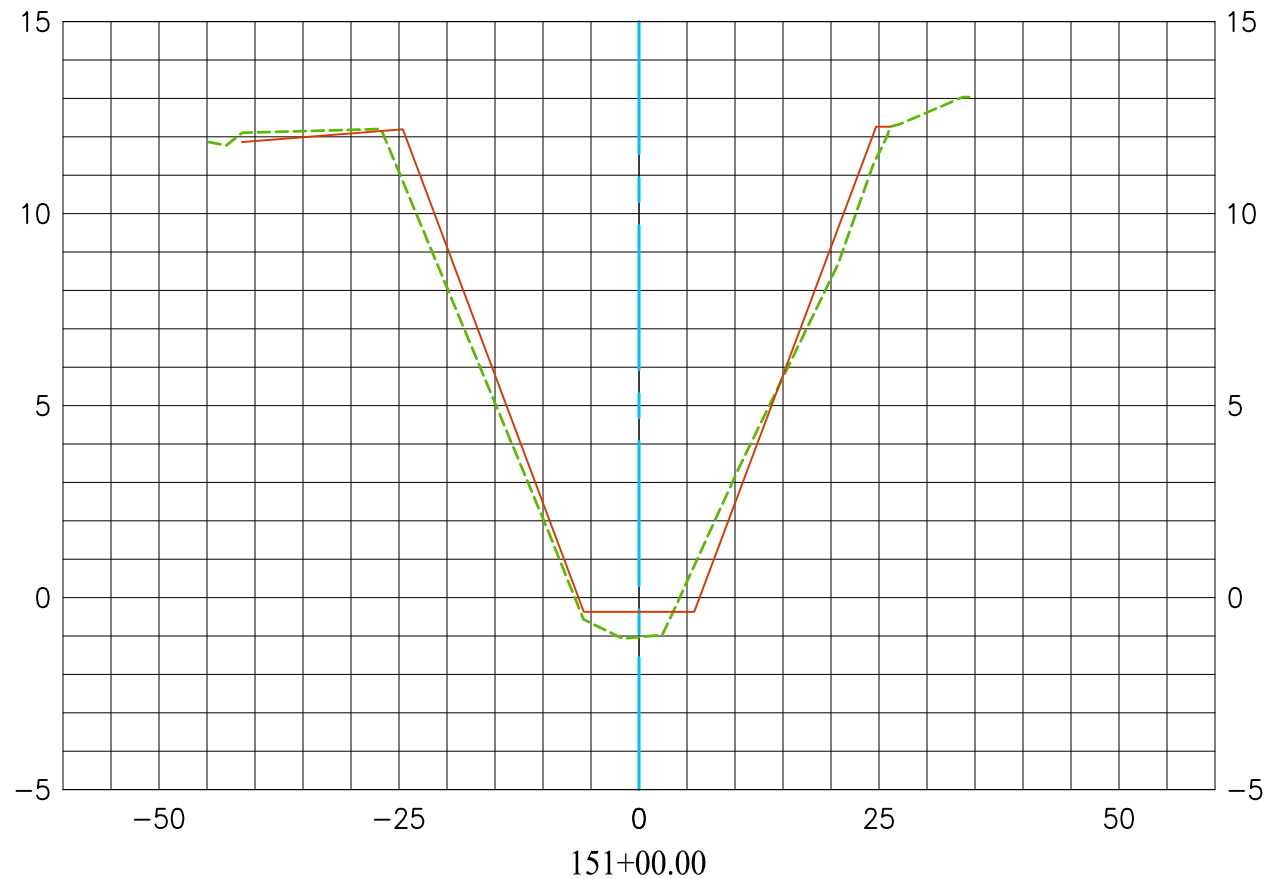


EXISTING CONDITION 2019  
 MODIFIED RECORD PLAN C01-701-1-A  
 DATED 01/23/2008  
 DATE PREPARED: 08/02/2019



Vert. Scale: 1"=5'  
 Hor. Scale: 1"=20'




## C01 LOS ALAMITOS CHANNEL CL

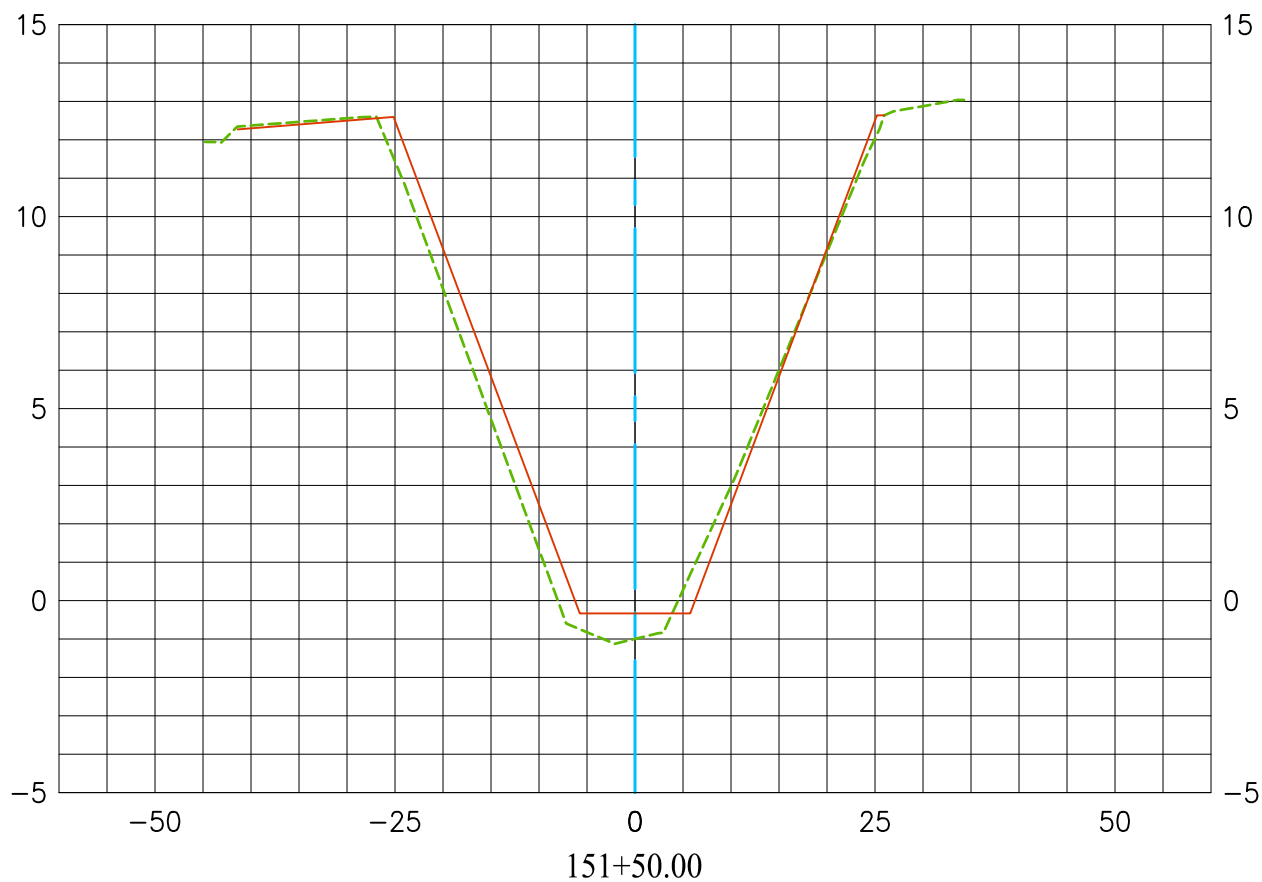

EXISTING CONDITION 2019  
MODIFIED RECORD PLAN C01-701-1-A  
DATED 01/23/2008  
DATE PREPARED: 08/02/2019

Vert. Scale: 1"=5'  
Hor. Scale: 1"=20'

## C01 LOS ALAMITOS CHANNEL CL

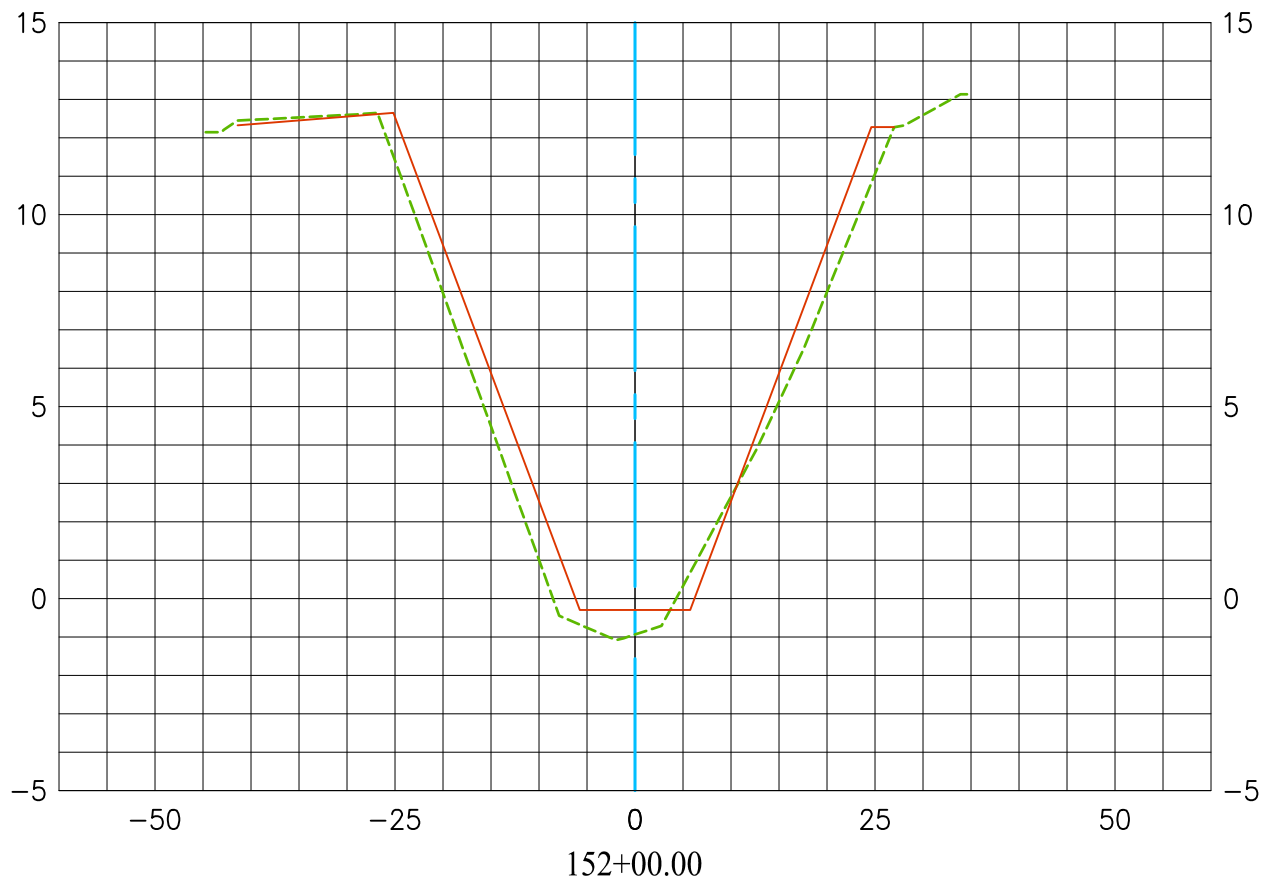

EXISTING CONDITION 2019  
MODIFIED RECORD PLAN C01-701-1-A  
DATED 01/23/2008  
DATE PREPARED: 08/02/2019




Vert. Scale: 1"=5'  
Hor. Scale: 1"=20'





## C01 LOS ALAMITOS CHANNEL CL

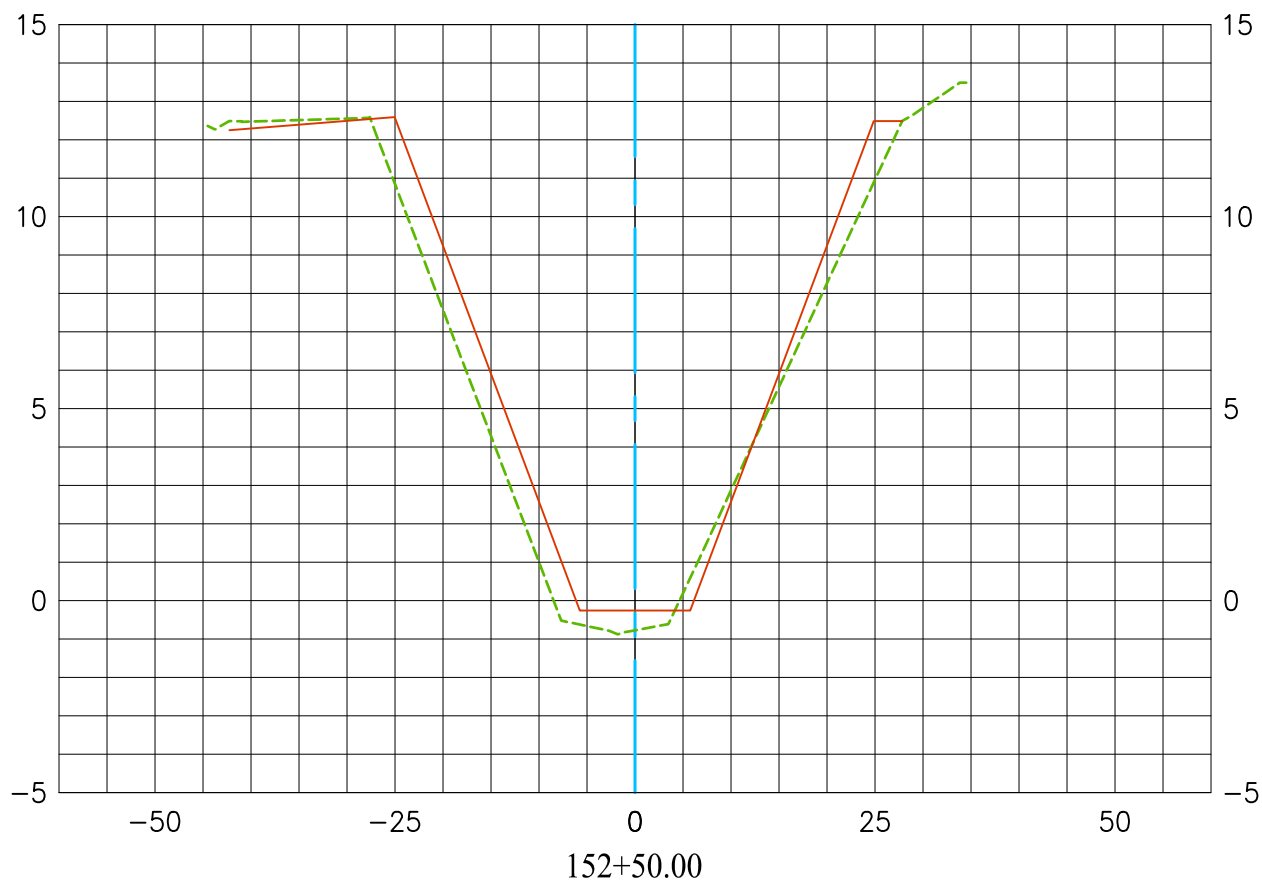


EXISTING CONDITION 2019  
MODIFIED RECORD PLAN C01-701-1-A  
DATED 01/23/2008  
DATE PREPARED: 08/02/2019



Vert. Scale: 1"=5'  
Hor. Scale: 1"=20'

## C01 LOS ALAMITOS CHANNEL CL

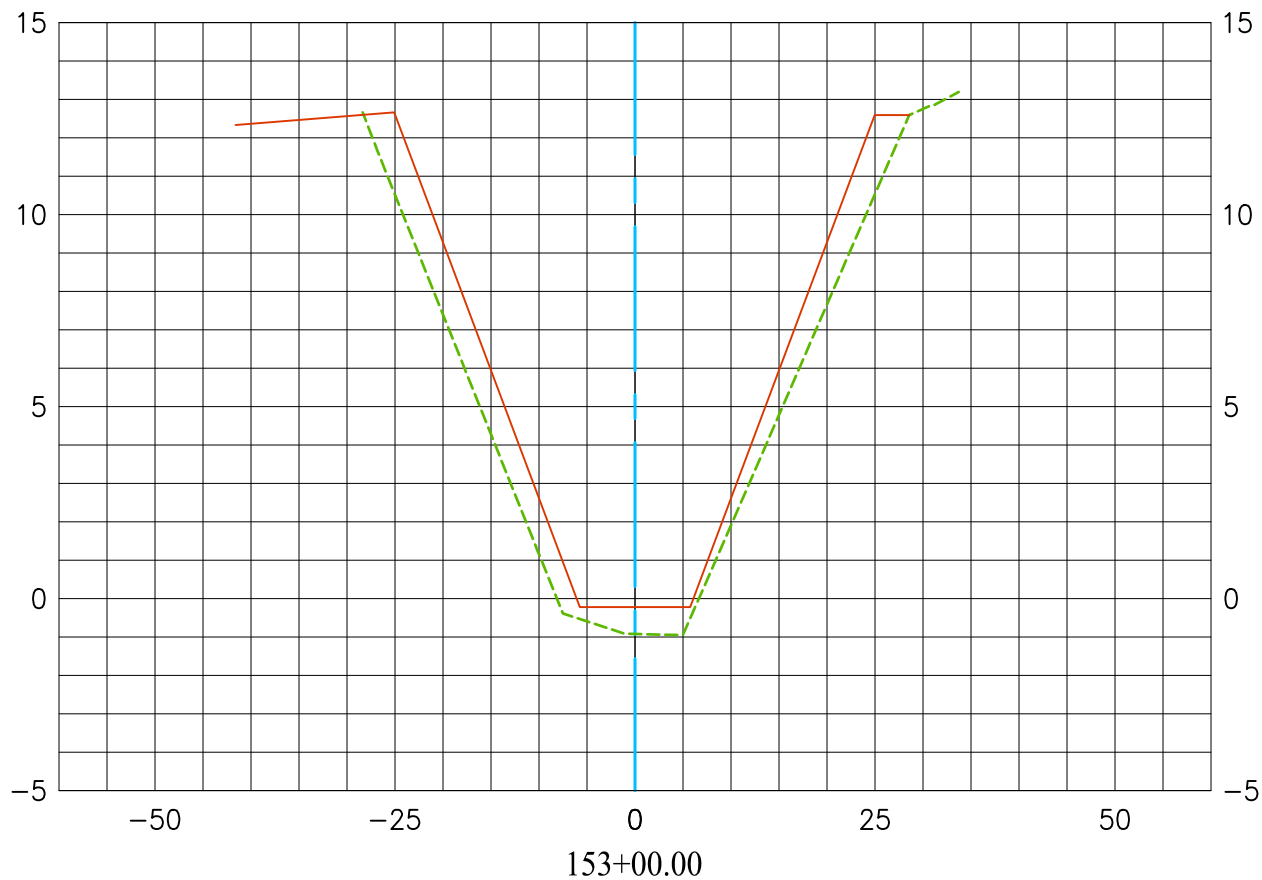


EXISTING CONDITION 2019  
MODIFIED RECORD PLAN C01-701-1-A  
DATED 01/23/2008  
DATE PREPARED: 08/02/2019



Vert. Scale: 1"=5'  
Hor. Scale: 1"=20'



## C01 LOS ALAMITOS CHANNEL CL

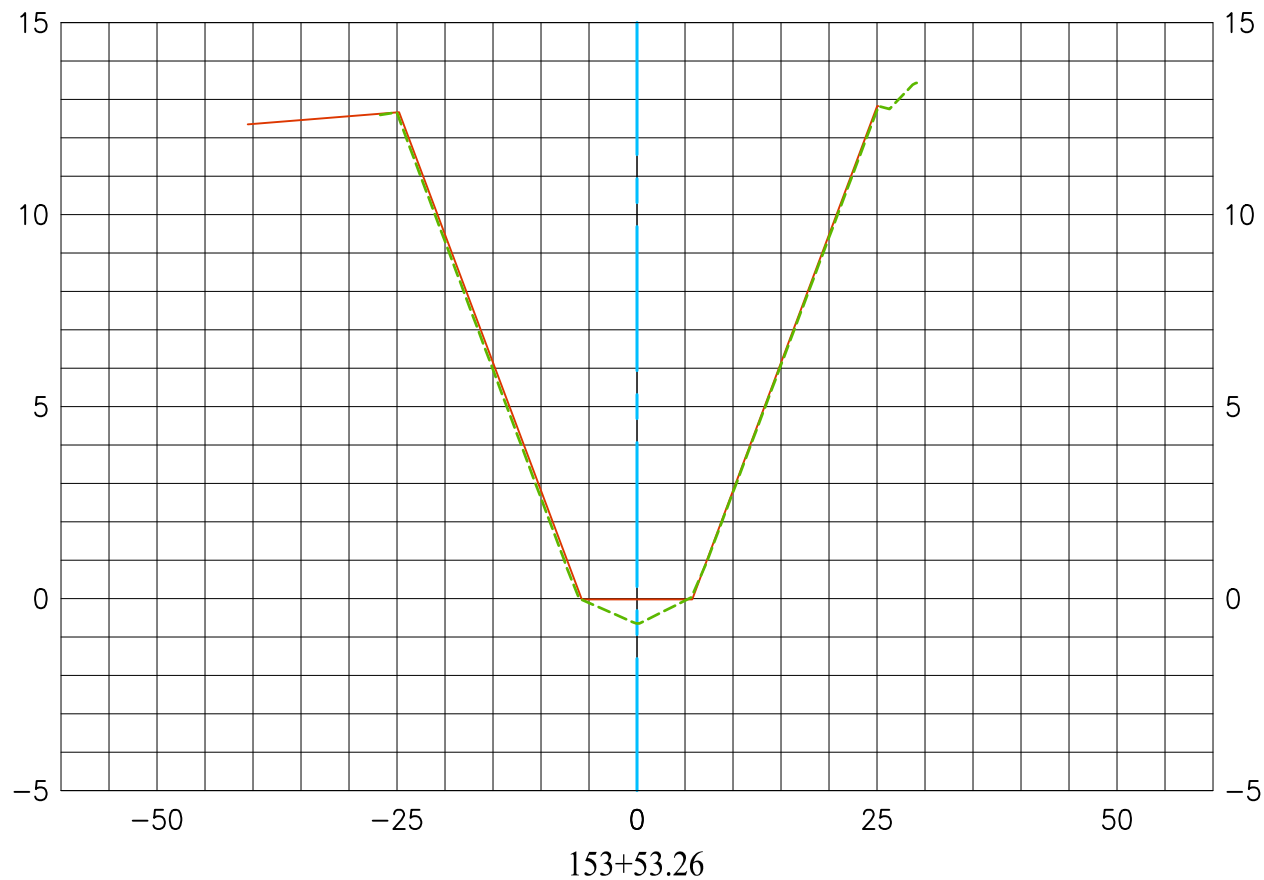

EXISTING CONDITION 2019  
MODIFIED RECORD PLAN C01-701-1-A  
DATED 01/23/2008  
DATE PREPARED: 08/02/2019

Vert. Scale: 1"=5'  
Hor. Scale: 1"=20'