

RECORD OF SURVEY

PARCELS SHOWN BELOW GIVING DESCRIPTION,
SCALE, DATE AND OWNERS NAME.

Examined and Approved this 29 day of Jan, 1957.

Owen Vineyard
Deputy County Surveyor.

I, John M. Hoy, hereby certify that I am a
Licensed Land Surveyor in the State of California
No 2326; that these maps represent surveys
made under my supervision at the request of the
respective owners; that all monuments shown actually
existed at the time of the survey and their pos-
itions are correctly shown.


John M. Hoy
Licensed Land Surveyor.

A PORTION OF THE NORTH 308'
OF THE EAST 5 ACRES OF THE
N $\frac{1}{2}$, OF THE NE $\frac{1}{4}$, OF THE
NE $\frac{1}{4}$ OF SEC. 14, T5S, R11W,
S.B.B. & M., ORANGE COUNTY,
CALIFORNIA.

DATE: JAN. 1957.


SCALE: 1" = 60'

OWNER: WILLIAM GUTOSKY.

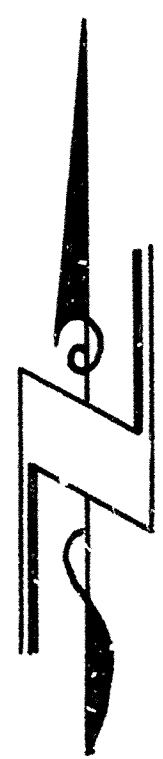

Bearings are based on $\pm$ BOLSA AVE.
as being S 89°25'45"W as per R/S 27-31.

All pipe set bear a copper tag
marked L.S. 2326.

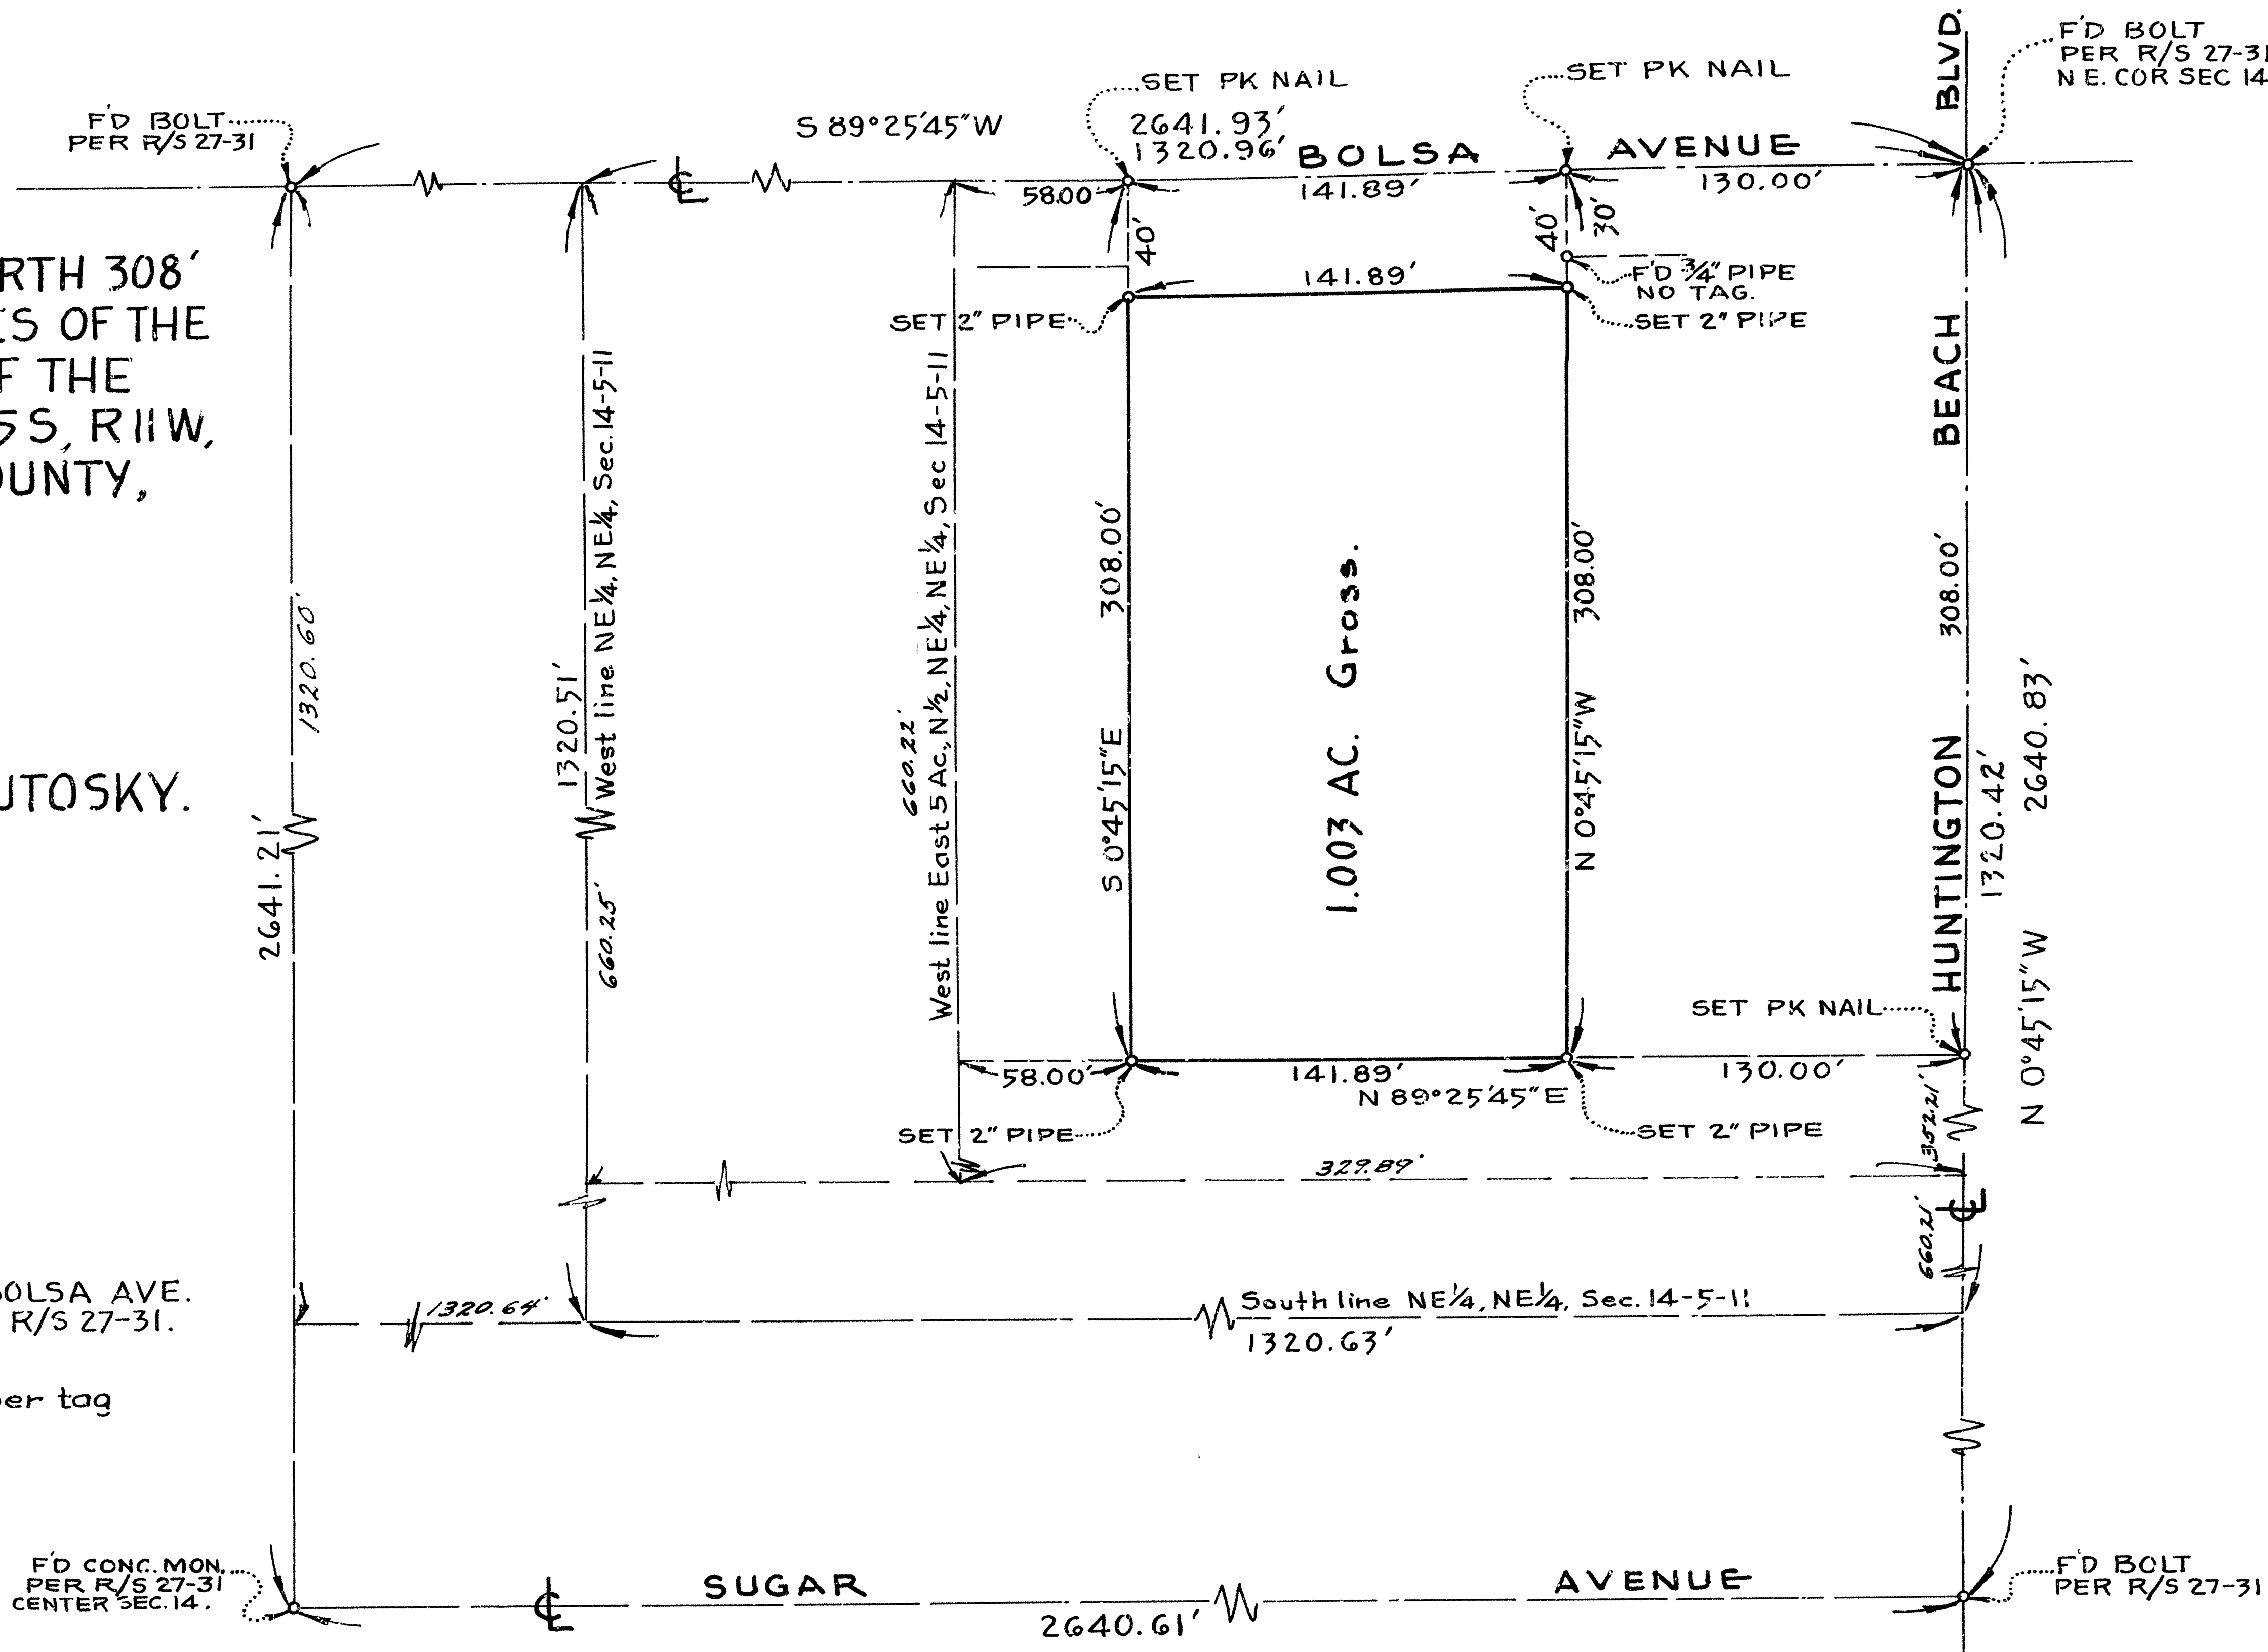

FB. N-4/25.

A PORTION OF LOT 92, TRACT
No 918, AS PER MISC. MAP BK
28, PG 43, RECORDS OF ORANGE
COUNTY, CALIFORNIA.



DATE: JAN. 1957.

SCALE: 1" = 60'

OWNER: CLARENCE L. HENDRICKSON.

Bearings are based on East line Lot
92, Tract 918, MM 28-43.

All pipe set bear a copper tag
marked L.S. 2326.

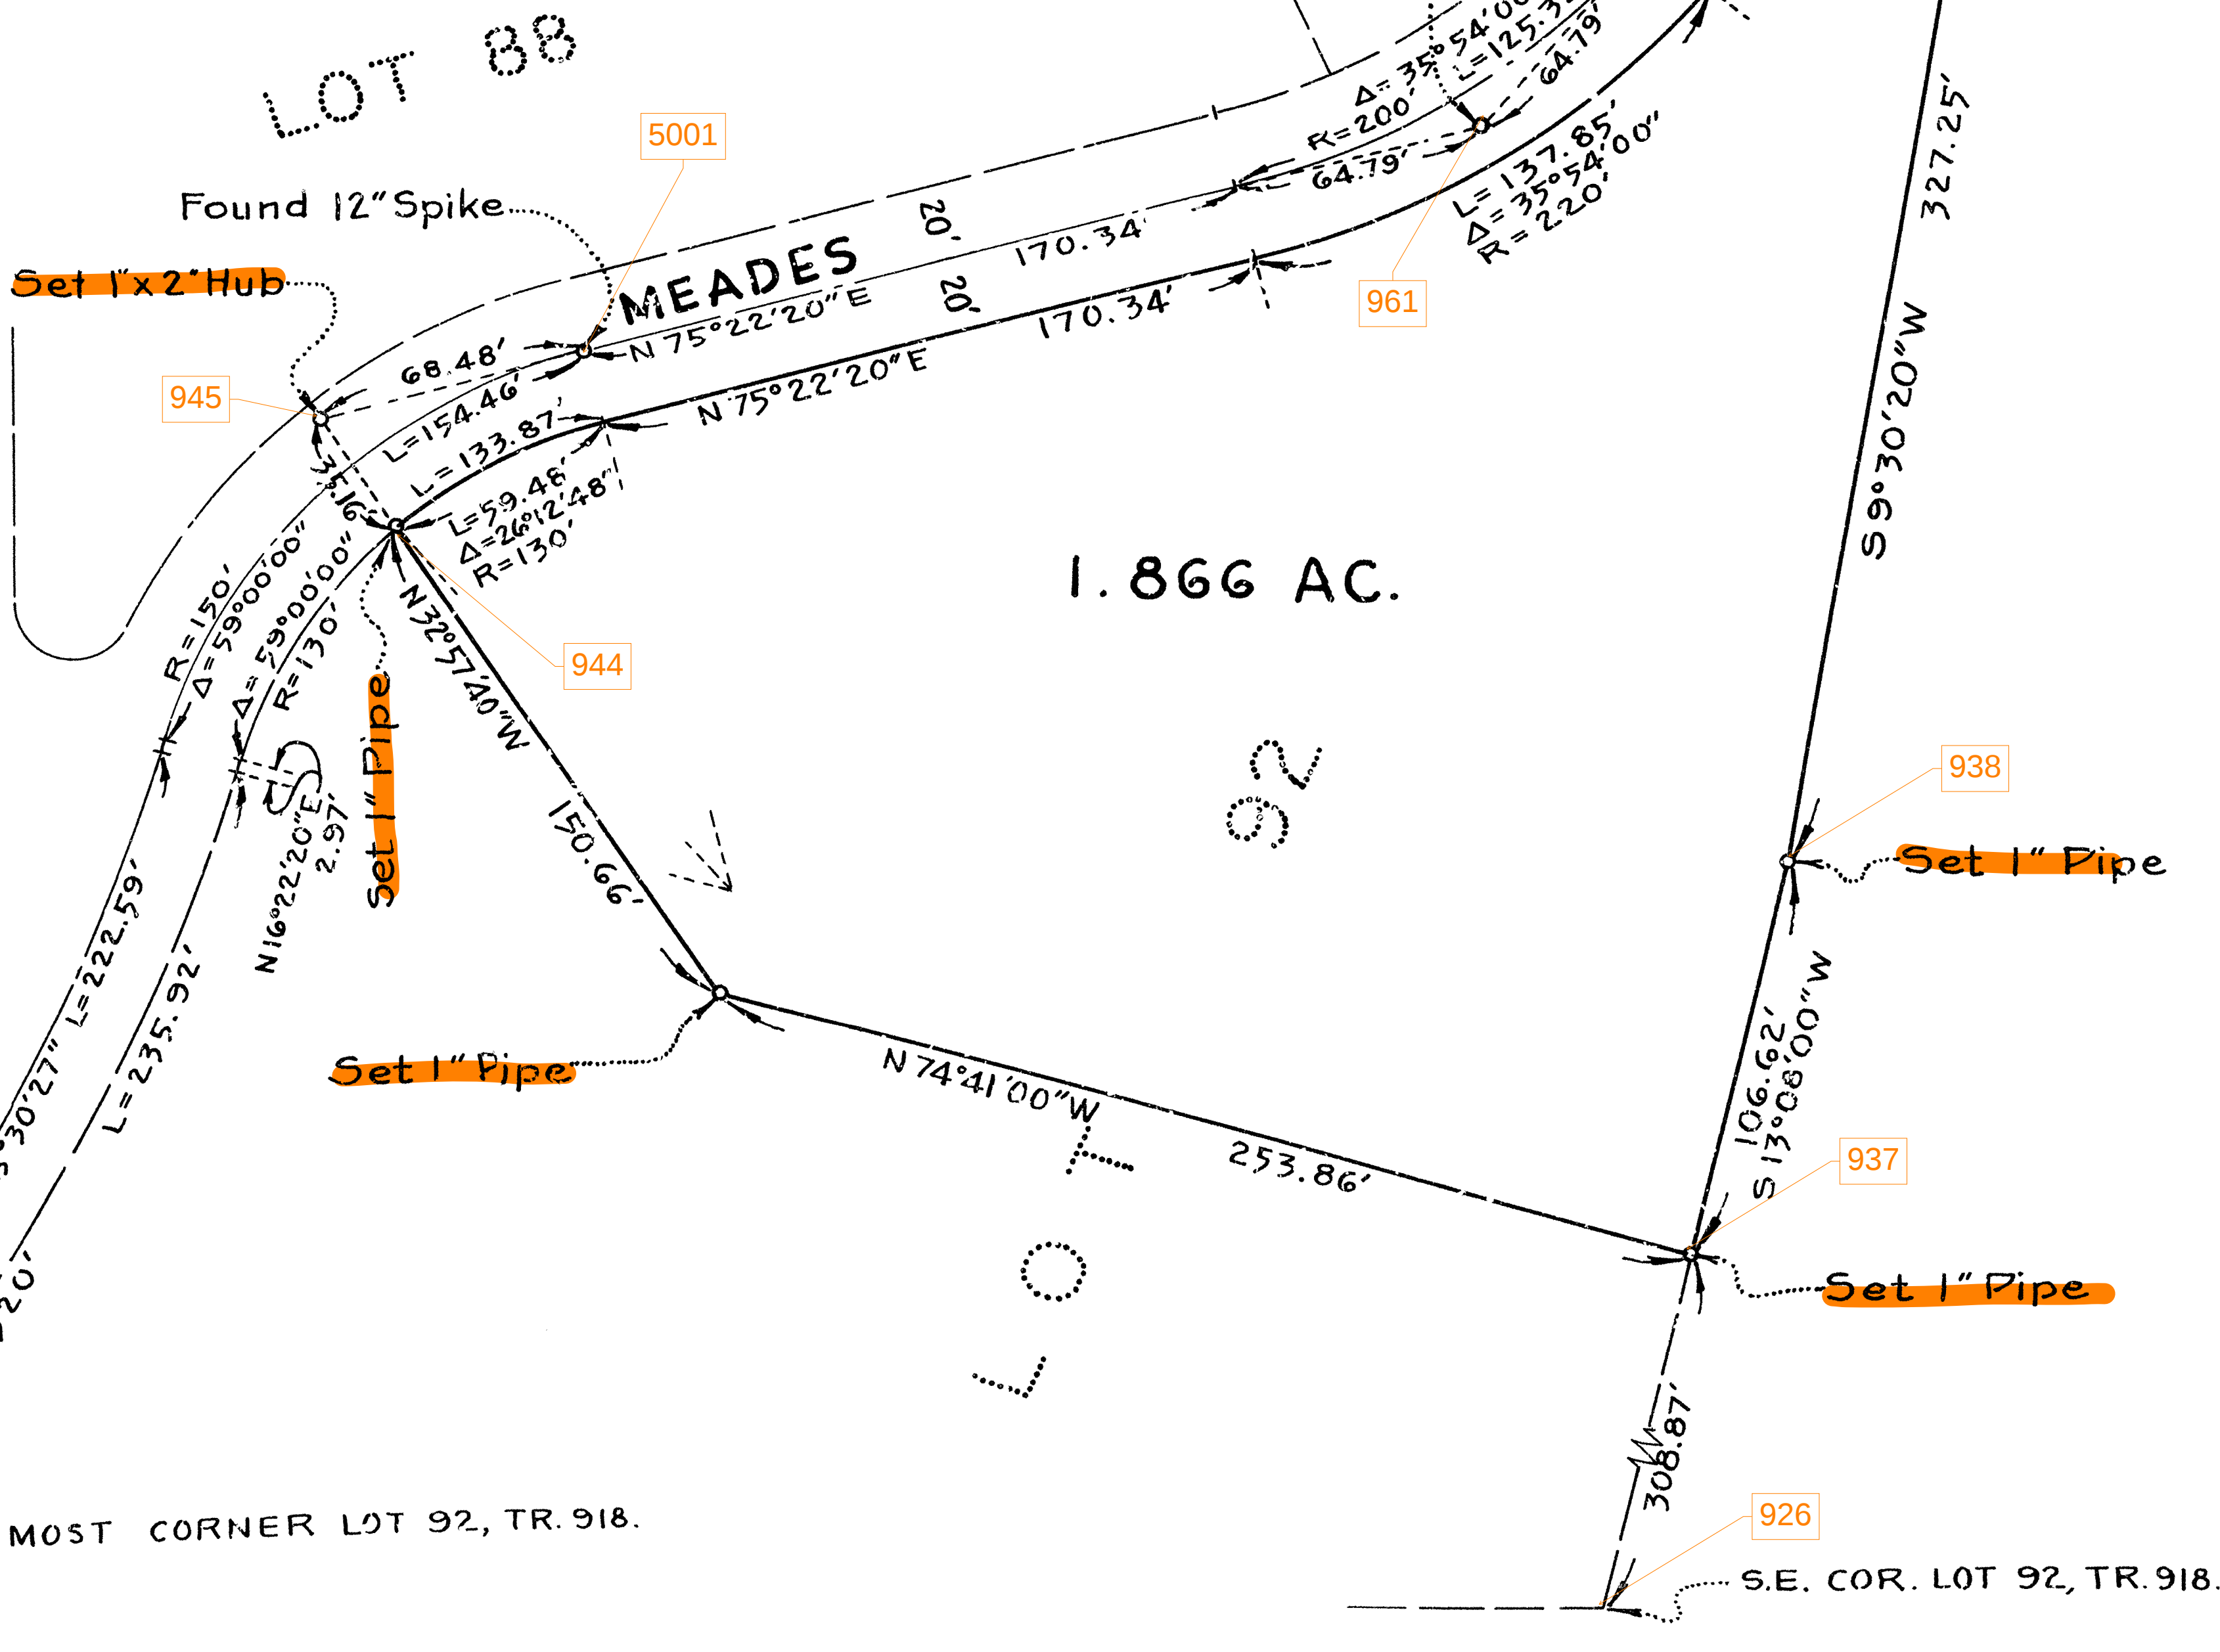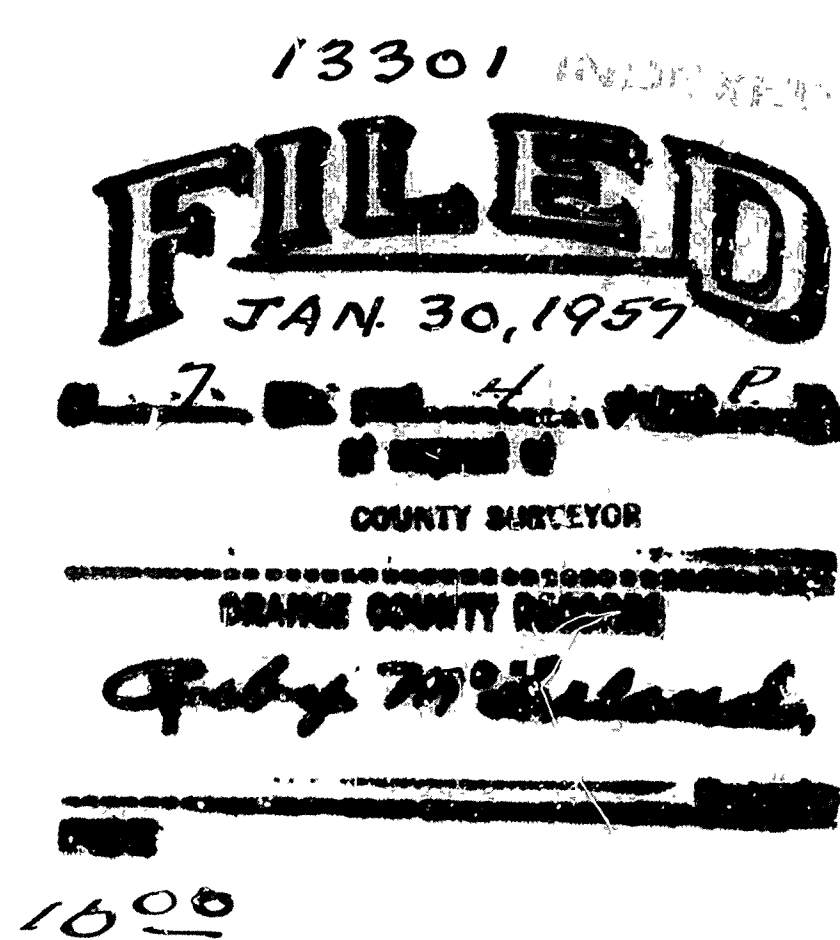

FB. D-4/18.