


FILED
MAY 22-1956
22
County Surveyor
Orange County Records


RECORD OF SURVEY

Examinated and Approved on
this 18 day of May, 1956.
20⁰⁰
Deputy County Surveyor


I, D.D. Hillyard, hereby certify that I am a Licensed Surveyor (No. 2210) of the State of California, and that this map, consisting of one sheet, represents surveys made under my supervision at the request of the owners; and that all monuments shown actually existed at the time of the surveys, and their position is correctly shown.
D.D. Hillyard
Licensed Surveyor

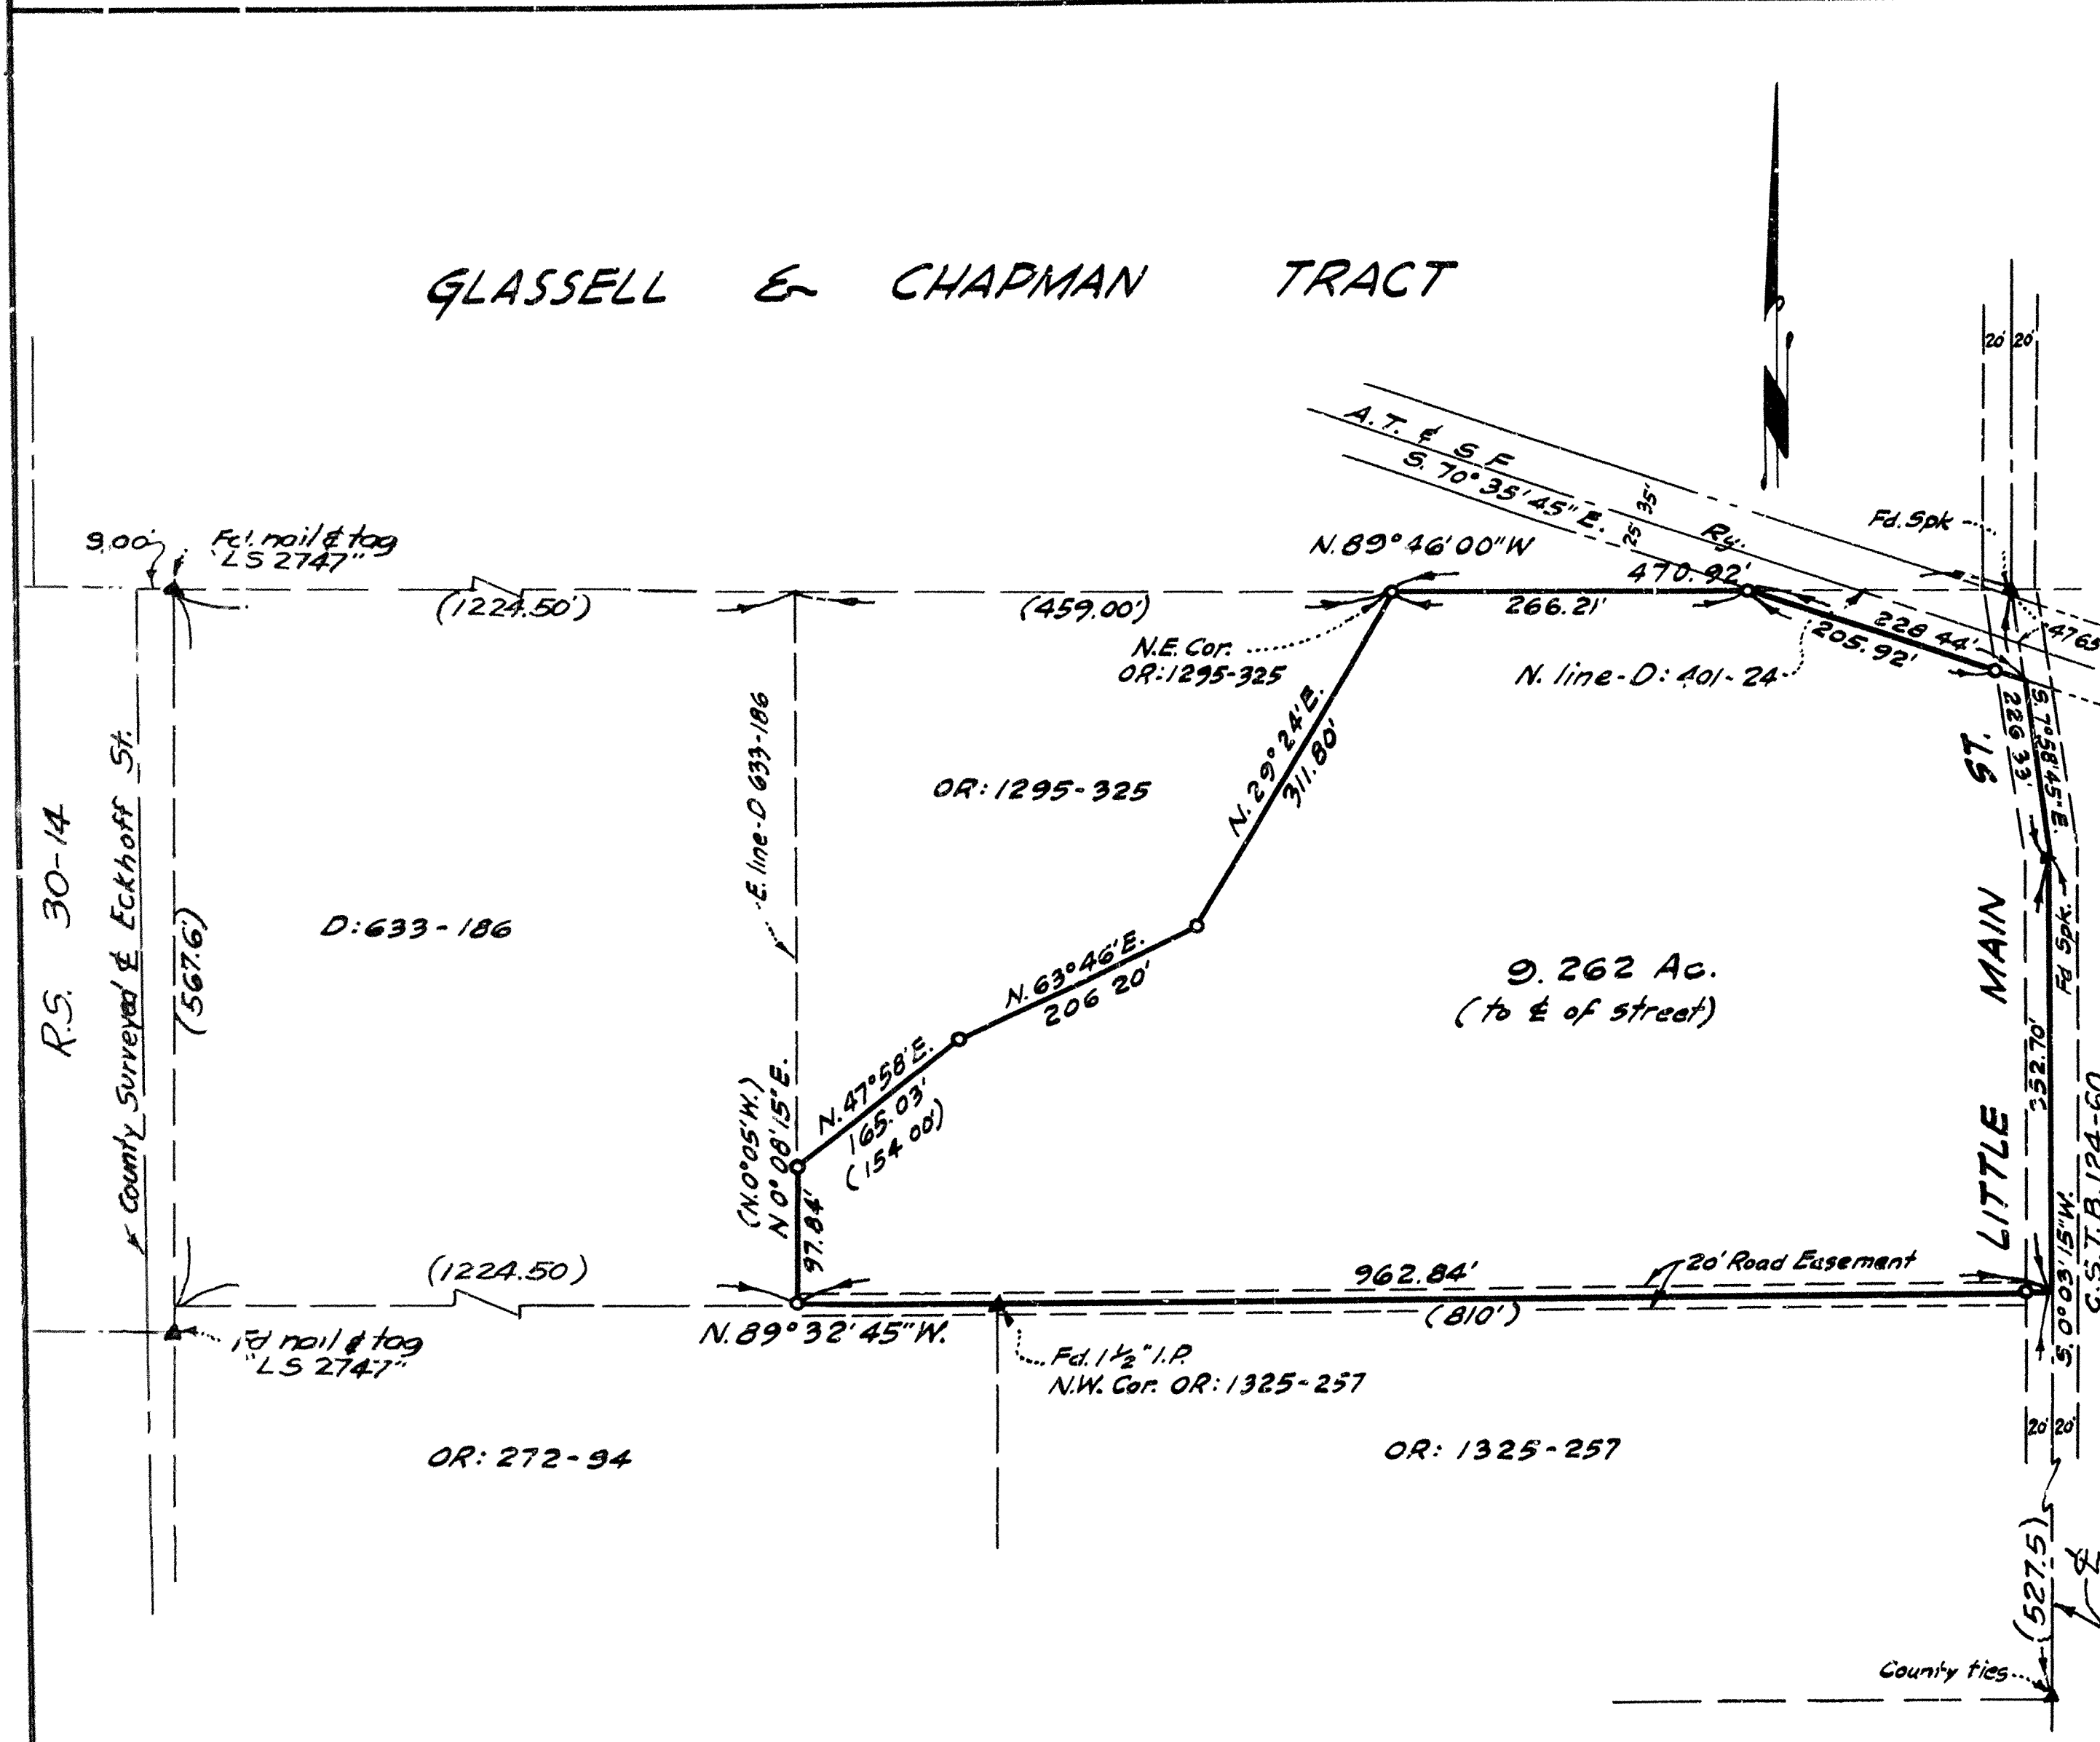


OWNER: DORA HOOKER ADAMS
DESCRIPTION: Survey of a portion of the NW 1/4 of the NW 1/4 of Sec. 30, T. 4 S., R. 9 W., S.B. 34.
SCALE: 1" = 200' SURVEYED: April 1956.
NOTES: Set 1" iron pipe bearing copper tag stamped "L.S. 2210" at points "o". Bearings are based on the North line of land conveyed to John Adams per D: 401-24, being "N. 89° 46' 00" W."

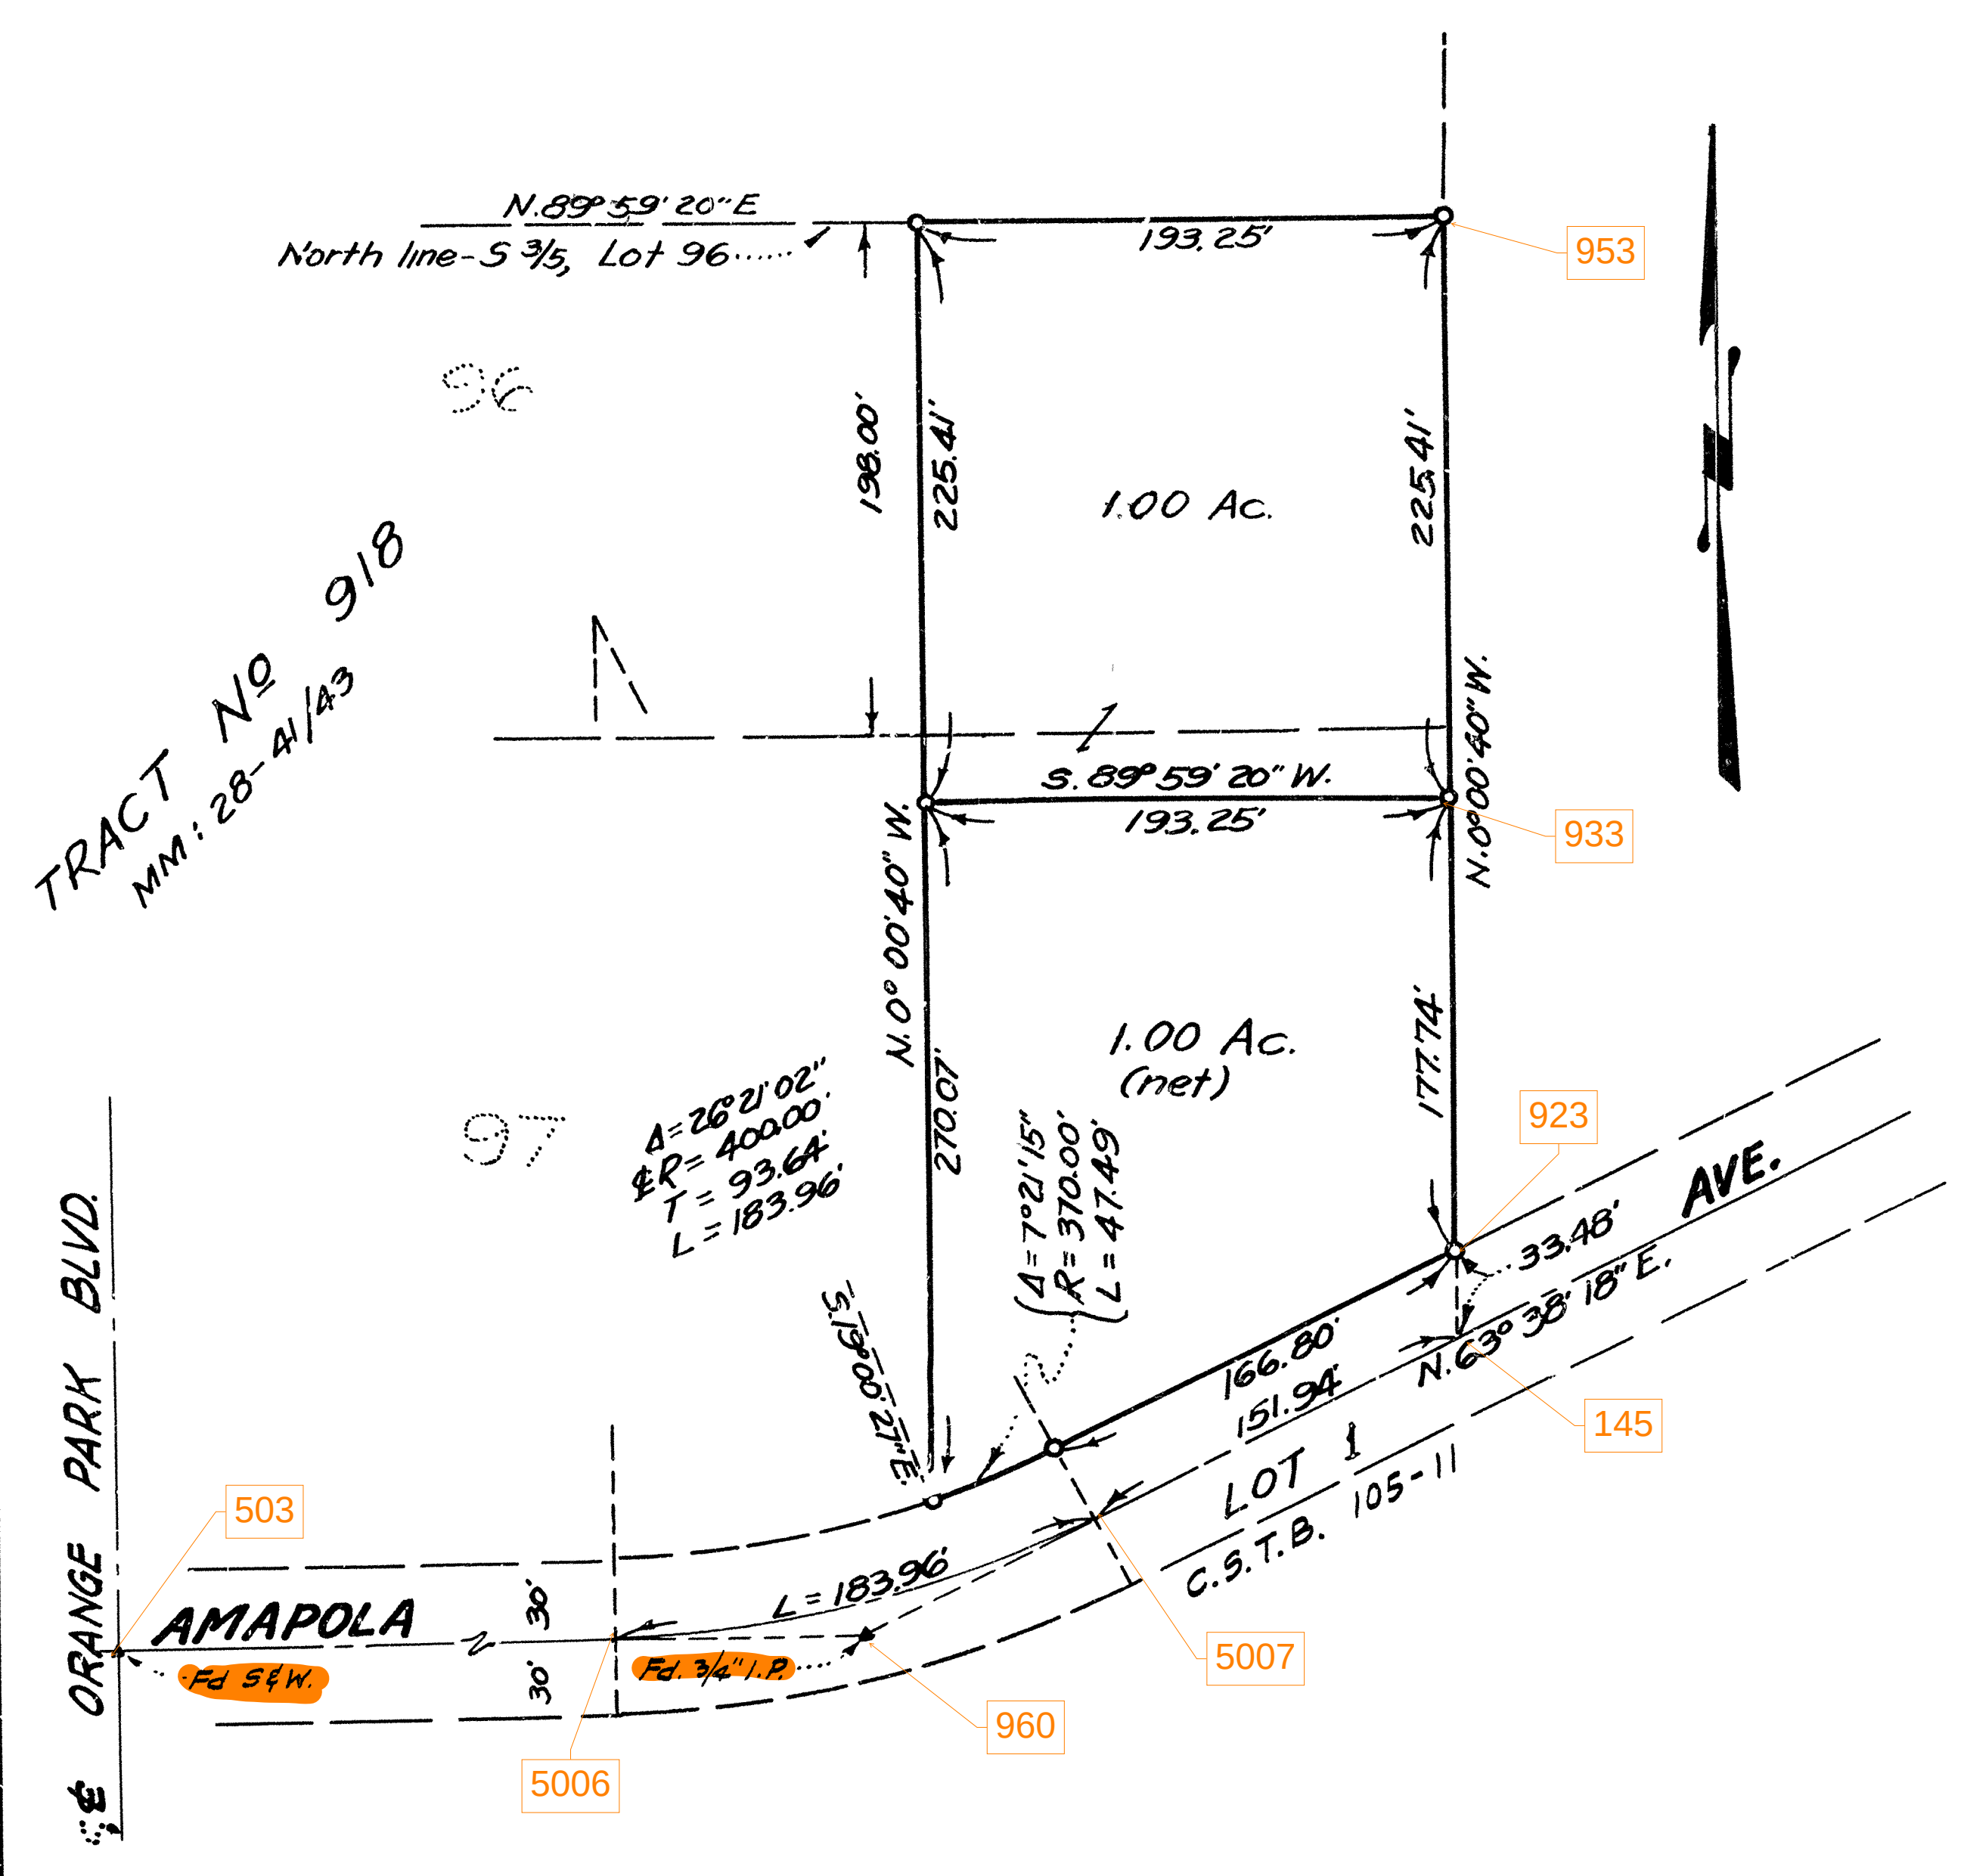

OWNER: FRANK BROWN
DESCRIPTION: Survey of portion of Lots 96 & 97 of Tract No. 918, M.M. 28-41/43, Rec. of Orange Co.
SCALE: 1" = 100' SURVEYED: March 6, 1956.
NOTES: Set 1" iron pipe bearing copper tag stamped "L.S. 2210" at points "o". Bearings hereon are based on the N. line of Lot 97 being "N. 89° 59' 20" E. as per Tract No. 918, M.M. 28-41/43.

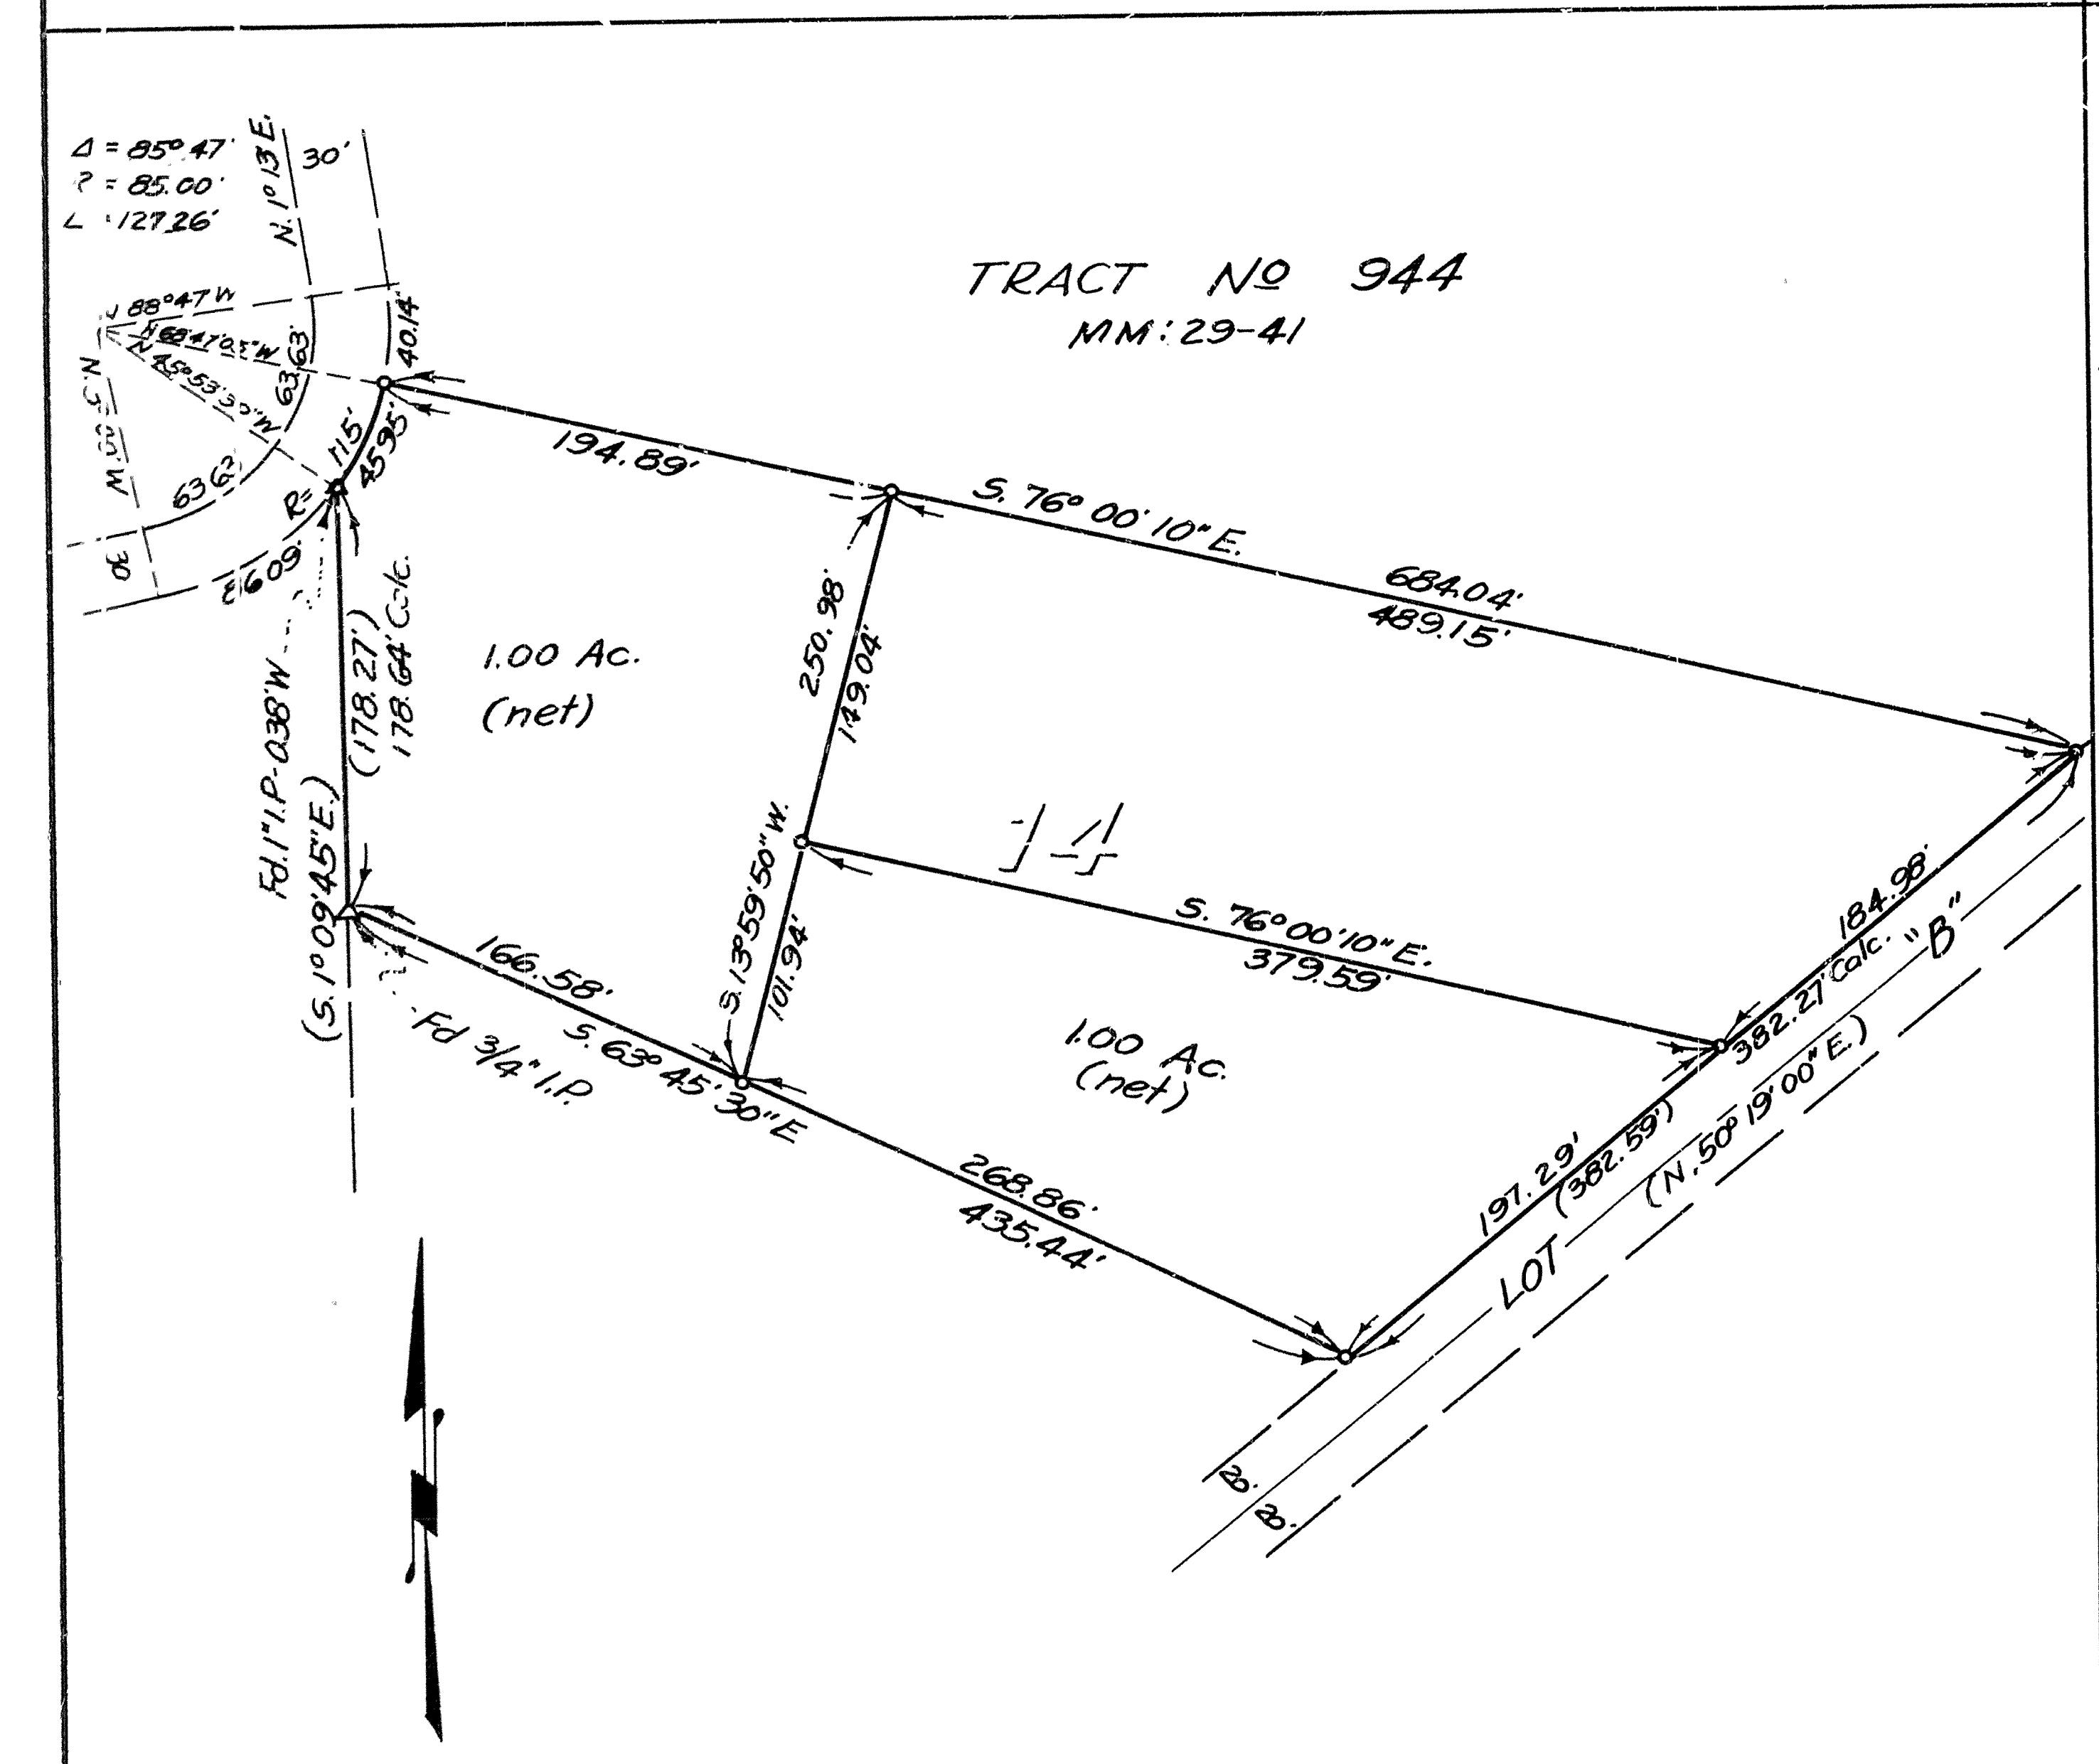

OWNER: JEANE GLEASON
DESCRIPTION: Survey of Lot 14, Tract No. 944, M.M. 29-41, Rec. of Orange Co.
SCALE: 1" = 100' SURVEYED: March 7, 1956.
NOTES: Set 1" iron pipe bearing copper tag stamped "L.S. 2210" at points "o". Dimensions and bearing in () are as per Tract No. 944, M.M. 29-41. Bearings hereon are based on the W'y. line of Lot 14, being "S. 1° 09' 45" E. as per Tract No. 944, M.M. 29-41.

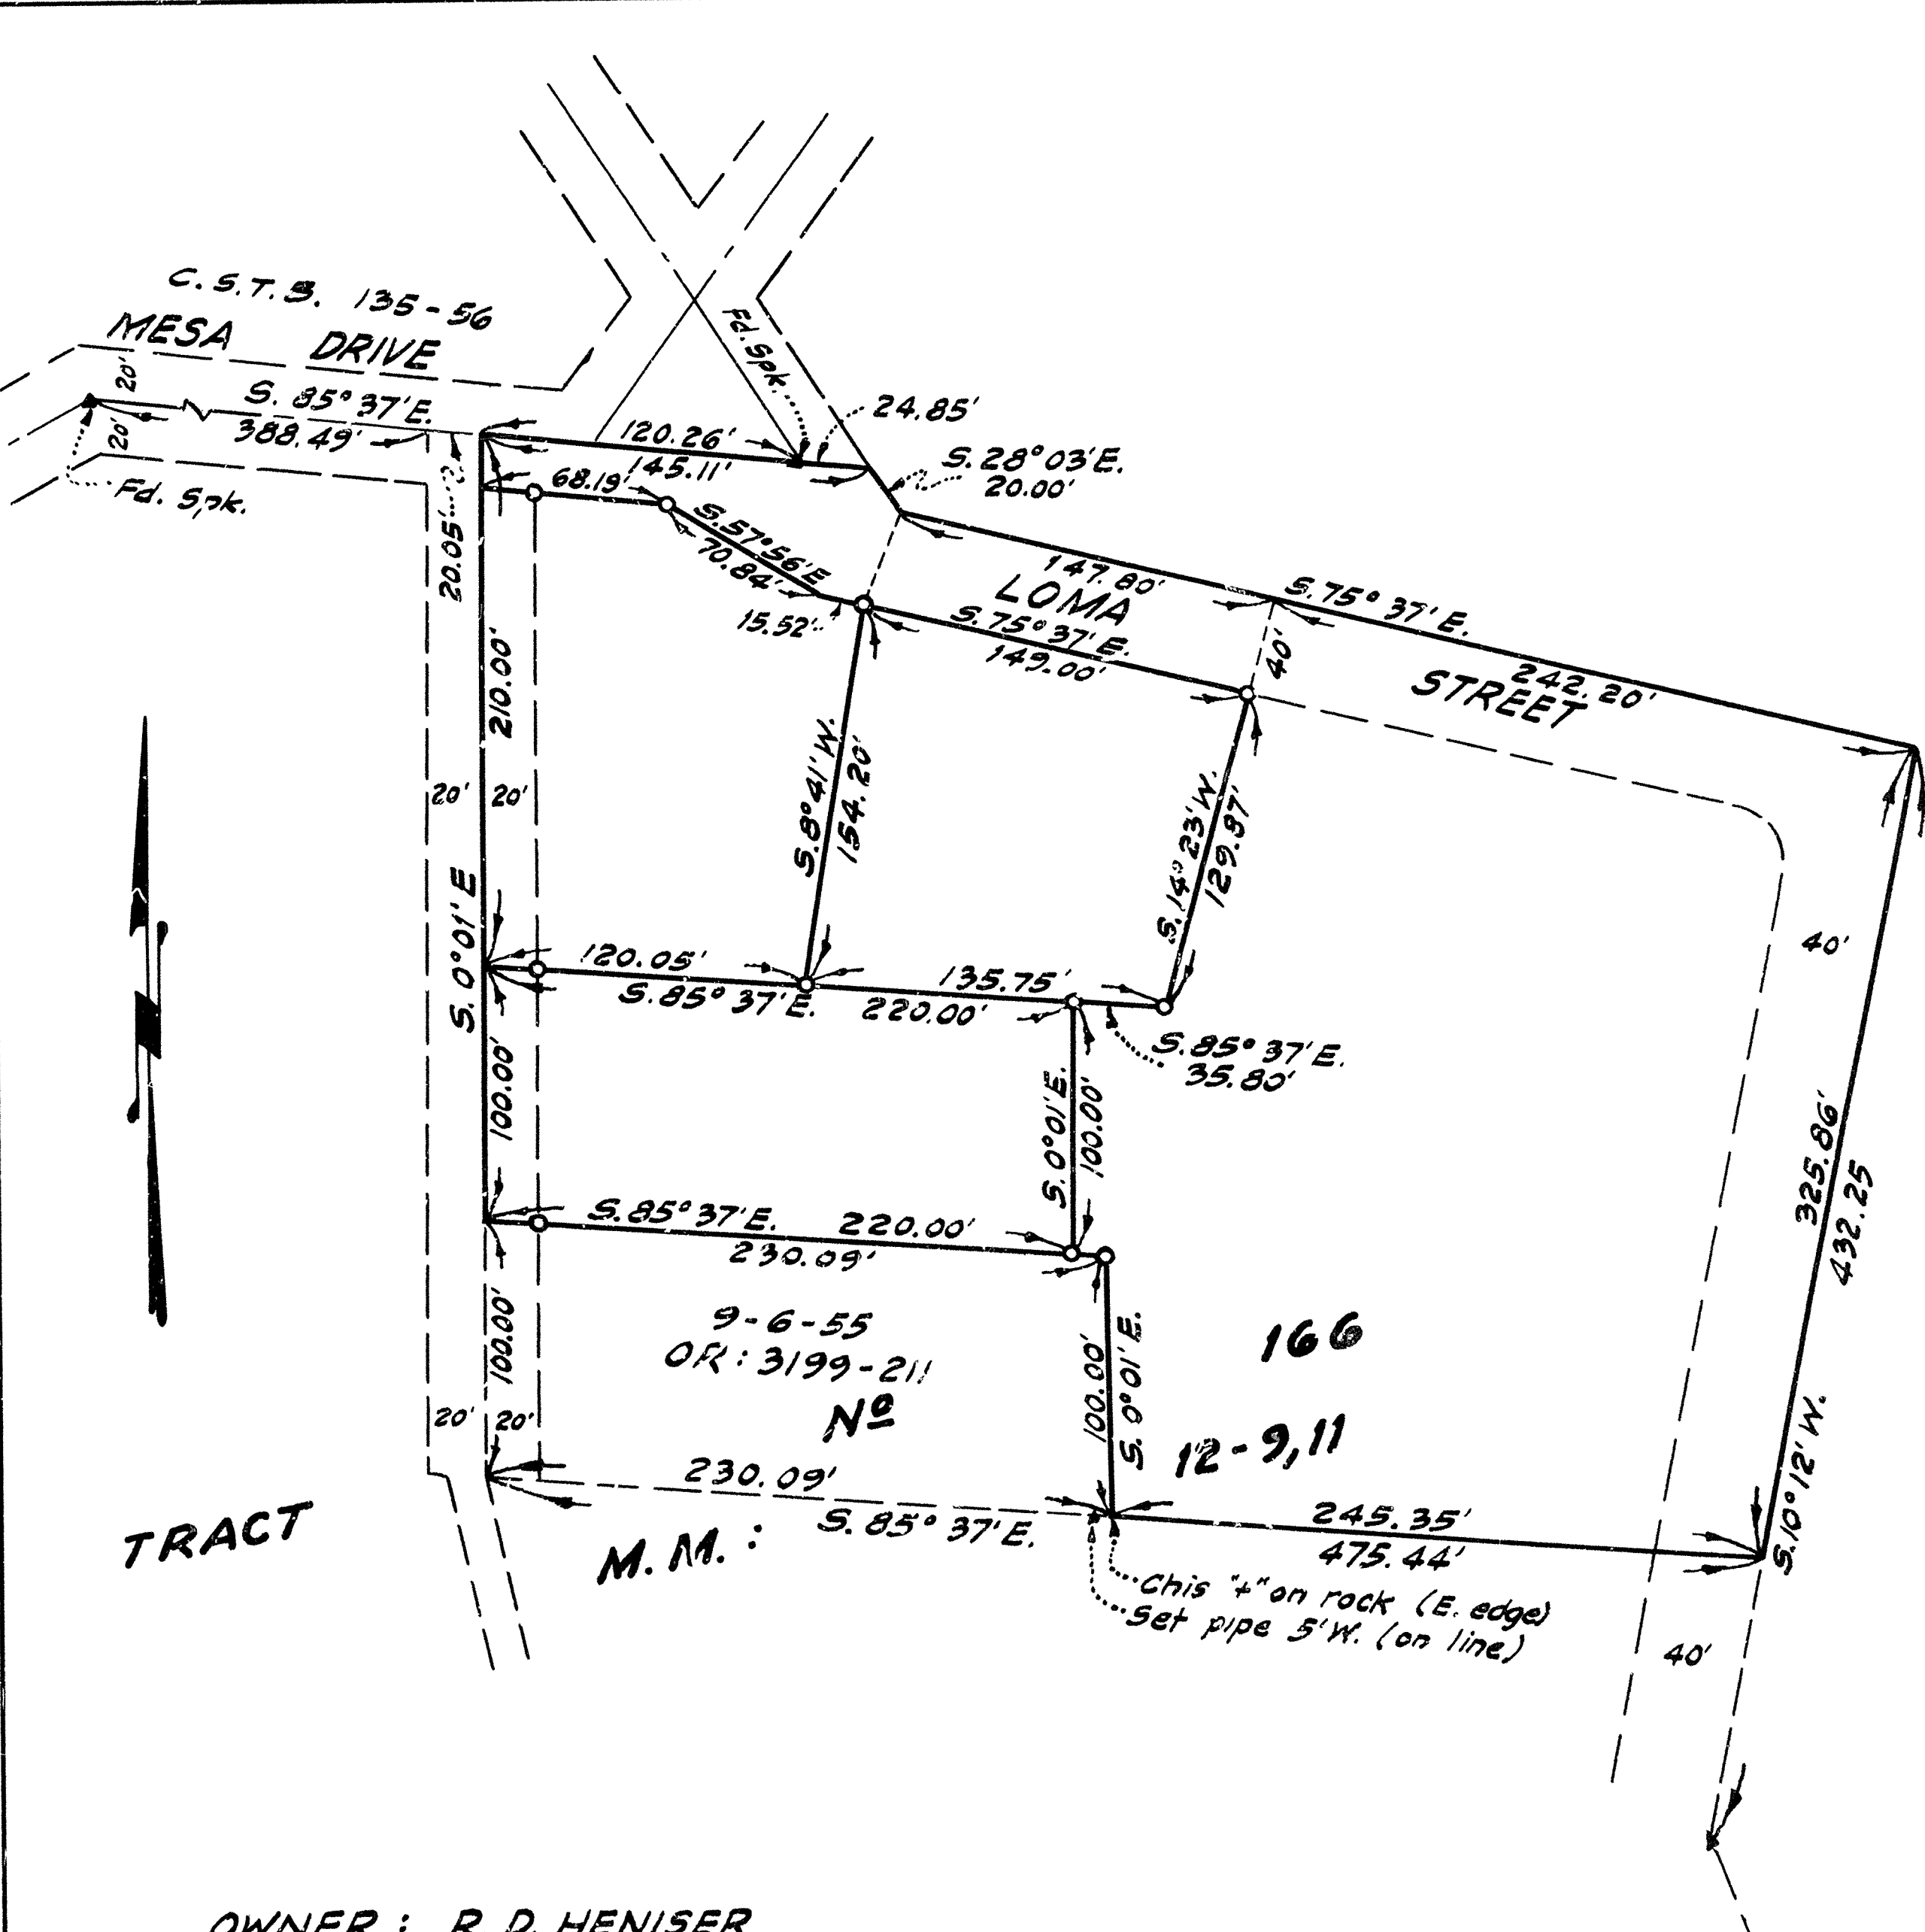

OWNER: R.D. HENISER
DESCRIPTION: Survey of a portion of Lot 36, Tract No. 166, M.M. 12-9, 11, Rec. of Orange Co., Calif.
SCALE: 1" = 100' SURVEYED: March 22, 1956.
NOTES: Set 1" iron pipe bearing copper tag stamped "L.S. 2210" at all points "o". Bearings are based on the E. of Mesa Drive, being "S. 85° 37' E." as per Tract No. 166, M.M. 12-9, 11, Rec. of Orange Co., Calif.