

RECORD OF SURVEY

OF PARCELS SHOWN BELOW,
GIVING NAME OF OWNER, DATE OF
SURVEY, SCALE, AND OTHER DATA
AS INDICATED.
D. D. HILLYARD, LICENSED SURVEYOR

FILED
Nov. 28, 1951
At 3:55 P.M. past 2 o'clock P.M.
at request of
W. H. Hillyard
ORANGE COUNTY RECORDS
By W. H. Hillyard
4.00

OWNER:

Ernest N. Winbigler


DESCRIPTION:

Part of Blk. 15, Irvine's
Subdivision, MRM: 1-88

SURVEYED:

August 15, 1951

SCALE: 1" = 100'

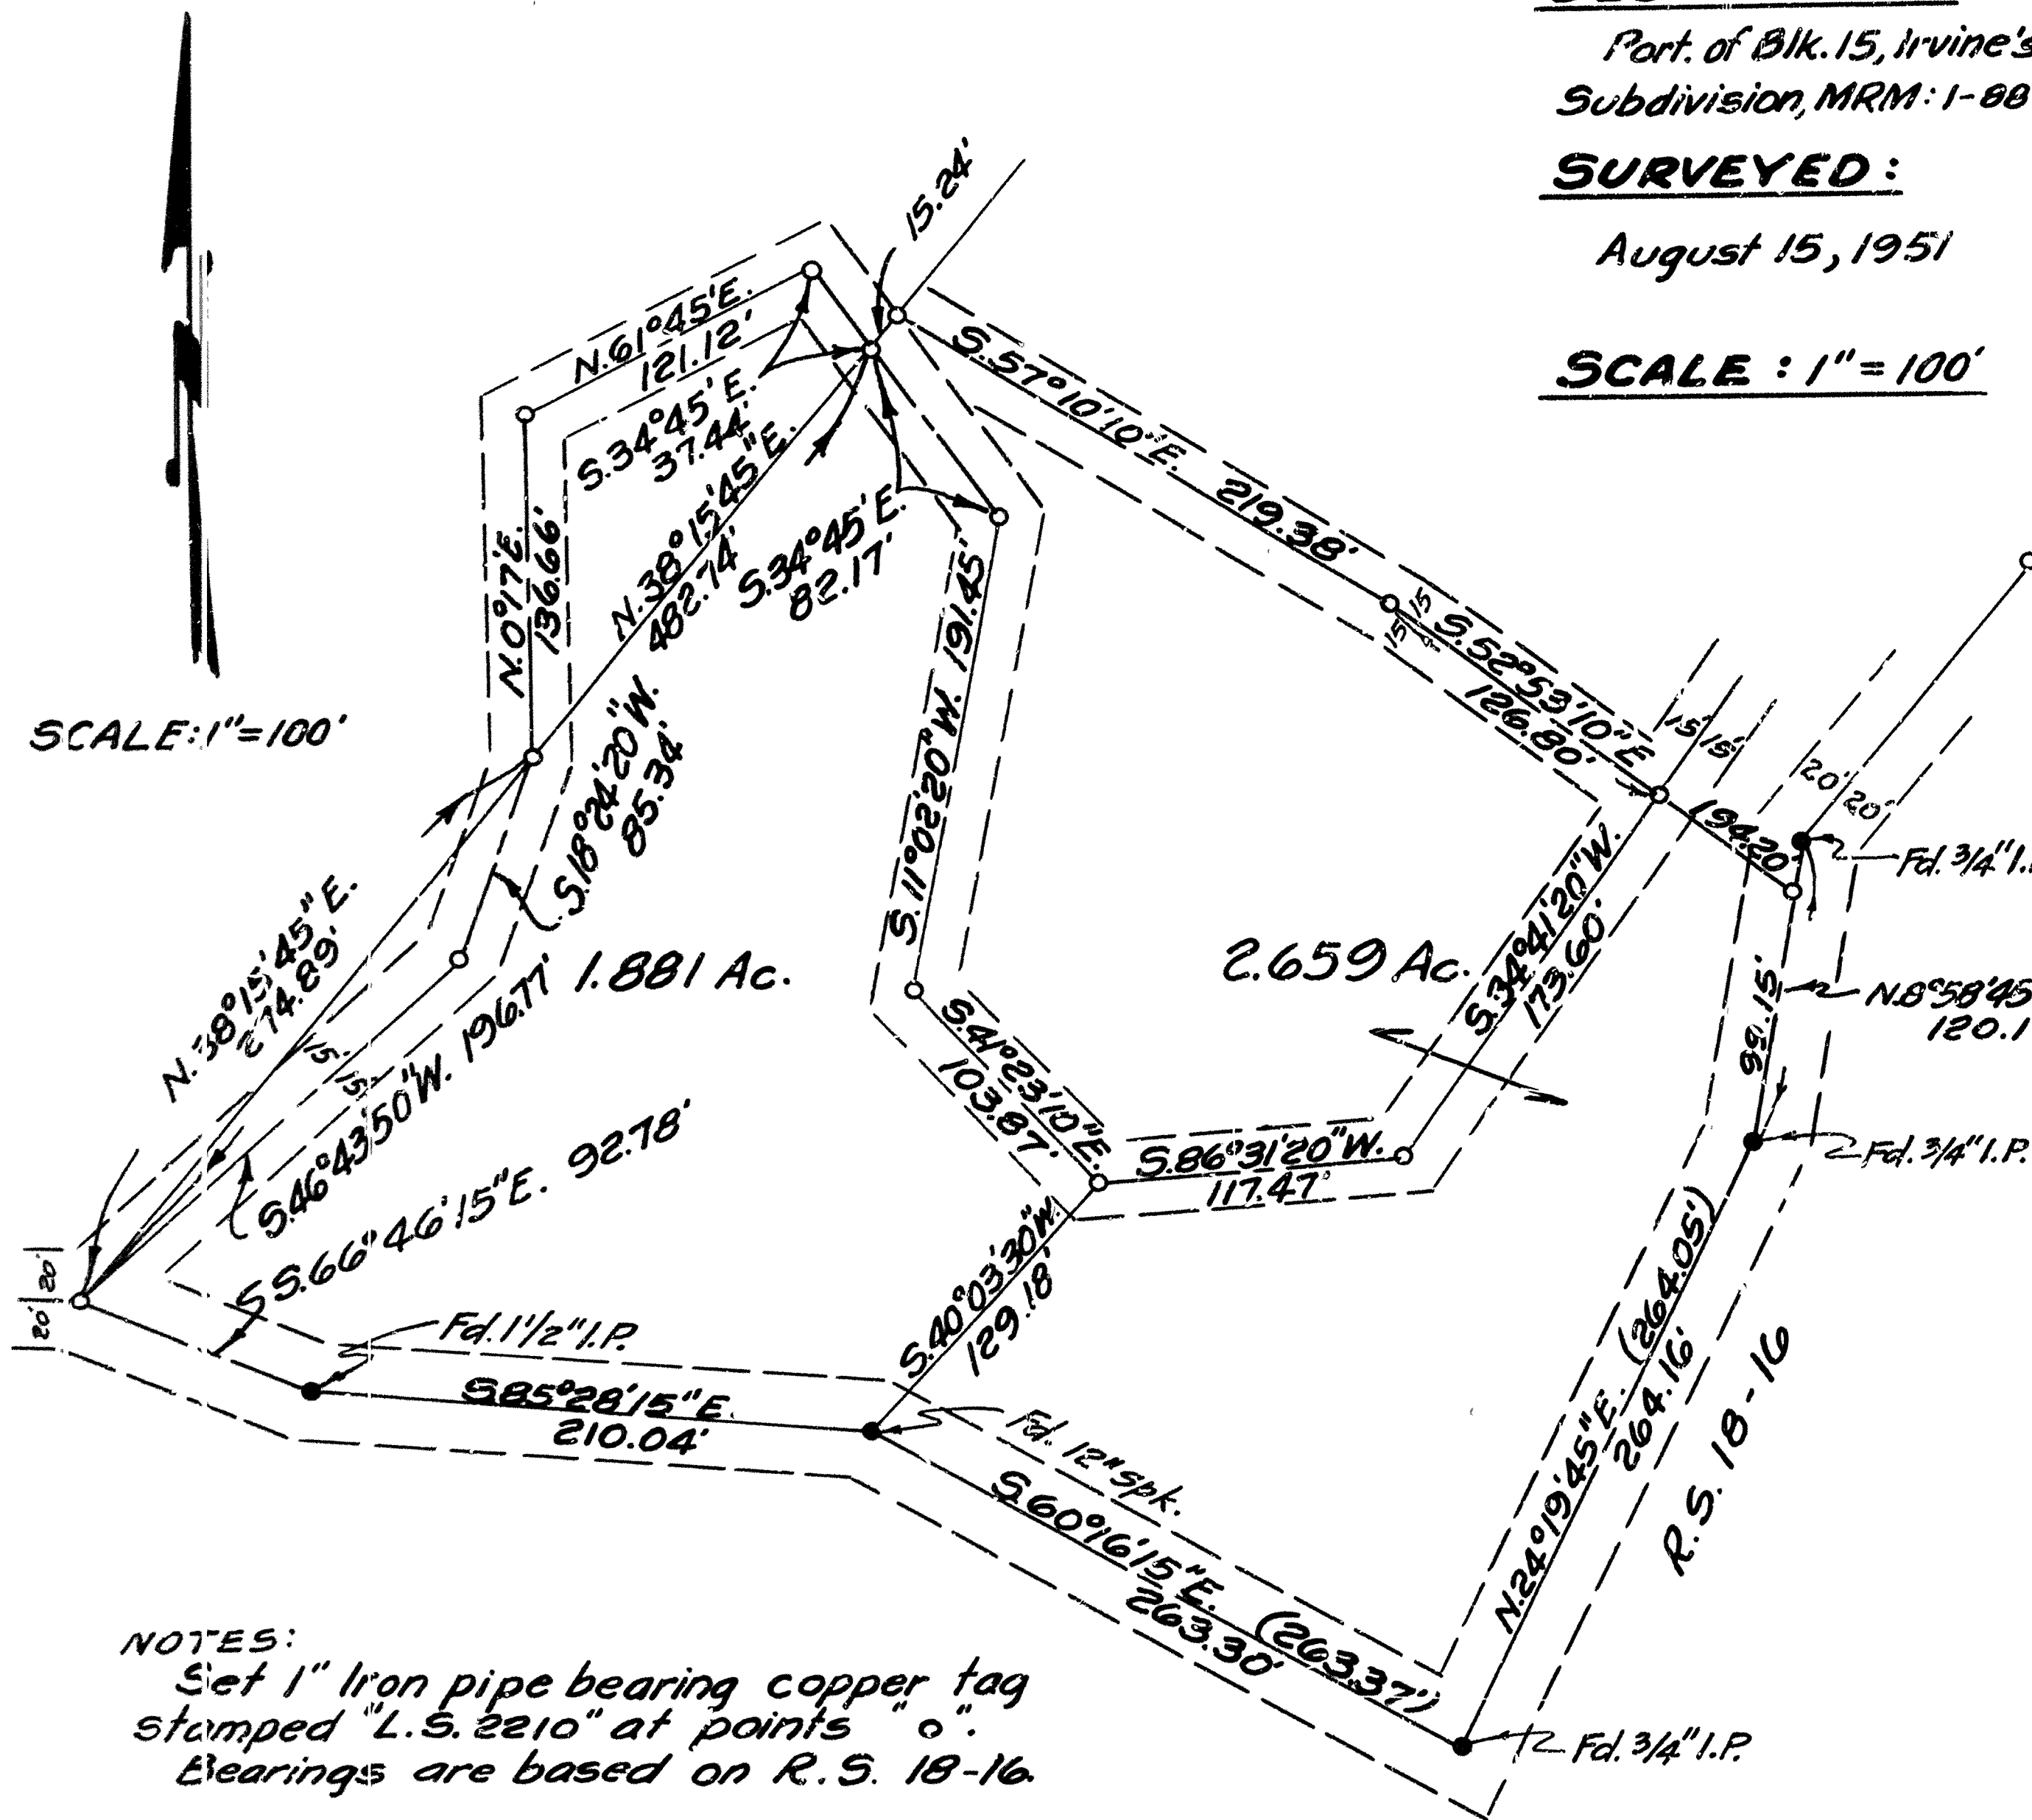

NOTES:
Set 1" Iron pipe bearing copper tag
stamped "L.S. 2210" at points "o".
Bearings are based on R.S. 18-16.

60-23

OWNER:

Orange Park Acres, Inc.


DESCRIPTION:

Part of Lots 79 & 84,
Tr. No. 918, MM: 28-41-43,
inc.

SURVEYED:

Oct. 3, 1951

SCALE: 1" = 200'

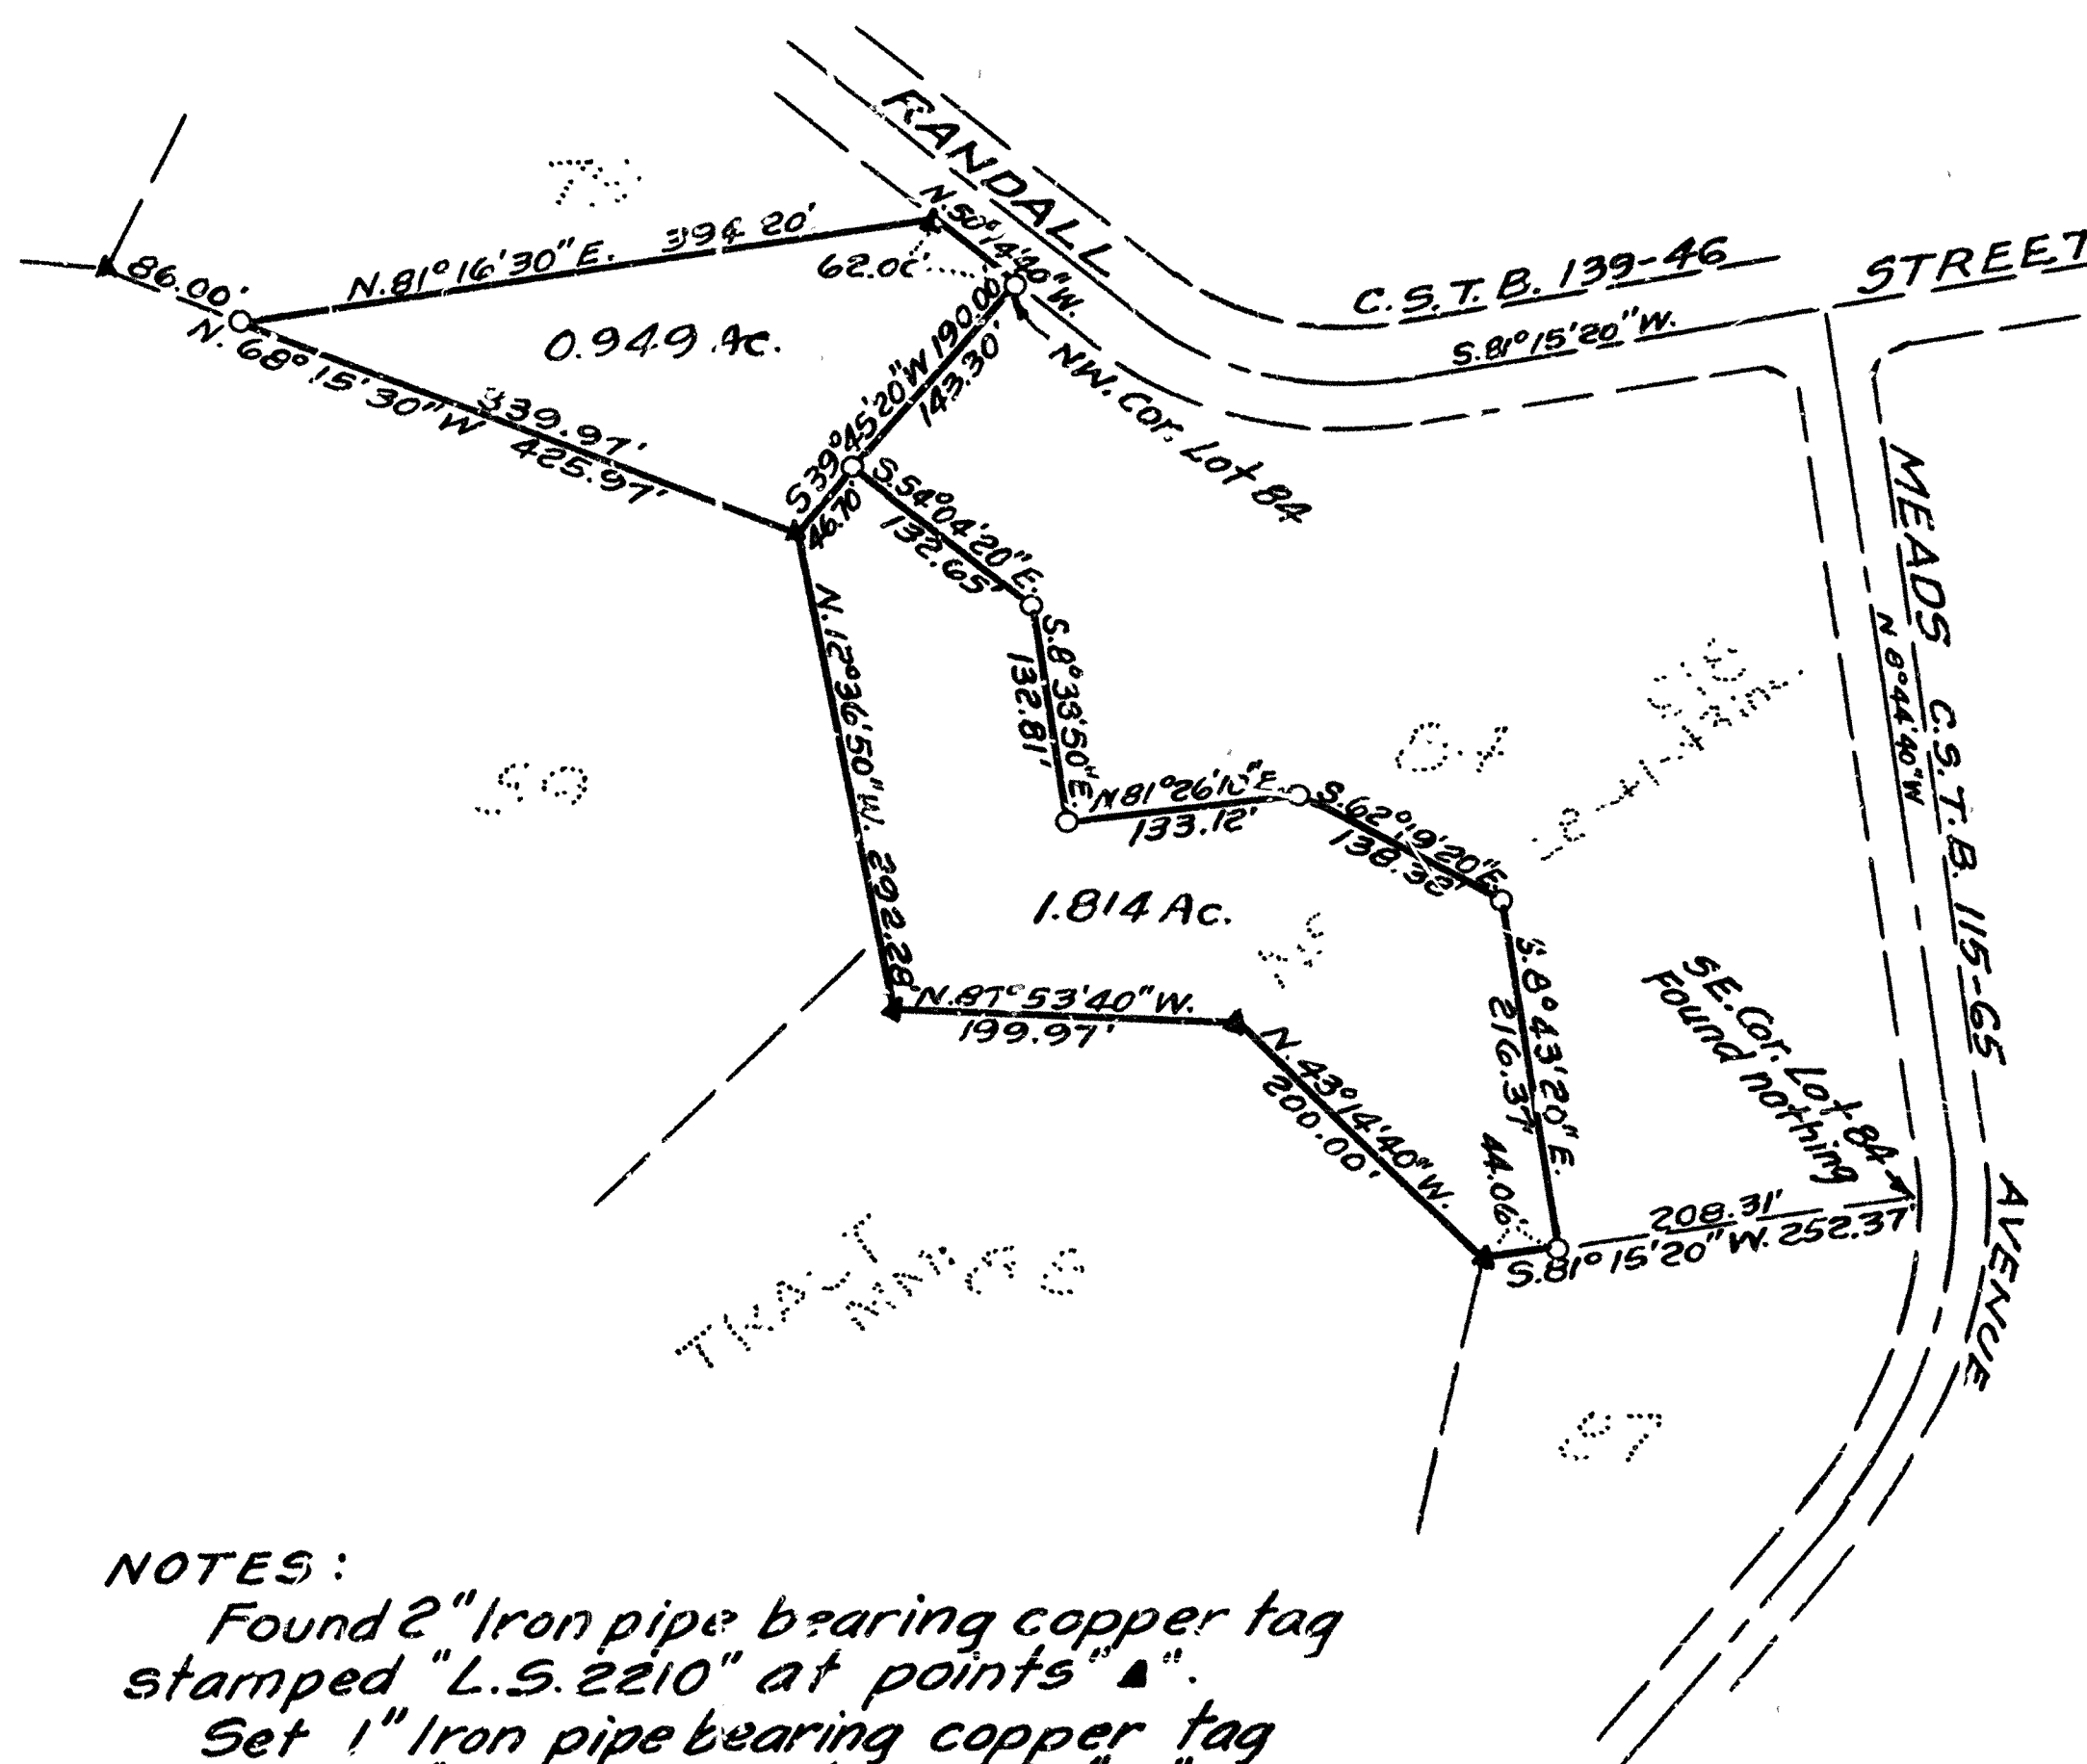

NOTES:
Found 2" Iron pipe bearing copper tag
stamped "L.S. 2210" at points "a".
Set 1" Iron pipe bearing copper tag
stamped "L.S. 2210" at points "o".
Bearings are based on (S. 81° 15' 20" W.)
as per 3/4 line of Lot 84, Tr. No. 918, MM: 28-41-43 inc.

60-29

OWNER:

Louie Tetzlaff, Estate


DESCRIPTION:

Parts of SE 1/4 of Sect. 7 E.
NE 1/4 of Sect. 18, T. 4 S.,
R. 9 W., S. B. & M.

SURVEYED:

Sept. 19, 1951.

SCALE: 1" = 200'

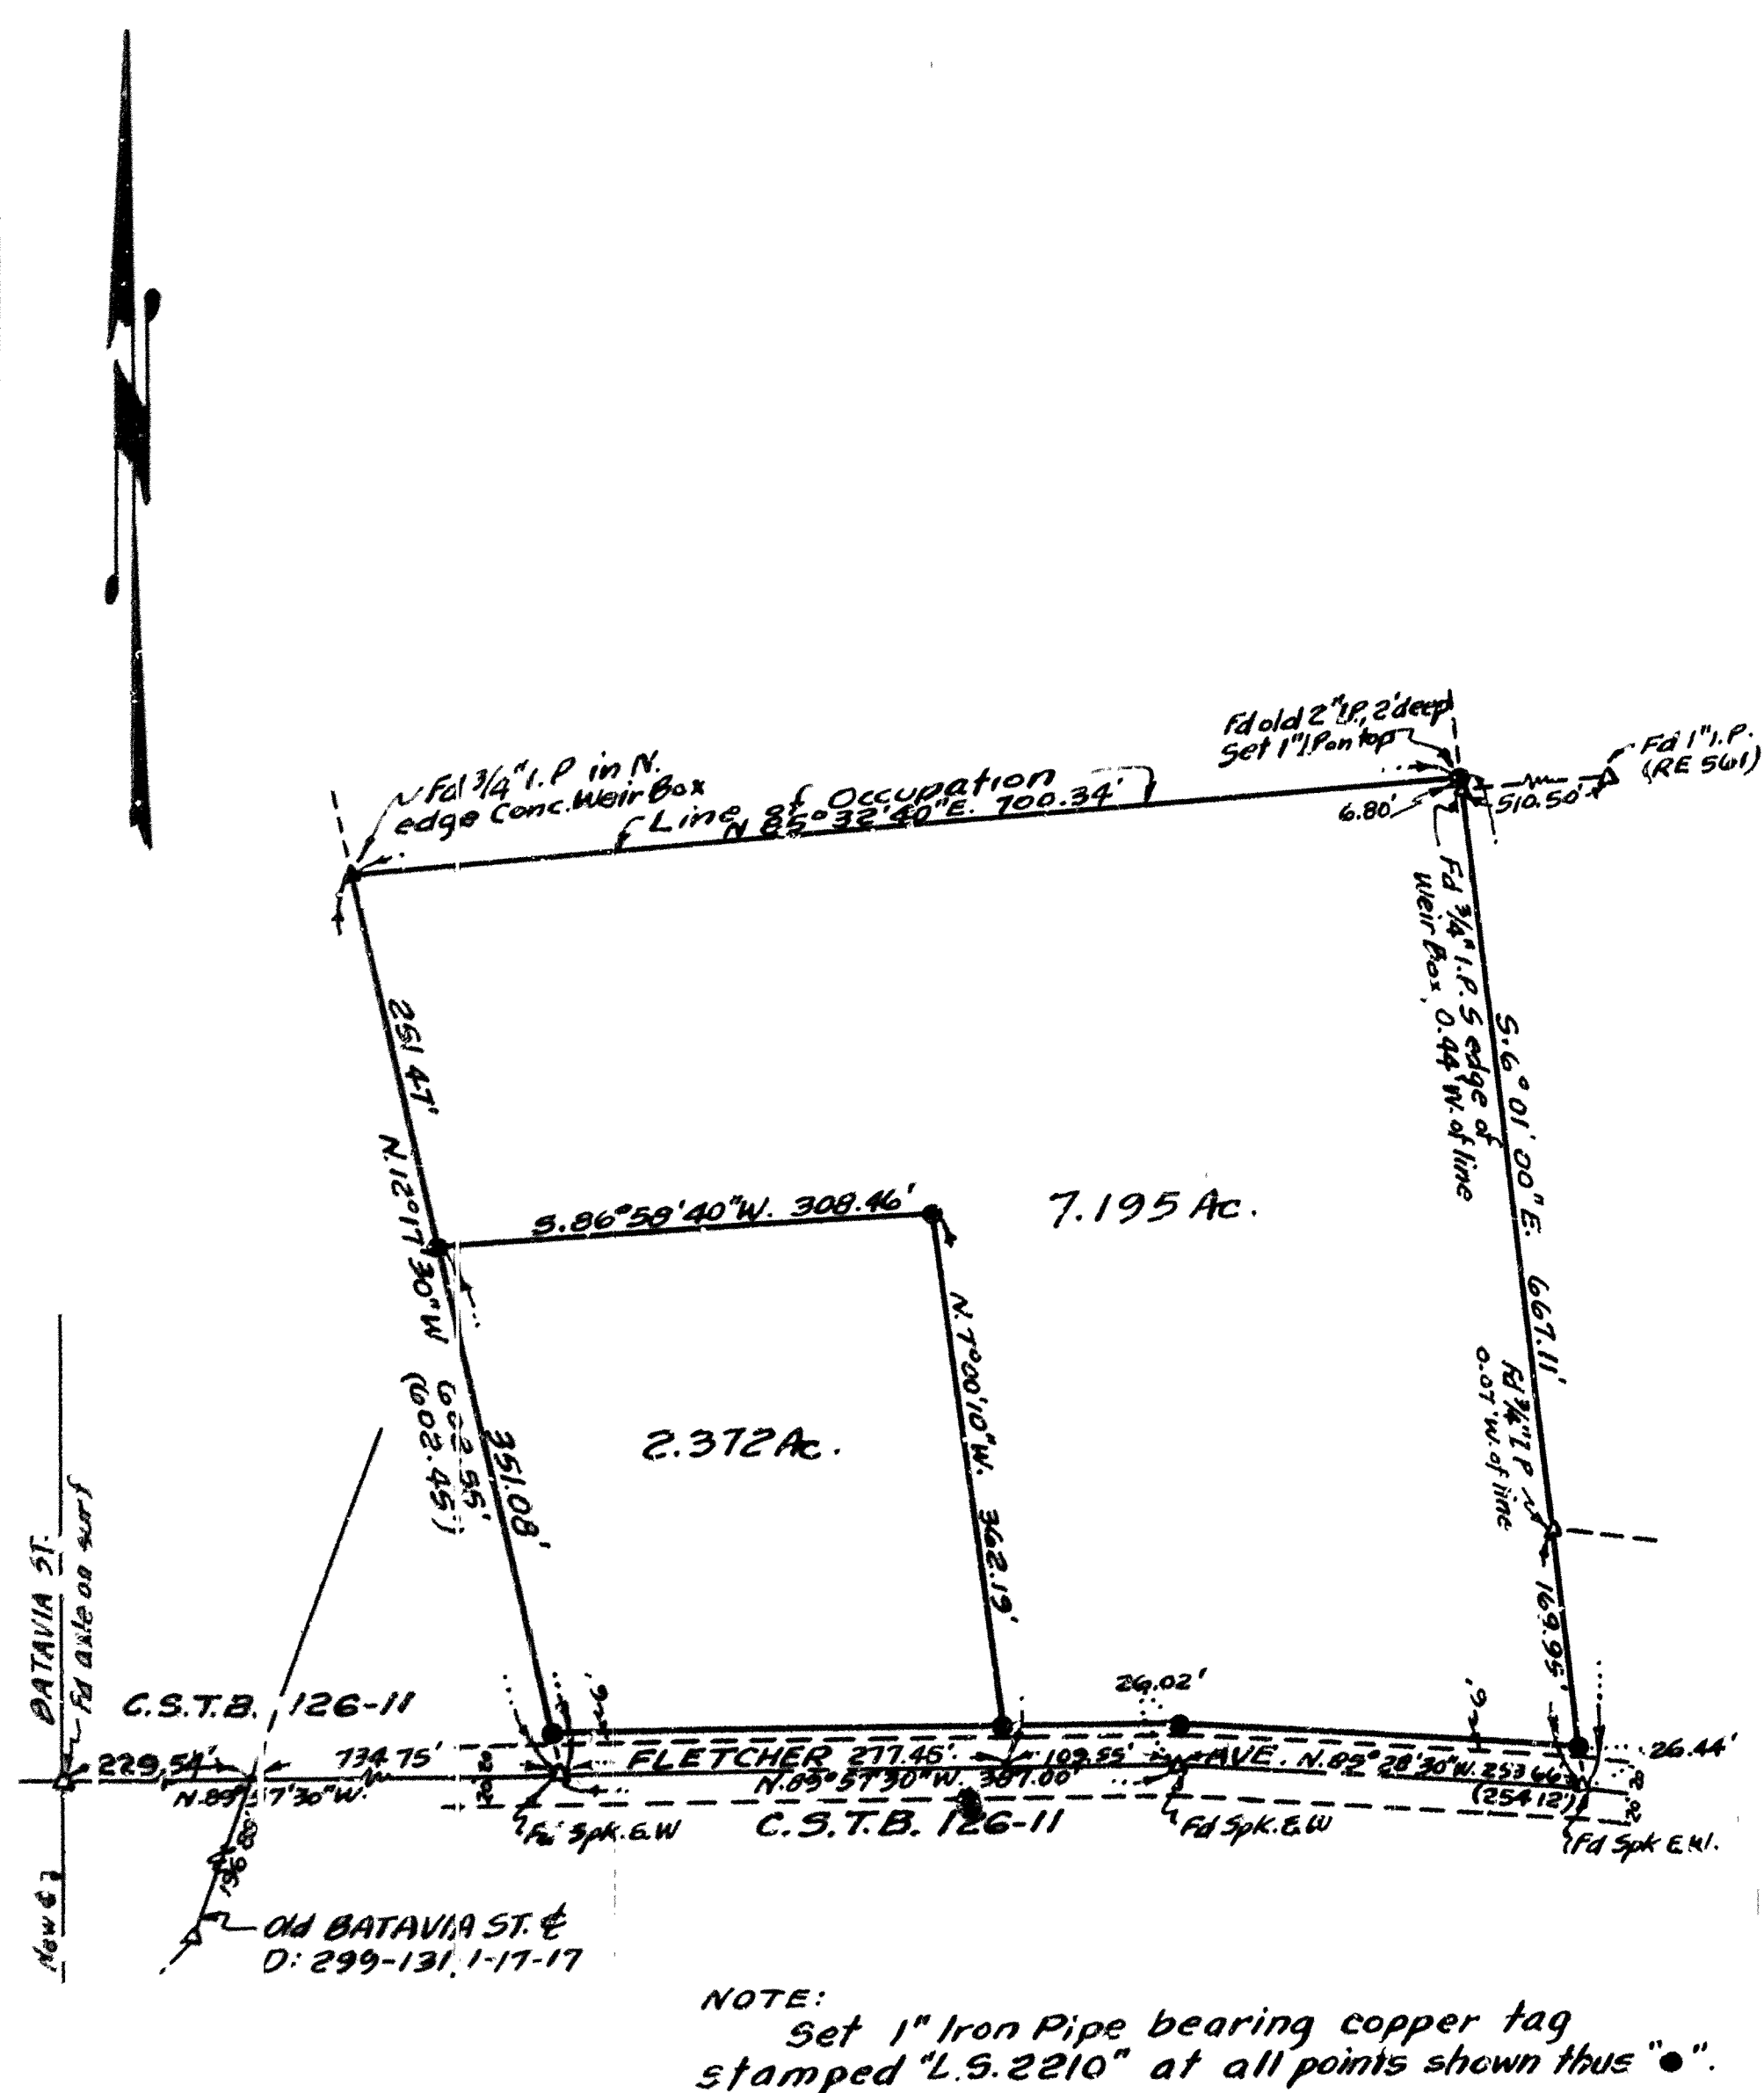

NOTE:
Set 1" Iron Pipe bearing copper tag
stamped "L.S. 2210" at all points shown thus "o".

60-27 & 28

OWNER:

Fred S. Chapman


DESCRIPTION:

Parts of Sect. 23 & 24,
T. 4 S., R. 9 W., S. B. & M.

SURVEYED:

Sept. 13, 1951.

SCALE: 1" = 200'

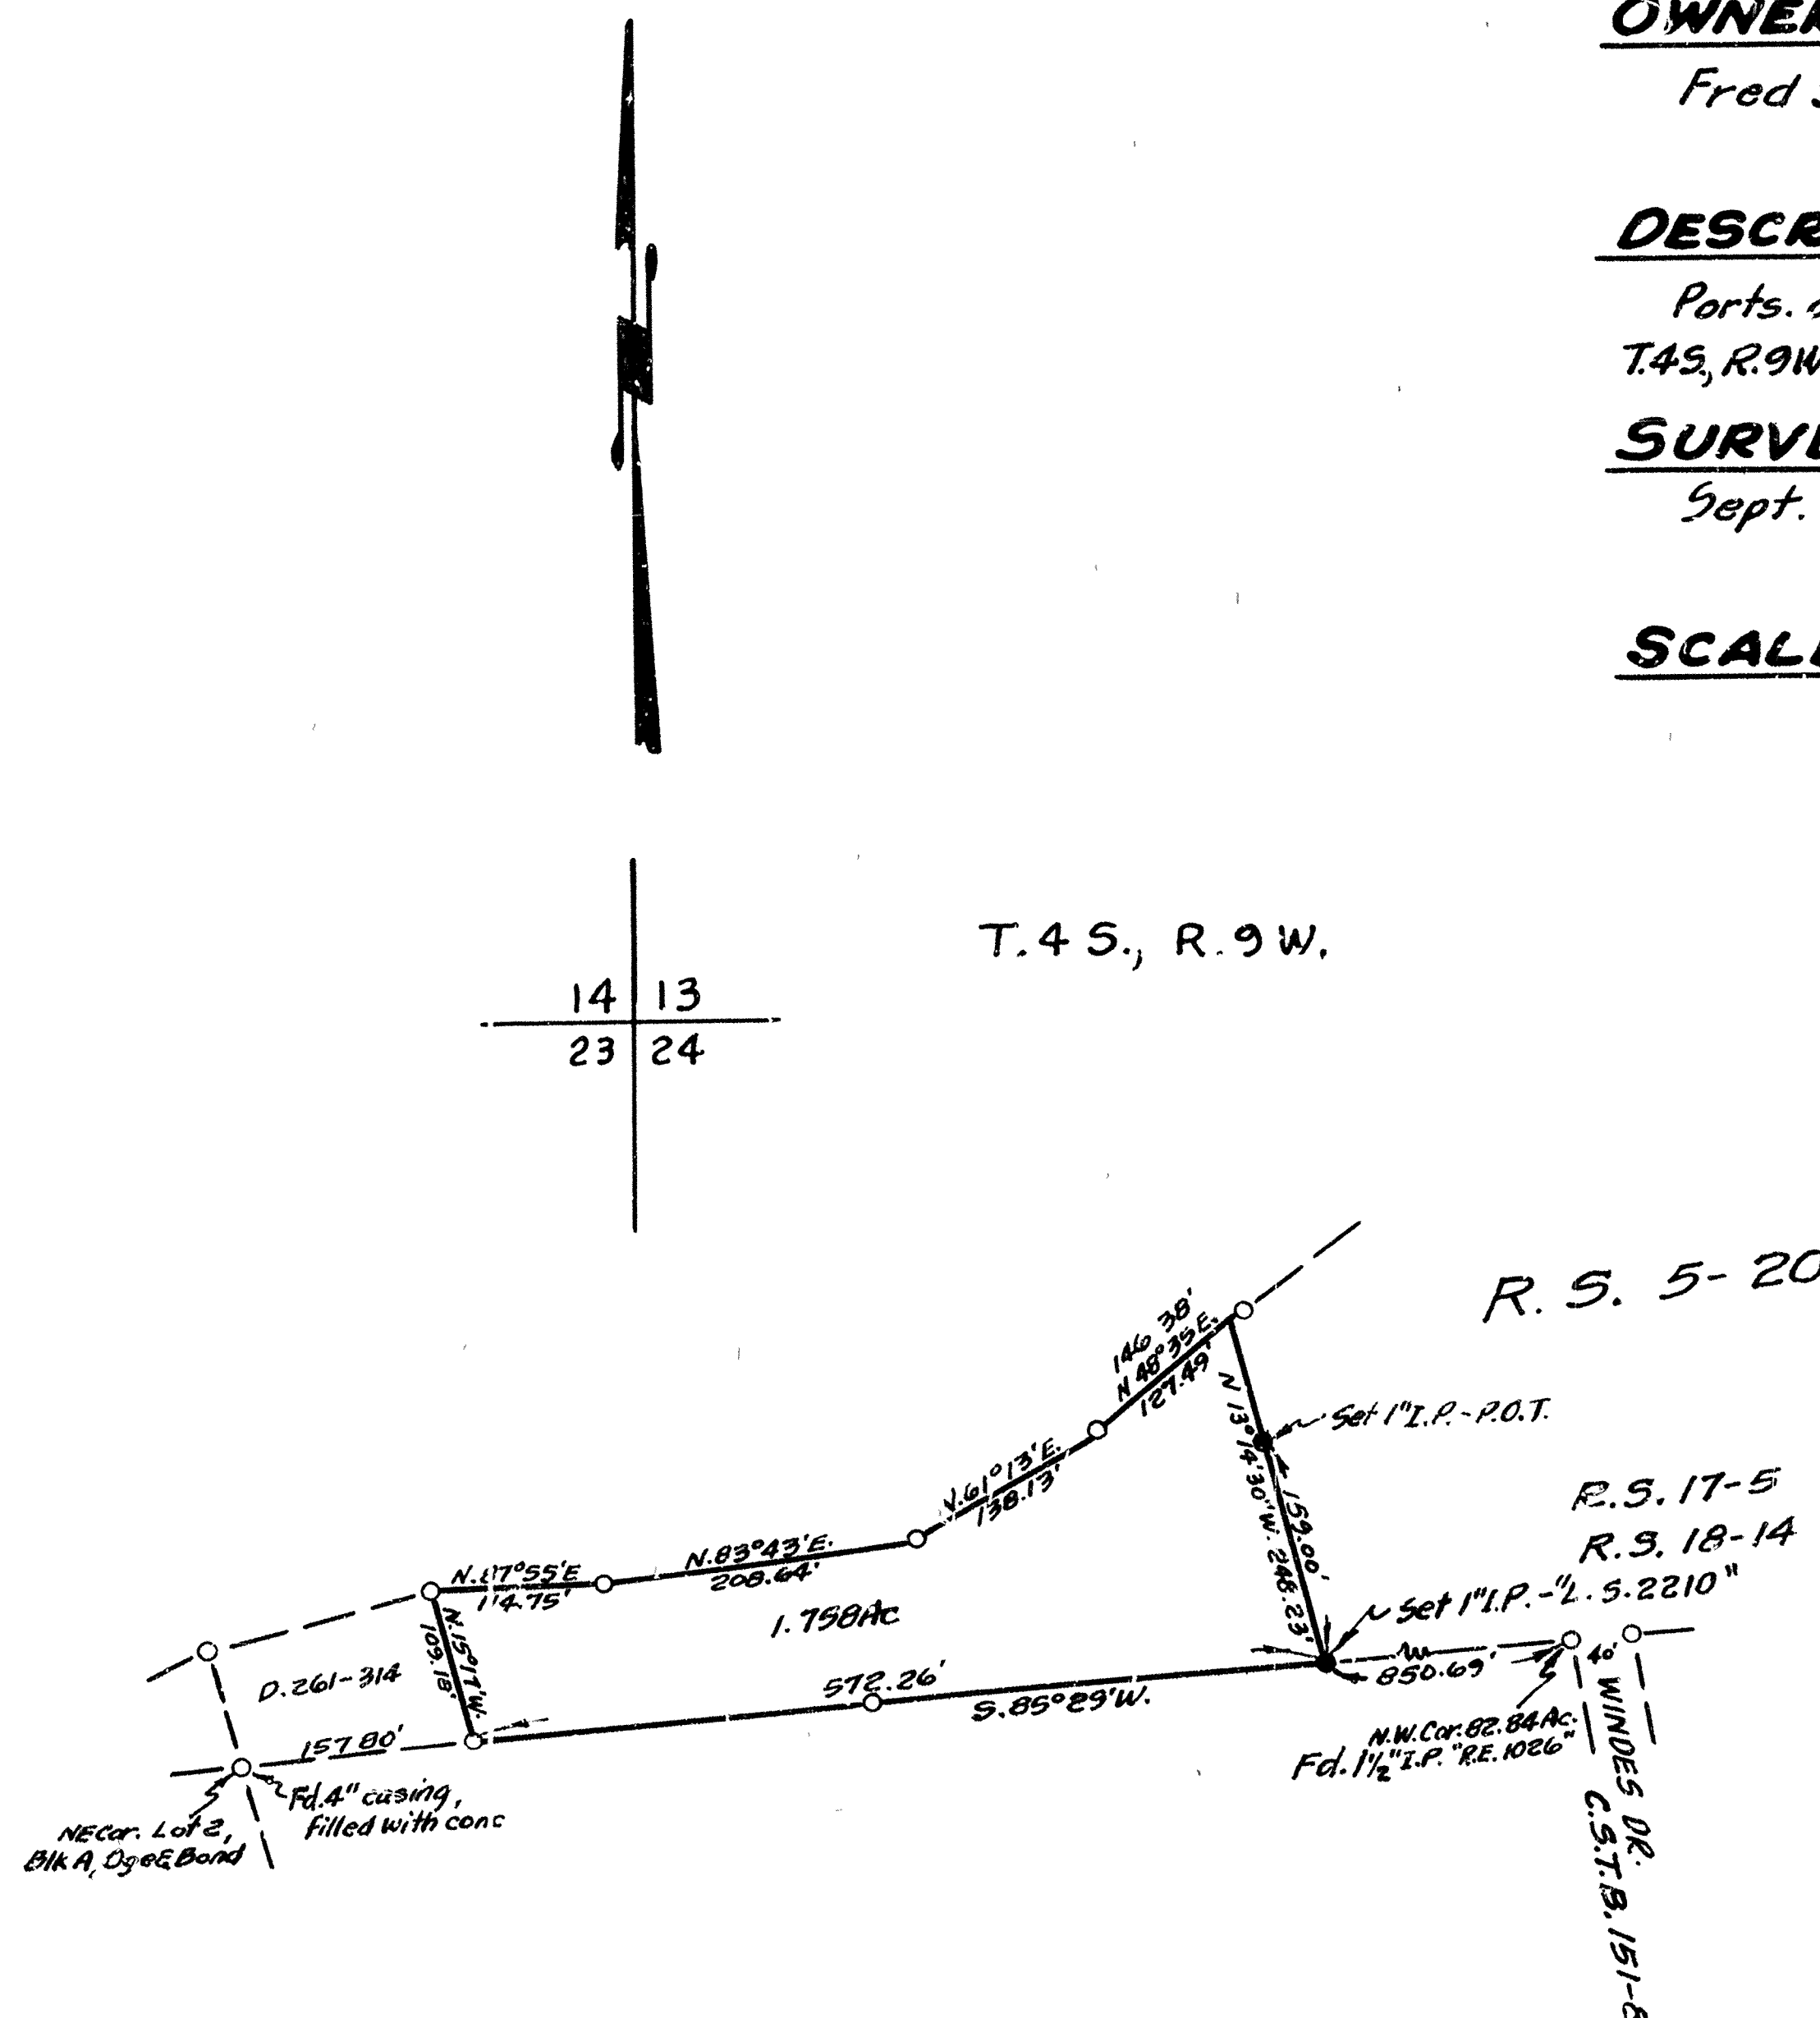

NOTES:
Bearings are based on 3/4 line
(S. 85° 29' W.) as per R.S. 5-20.

Examined and approved this
28th day of November ---

J. E. Lloyd
Deputy County Surveyor

I, D. D. Hillyard, certify: That I am a
Licensed Surveyor in the State of California,
No. 2210; that this map consisting of one sheet,
represents surveys made under my supervision at the request
of the Owners; and that all monuments shown
actually existed at the time of the survey and
their position is correctly shown.

D. D. Hillyard
Licensed Surveyor