

INDEXED
9317

JUL 13 1965

FUND FOR RECORD THE DAY OF
 AT 8:50 A.M. IN BOOK 81 P. 240
 OF RECORDS OF SURVEYS COUNTY OF ORANGE
 CALIFORNIA
 AT REQUEST OF COUNTY SURVEYOR
 \$5.00 J. WYLLIE CARTER, County Recorder

IN UNINCORPORATED TERRITORY OF ORANGE COUNTY, CALIFORNIA,
OF A PORTION OF LOT 84, TRACT NO 918, AS SHOWN ON A MAP RECORDED IN
BOOK 28, PAGES 41, 42 AND 43 OF MISCELLANEOUS MAPS, RECORDS OF ORANGE
COUNTY, CALIFORNIA.

RAY MERCADO L.S. 2681


JUNE 1965

THIS MAP CORRECTLY REPRESENTS A SURVEY MADE BY ME OR
UNDER MY DIRECTION IN CONFORMANCE WITH THE REQUIREMENTS
OF THE LAND SURVEYORS ACT AT THE REQUEST OF ROBERT L. BEEM
IN JUNE 1965.

THIS MAP HAS BEEN EXAMINED FOR CONFORMANCE WITH THE
REQUIREMENTS OF THE LAND SURVEYORS ACT THIS 12th DAY
OF July 1965.

Robert V. Wise
DEPUTY COUNTY SURVEYOR

RAY MERCADO L.S. 2681.

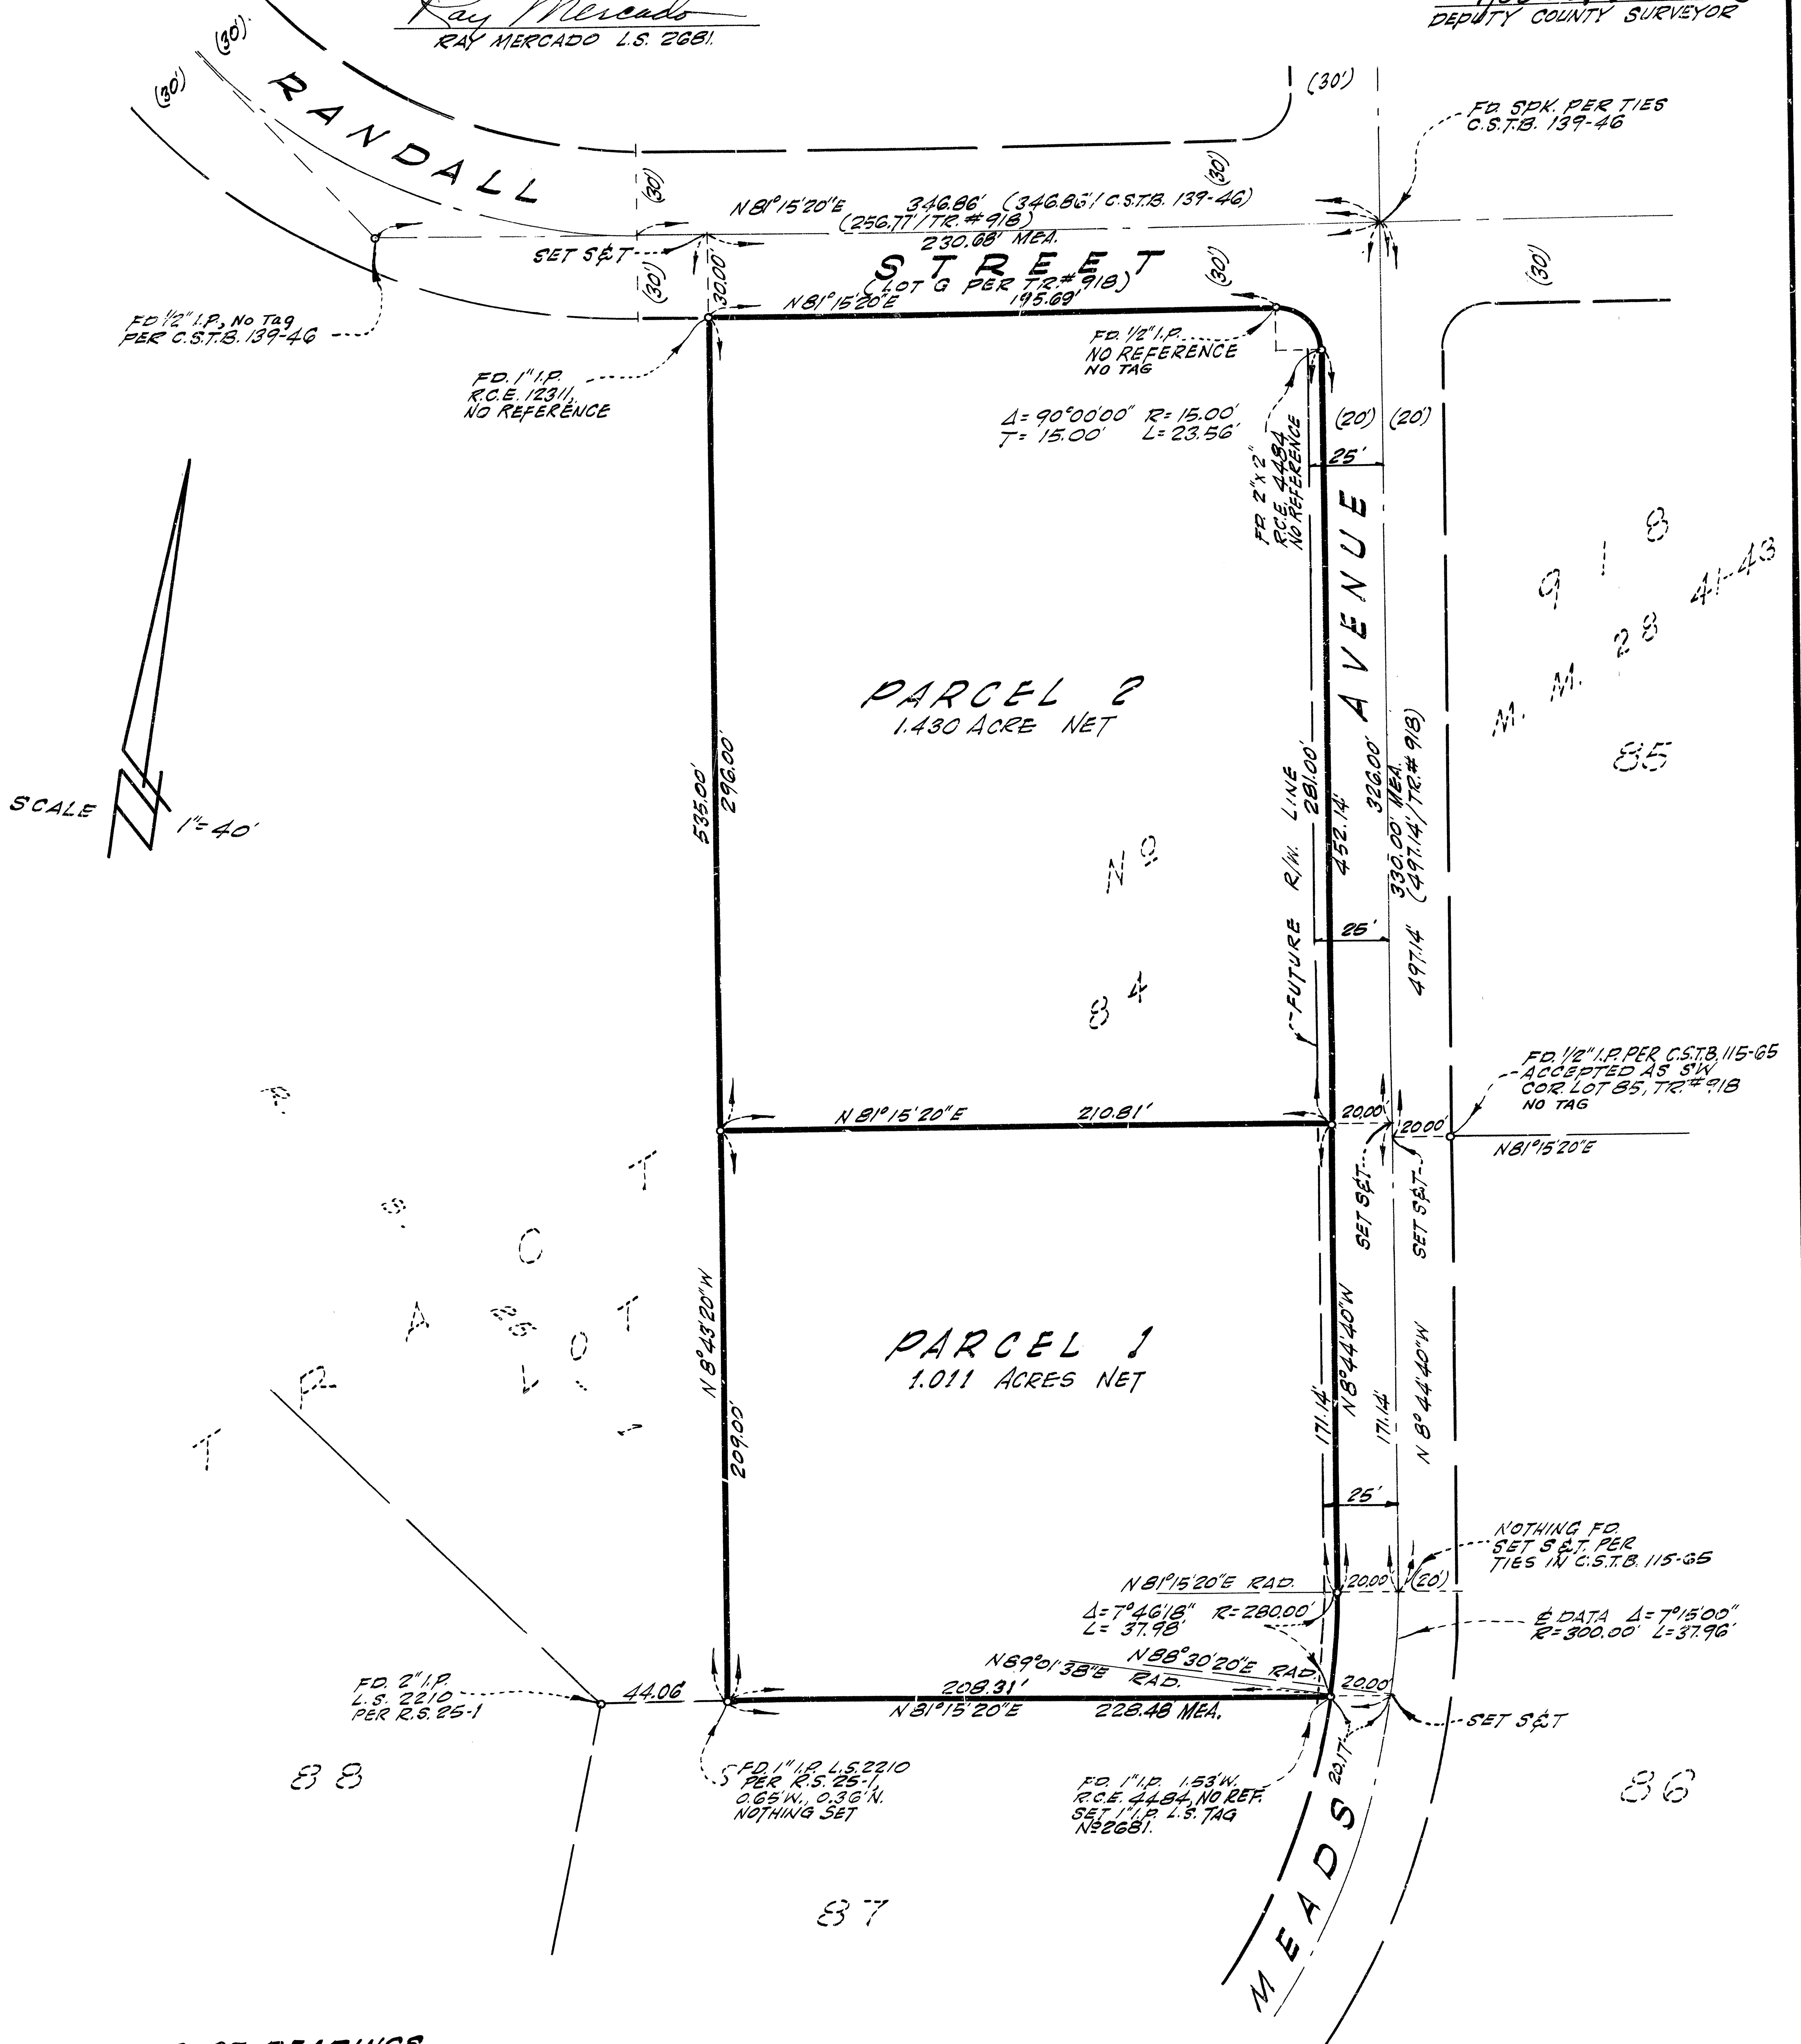

BASIS OF BEARINGS
BEARINGS ARE BASED ON THE CENTERLINE OF RANDALL STREET (LOT G).
S 81°15'20"W PER TRACT N2 918, N1/4 28, 41-43, RECORDS OF ORANGE
COUNTY, CALIFORNIA.

MONUMENT NOTE
SET 1" IRON PIPE BEARING TAG L.S. 2681 AT ALL POINTS SHOWN; UNLESS OTHERWISE NOTED.

FLD. BK. T-7, 53 S-1458