

SHEET 1 OF 1 SHEET

DATE OF SURVEY:  
MAY 31, 1994

<u>BLOCK</u>	<u>MODULE</u>
5450	45

RECORD OF SURVEY  
NO. 94-1004

IN THE UNINCORPORATED TERRITORY OF THE COUNTY OF ORANGE,  
STATE OF CALIFORNIA

BEING A SURVEY OF A PORTION OF LOT 152 IN BLOCK 51 OF IRVINE'S SUBDIVISION, AS SHOWN ON A MAP RECORDED IN BOOK 1 AT PAGE 88 OF MISCELLANEOUS MAPS IN THE OFFICE OF THE COUNTY RECORDER OF ORANGE COUNTY, CALIFORNIA.

PAUL A. CUOMO                      P.L.S. 4136

ACCEPTED AND FILED AT THE  
REQUEST OF

**ORANGE COUNTY SURVEYOR**

DATE NOVEMBER 30, 1995

TIME 10:11 A.M. FEE \$ 8.00

INSTRUMENT # 95-0528692 R/S

BOOK 153 PAGE 32

GARY L. GRANVILLE


COUNTY CLERK - RECORDER

BY Phyllis Johnson  
DEPUTY

SURVEYOR'S STATEMENT:

THIS MAP CORRECTLY REPRESENTS A SURVEY MADE BY ME OR UNDER MY DIRECTION IN CONFORMANCE WITH THE REQUIREMENTS OF THE LAND SURVEYOR'S ACT AT THE REQUEST OF SHARRON S. STANUL IN MAY, 1994.

*Paul A Cuomo*  
PAUL ANTHONY CUOMO P.L.S. 4136  
MY LICENSE EXPIRES 06/30/96

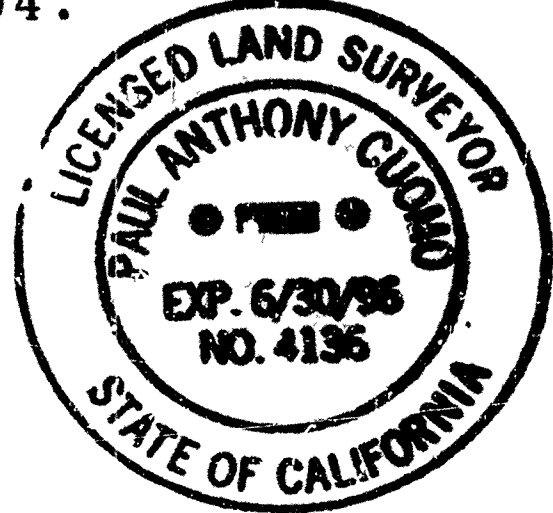

COUNTY SURVEYOR'S STATEMENT:

THIS MAP HAS BEEN EXAMINED IN ACCORDANCE WITH SECTION 8766 OF THE LAND SURVEYOR'S ACT THIS 14<sup>th</sup> DAY OF NOVEMBER, 1994.

John Canas  
JOHN CANAS, COUNTY SURVEYOR



STATEMENT OF PURPOSE:

THE PURPOSE OF THIS SURVEY IS TO ESTABLISH AND MONUMENT THAT PORTION OF LAND DESCRIBED IN THE GRANT DEED RECORDED MAY 6, 1993 AS DOCUMENT NO. 93-0304577 IN THE OFFICE OF THE COUNTY RECORDER OF SAID COUNTY.

### BASIS OF BEARINGS:

THE BEARING OF NORTH 50°11'45" WEST FOR THE CENTERLINE OF MESA DRIVE PER THE MAP FILED IN BOOK 21 OF PARCEL MAPS AT PAGE 8, IN THE OFFICE OF THE COUNTY RECORDER OF ORANGE COUNTY, CALIFORNIA, WAS USED AS THE BASIS OF BEARINGS FOR THIS SURVEY.

