

See page 6

£ SURVEY

BOUNDED BY

PALISADE ROAD - "ON THE NORTH"
MESA DRIVE - "ON THE SOUTH"
SANTA ANA AVE. - "ON THE WEST"
CYPRESS ST. - "ON THE EAST"

ORANGE COUNTY SURVEYORS NO. 6374

Date of Start: 11 July 60

Equipment

1) Transit: Wild T-1 #52223

2) Tape : C-2

a) * Calibration Temp.: 59°

*(25 lbs. tension = 100.00')

Field Party

Chief of Party : W. Rayburn

Tape : A. Payne

" : R. Winterburn

Notes : G. Colvert

Refs:

1) T.B. 133-41, 48, 49, 50, 51, 52, 53, 54
147-56, 59

2) Tie Sheets - S.W. IRV.
County Survey #6284

Date of Completion: 20 July 60


OFFICE DATA

Eng. Order No

ORANGE COUNTY SURVEYOR

ADVISED BY Rayburn & Pty. DATE

SM 3/88

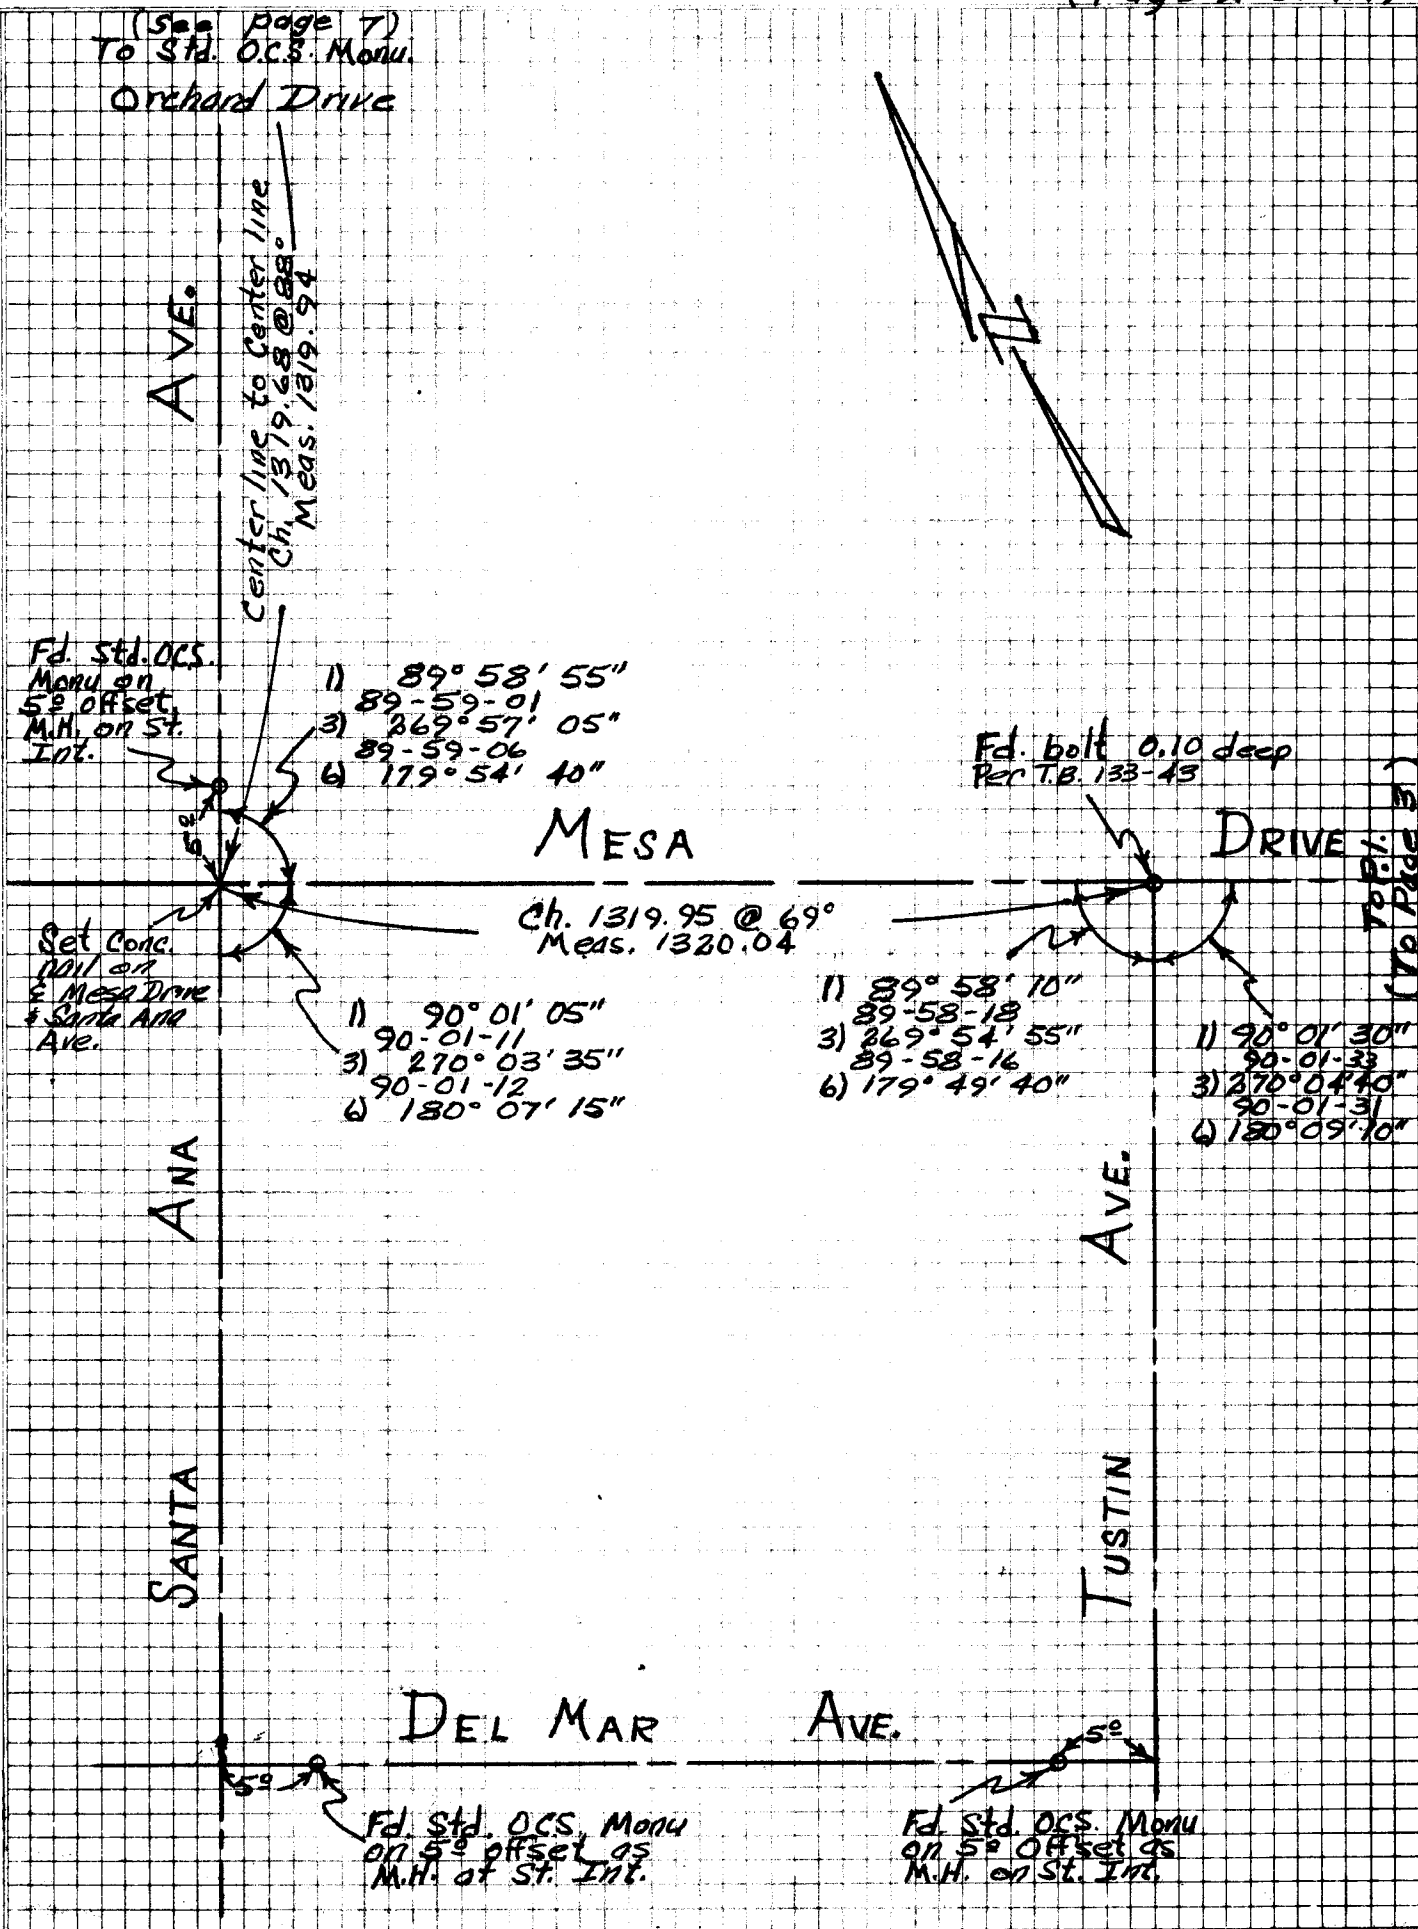

(Page 3 of 14)

ORANGE COUNTY SURVEYOR

REVISED BY Rayburn & Pty. DATE

SM 3/58

TO TUSTIN AVE
(see page 2)

MESA

Ch. 682.59 @ 69°
Meas. 682.63

- 1) 166° 22' 00"
- 2) 166° 22' 03"
- 3) 139° 06' 03"
- 4) 166° 22' 02"
- 5) 278° 12' 15"

DRIVE

Ch. 316.94 @ 69°
Meas. 316.96


P.I.
Fd. Spike
3-2' net ties

- 1) 174° 14' 00"
- 2) 174° 14' 00"
- 3) 162° 42' 00"
- 4) 174° 13' 58"
- 5) 325° 23' 50"

Northwest Line of Tract

P.I.
Set bolt on
surface with
4-2' net & ties


TO ACACIA ST

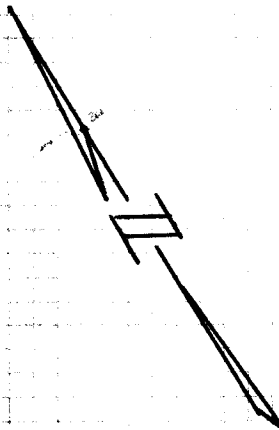

ORANGE COUNTY SURVEYOR

REVEYED BY Bayburn & Pty. DATE _____


5M 3/58

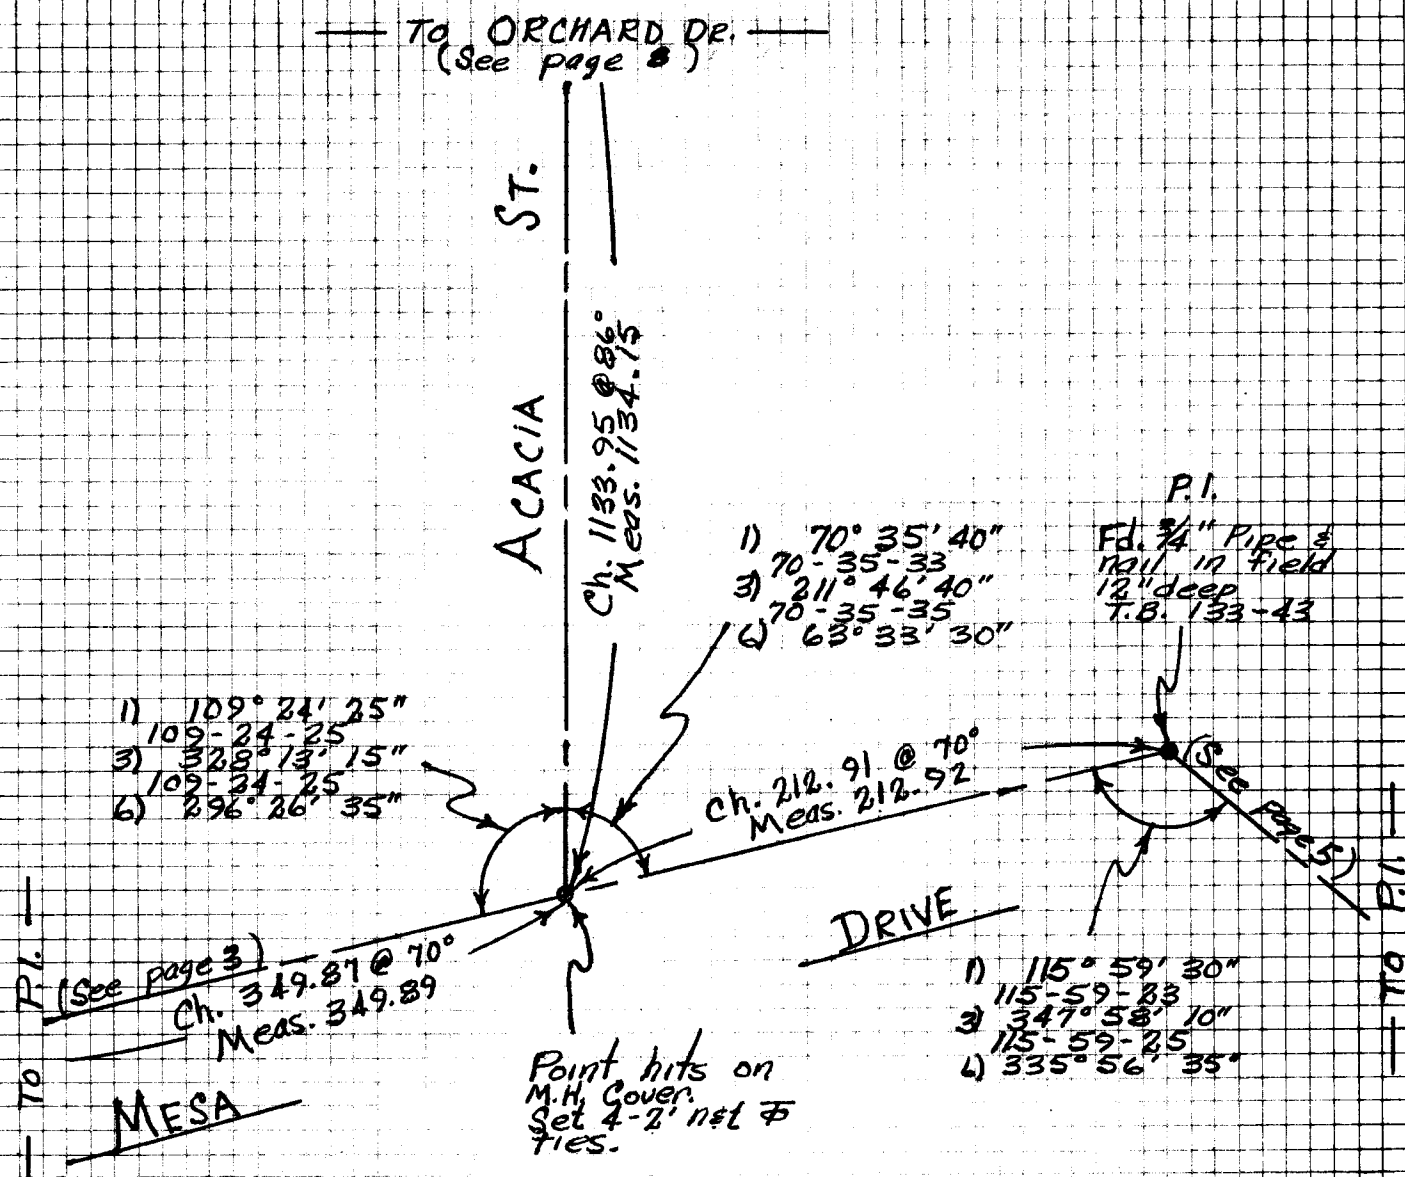

ORANGE COUNTY SURVEYOR

PREPARED BY Rayburn & Pity DATE


5M 3/58

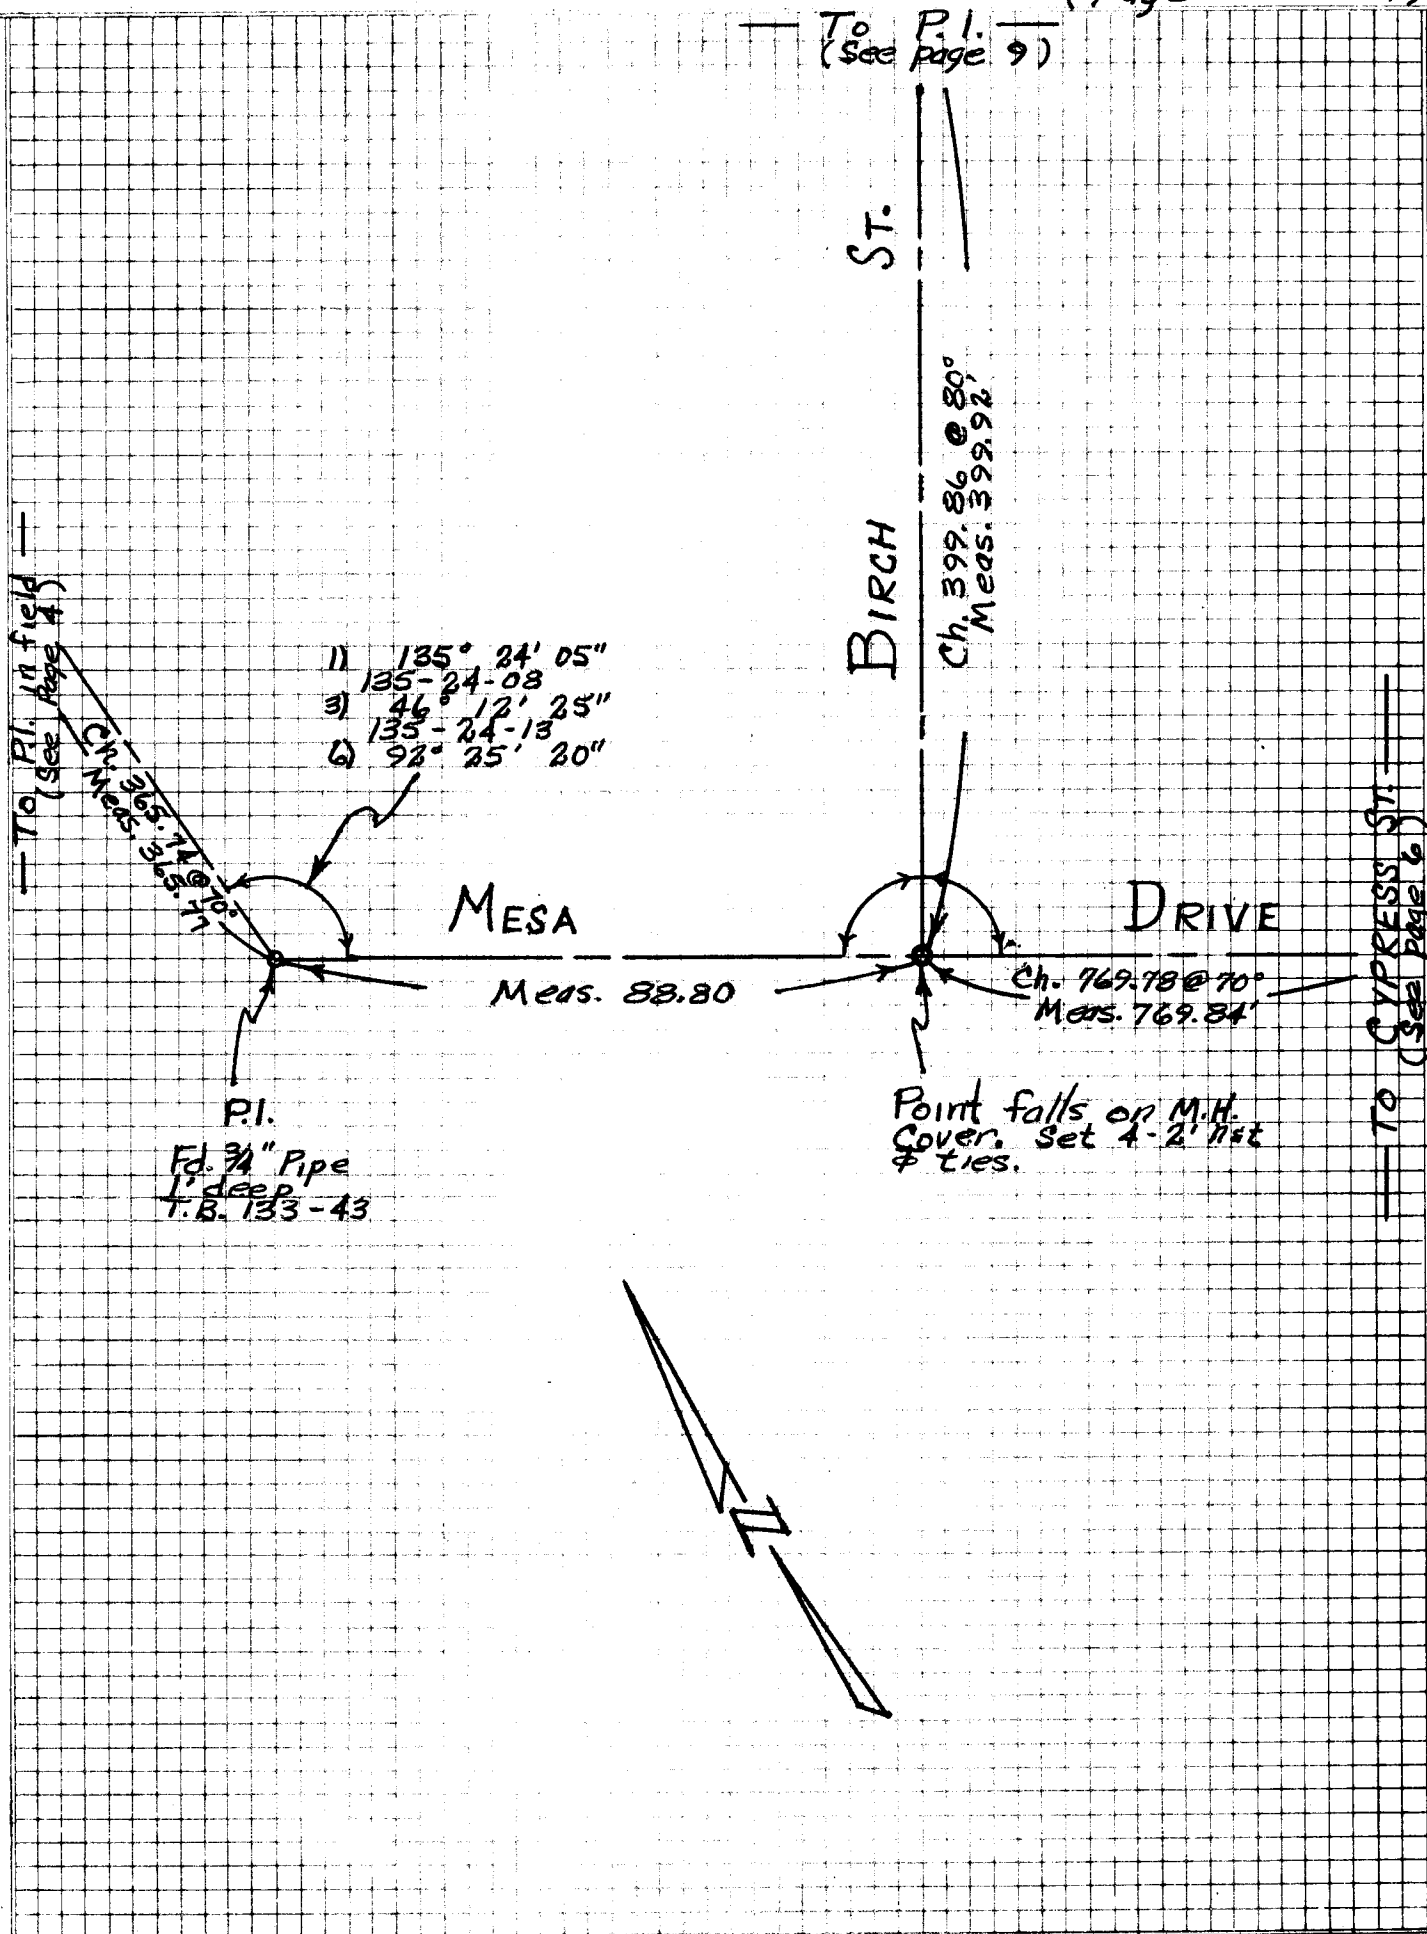

ORANGE COUNTY SURVEYOR

Surveyed by Rayburn & Pty. DATE


SM 3/58

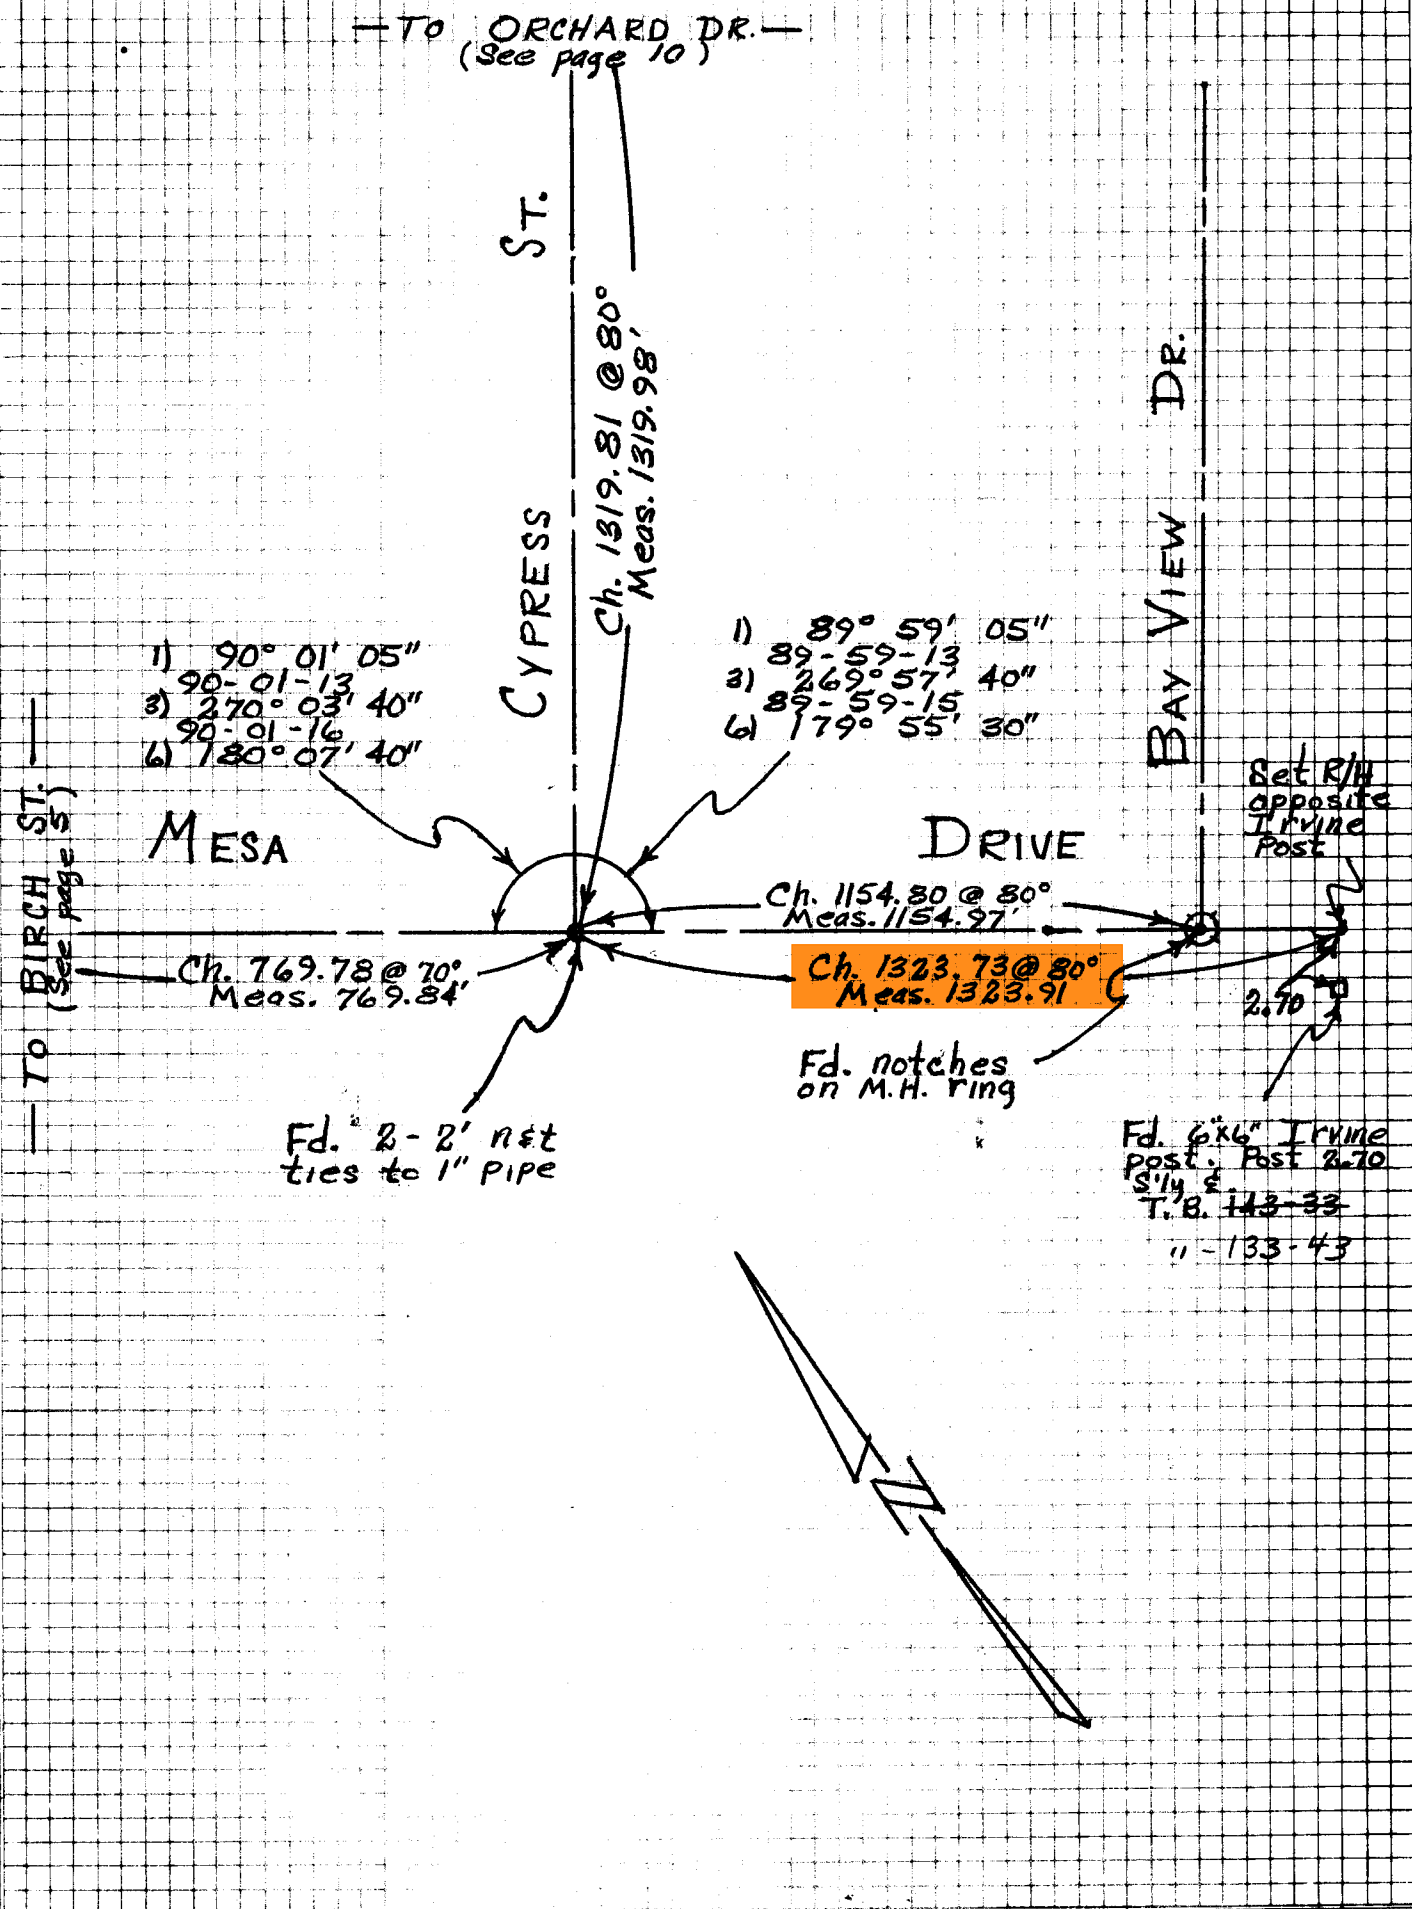

ORANGE COUNTY SURVEYOR

REVISED BY Rayburn & Pity, DATE


SM 3/58

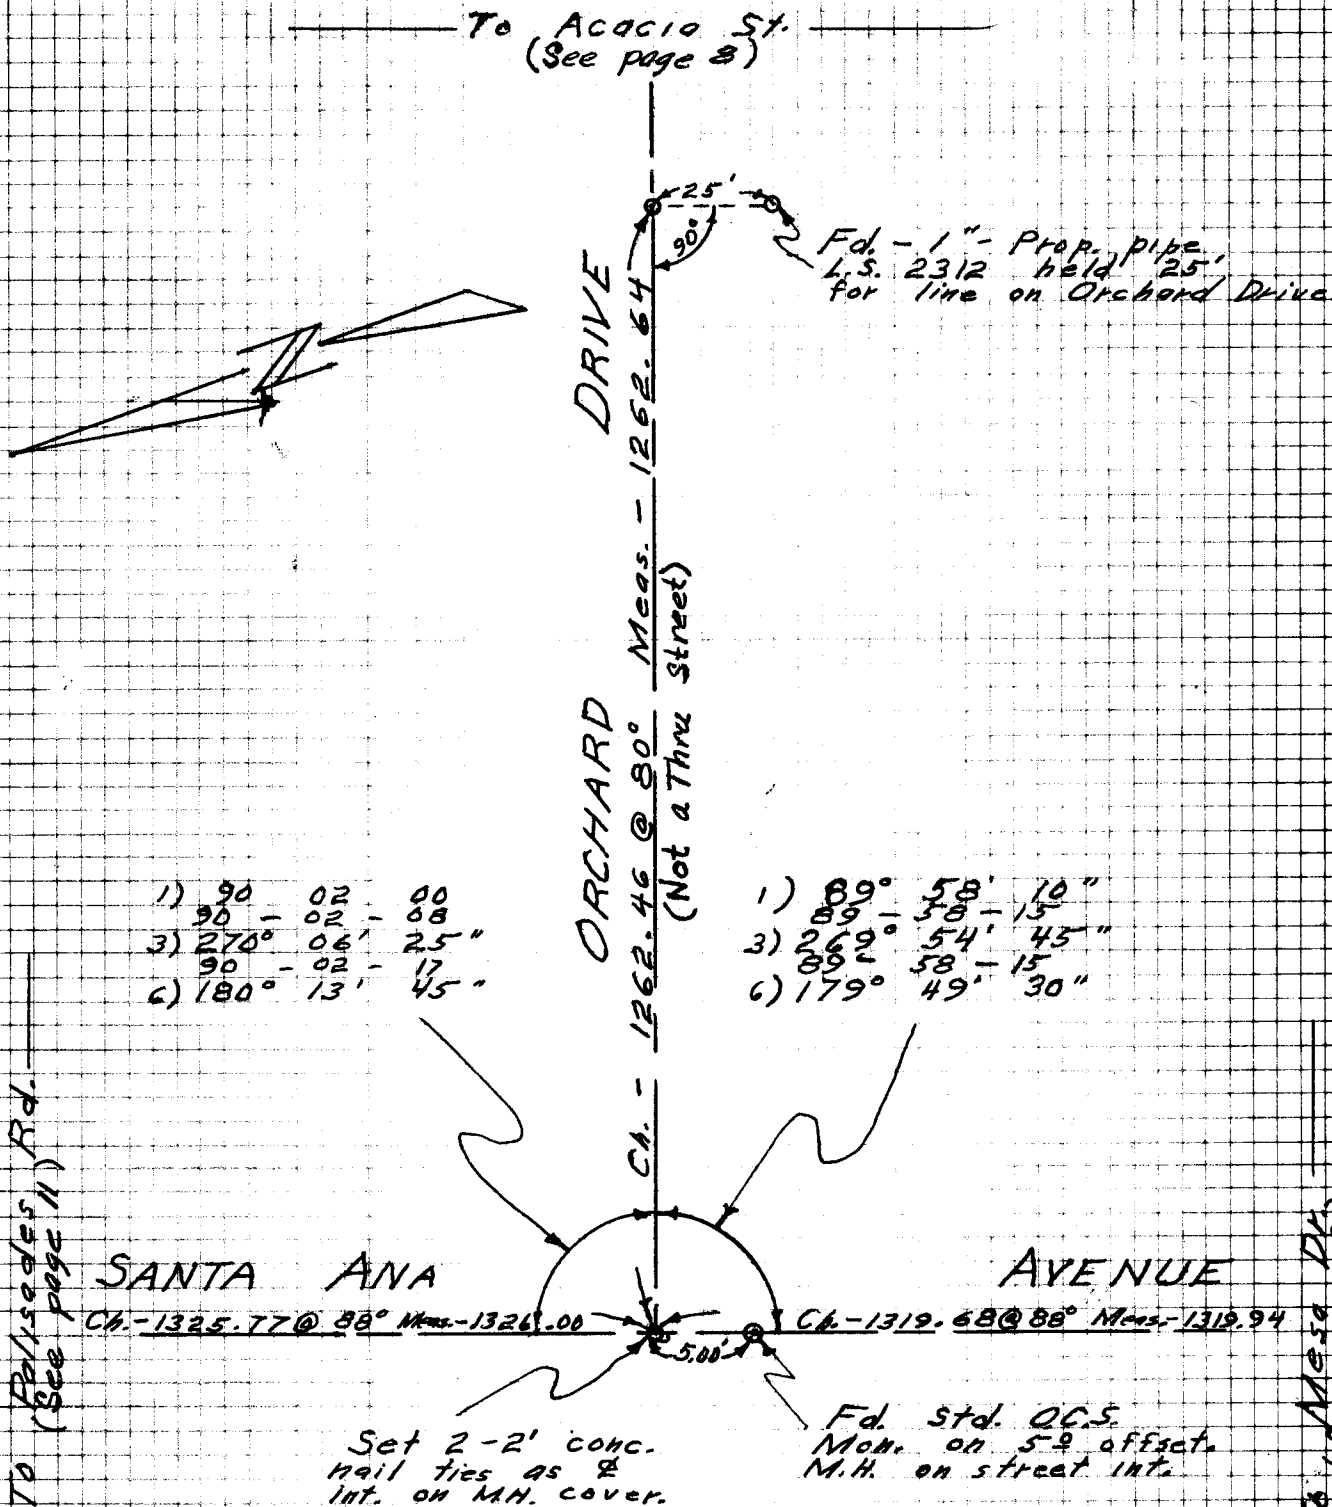

ORANGE COUNTY SURVEYOR

VIEWED BY Rayburn & Day DATE

5M 3/58

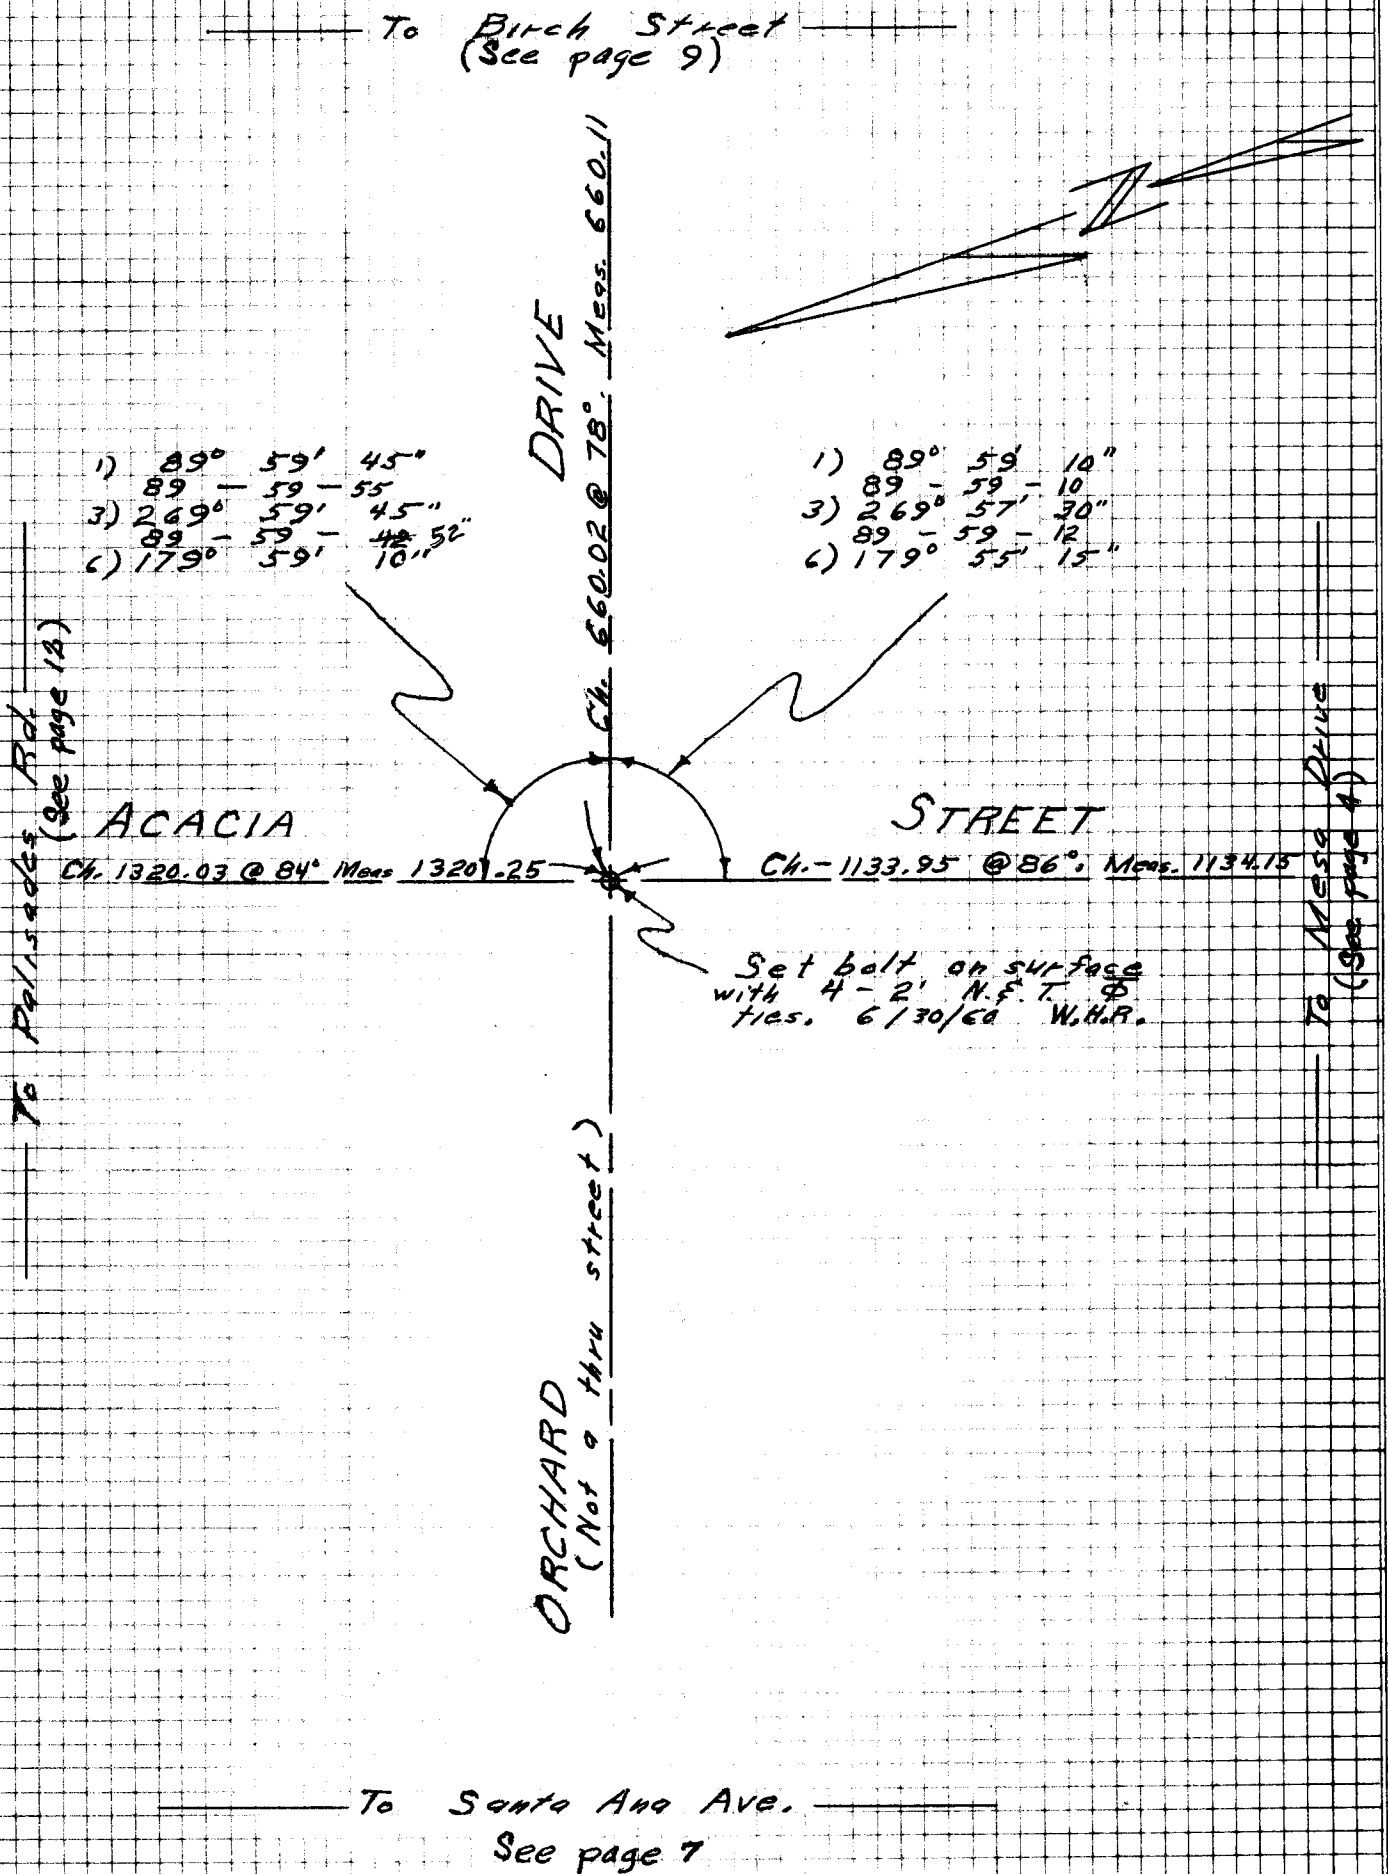

— To Palisades Rd. —
(See page 13)

— TO ACACIA ST. —
(see page 8)

— TO CYPRESS ST. —
(see page 10)

ORCHARD

DRIVE

- 1) 89° 59' 40"
- 2) 89-59-46
- 3) 269° 59' 20"
- 4) 89-59-45
- 6) 179° 58' 35"

- 1) 90° 00' 10"
- 3) 90-00-10
- 3) 270° 00' 30"
- 6) 90-00-10
- 6) 180° 01' 00"

- 1) 90° 00' 15"
- 3) 90-00-10
- 3) 270° 00' 30"
- 6) 90-00-13
- 6) 180° 01' 20"

- 1) 89° 59' 45"
- 3) 89-59-45
- 3) 269° 59' 15"
- 6) 89-59-46
- 6) 179° 58' 40"

Set 4-2' net ties as point hits on M.H. cover

- 1) 157° 04' 00"
- 3) 157-04-10
- 3) 111° 12' 30"
- 6) 157-04-08
- 6) 222° 24' 50"

P.I.
Set punched bolt on surface with 4-2' net & ties.
By ties - S.W. IRV.
Page 21 - Tie Sheet

Ch. 282.43 @ 74°
Meas. 282.46

P.I.

Set punched bolt on surface with 4-2' net & ties.
This point set by Int. - 90° off of Mesa Drive & Meas. Rec. angle from P.I. - N.E. to complete Int. - Ties all torn out as per S.W. - IRV. page 20 tie sheet to this point.

- 1) 157° 04' 00"
- 3) 157-03-55
- 3) 111° 11' 45"
- 6) 157-03-50
- 6) 222° 23' 00"

Ch. 399.86 @ 80°
Meas. 399.92

BIRCH

— To Mesa Dr. —
(See page 5)

ORANGE COUNTY SURVEYOR

5M 3/58
SURVEYED BY *Rayburn & Pty.* DATE

— To Palisades Bld. —
(See page 14)

- 1) 90° 01' 10"
- 2) 90° 01' 05"
- 3) 270° 03' 30"
- 4) 90° 01' 06"
- 5) 180° 06' 40"

ORCHARD DRIVE
Ch. - 660.02 @ 78° Meas. - 660.11

(See page 9)
— To Birch St. —

— To Orchid St. —

Set 4 - 2' N.E.T.
ties. Point falls on
M.H. cover.

CYPRESS

Ch. 1319.91 @ 80° Meas. - 1320.08

STREET

Ch. 1319.81 @ 80° Meas. - 1319.98

- 1) 89° 59' 00"
- 2) 89° 59' 08"
- 3) 269° 57' 25"
- 4) 89° 59' 11"
- 5) 179° 55' 10"

— To Mesa Drive —
(See page 6)

ORANGE COUNTY SURVEYOR

SRVEYED BY *Rayburn & Pky.* DATE

SM 3/58

To *Acacia St.*
(See page 12)

PALISADES ROAD
CH - 2640.45 @ 04° Meas. - 2640.88

- 1) 89° 59' 25"
- 2) 89° 59' 26"
- 3) 269° 58' 10"
- 4) 89° 59' 23"
- 5) 179° 56' 20"


SANTA ANA AVE.

CH - 1325.77 @ 88° Meas. - 1326.00

Ed. O.C.S. (Std.)
monu. - 10'
sly of white
line

*Ed. bolt on surface
as per T.D. 135-44.
Flas checked.*

To *Orchard Drive*
(See page 7)

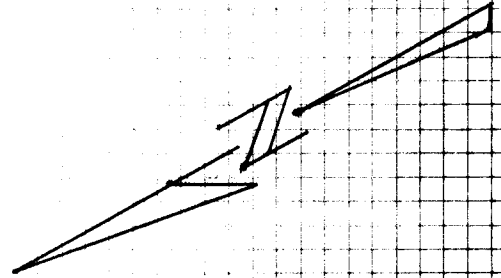

ORANGE COUNTY SURVEYOR

REVISED BY Rayburn F. Pity DATE

SM 3/58

To ~~Acacia St.~~
Birch
(See page 13)

PALISADES ROAD

CH - 659.92 @ 84° Meas. - 660.04

Fd. bolt on
surf. 10' 5" ly
of white line on
Palisades Rd.
T.B. 133 - 52

CH - 2640.45 @ 84°
Meas. - 2640.88

ACACIA STREET


CH - 1320.03 @ 84° Meas. - 1320.25

- 1) 89° 59' 05"
- 3) 269° 59' 16"
- 6) 179° 55' 50"

- 1) 89° 59' 25"
- 3) 269° 59' 35"
- 6) 179° 57' 05"

To Santa Ana St.
(See page 11)

To Orchard Drive
(See page 8)

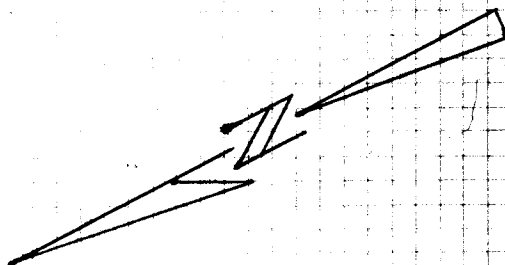


ORANGE COUNTY SURVEYOR

urveyed by Rayburn & Pty. DATE

SM 3/58

To Cypress St.
(See page 14)

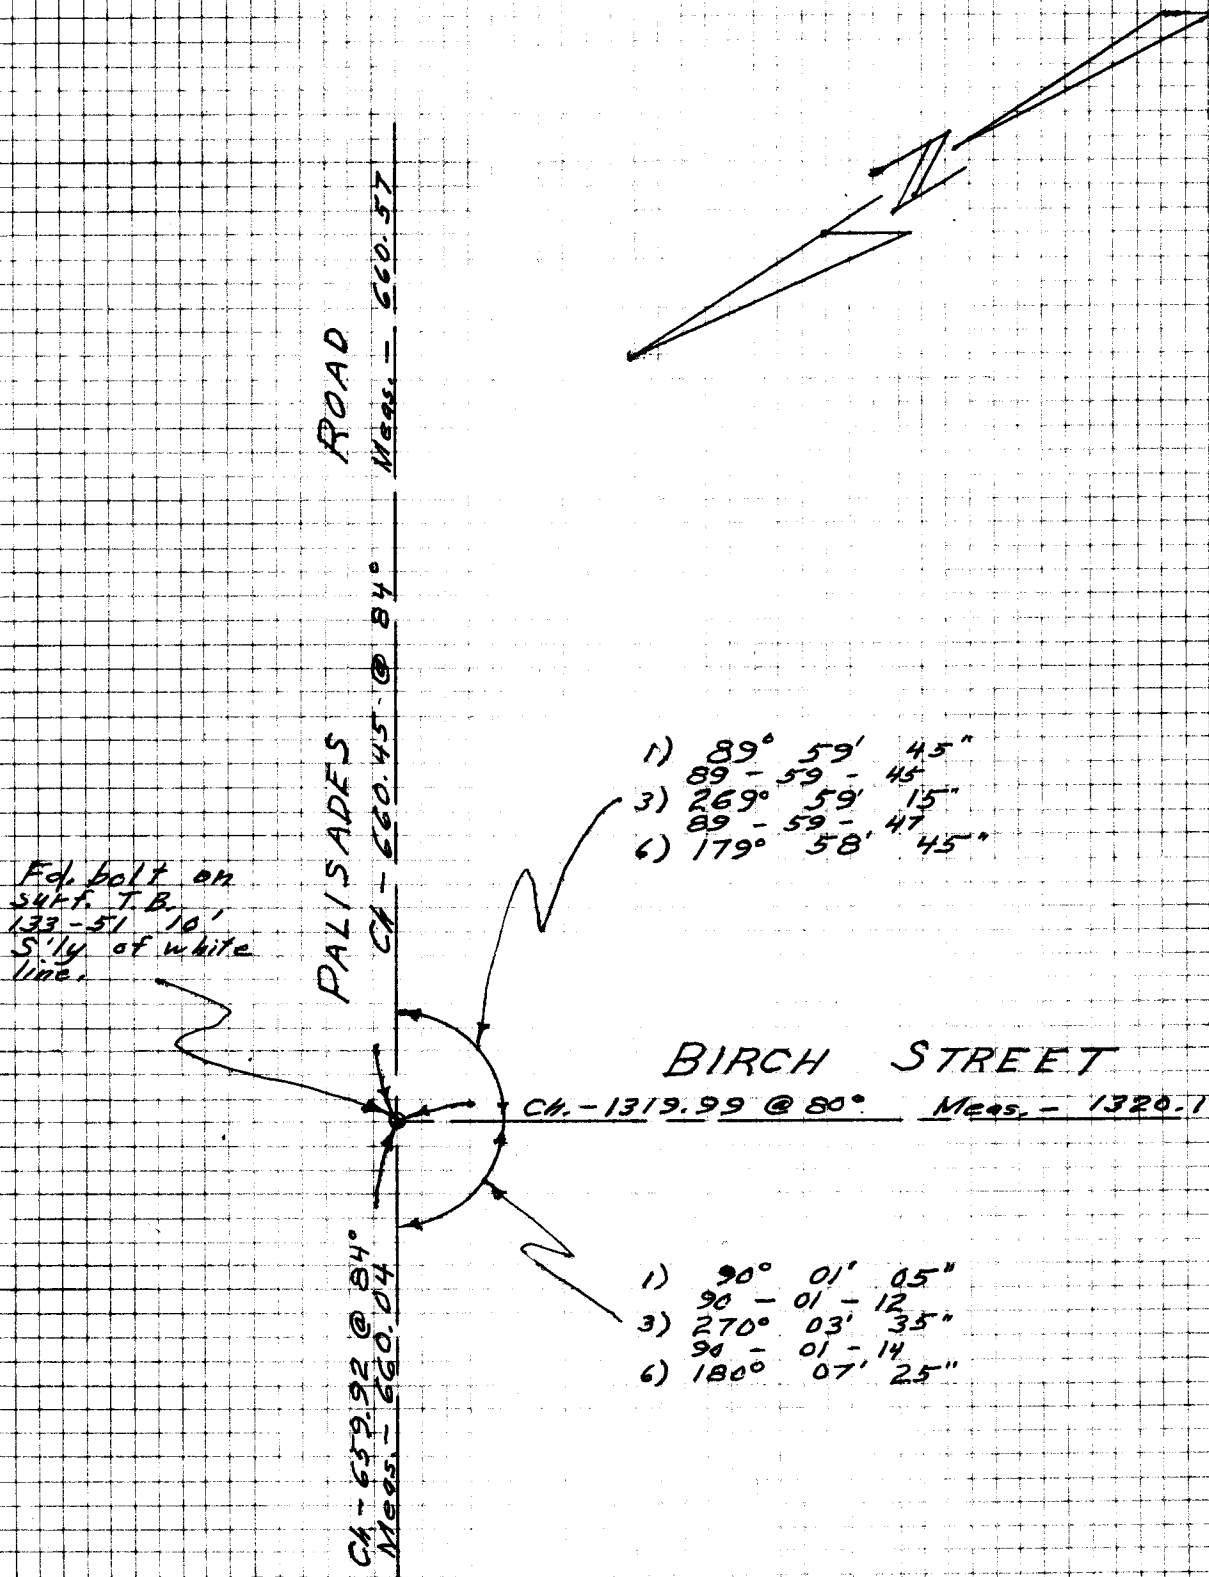

To Acacia St.
(See page 12)

ORANGE COUNTY SURVEYOR

REVISED BY Rayburn & Pity, DATE

SM 3/58

