

ORANGE COUNTY SURVEYOR SURVEY NOTES

A/NE-IRV 1983

ALIGNMENT INDEX BOOK AND PAGE

ALIGNMENT NOTES PG. 1 OF 7

PPB _____ WORK ORDER NUMBER R38001410

SURVEY NOTES PAGE _____ OF _____

SURVEY COMPLETION DATE 2-89

SURVEY FILE NUMBER R89-1

PROJECT NAME SKYLINE DR. EASEMENT

SURVEY LIMITS ALONG SKYLINE DR. R/W LIMITS FROM REDHILL N'LY TO BEVERLY GLEN.

PURPOSE OF SURVEY TO ESTABLISH AND MARK-OUT THE R/W.

THOMAS BROS.:

BLOCK AND MODULES:

PG 24-

BLK 5853-MOD 00,01,02

B-1, C-1

SURVEY NOTE PAGE INDEX:

EQUIPMENT:

PERSONNEL:

PG 1 OF 10 - TITLE PG

TOPCON ET-2 #A7A7A

DOYLE - P.C.

PG 2-5 OF 10 - CONTROL

TOPCON FC-1 DATA COLLECTOR

ENGELMANN - TK

PG 6-7 OF 10 - TIE NOTES

RUFFING - P

PG 8-9 OF 10 - PHOTOS


PG 10 OF 10 - DATA COLL. SET-UP SHEET

REFERENCES/REMARKS:


TOP OF WEDGE AREA FILED UNDER: SKYLINERWCRD-CO.RPT

THE TIES SHOWN HEREON ARE FOR THE PURPOSE OF PERPETUATING THE MONUMENTATION CURRENTLY EXISTING. NO ATTEMPT WAS MADE TO DETERMINE THE VALIDITY OF THE MONUMENTS OR THEIR PROPER LOCATION IN RELATION TO LEGAL BOUNDARY LINES IN THE AREA.

ORANGE COUNTY SURVEYOR

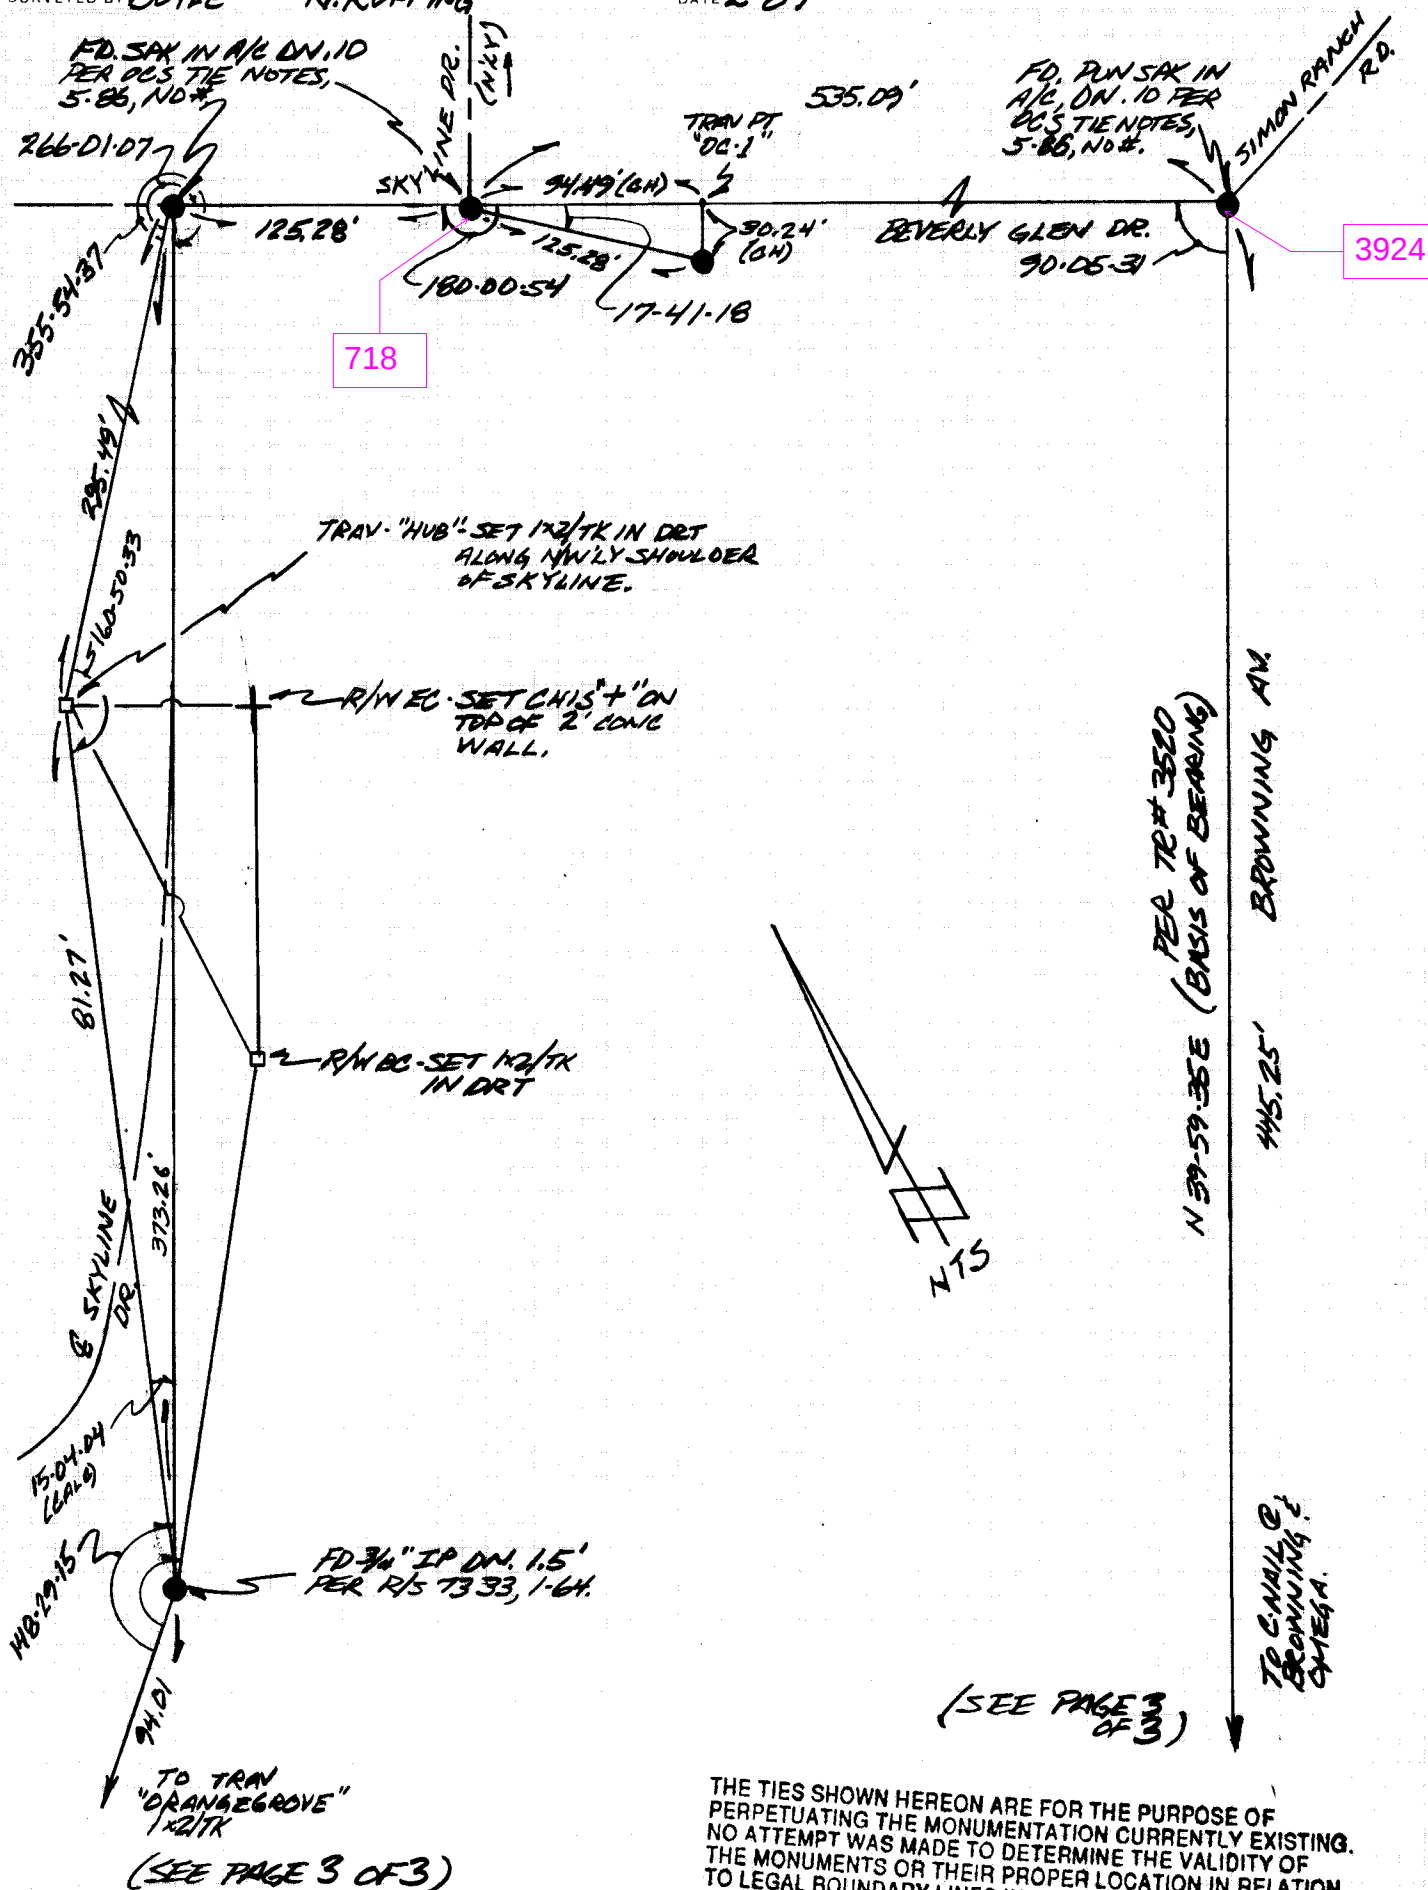

THE TIES SHOWN HEREON ARE FOR THE PURPOSE OF PERPETUATING THE MONUMENTATION CURRENTLY EXISTING. NO ATTEMPT WAS MADE TO DETERMINE THE VALIDITY OF THE MONUMENTS OR THEIR PROPER LOCATION IN RELATION TO LEGAL BOUNDARY LINES IN THE AREA.

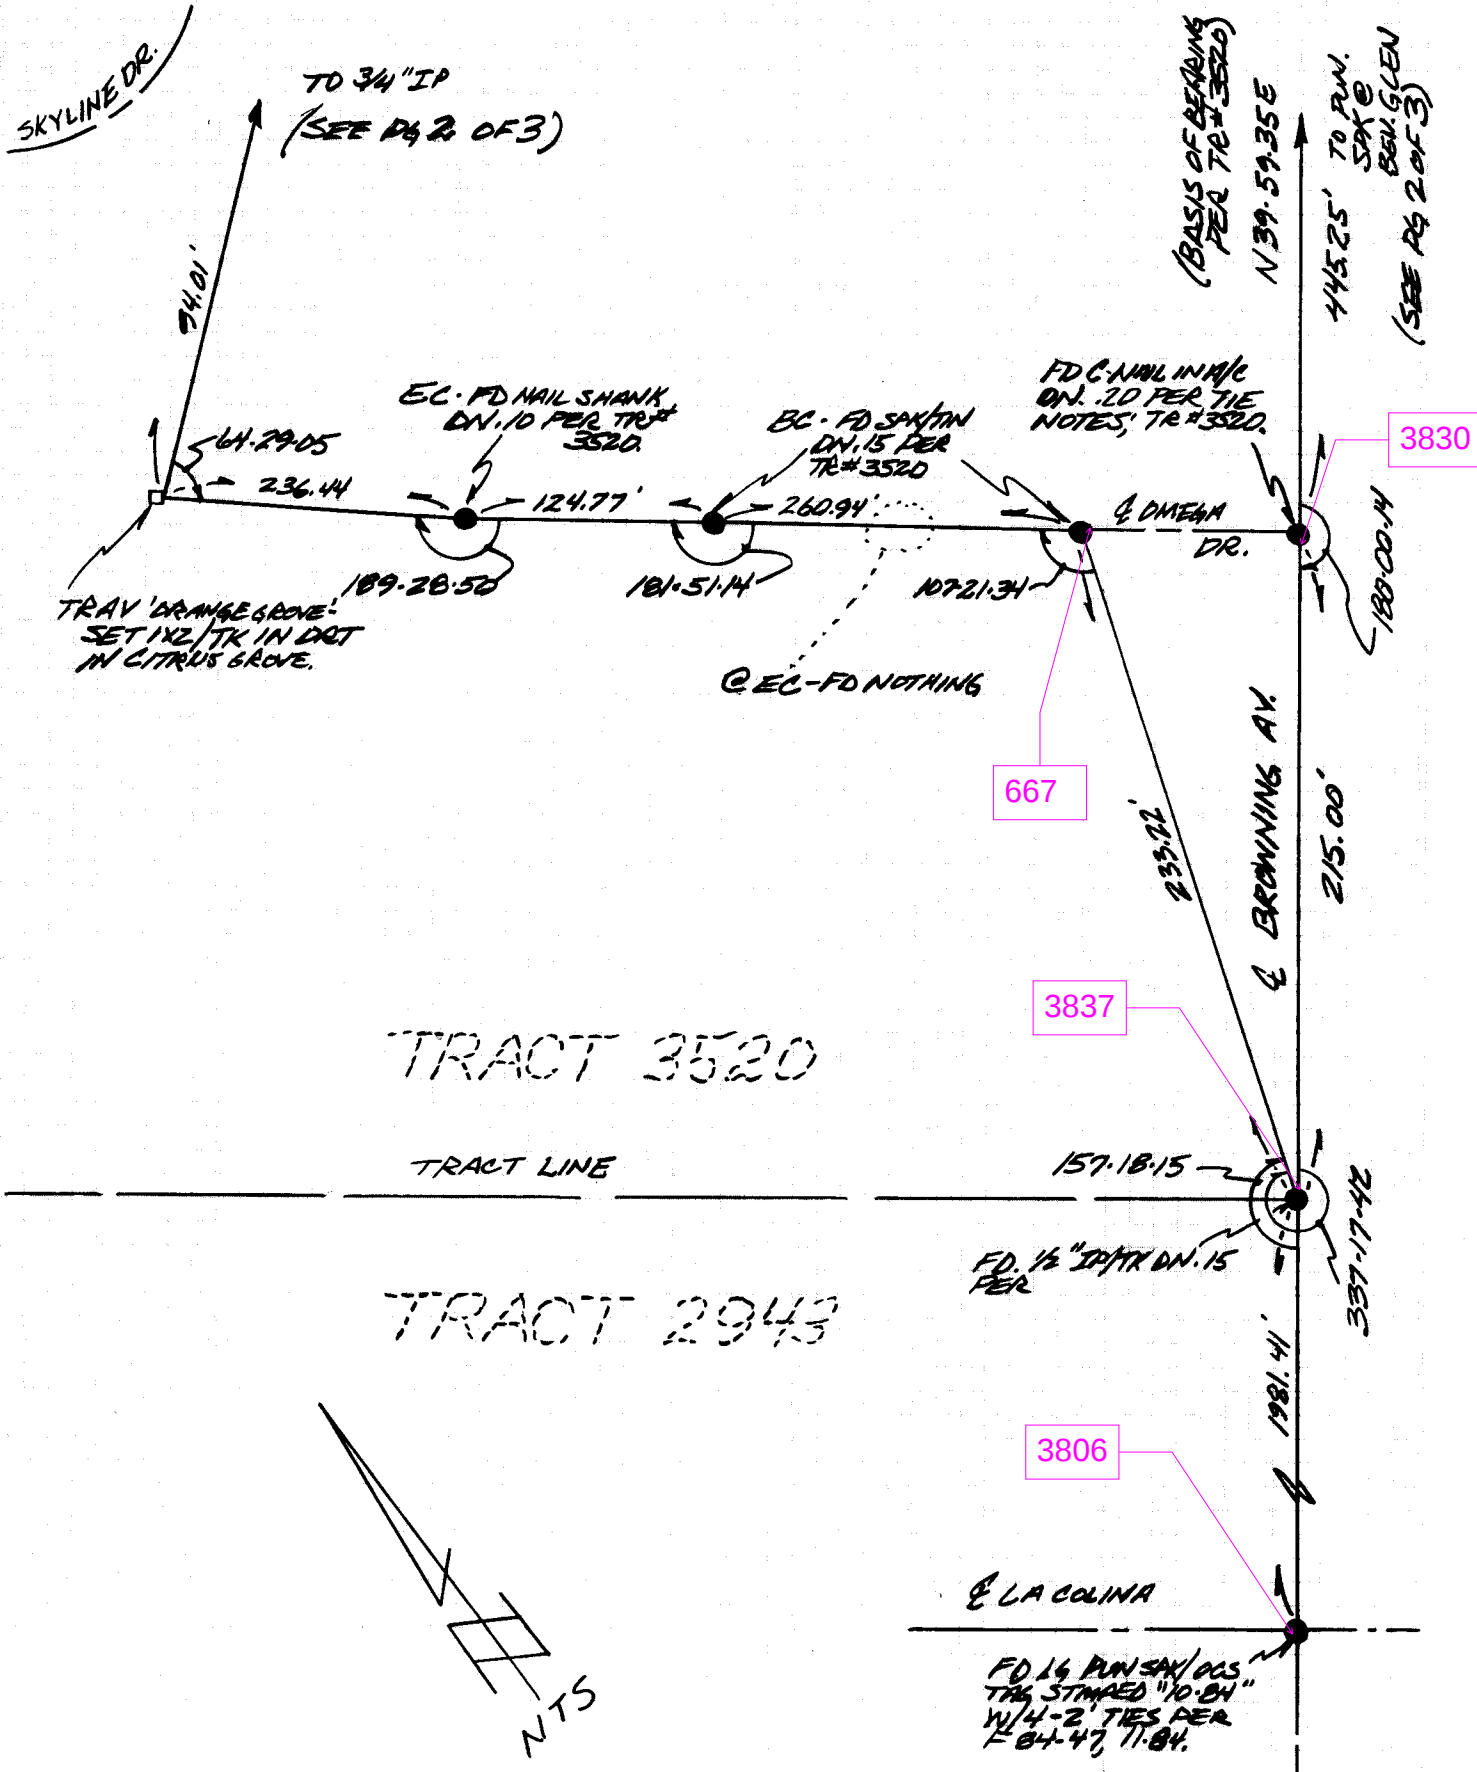

THE TIES SHOWN HEREON ARE FOR THE PURPOSE OF PERPETUATING THE MONUMENTATION CURRENTLY EXISTING. NO ATTEMPT WAS MADE TO DETERMINE THE VALIDITY OF THE MONUMENTS OR THEIR PROPER LOCATION IN RELATION TO LEGAL BOUNDARY LINES IN THE AREA.

SKYLINE DR R/W

A/NE-IRV

1986

4 of 7
4 of 10

DOYLE PTY

FEB. 21, -89

ORANGE COUNTY SURVEYOR

BLOCK 14 IRVINE'S SUBDIVISION M M 1-88

FD. SPK IN A/C DN. 0.10'
PER O.C.S TIE NOTES
S-86, NO #

BEVERLY GLEN DRIVE

TO
BROWNING
AVE.

[S 49-55-38 E

660.52

IDENTICAL

SKYLINE DRIVE
(N 40-00-43 E 295.22
(N 40-00-28 E, 295.00)

R/W

N 67-31-14 E, 0.31' CALC.

FD. NOTHING
SET NOTHING

(N 49-55-38 W 240.14) 240.14 CALC.

TO ANGLE
PT IN
TRACT

(RAD.) N 39-34-43 W

TR 3520

□ SET 1x2 & TK FLUSH
ON R/W

() - PER TR 3520

[] - PER R/S 71-29

(RAD.) 10-16-15 W

OMEGA DRIVE

TR 3520

TO &
BROWNING


(N 49-54-50 W, 600.73)

N 49-54-50 W, 600.73

THE TIES SHOWN HEREON ARE FOR THE PURPOSE OF
PERPETUATING THE MONUMENTATION CURRENTLY EXISTING.
NO ATTEMPT WAS MADE TO DETERMINE THE VALIDITY OF
THE MONUMENTS OR THEIR PROPER LOCATION IN RELATION
TO LEGAL BOUNDARY LINES IN THE AREA.

PORTION OF LOT 1118
BLOCK 15 - IRVINE'S SUBD.
M M 1-88 (N 40-00-43 E 365.10
(N 40-00-28 E 365.18)

BLOCK 14 IRVINE'S
SUBDIVISION MM F-88

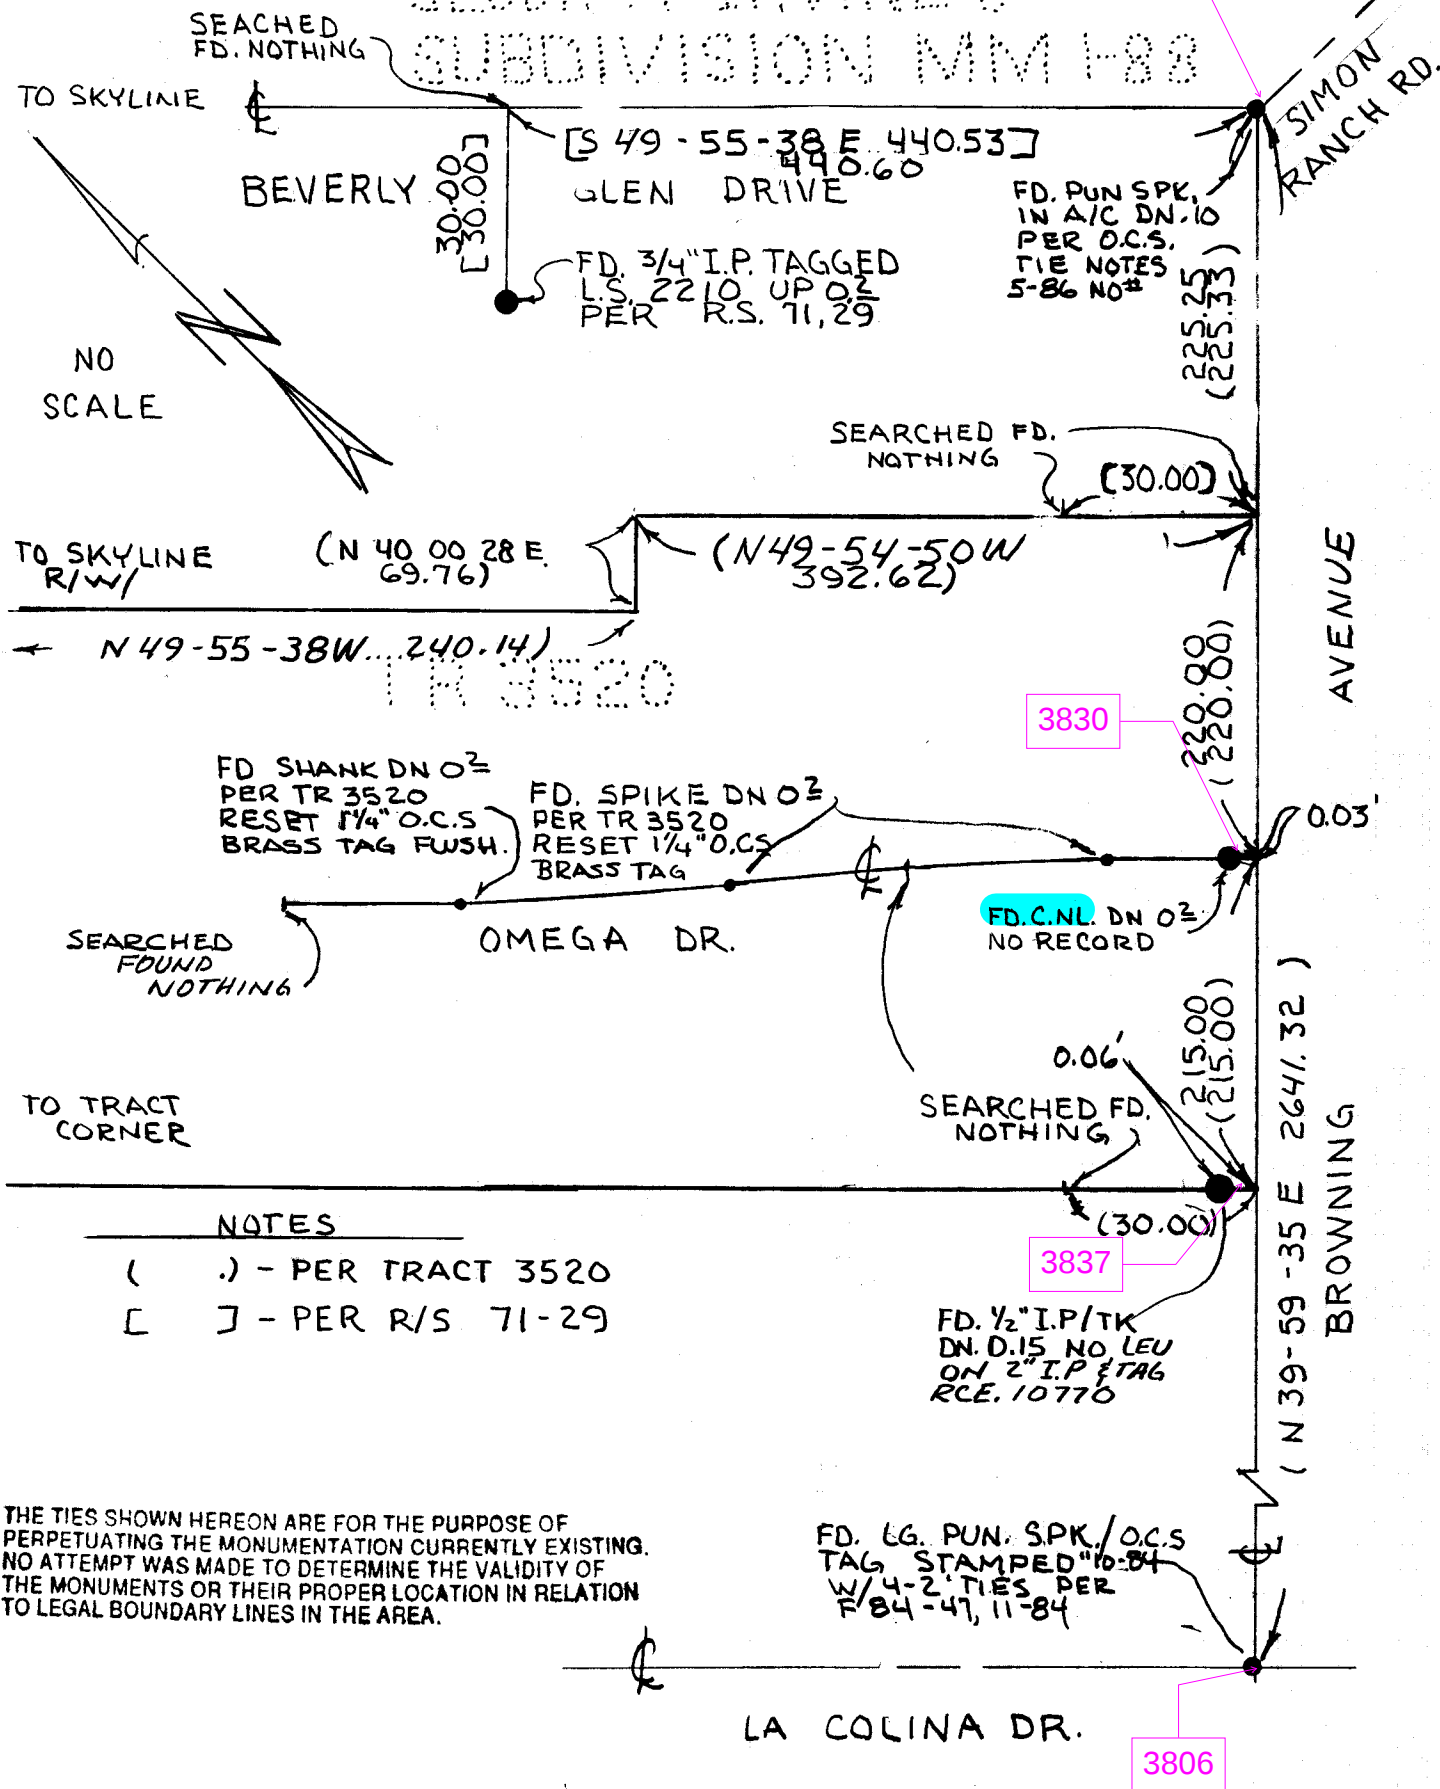


THE TIES SHOWN HEREON ARE FOR THE PURPOSE OF
PERPETUATING THE MONUMENTATION CURRENTLY EXISTING.
NO ATTEMPT WAS MADE TO DETERMINE THE VALIDITY OF
THE MONUMENTS OR THEIR PROPER LOCATION IN RELATION
TO LEGAL BOUNDARY LINES IN THE AREA.

SURVEYED BY DOYLE N: RUFFING

DATE 2-89

TIE NOTES FOR
OMEGA CR.

THE TIES SHOWN HEREON ARE FOR THE PURPOSE OF PERPETUATING THE MONUMENTATION CURRENTLY EXISTING. NO ATTEMPT WAS MADE TO DETERMINE THE VALIDITY OF THE MONUMENTS OR THEIR PROPER LOCATION IN RELATION TO LEGAL BOUNDARY LINES IN THE AREA.

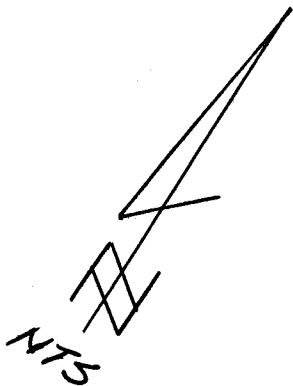

TRACT
2943

TRACT
3520

○ SET LD/063 TIE TAG,
T/C

● = FD LD/063 TIE TAG,
T/C, NO REF.

◎ = SET 1/4" BR. 063
TAG IN EASY FLUSH
(SEE DRAWING FOR
CRIG. PT.)

TRACT LINE

BC - FD SPR/TIN DN
.15 PER TR. #
3520

EC - FD
NOTHING
SET NOTHING

INT - FD C-MAIL IN
ARC DN. 20 PER 10 TO BGR

TIE NOTES
TR # 3520

E BROWNING

3830

SEE

DOYLE N. RUFFING

DATE 2-89

ORANGE COUNTY SURVEYOR

