


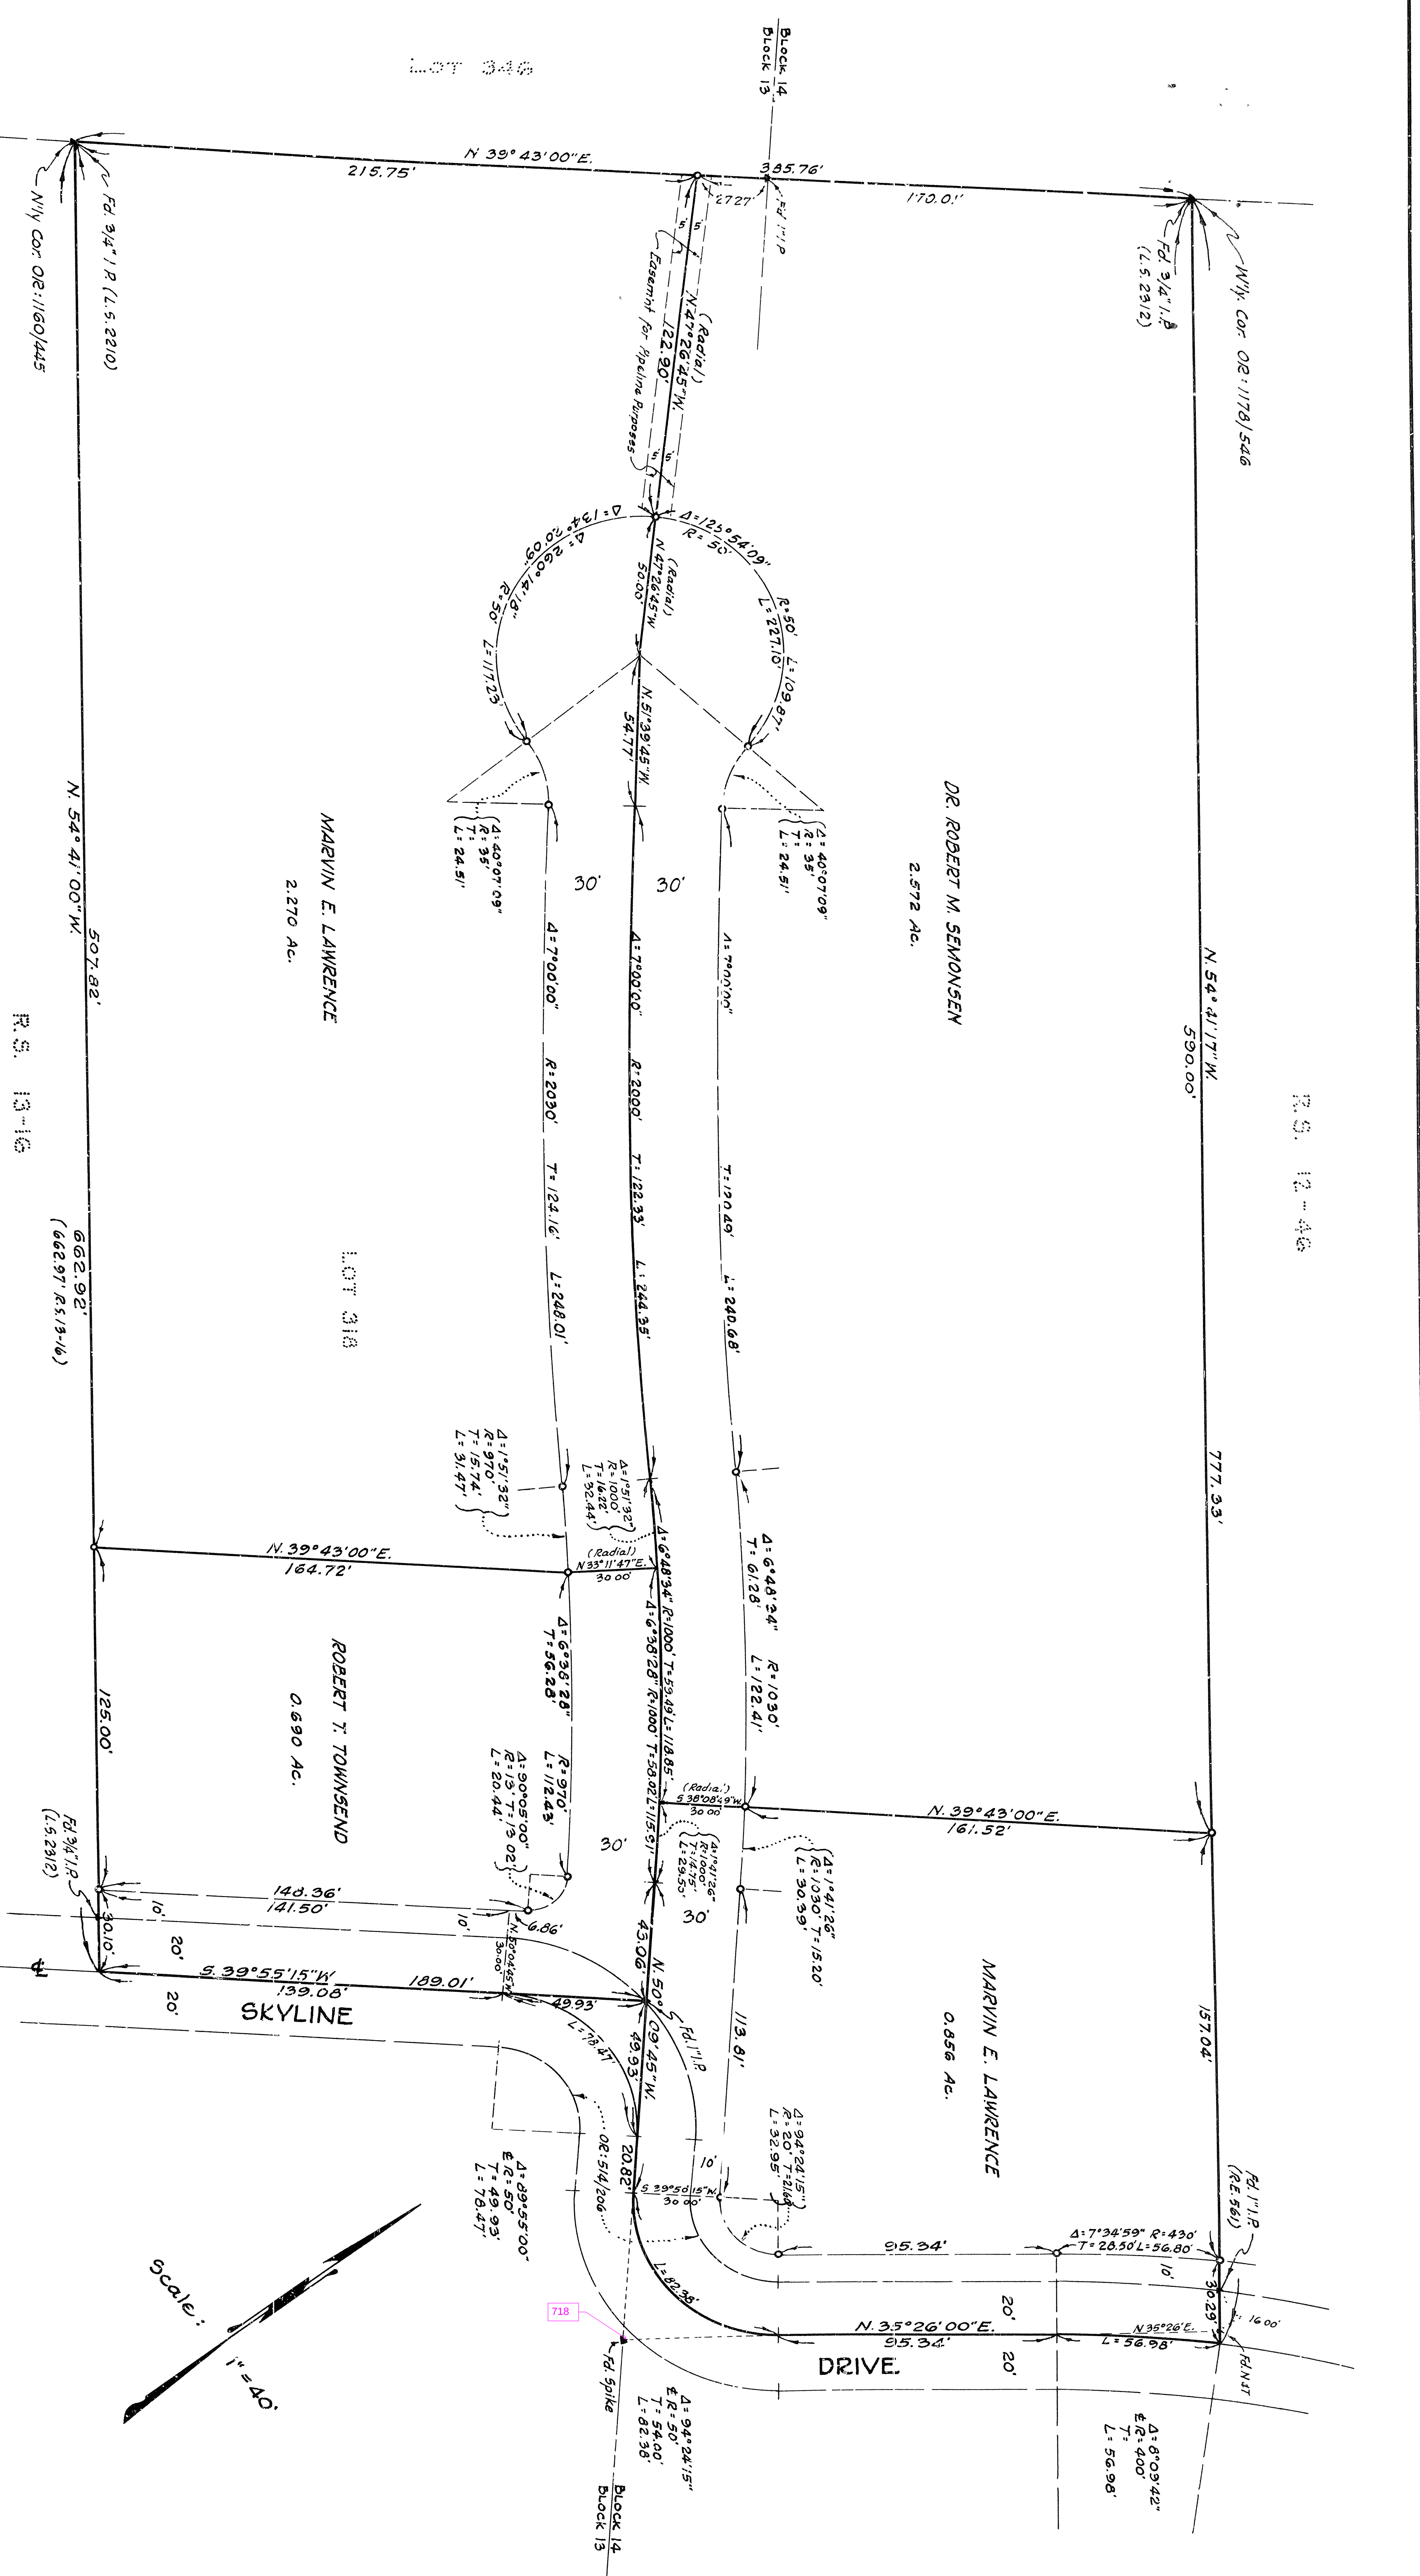

I, D.D. Hillyard, hereby certify that I am a Licensed Surveyor of the State of California (No. 2210); that this map, consisting of one sheet, represents a true and complete survey made under my supervision at the request of the owners; that all monuments shown, actually exist at the time of the survey, and their position is correctly shown.

D.D. Hillyard
Licensed Surveyor

Notes:
Bearings are based on Skyline Drive
"N 39° 55' 15" E" as per O.R. 514/206.
Set 1" iron pipe bearing copper tags
stamped "L.S. 2210" at points to be

Examined and approved this 4 day of
Feb. 1955.
Wm. J. Ford
County Surveyor

D.D. HILLYARD ~ LICENSED SURVEYOR

OF A PORTION OF LOT 316, BLOCK 13,
AND BLOCK 14, IRVINE'S SUBDIVISION, MPM:1-88.
(OWNERS AS INDICATED)

RECORD OF SURVEY

