
Governme Governme Governme Governme Gancho Date of Survey Dat	PP INT OF S PP BC ALON CORN nt Corner 10-25-20 8771 Establis Reestal Reestal	SINGINGW NG FAIRW IER TYPE Control Property Other 022 Shed blished nd, set, rese	VOOD DR AN EATHER RI N Elev Units Hori: Zone Vert Comp Comp Rebuilt Referer et, replaced,	ORANGE ORANGE	ATHER F Y & +/- 4: DORDINA etric Epoch C lic Resourc C F	23-0032, California RD & AT THE APP B' E'LY OF SAID D ATES (Optional) E U.S. Survey Foot Date ces Code §§8801-88 ces Code §§8890-89 Other: Pre-Construction
Brief Legal Description AT THE ATEC ALONG SINGINGWOOD DR & ATTHE ATEC ALONG SINGING S	PP INT OF S PP BC ALON CORN nt Corner 10-25-20 8771 Establis Reestal Reestal	SINGINGW NG FAIRW IER TYPE Control Property Other 022 Shed blished nd, set, rese	VOOD DR AN EATHER RI N Elev Units Hori: Zone Vert Comp Comp Rebuilt Referer et, replaced,	ND FAIRWED, +/- 43' S'L Covation s Me zontal Datum e cical Datum plies with Pub plies with Pub	ATHER F Y & +/- 45 DORDINA etric Epoch C lic Resource C F	RD & AT THE APE B' E'LY OF SAID II ATES (Optional) E. U.S. Survey Foot Date ces Code §§8801-88 ces Code §§8890-89 Other: Pre-Construction
Meander Rancho Rancho Date of Survey	8771 Establis Reestal ment as foun	Property Other 022 shed blished nd, set, rese	Elev Units Hori: Zone Vert Com Com Rebuilt Referer et, replaced,	vation s Moreovation zontal Datum e cical Datum plies with Pub plies with Pub	Epoch D	U.S. Survey Foot Date ces Code §§8801-88 ces Code §§8890-89 Other: Pre-Construction
Corner/ Monument:	Establis Reestal ment as foun	blished nd, set, rese	Rebuilt Referer et, replaced,	nced	F	Pre-Construction
Monument: ☐ Found and tagged Jarrative of corner identified and monumated See sheet #2 for description (s): NO CLAIM IS MADE AS TO THE RELATION PARCEL, OR LOT LINES, OR ANY OTHER REPRESENTATION ONLY. BEARINGS SHOWN HEREON ARE ASSUME MEASURED DISTANCES SHOWN HEREON REDUNDANT LEAST SQUARES NETWORK PER CHAPTERS 5 & 11 OF THE OC SUBBY 1.
See sheet #2 for description (s): NO CLAIM IS MADE AS TO THE RELATION PARCEL, OR LOT LINES, OR ANY OTHER REPRESENTATION ONLY. BEARINGS SHOWN HEREON ARE ASSUME MEASURED DISTANCES SHOWN HEREON REDUNDANT LEAST SQUARES NETWORK PER CHAPTERS 5 & 11 OF THE OC SUBBY 1.00002346. RECORD DISTANCES SHOWN HEREON ARE OR GROUND, AS PER SAID RECORD. ALMEASUREMENTS. SURV This Corner Record was prepared the Professional Land Surveyors' Signed COUNTY S	NSHIP OF THE DATA RELAT	E POINTS SI	·	or removed:		
the Professional Land Surveyors' Signed	E AS THEY A L DISTANCES EYOR'S STA	APPEAR ON WERE FIELD ATEMENT	THE DOCUMEI VERIFIED US	NT OF RECOF	RD. DISTAN NIC DISTA	NCES MAY BE EITHE
Signed Ellish Clean	•	•	ection in conf 14-2023	formance wit	h	
		(P.L.S.	or R.C.E. N	lo. <u>9294</u>	_	NO. 9294
This Corner Record was received	SURVEYOR'S	S STATEMI 02-14-				GED LAND SU
and examined and filed	1.	1-13-2023	3			SED LAND SO WASEL LAFON
Signed Nichael fa Jonta		(P.L.S.	or R.C.E. N	lo. <u>8970</u>	_	\\ \ \\ \\ \\ \\ \\ \ \ \ \ \ \ \ \ \ \
TitleDEPUTY COUNTY SU			•			NO. 8970
County Surveyor's Comment	RVEYOR					

6175

3907

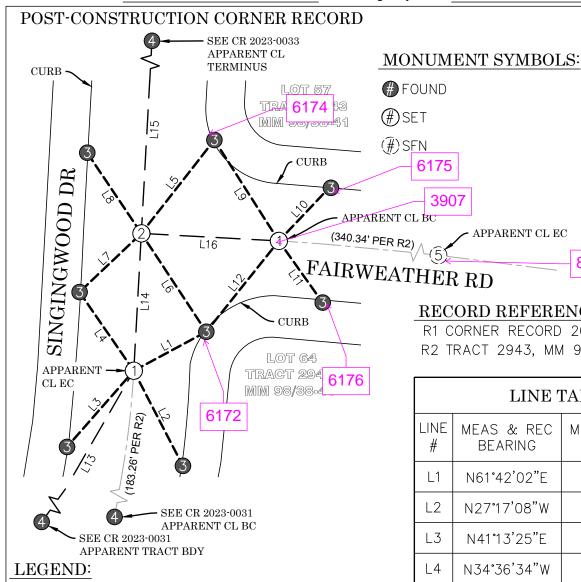

- REF LINE 1: **APPARENT**

CENTERLINE

REF LINE 2: TIE LINES

> REF LINE 3: MEAS BETWEEN

MONUMENTS

ORANGE COUNTY SURVEYOR OCS SEARCHED, FOUND NOTHING SFN

GRAY LINE NON-MEASURED LINE

MONUMENT NOTES:

(1) SEARCHED, FD NOTHING; SET SPIKE & 1-1/2" SS WSHR STMPD "OCS", FLUSH IN AC, PER TIES AS SHOWN HEREON

(2) SEARCHED, FD NOTHING; SET 3-1/2" BR DISK STMPD "OCS", DN 1.3' IN MONUMENT WELL, PER TIES AS SHOWN HEREON

3 FD LEAD & 3/4" BR TAG STMPD "OCS TIE" ON TOP OF CONC CURB, PER R1

4 FD MONUMENT AS DESCRIBED ON ADJACENT CORNER RECORD

(5) APPARENT CL BC, SFN

RECORD REFERENCES:

APPARENT CL EC

R1 CORNER RECORD 2022-1253 R2 TRACT 2943, MM 98/38-41

816

NTS

LINE TABLE							
LINE #	MEAS & REC BEARING	MEAS & REC DISTANCE	REF				
L1	N61°42'02"E	25.70'	R1				
L2	N27°17'08"W	33.46'	R1				
L3	N41°13'25"E	31.68'	R1				
L4	N34°36'34"W	29.87'	R1				
L5	N38°01'15"E	37.04'	R1				
L6	N33°23'06"W	36.82'	R1				
L7	N46°29'13"E	26.65'	R1				
L8	N33°53'31"W	30.36'	R1				
L9	N32°33'03"W	37.43'	R1				
L10	N43°27'12"E	23.73'	R1				
L11	N35°24'56"W	23.63'	R1				
L12	N38°38'25"E	36.34'	R1				
L13	N30°03'36"E	315.06'	R1				
L14	N03°08'57"E	42.99'	R1				
L15	N03°08'18"E	216.03'	R1				
L16	N86°50'45"W	43.02'	R1				