


SCALE 1" = 200'

THESE NOTES NOT FIELD CHECKED
BY ORANGE COUNTY SURVEYOR

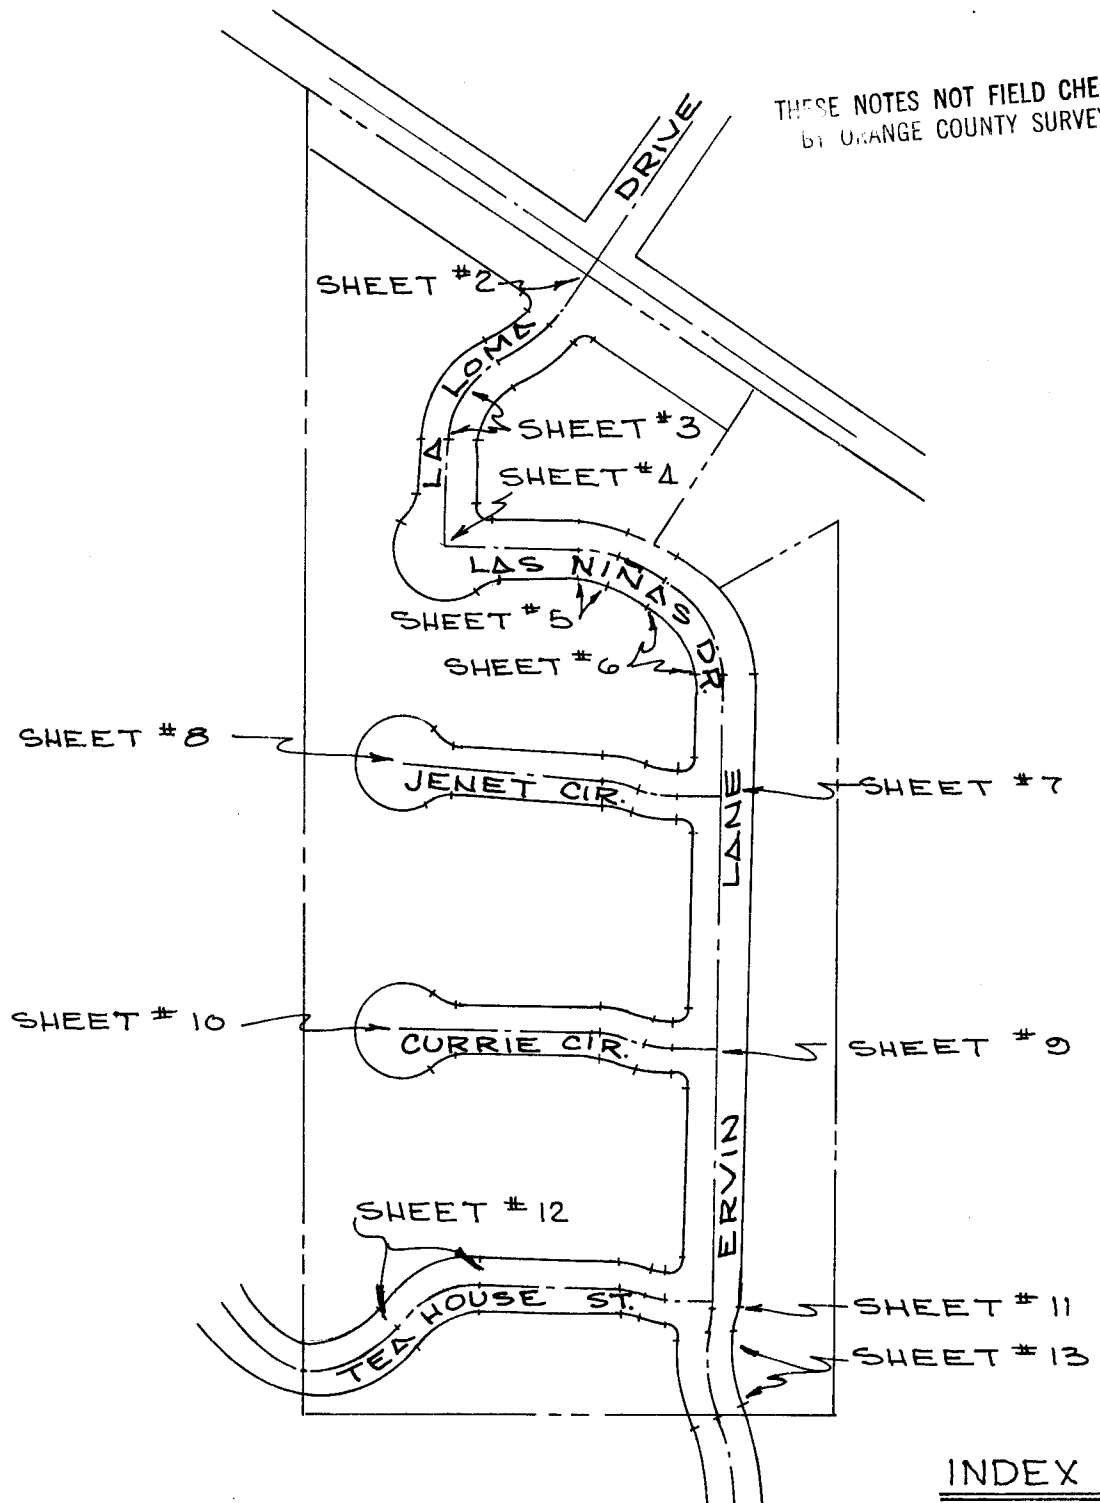

INDEX MAP

Q TIES - TRACT 5576

A/5-9

595

WILLIAMSON & SCHMID C.E.'s


JULY, 1966

G.F. OLDENBURG - L.S. 3246

SHEET 2 OF 13

PARTY:

JOHNSON
SHEETS

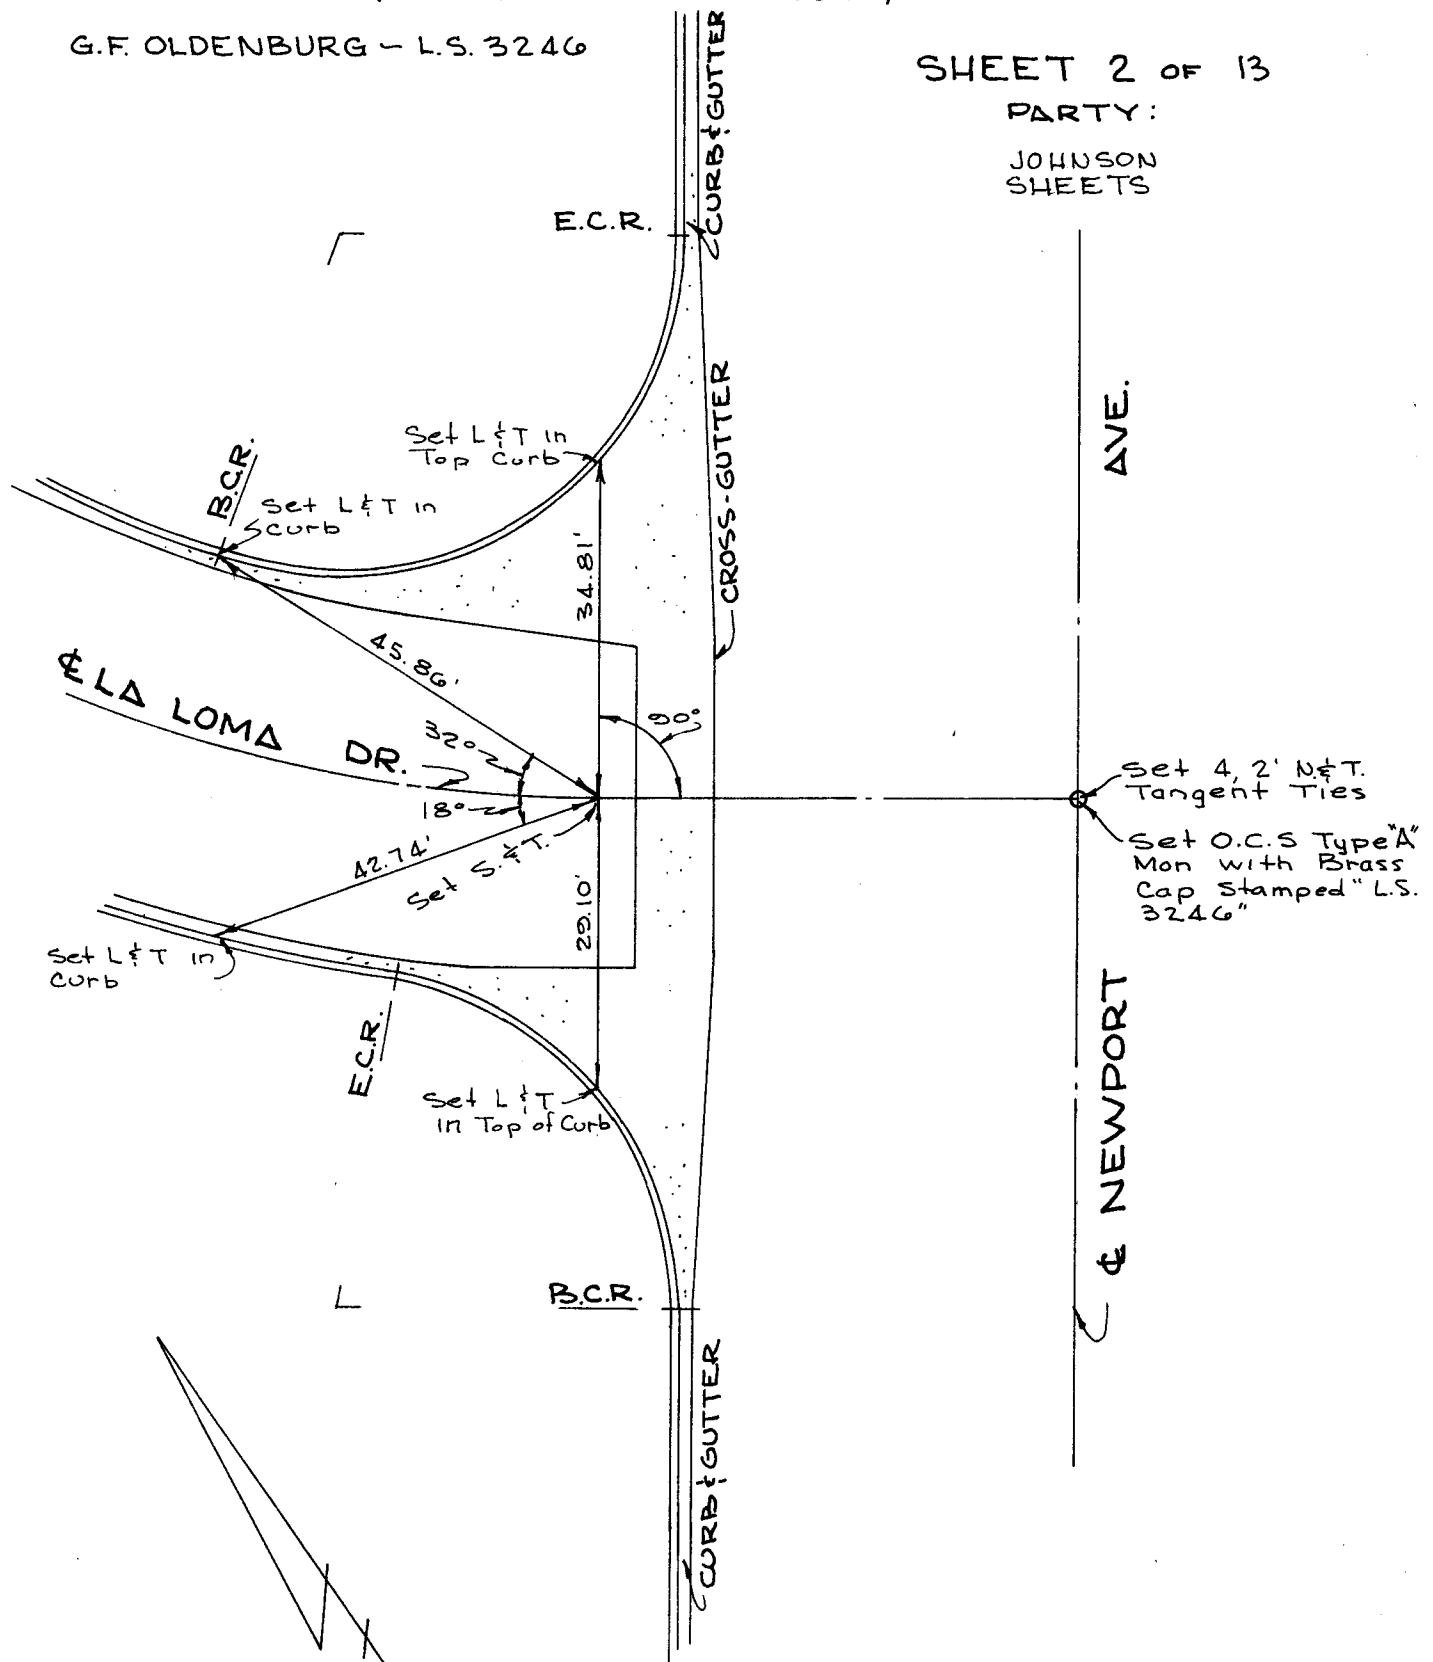

SCALE 1" = 20'

NEWPORT AVE. &
LA LOMA DR.


THESE NOTES NOT FIELD CHECKED
BY ORANGE COUNTY SURVEYOR

G.F. OLDENBURG - L.S. 3246

SHEET 3 of 13

PARTY:

JOHNSON
SHEETS

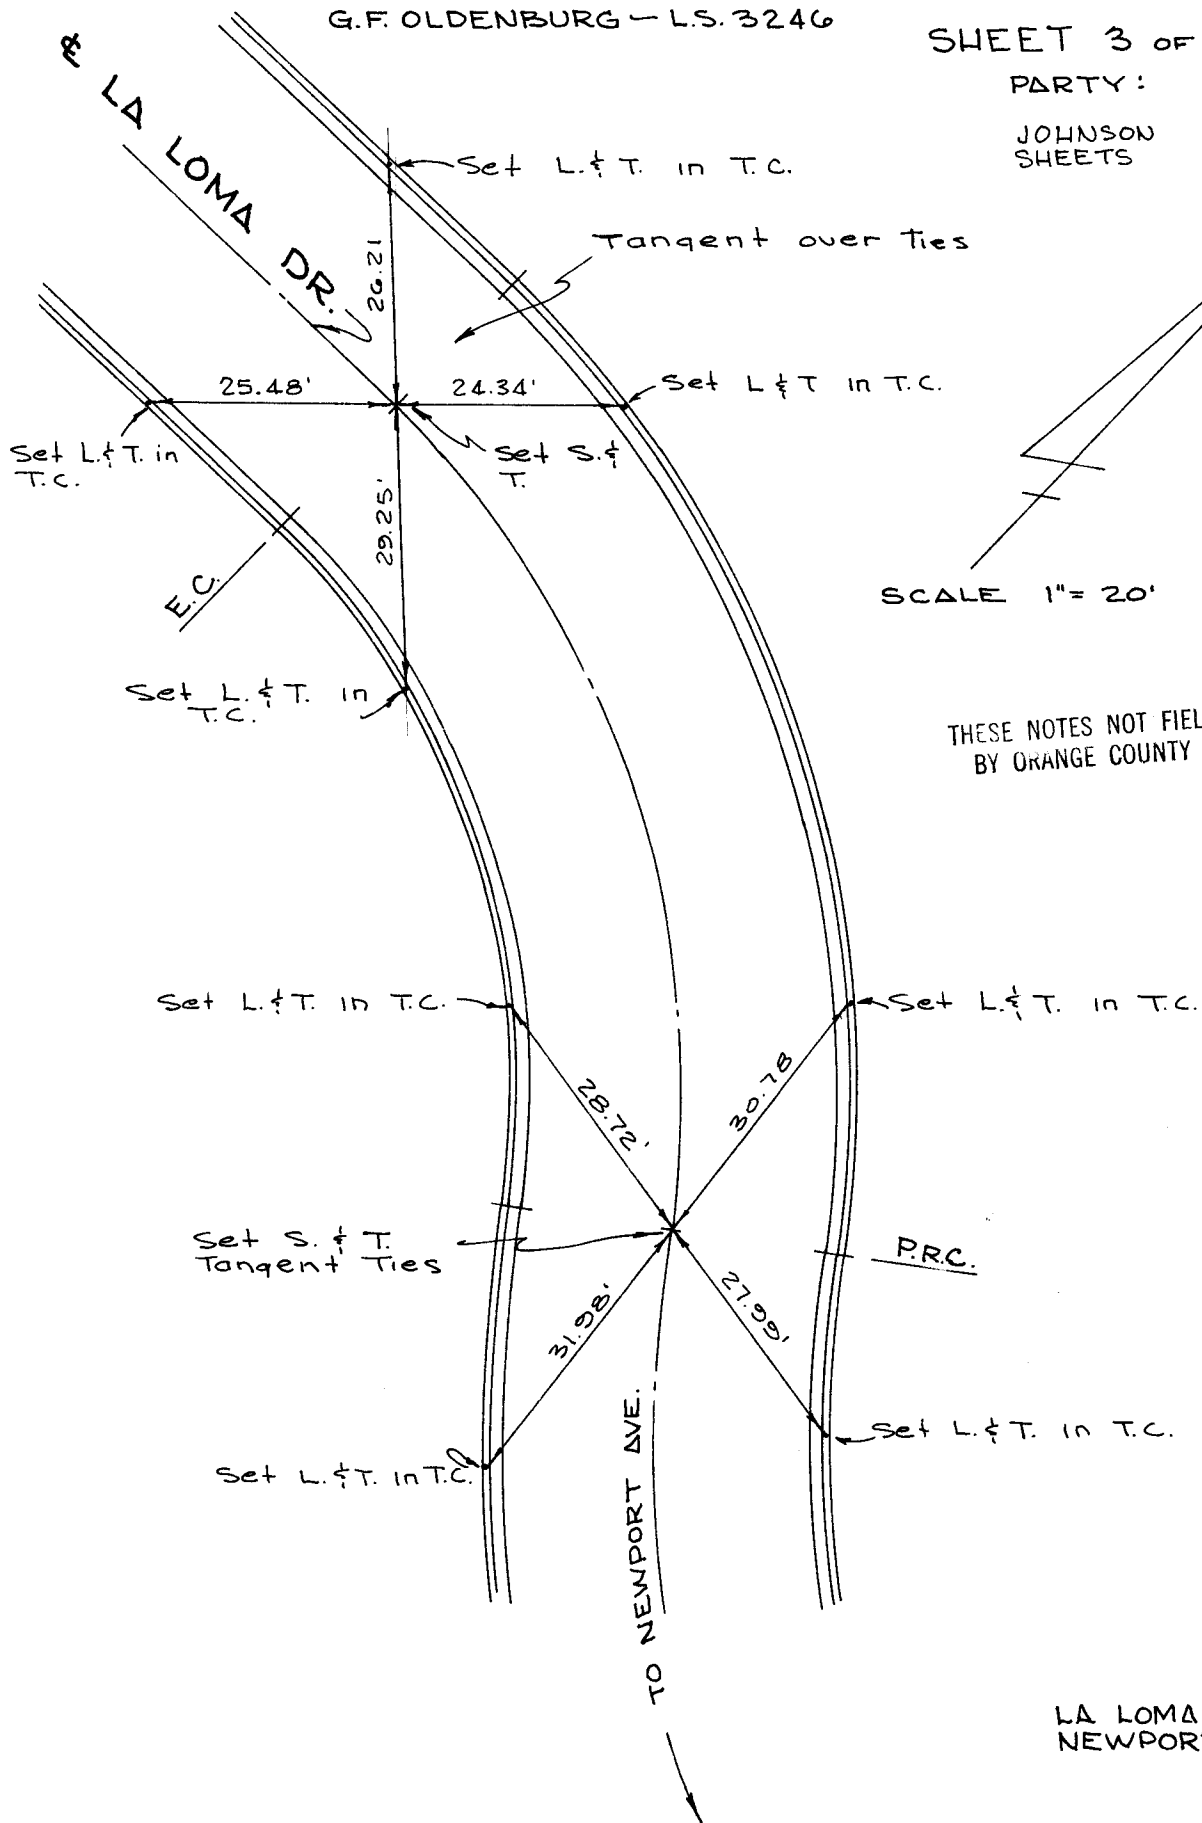

& TIES - TRACT 5576

A/5-9

599

WILLIAMSON & SCHMID C.E.'s

JULY, 1966


G. F. OLDENBURG - L.S. 3246

SHEET 4 OF 13

PARTY:

JOHNSON
SHEETS

THESE NOTES NOT FIELD CHECKED
BY ORANGE COUNTY SURVEYOR

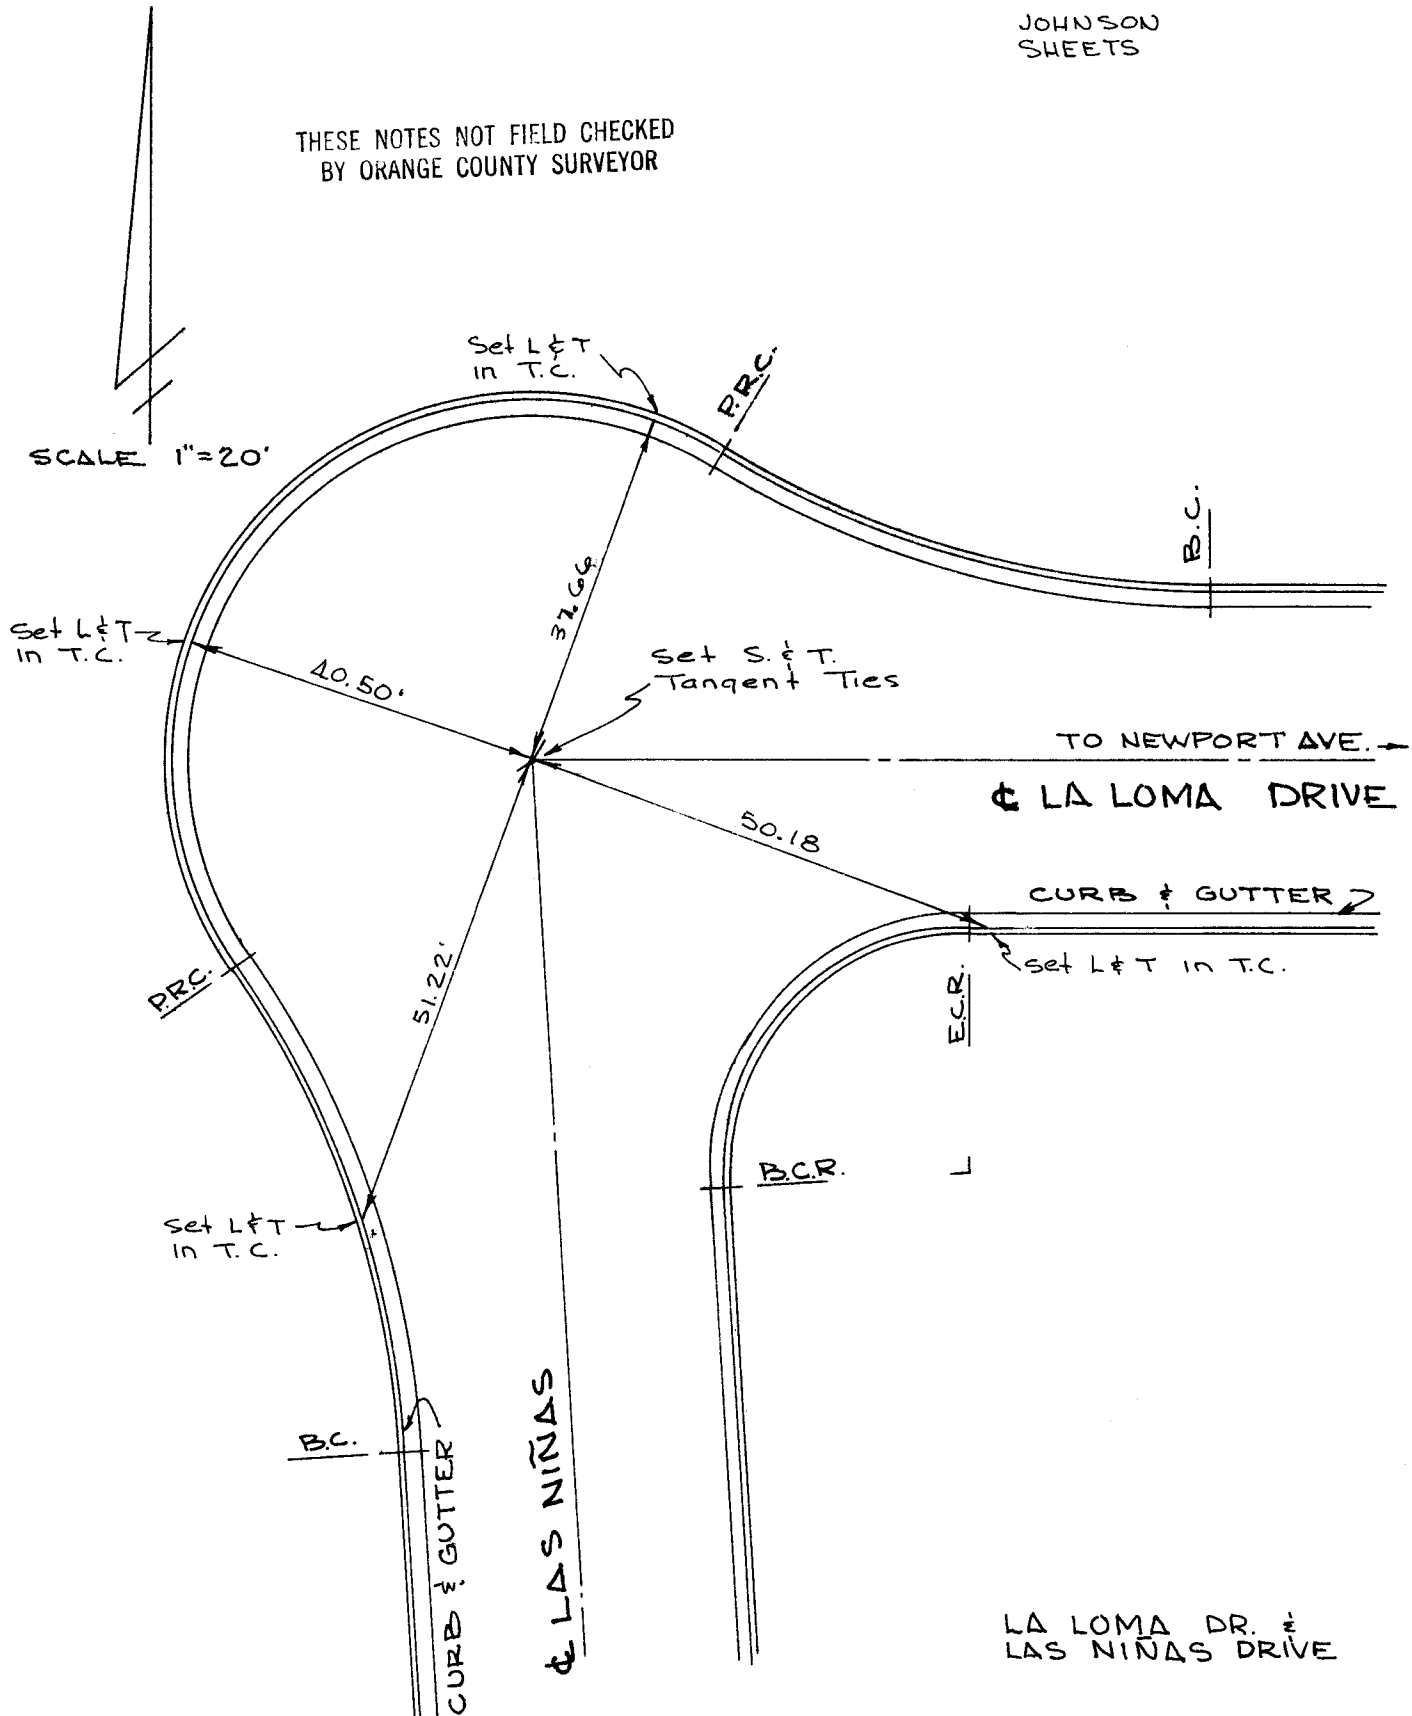

± TIES - TRACT 5576

A/5-9

601

WILLIAMSON ± SCHMID, C.E.'s


JULY, 1966

G.F. OLDENBERG - L.S. 3246

SHEET 5 of 13

PARTY:

JOHNSON
SHEETS

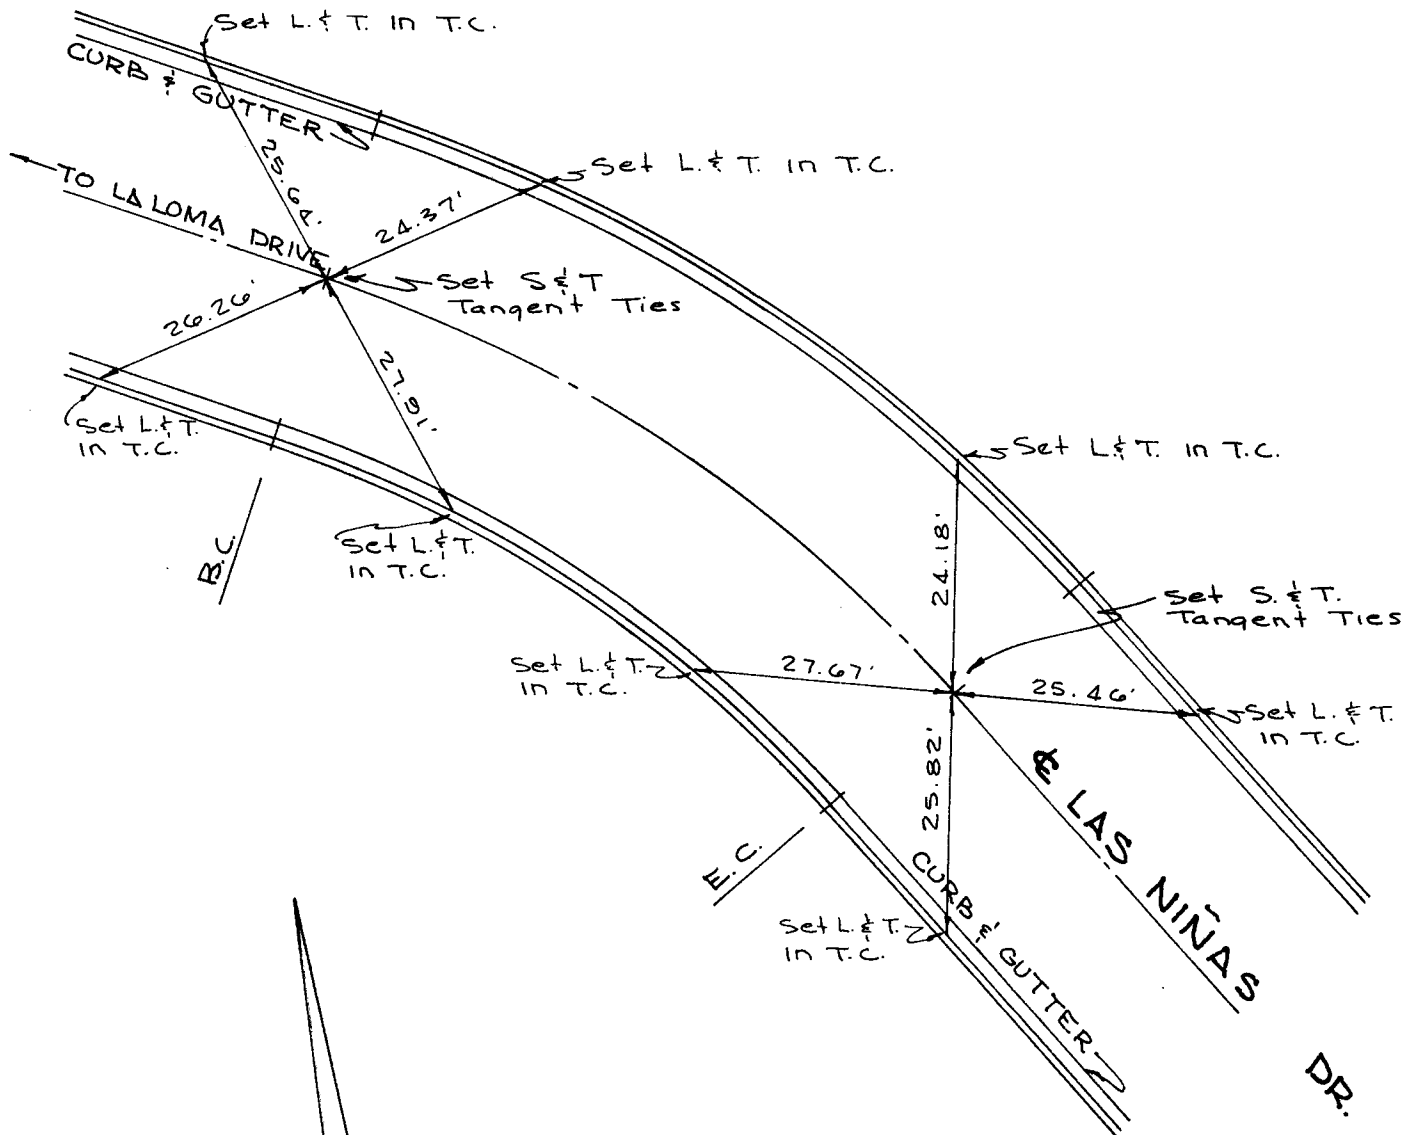

THESE NOTES NOT FIELD CHECKED
BY ORANGE COUNTY SURVEYOR

LAS NIÑAS DRIVE
TO LA LOMA

65-80
3

WILLIAMSON & SCHMID, C.E.'s


JULY, 1966

G.F. OLDENBURG - L.S. 3246

SHEET 6 of 13

PARTY:


JOHNSON
SHEETS

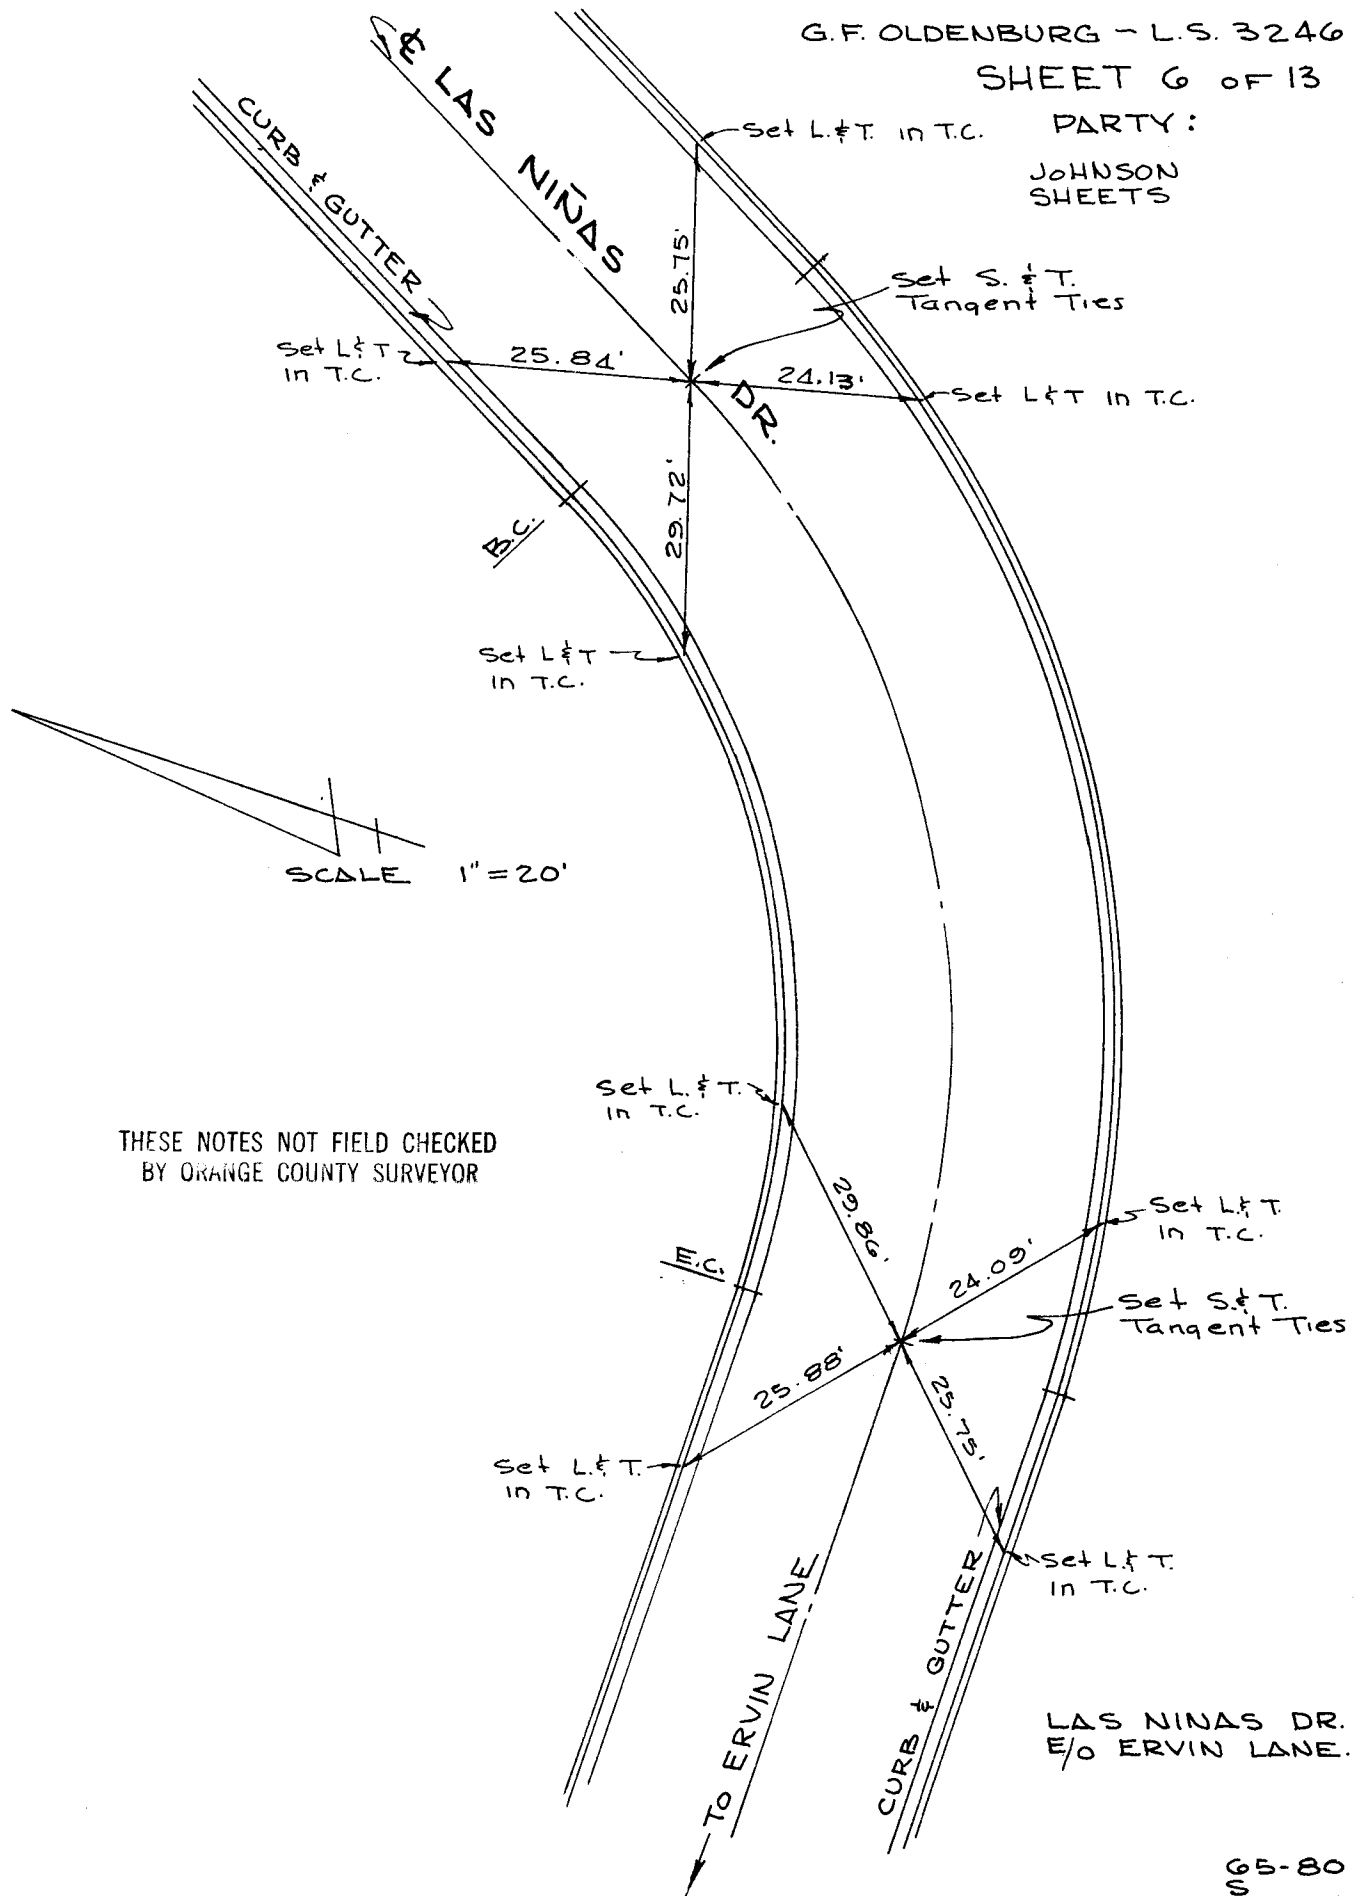

G.F. OLDENBURG - L.S. 3246

SHEET 7 OF 13

PARTY:
KING
COOK
HENDERSON

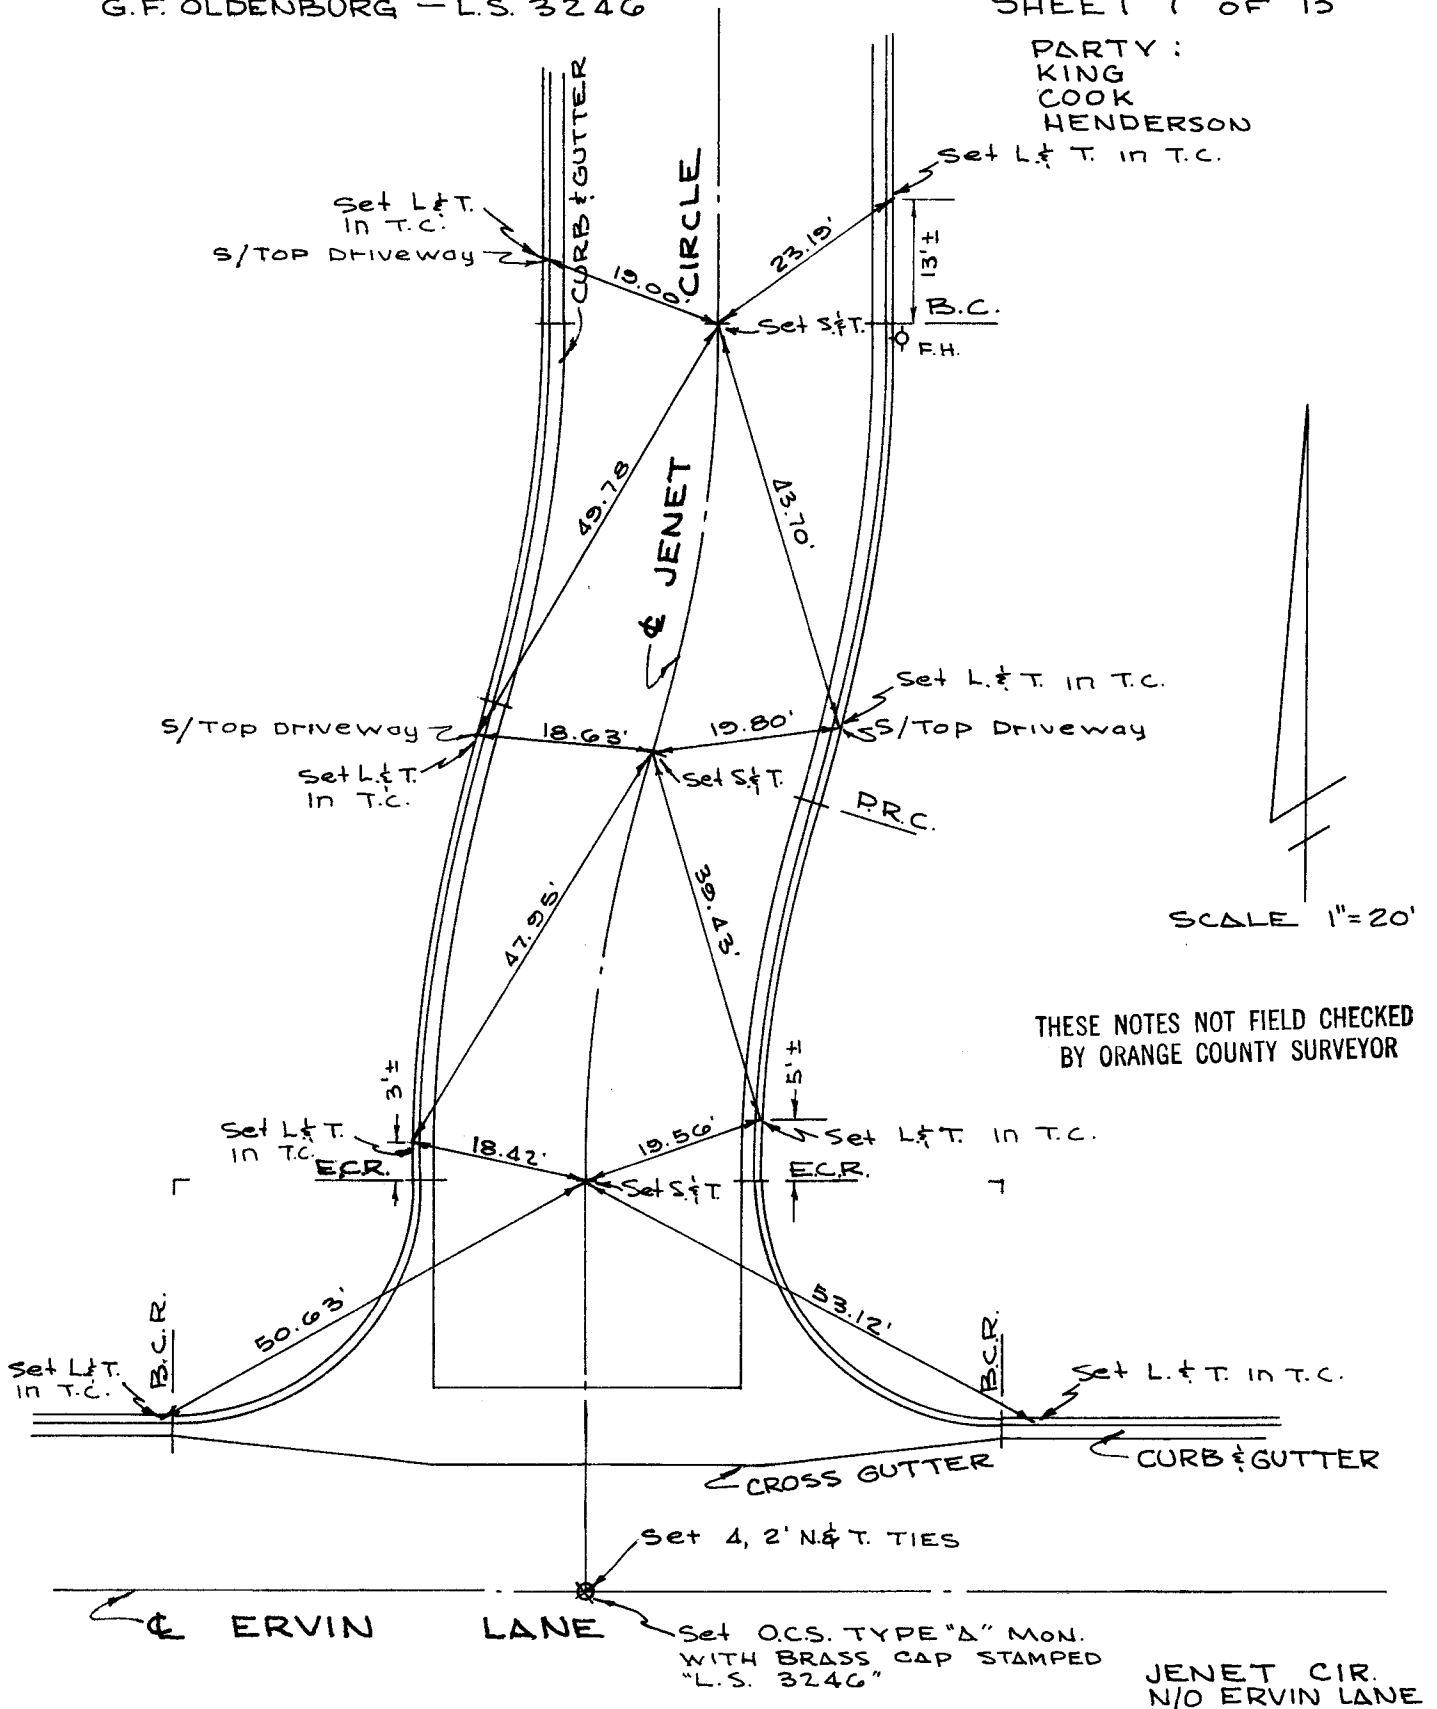

SCALE 1"=20'

THESE NOTES NOT FIELD CHECKED
BY ORANGE COUNTY SURVEYOR


JENET CIR.
N/O ERVIN LANE

PARTY:


KING

COOK

HENDERSON

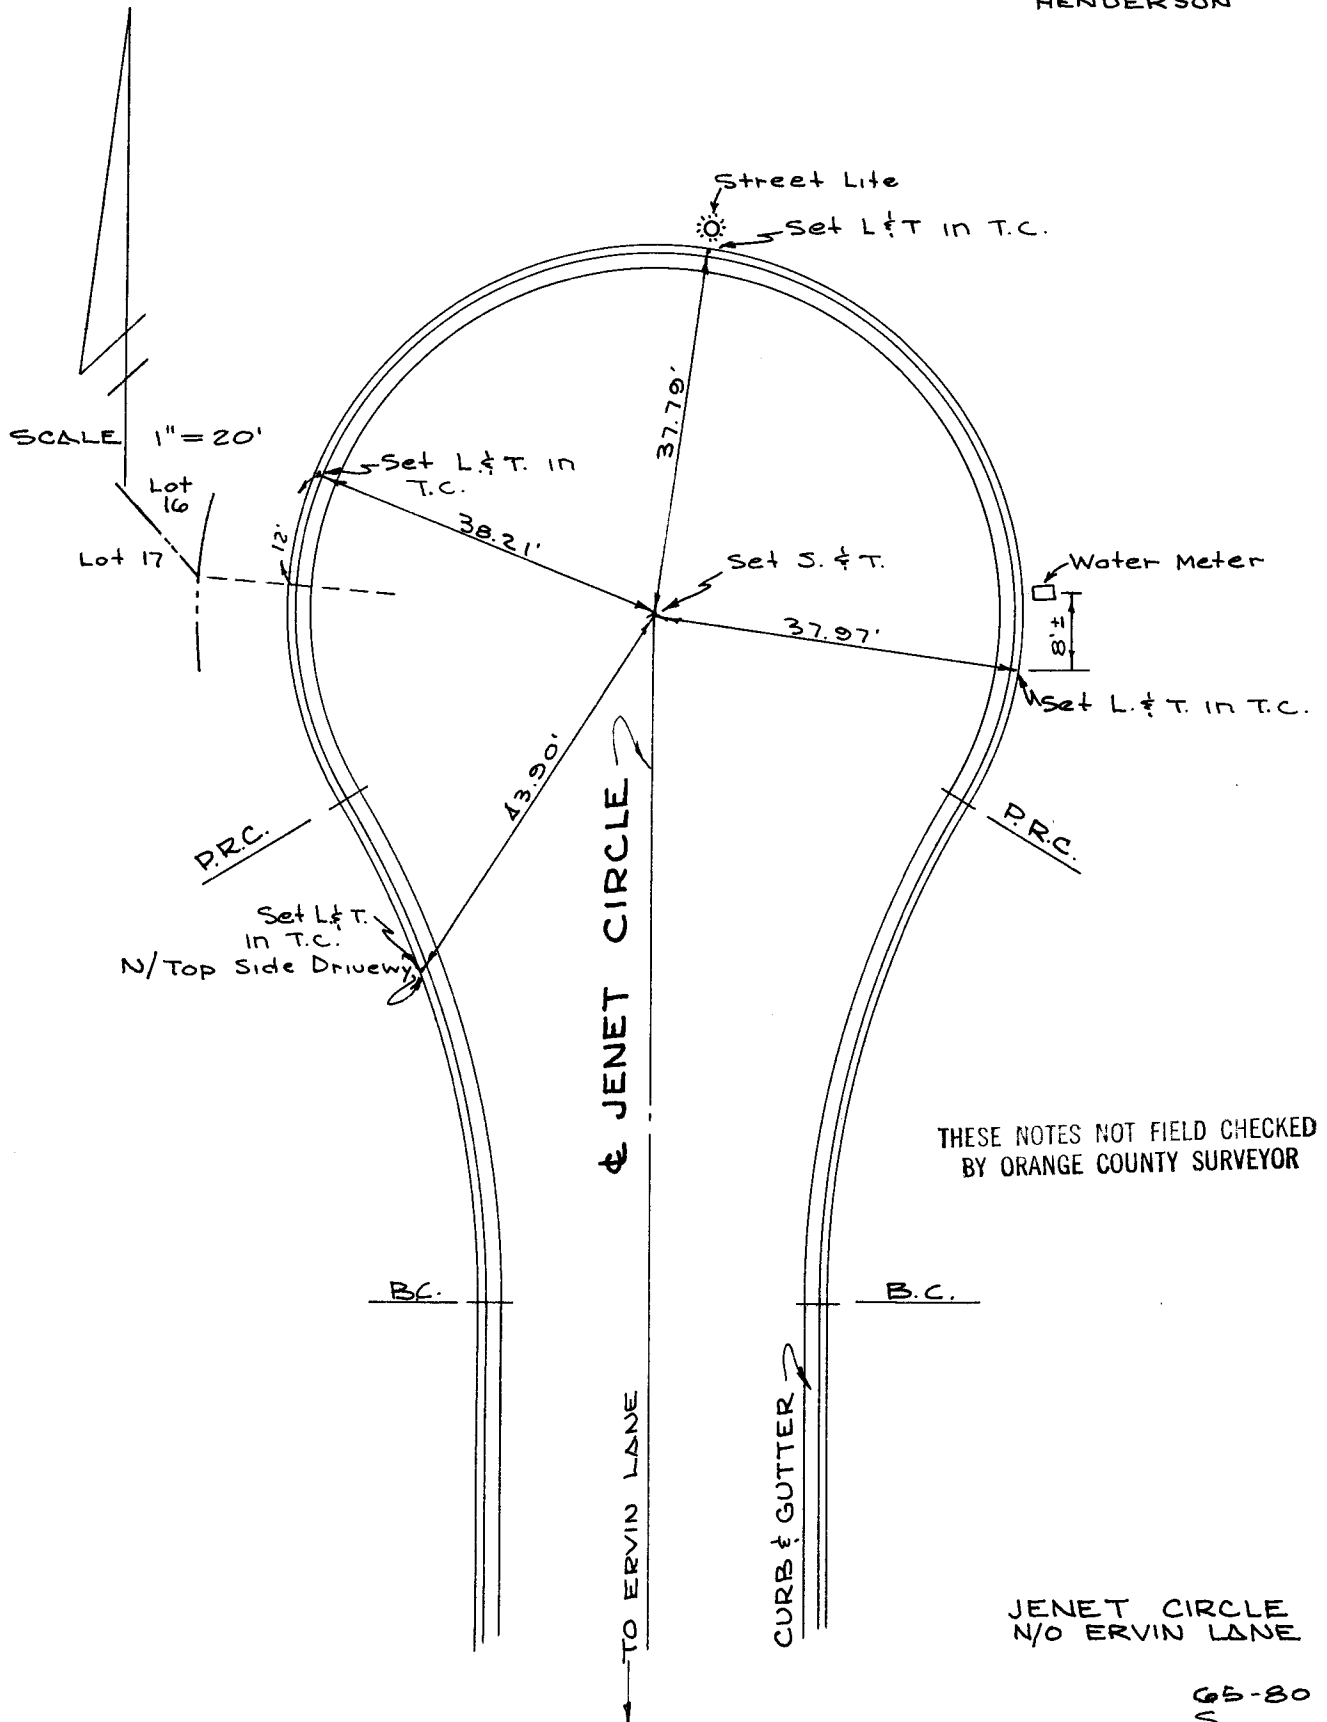

PARTY:
KING
COOK
HENDERSON

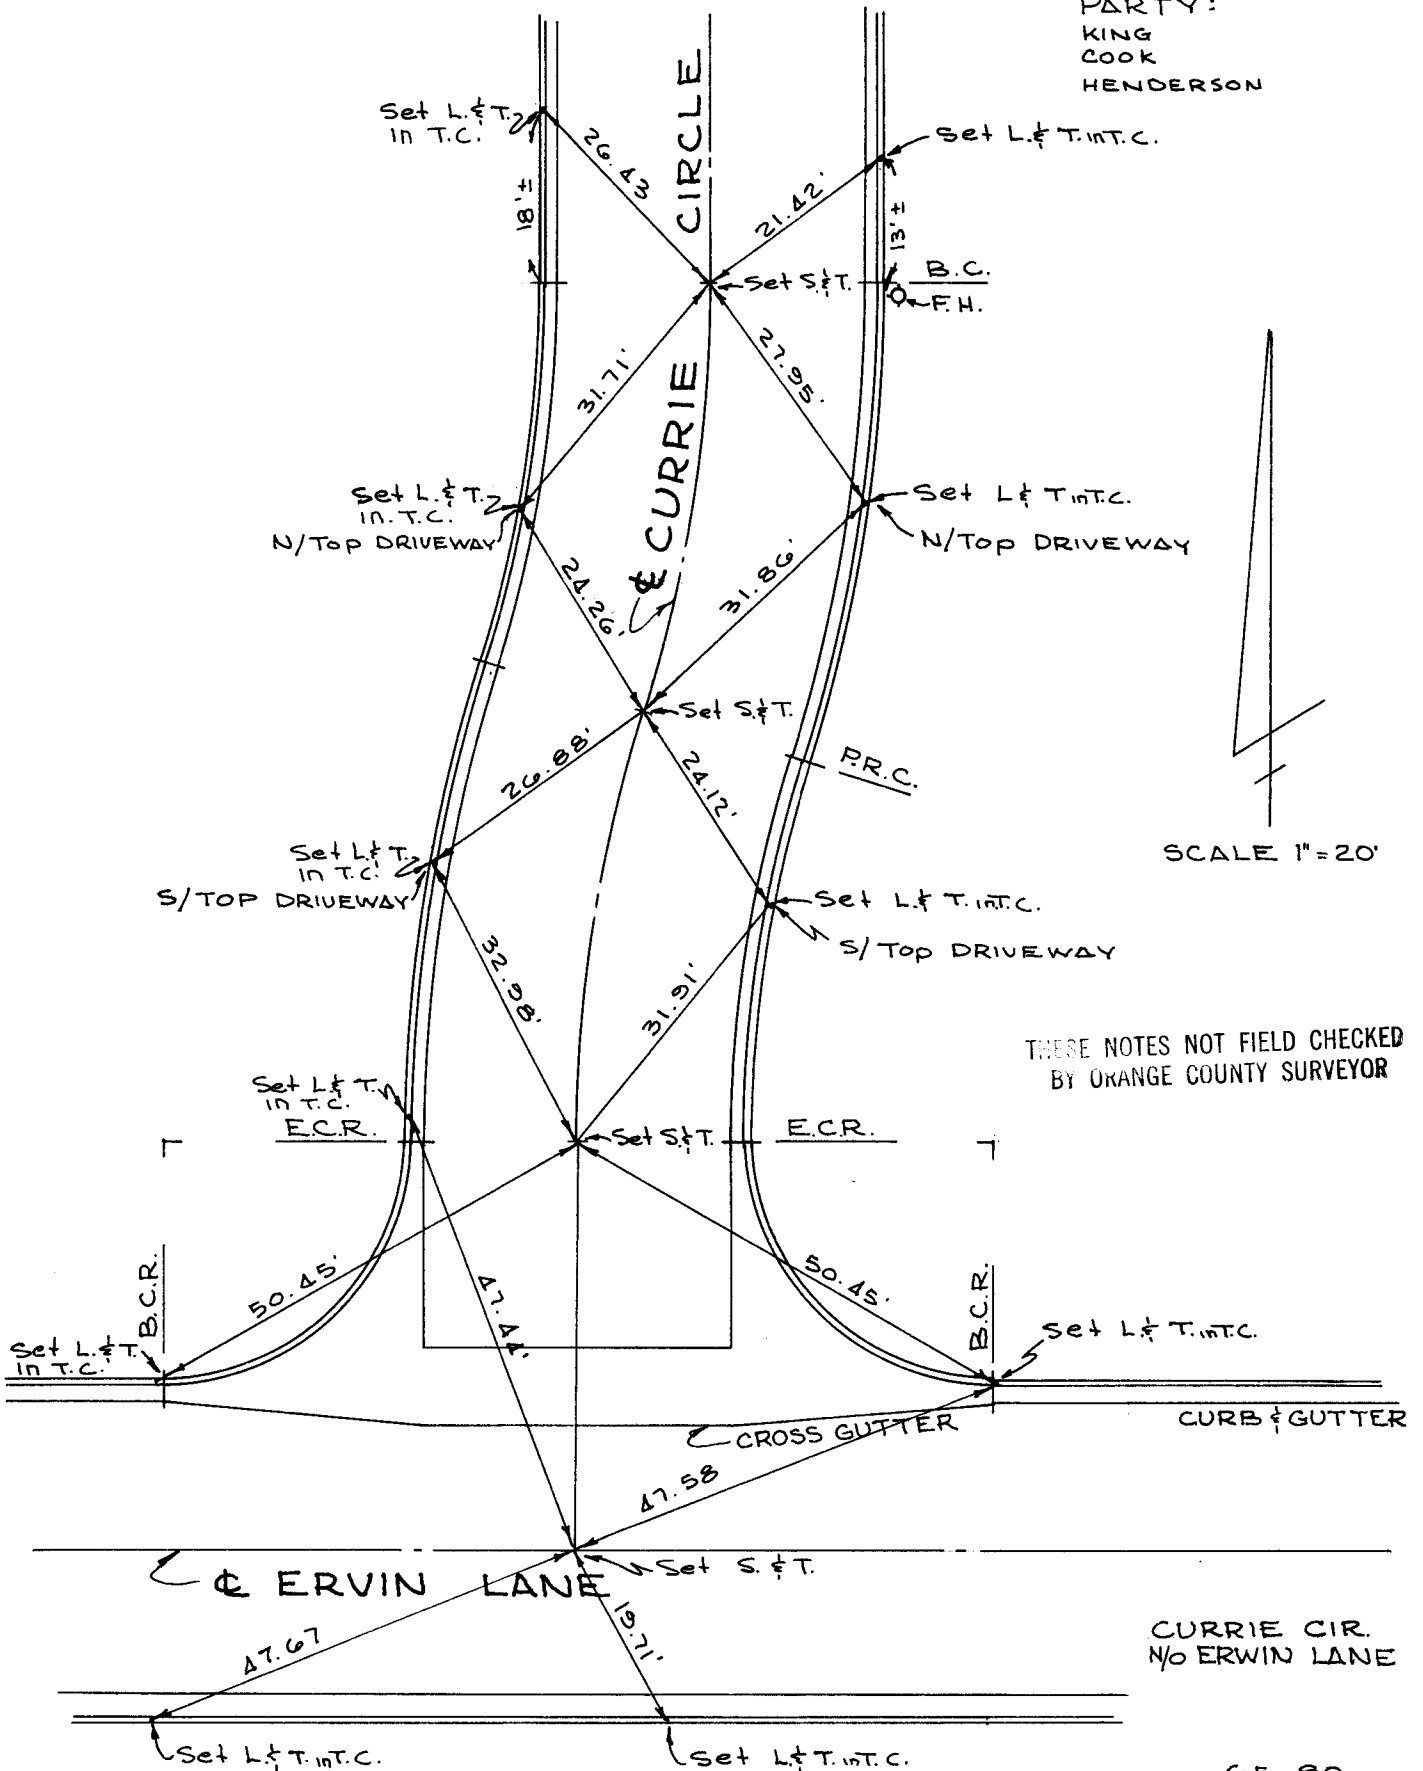

CLTIES -TRACT 5576

A/5-9

611


WILLIAMSON & SCHMID CE's

SEPT., 1966

G.F. OLDENBURG -L.S. 3246

SHEET 10 OF 13


PARTY:
KING
COOK
HENDERSON

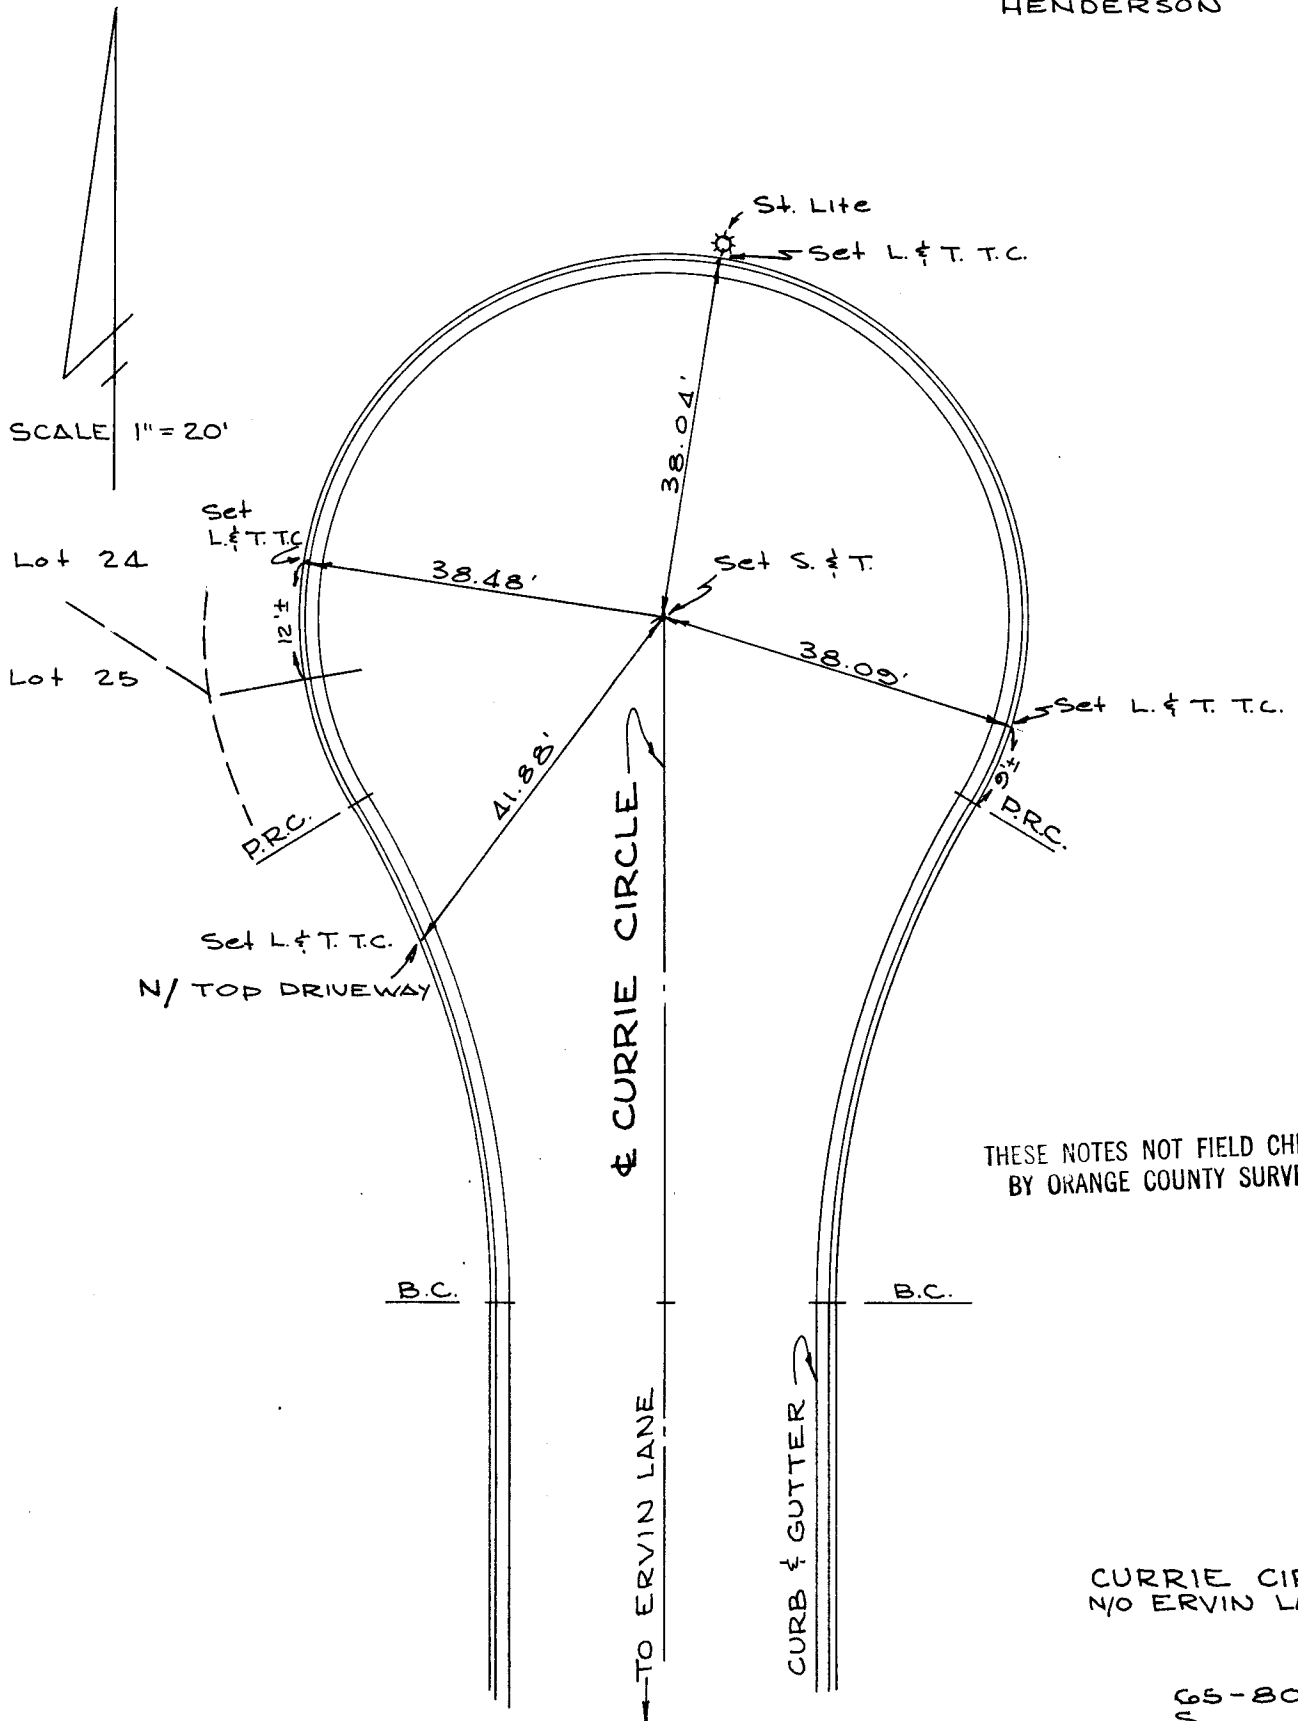

Sept, 1966

SHEET 11 OF 13

PARTY:
KING
HENDERSON
COOK

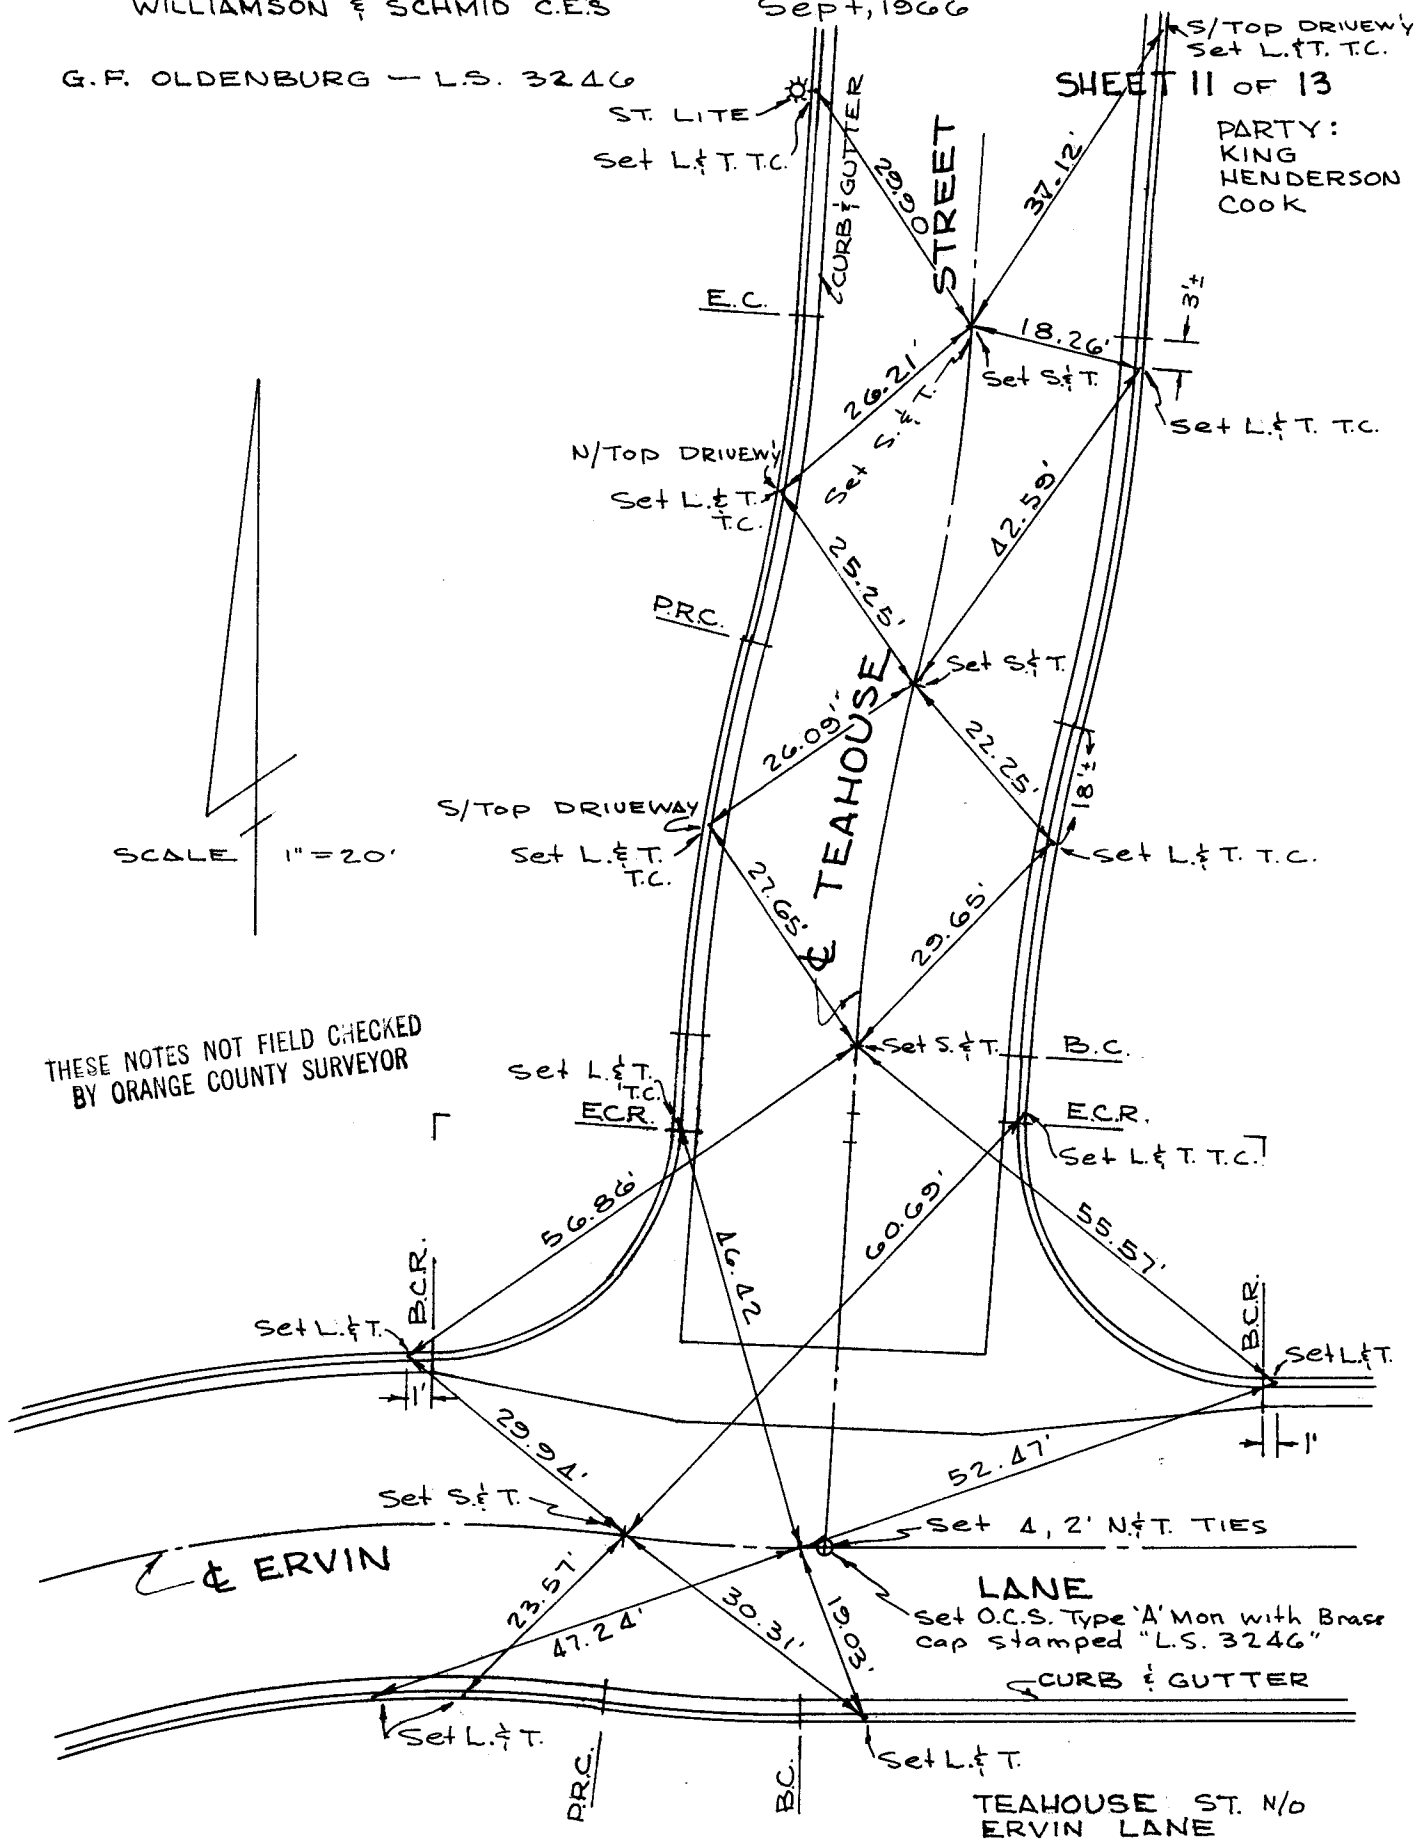

WILLIAMSON & SCHMID, C.E.'s.

, 1966


G.F. OLDENBURG - L.S. 3246

SHEET 12 OF 13

PARTY :
COOK
Johnson
Maurel

THESE NOTES NOT FIELD CHECKED
BY ORANGE COUNTY SURVEYOR

SCALE 1"=20'

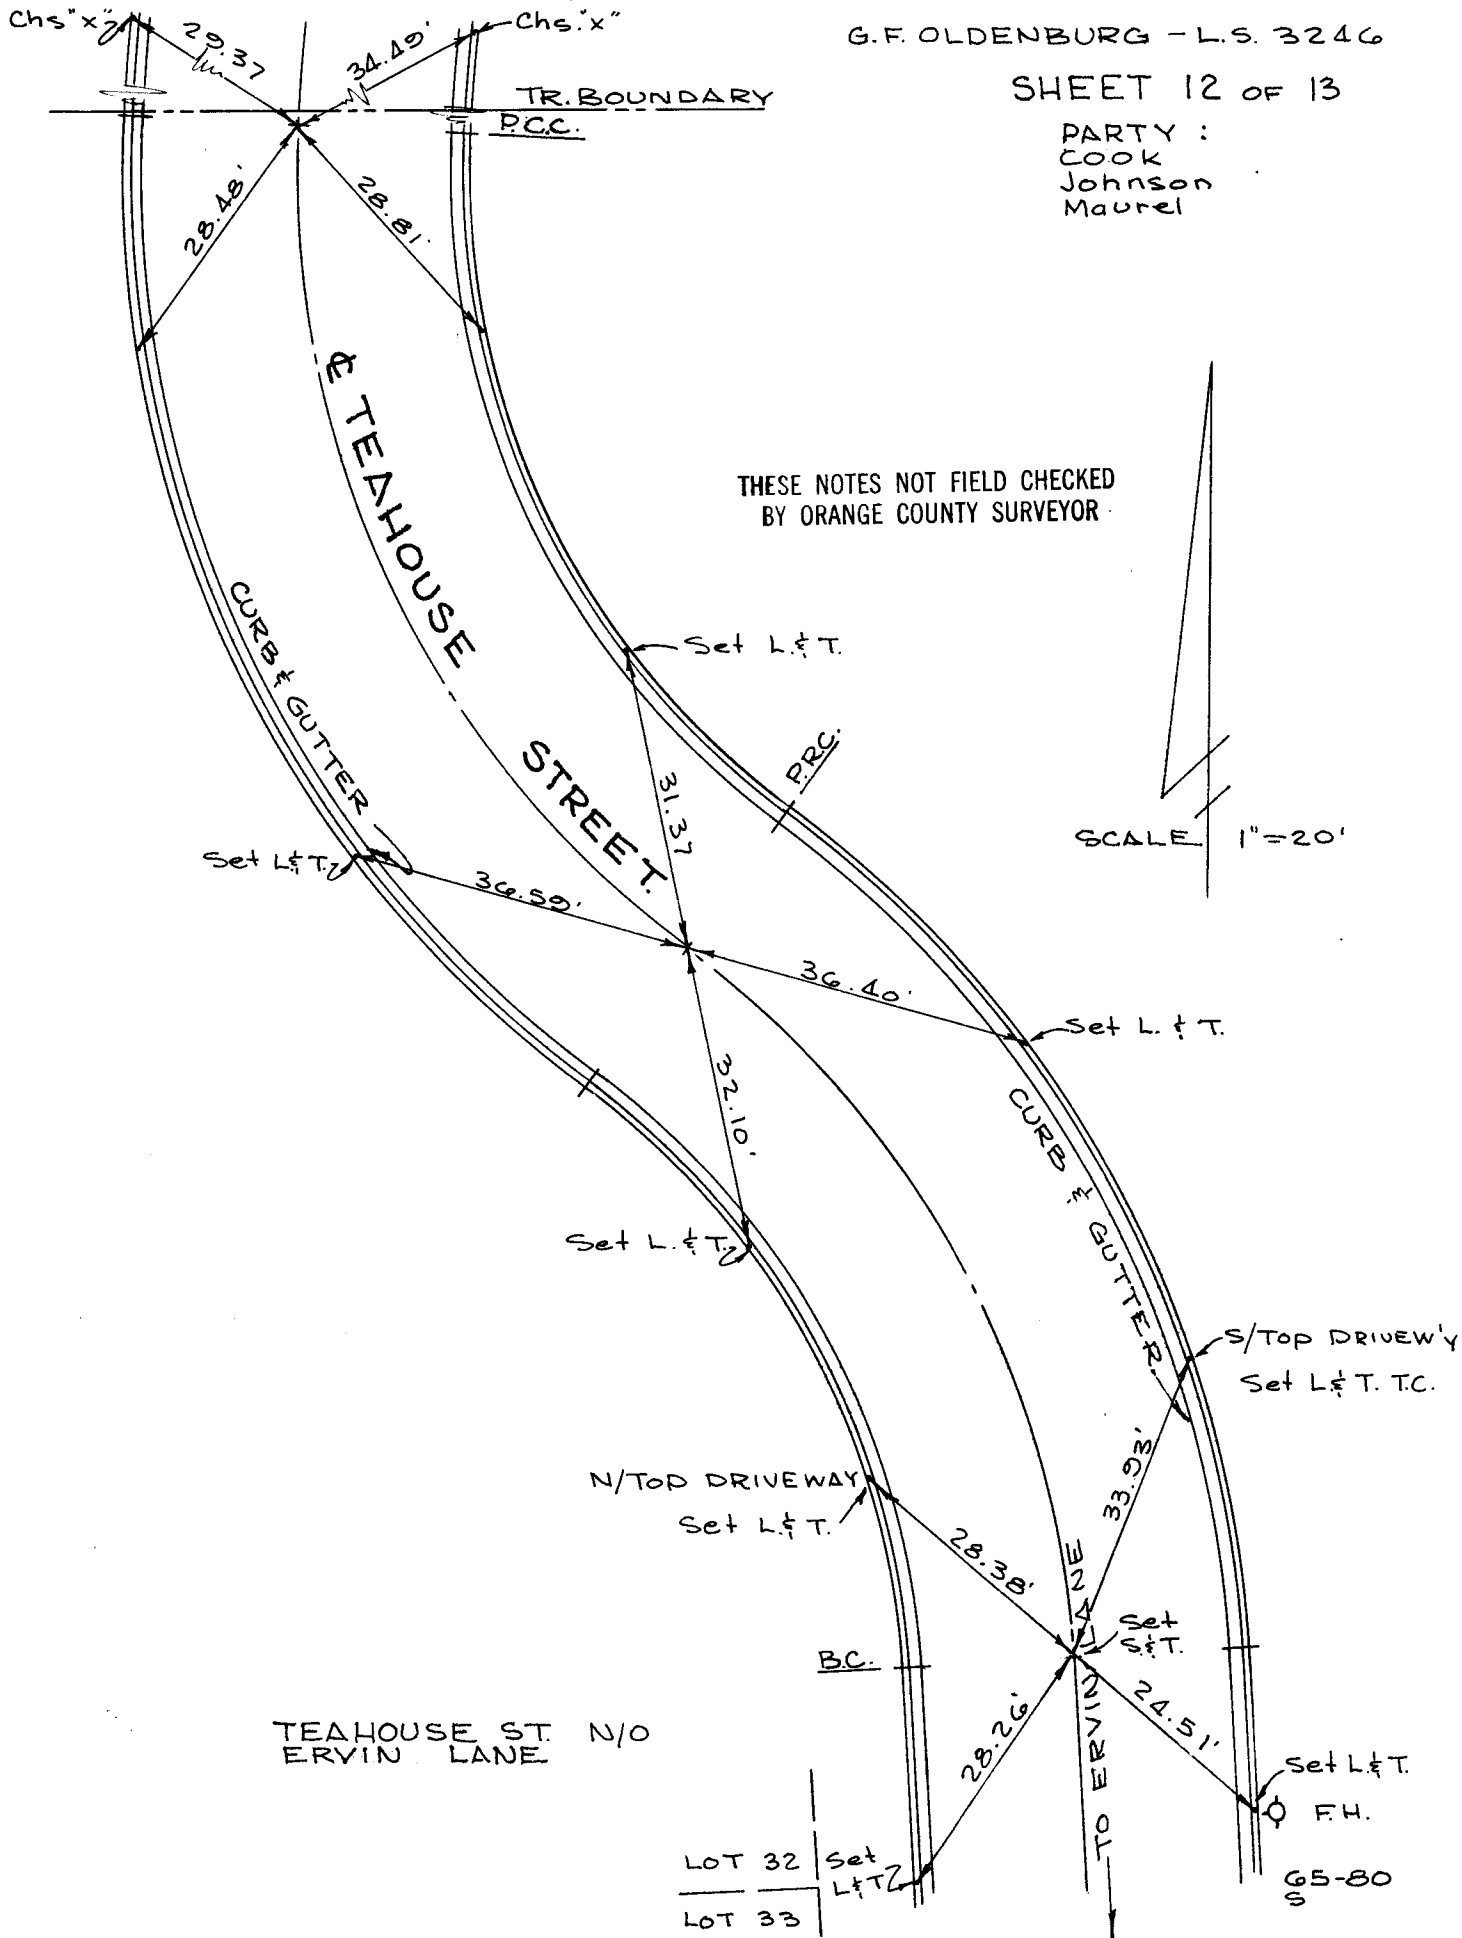

Φ TIES -TRACT 5576

A/5-9

617


WILLIAMSON & SCHMID, C.E.'s

JULY, 1966

G.F. OLDENBURG - L.S. 3246

SHEET 13 OF 13

PARTY:
KING
COOK

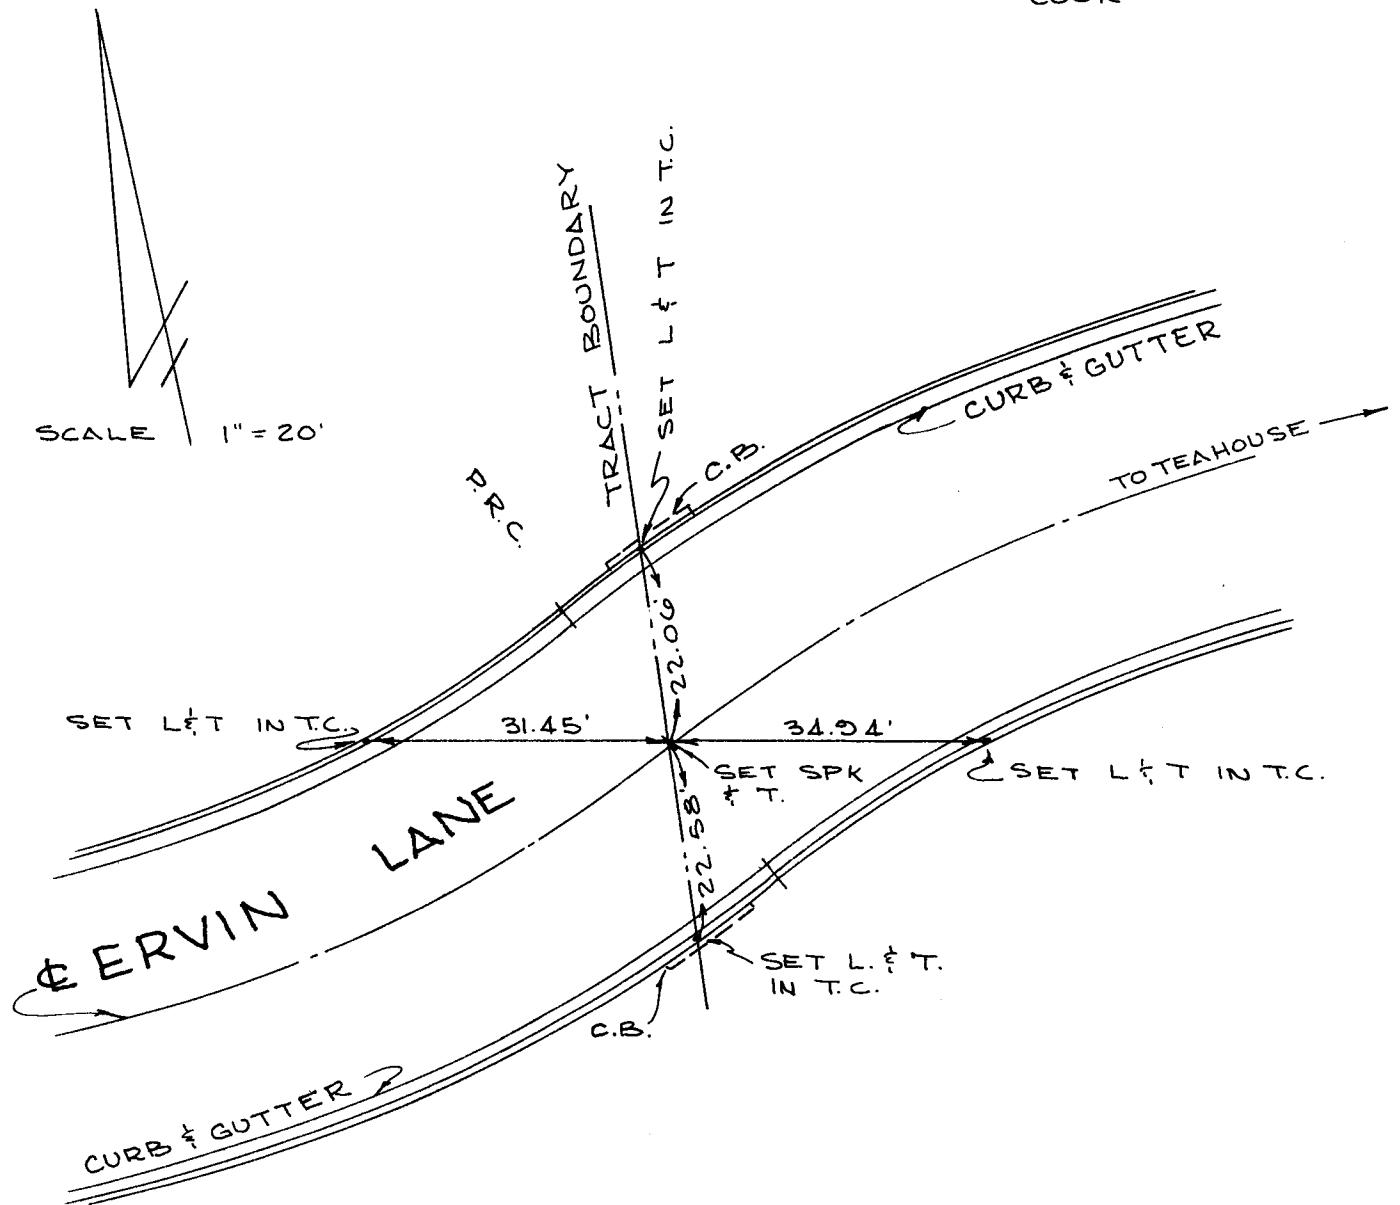

THESE NOTES NOT FIELD CHECKED
BY ORANGE COUNTY SURVEYOR

ERVIN LANE W/O
TEAHOUSE ST.

65-80
S