

CORNER RECORD


BOOK/PAGE 2014-2245B

City of Tustin County of Orange, California

Brief Legal Description Gimbert Lane \pm 130' S of Green Willow Court (Post-Construction)
(Include: Sec., Twp., Rge., and Meridian or Rancho)

CORNER TYPE

COORDINATES (Optional)

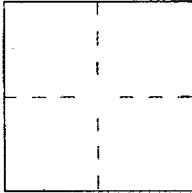

- ☐ Government Corner ☒ Control
☐ Meander ☐ Property
☐ Rancho ☐ Other
☐ Date of Survey 06/09/14

N. _____
E. _____
Zone _____ ☐ NAD27 ☐ NAD83
NAD 83 Epoch _____
Elev. _____
Vert. Datum: ☐ NGVD29 ☐ NAVD88
Meas. Units: ☐ Metric ☐ Imperial

Corner — ☐ Left as found ☐ Found and tagged ☐ Established ☒ Reestablished ☐ Rebuilt

Identification and type of corner found: Evidence used to identify or procedure used to establish or reestablish the corner:
Found and described on the reverse of this sheet


A description of the physical condition of the monument as found and as set or reset: _____
SEE PAGE 2

SURVEYOR'S STATEMENT

This Corner Record was prepared by me or under my direction in conformance with the

Professional Land Surveyor's Act on 1/26, 20 15.

Signed Daniel A. Calvillo L.S. or R.C.E. Number 8294

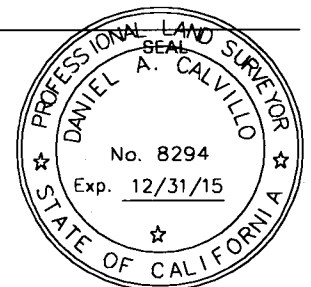

COUNTY SURVEYOR'S STATEMENT

This Corner Record was received NOV 25 2014, and examined

and filed FEB 09 2015, 20 _____.

Signed Craig S. Wehrman, Deputy County Surveyor

L.S. or R.C.E. Number 6131



County Surveyor's Comment _____

- △ SET SPIKE & WASHER STAMPED "LS 8294" IN PLACE OF
PK NAIL PER R1 AFTER CONSTRUCTION
- SET NAIL & TAG STAMPED "LS 8294" AFTER CONSTRUCTION
- FD. NAIL & TAG STAMPED "LS 8294" AFTER CONSTRUCTION
- [] DENOTES RECORD DISTANCES PER R1
- R1 REFERENCE PER CR2014-2223A

N.T.S.

