


Alpine Civil Engineers
Thomas E. Shelton
R.C.E. 12443

10-13-76


THESE NOTES NOT FIELD CHECKED
BY ORANGE COUNTY SURVEYOR

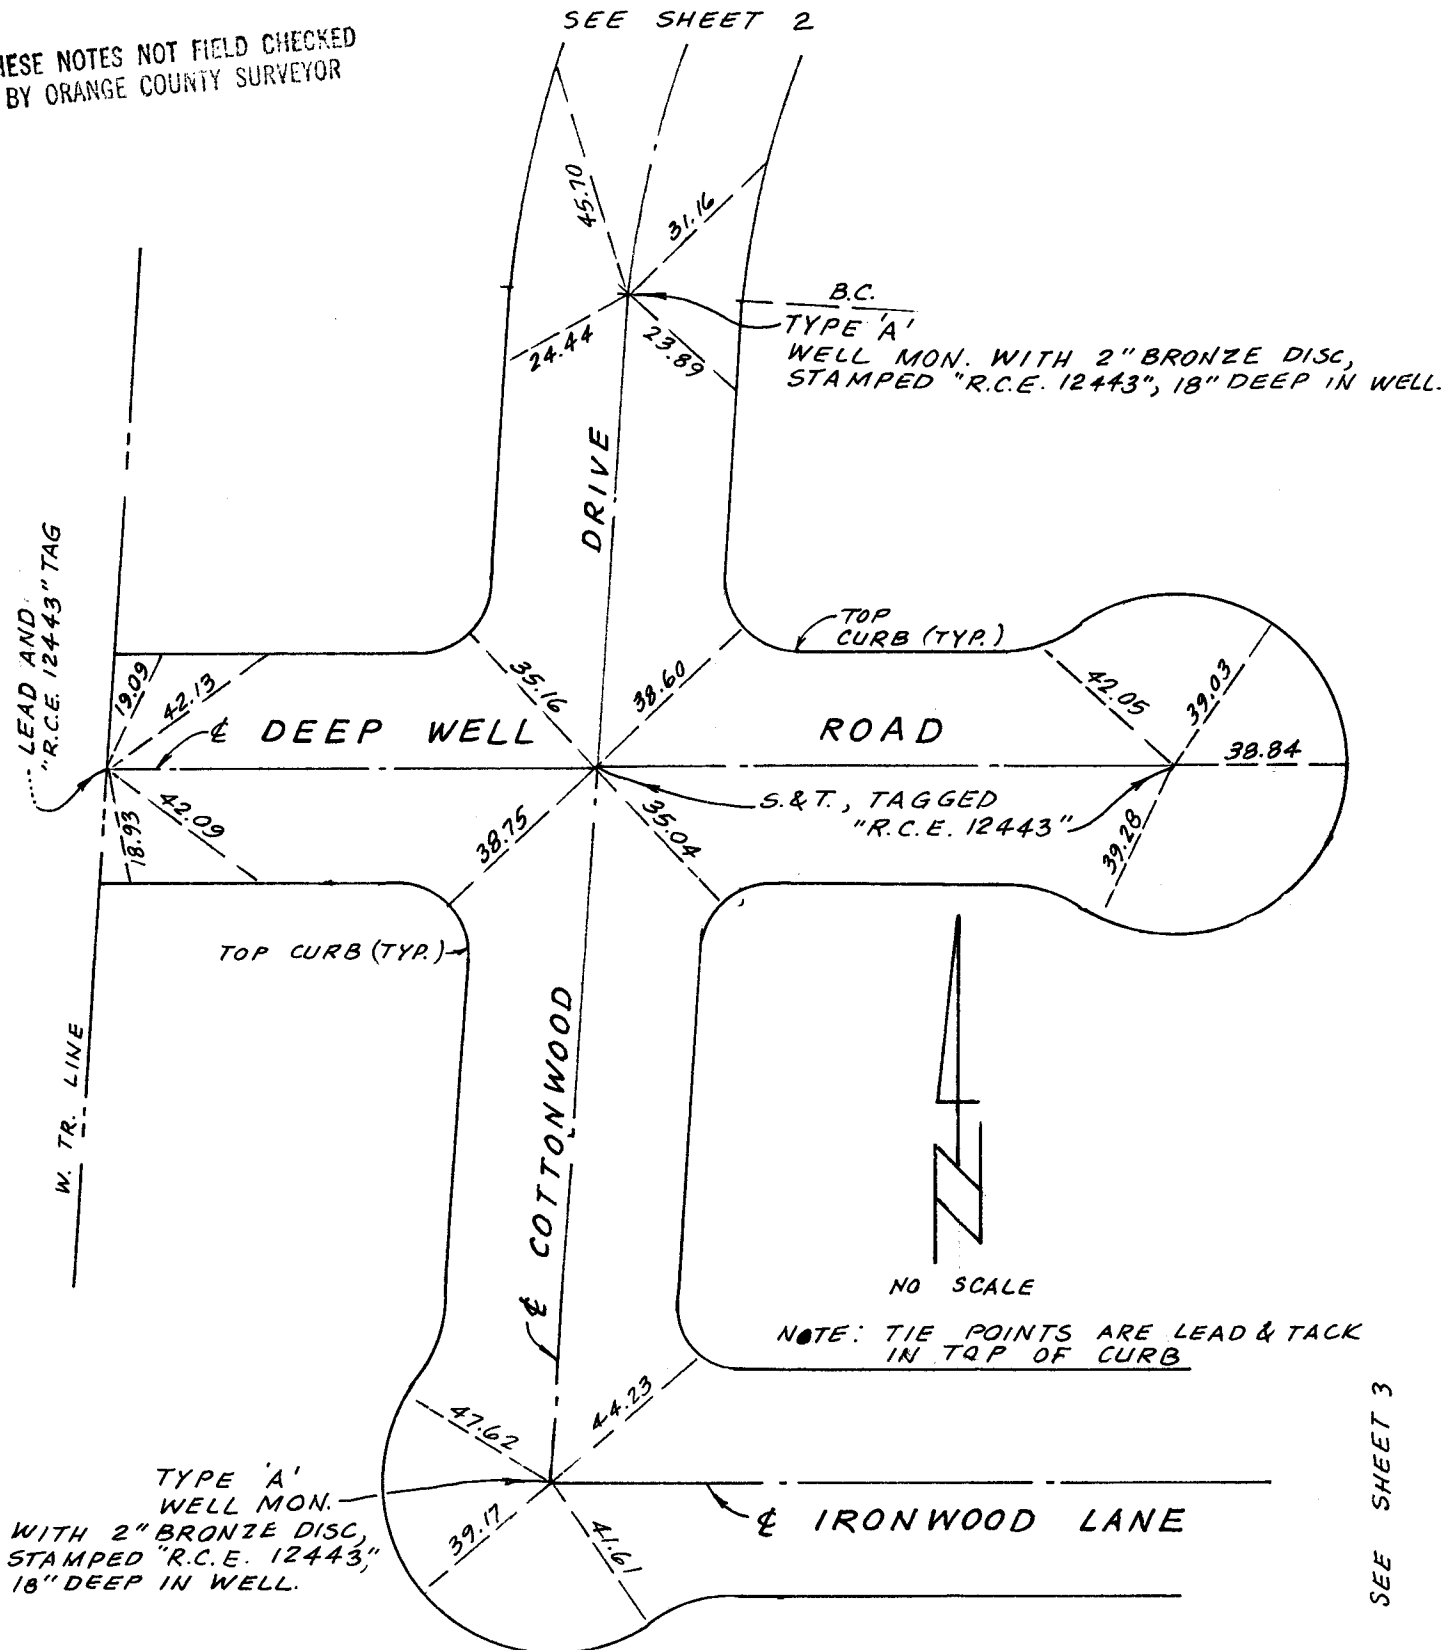

Alpine Civil Engineers
Thomas E. Shelton
R.C.E. 12443

10-13-76

THESE NOTES NOT FIELD CHECKED
BY ORANGE COUNTY SURVEYOR

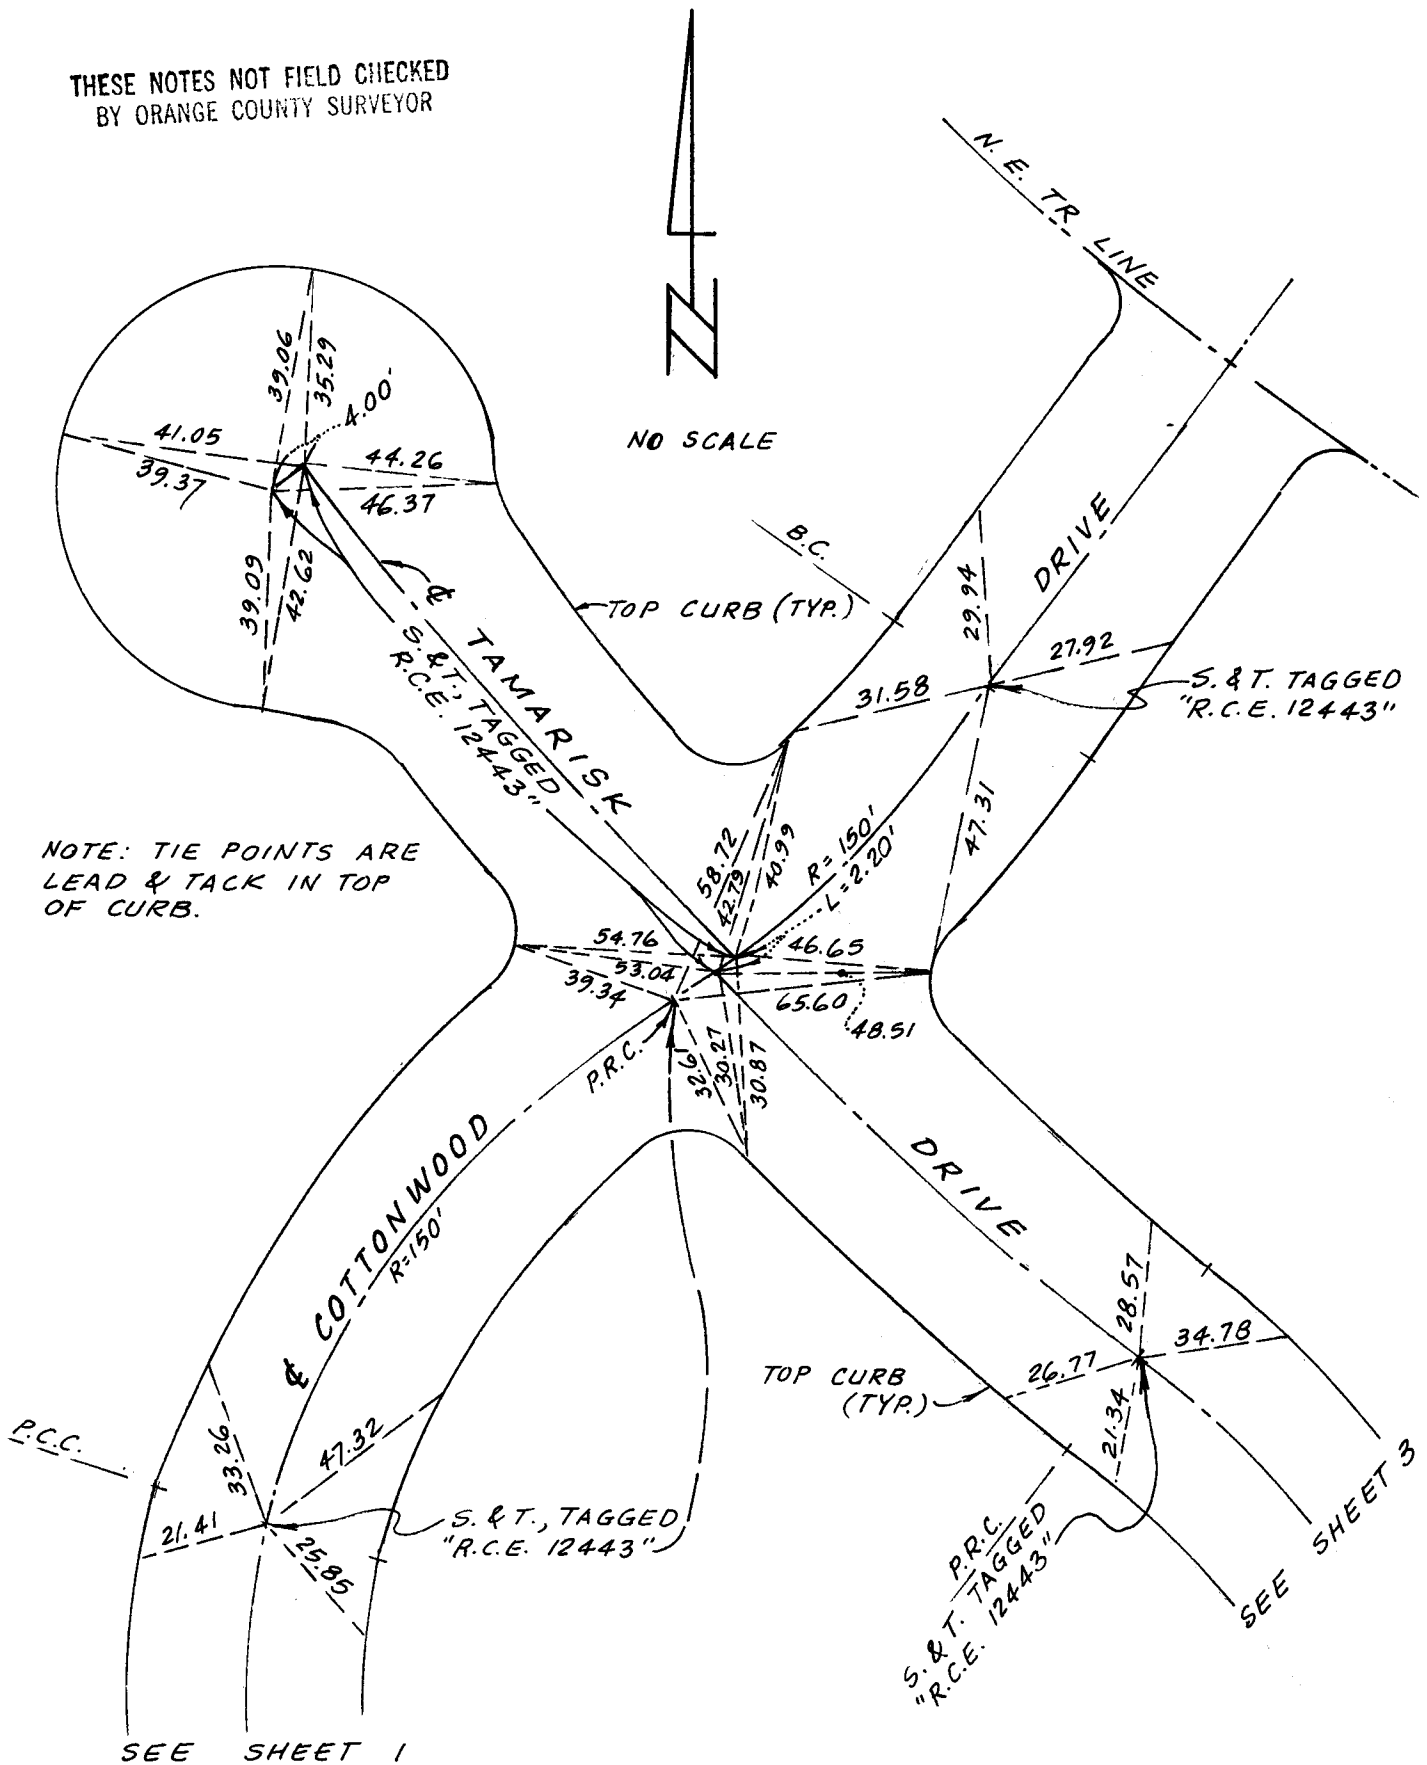

Alpine Civil Engineers
Thomas E. Shelton
R.C.E. 12443

10-13-77

THESE NOTES NOT FIELD CHECKED
BY ORANGE COUNTY SURVEYOR



NO SCALE

NOTE: TIE POINTS ARE
LEAD & TACK IN TOP
OF CURB.

SEE SHEET 1

