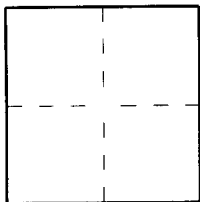


# CORNER RECORD

Document Number 2010-1614 ACity of Unincorporated area County of Orange, CaliforniaBrief Legal Description Intersection of Newport Ave. and Foothill Blvd. GPS 6009

## CORNER TYPE

Government Corner ☐ Control ☐  
Meander ☐ Property ☐  
Rancho ☐ Other ☒


Date of Survey 2/2010

## COORDINATES (Optional)

N. \_\_\_\_\_  
E. \_\_\_\_\_  
Zone \_\_\_\_\_ NAD27 ☐ NAD83 ☐  
NAD83 Epoch \_\_\_\_\_  
Elev. \_\_\_\_\_  
Vert. Datum: NGVD29 ☐ NAVD88 ☐  
Meas. Units: Metric ☐ Imperial ☐  
U.S. Survey foot ☒

Corner — Left as found ☒ Found and tagged ☐ Established ☐ Reestablished ☐ Rebuilt ☐Identification and type of corner found; Evidence used to identify or procedure used to establish or reestablish the corner.  
Centerline monuments along Newports Ave.A description of the physical condition of the monument as found and as set or reset: \_\_\_\_\_  
Found monuments as shown on page two.

## SURVEYOR'S STATEMENT

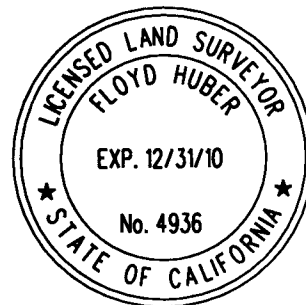This Corner Record was prepared by me or under my direction in conformance with  
the Land Surveyor's Act on JUNE 15, 2010Signed JM W. LS L.S. or R.C.E. No. 4936

## COUNTY SURVEYOR'S STATEMENT

This Corner Record was received JUN 16 2010  
and examined and filed JUL 20 2010Signed [Signature] L.S. or R.C.E. No. 7212Title DEPUTY COUNTY SURVEYOR

County Surveyor's Comment \_\_\_\_\_

These ties are for perpetuating the found monuments. No claim is made as to  
the relationship of the points or lines shown hereon to true boundary locations.

