

ORANGE COUNTY SURVEYOR SURVEY NOTES

A/4-9 1538

ALIGNMENT INDEX BOOK AND PAGE

ALIGNMENT NOTES PG. ____ OF ____

PPB ____ WORK ORDER NUMBER R 20292434

SURVEY NOTES PAGE 1 OF 15

SURVEY COMPLETION DATE 6-30-86

SURVEY FILE NUMBER R86-20

PROJECT NAME TIES, RESURFACING AREA "A2"

SURVEY LIMITS SEE LOCATION MAP - PAGE 2.

PURPOSE OF SURVEY TO TIE OUT SURFACE CONTROL POINTS
PRIOR TO RESURFACING.

THOMAS BROS.:

BLOCK AND MODULES:

<u>PAGE 18</u>	<u>(5953-54,64,74,84,94)(6053-04,14,24)</u>
	<u>(5852-39)</u>
	<u>(5852-67,68,69)(5853-60,50)</u>

SURVEY NOTE PAGE INDEX:

EQUIPMENT:

PERSONNEL:

TITLE	1 OF 15	TOPCON ET-1	MINICH SANDEFER
MAP	2 OF 15	100' STEEL CHAIN	RAYMOND WADE
INDEX	3 OF 15		SCHUH VAN DYCK
TIE NOTES	4 TO 15		MCCONLEE KLINGENBERG
			ESTEP ANDREW

REFERENCES:

DEPUTY COUNTY SURVEYOR'S NOTE:

The purpose of these notes is to show the relationship of the points and/or lines shown hereon to either lines of record, control lines, or to each other. The Deputy County Surveyor does not claim at this time, that the points or lines shown hereon are true centerline, boundary, deed, or control points or lines. Without further analysis, the interpretation of these notes is left to the discretion of the user.

John Canas

Deputy County Surveyor

By:




Louie Toomey
Supervising Land Surveyor

REMARKS: RESET SURFACE CONTROL POINTS AFTER
RESURFACING - 11-24-87, 11-25-87
(SEHER & PTY.)

MINICH

DATE 6-30-86

ORANGE COUNTY SURVEYOR

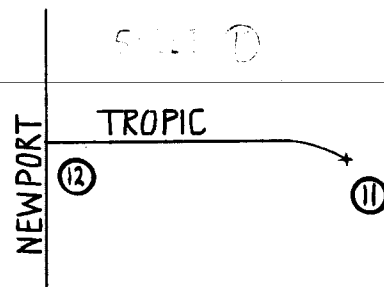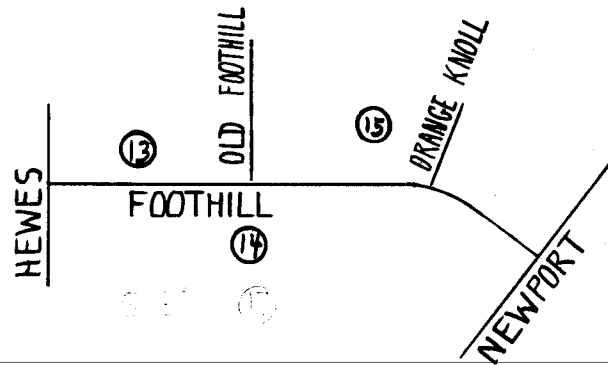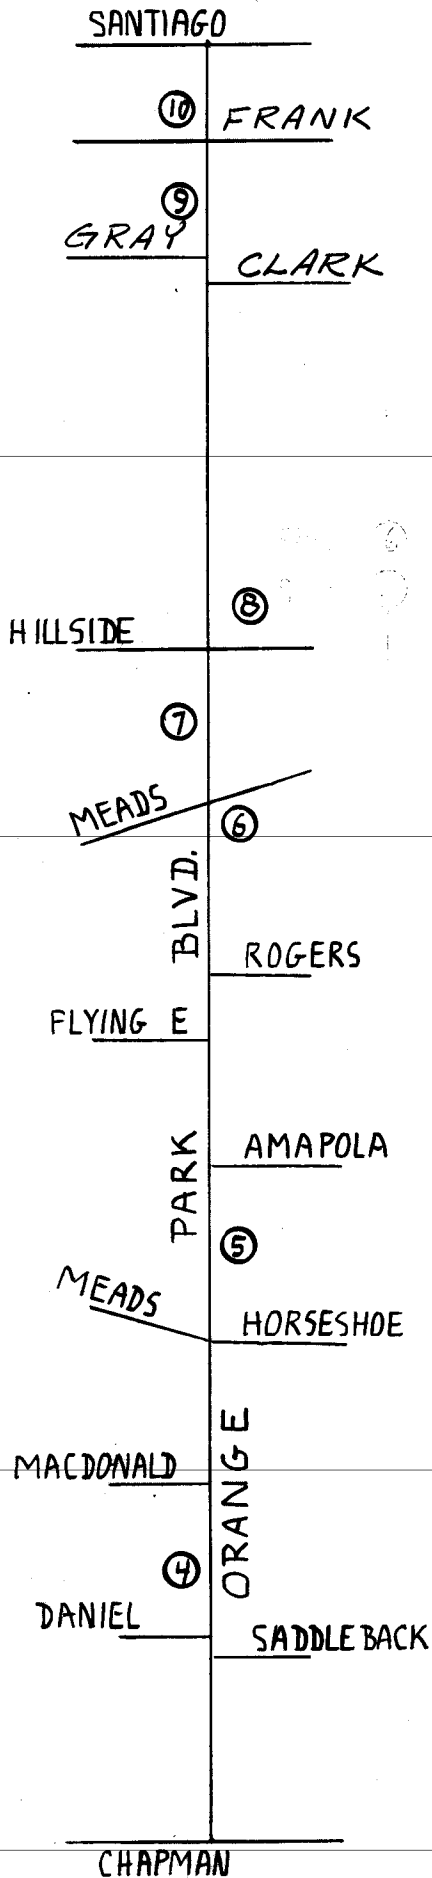

"O" = SHEET N2



See Deputy County Surveyor's Note on page 1

STREET LOCATION	PLAN SHEET	PAGE
ORANGE PARK BLVB & SADDLEBACK	5	4
" & DANIEL	5	4
" & MAC DONALD	5	4
" & MEADS S'LY	5	5
" & AMADOLA	5	5
" & MEADS N'LY	5	6
" @ B.C.	5	6
" @ E.C.	5	6
" @ P.O.L.	5	7
" @ B.C.	5	7
" @ E.C.	5	7
" & HILLSIDE	5	8
" @ B.C.	6	8
" & GRAY	6	9
" & FRANK	6	10
TROPIC @ E.C.	18	11
" @ P.R.C.	18	12
" @ B.C.	18	12
FOOTHILL BLVD. @ P.I.	17	13
" @ P.I.	17	13
" & OLD FOOTHILL	17	14
" @ B.C.	17	14
" @ TRACT 5745	17	15
" @ ORANGE KNOLL	17	15

SURVEYED BY MINICH

DATE 6.20.86



ORANGE COUNTY SURVEYOR

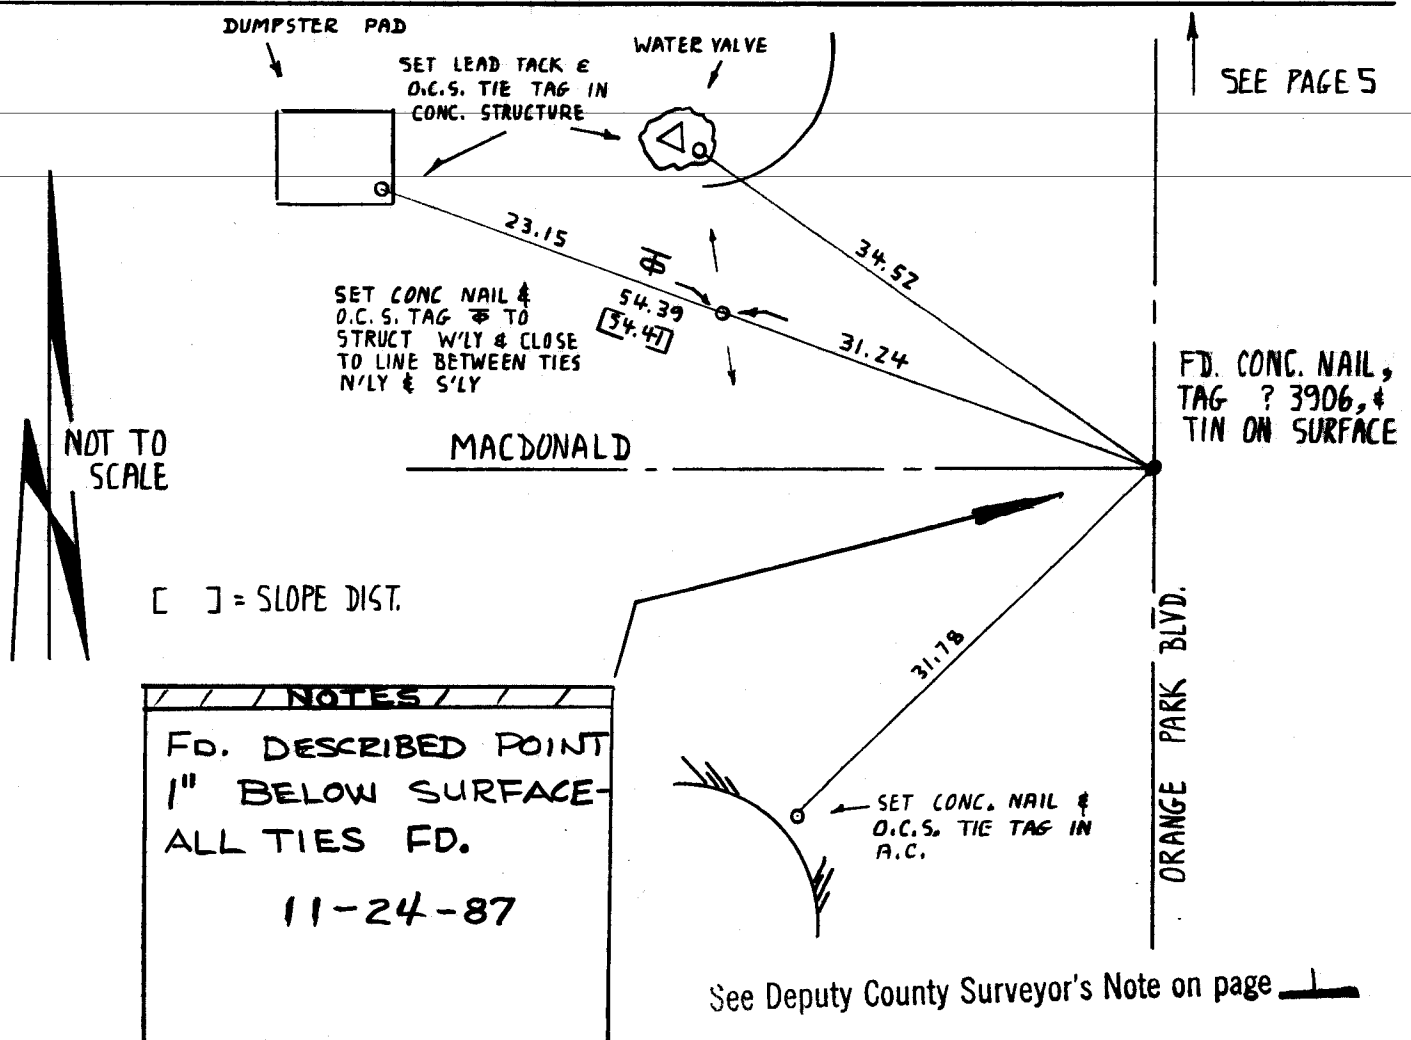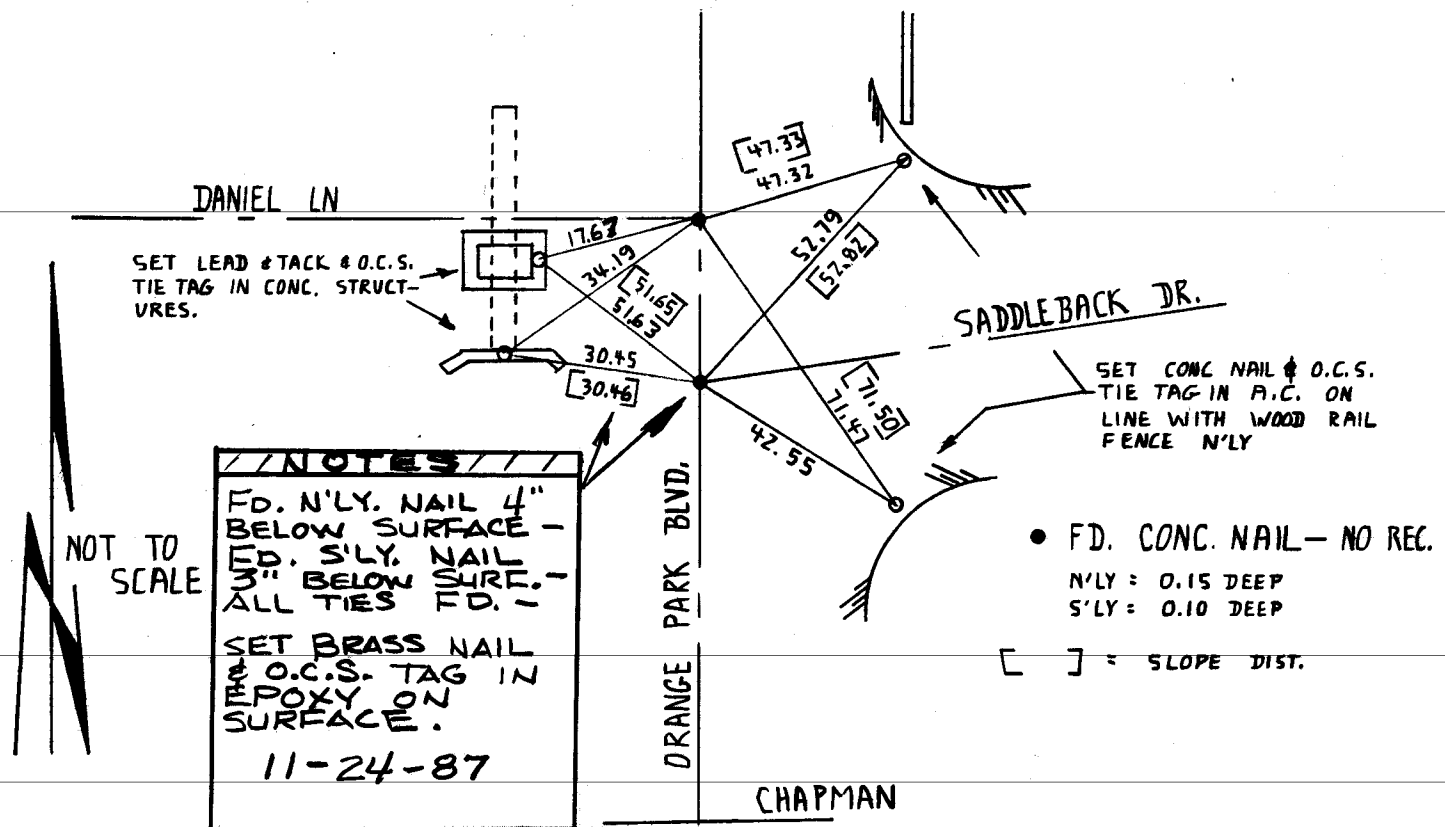

SURVEYED BY MINICH

DATE 6.20.86

ORANGE COUNTY SURVEYOR

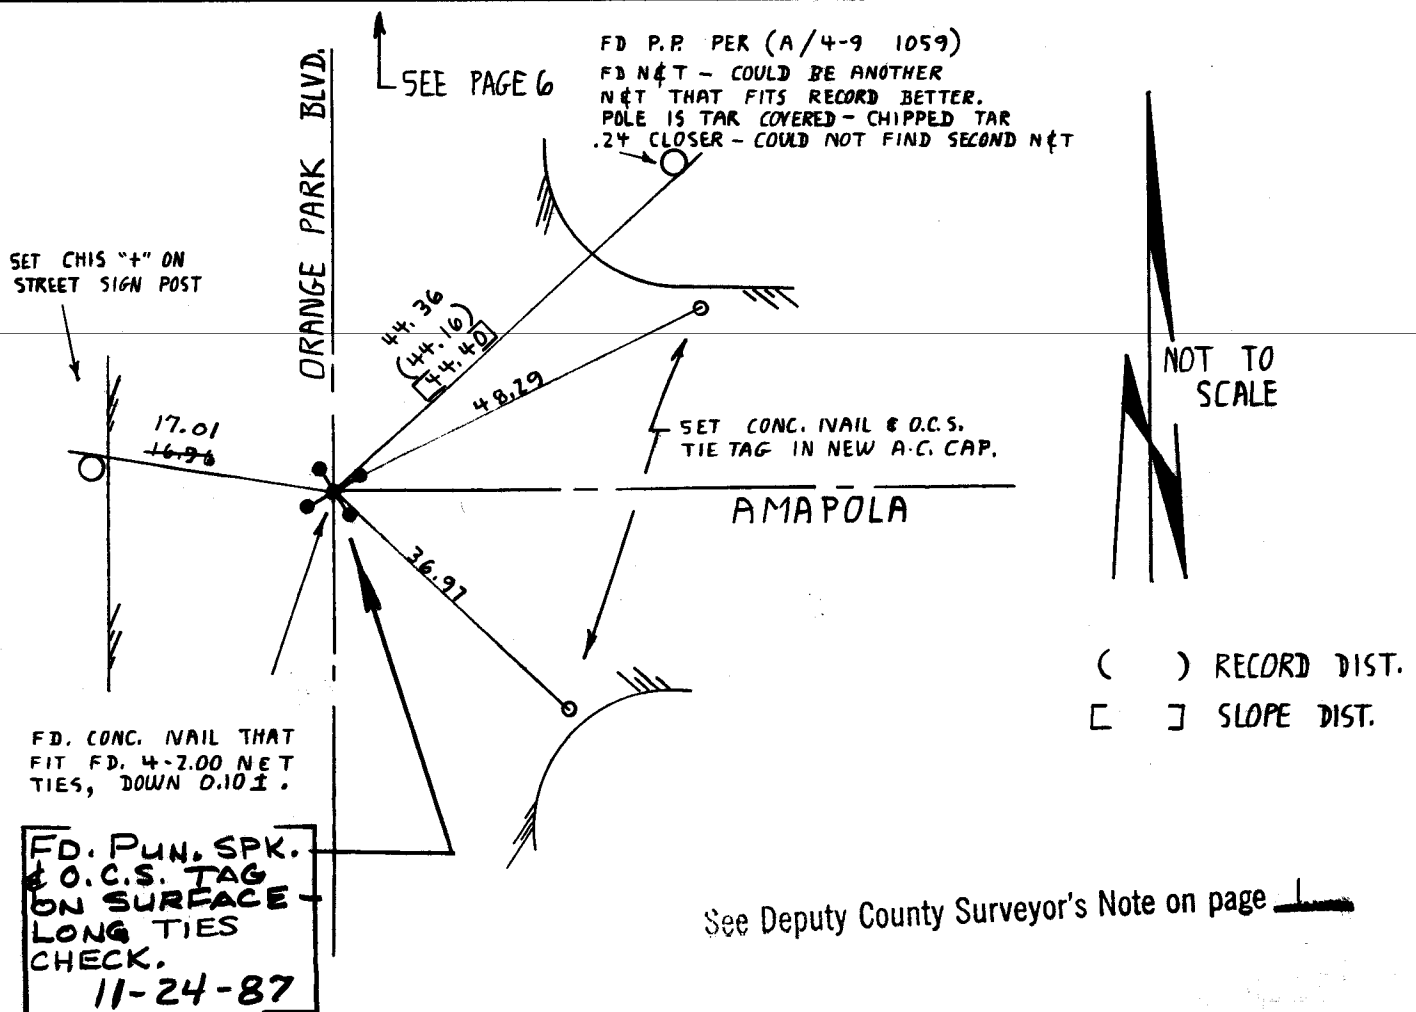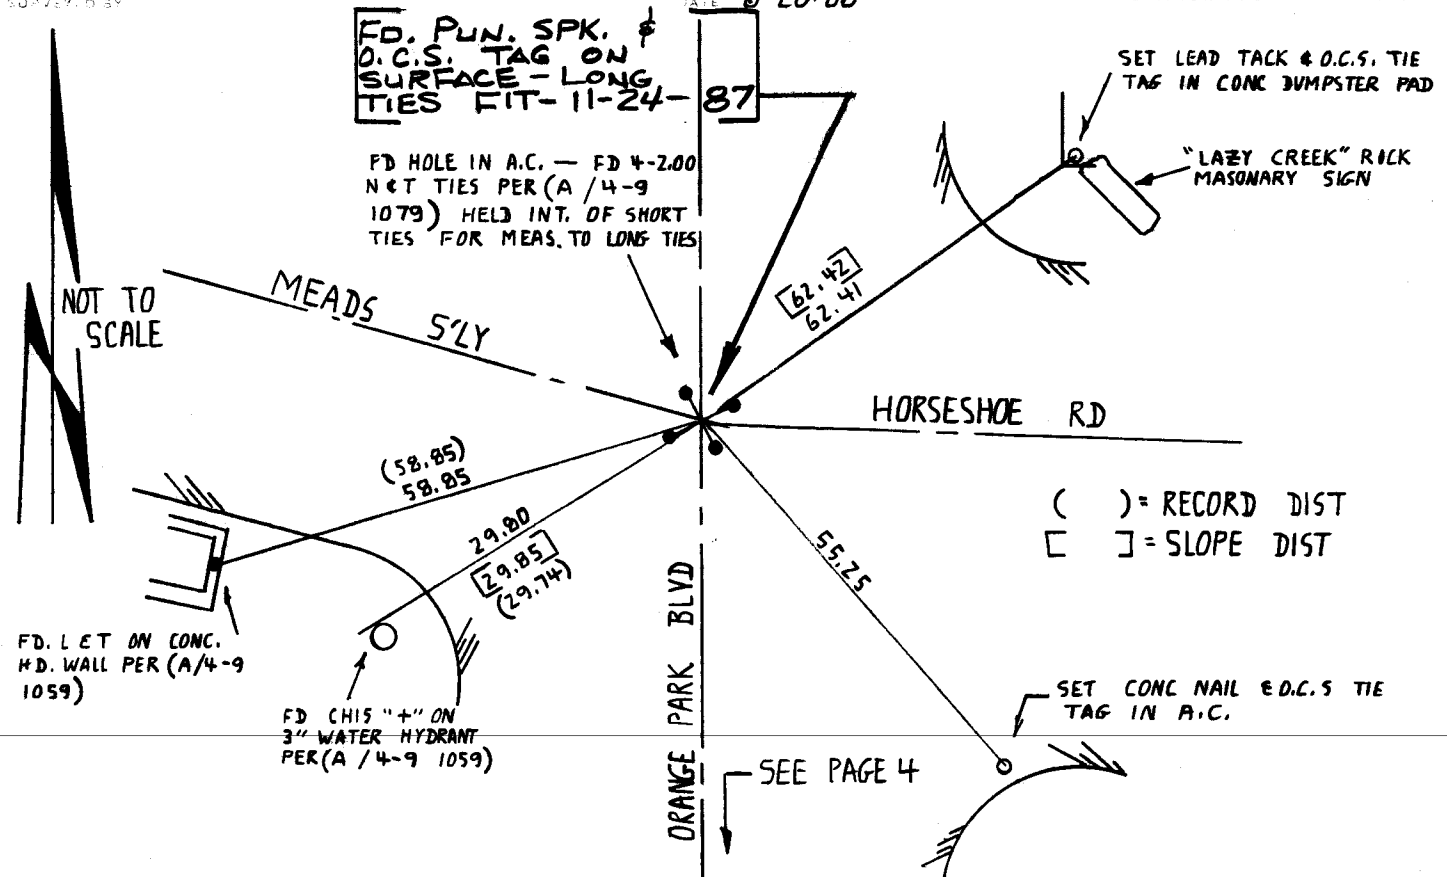

See Deputy County Surveyor's Note on page 1

MINICH

6-20-86

ORANGE COUNTY SURVEYOR

FD N&T ON PP# 432609E
PER (A/4-9 1060)FD N&T ON P.P.# 542856E
PER (A/4-9 1060)FD CONC NAIL WITH 4-2.00
N&T TIES PER (A/4-9
1060)() REC. DIST
[] SLOPE DIST.NOT TO
SCALEFD. CENTER OF WATER
VALVE INSIDE OF STAND PIPE
PER (A/4-9 708)FD. PUN. SPK. &
O.C.S. TAG ON
SURFACE - LONG
TIES CHECK
11-24-87

SEE PAGE 5

SET LEAD TACK & O.C.S.
TIE TAG IN CONC OF
WATER VALVE

MEADS N'LY

ORANGE PARK BLVD.

IDENTICAL

SET N&T IN
MAIL BOX POST
5 MAIL
BOXES
MB#10671SET N&T IN PP;
NO NUMBER.A.C. DRIVE
10712SET CONC NAIL & O.C.S.
TIE TAG IN A.C. DRIVESET CHIS "4" IN FENCE
POST OF CHAIN LINK
FENCING.DUG 3" - NOTHING FD;
NOTHING SET - LONG
TIES DO NOT
INTERSECT
11-25-87MEADS
N'LY

SET N&T IN PP 2243050E

SEE PAGE 7

FD. N&T. 1 1/2"
BELOW SURFACE -
SET PUN. SPK. &
O.C.S. TAG ON
SURFACE - ALL
LONG TIES FD.
11-25-87

[] SLOPE DIST.

NOT TO
SCALEP.I. IN DIRT
SHOULDERA.C. DRIVE
10751FD PK NAIL
B.C. NO REF

MINICH

6.20.86

ORANGE COUNTY SURVEYOR

SEE PAGE 8

SET N & T IN P.P.

SET 5/8" RE BAR &
PLASTIC O.C.S. CAP

30.44

FD PUN. CUT SPK & TAG & WASHER,
CAN NOT READ TAG # 432316E
E.C.FD. 1/4" BELOW
SURFACE - FD.
LONG TIES
11-25-87

[] = SLOPE DIST.

NOT TO
SCALE

PI IN A.C. DRIVE

SET LEAD, TACK,
& O.C.S. TAG IN
CONC OF WATER
VALVEFD PK NAIL &
RCE 19593 TAG
B.C.SET PUN. SPK. & O.C.S.
TAG ON SURFACE - LONG
TIES CHECK 11-25-87SET CHIS "+"
ON MAIL BOX
POST #10690SET CONC NAIL &
O.C.S. TIE TAG IN
A.C. DRIVE.SET N & T IN PP #
202888EA.C. DRIVE
#10671SET CONC NAIL
& O.C.S. TIE TAG IN
A.C. DRIVEPD PK NAIL &
RCE 19593 TAGSET PUN. SPK. & O.C.S.
TAG ON SURFACE -
LONG TIES CHECK
11-25-87SET CHIS "+" IN CHAIN
LINK FENCE POST
#10692.

5 MAIL BOXES


SET N & T IN MAIL BOX POST


SEE PAGE 6

MEADS


N'LY

See Deputy County Surveyor's Note on page 1

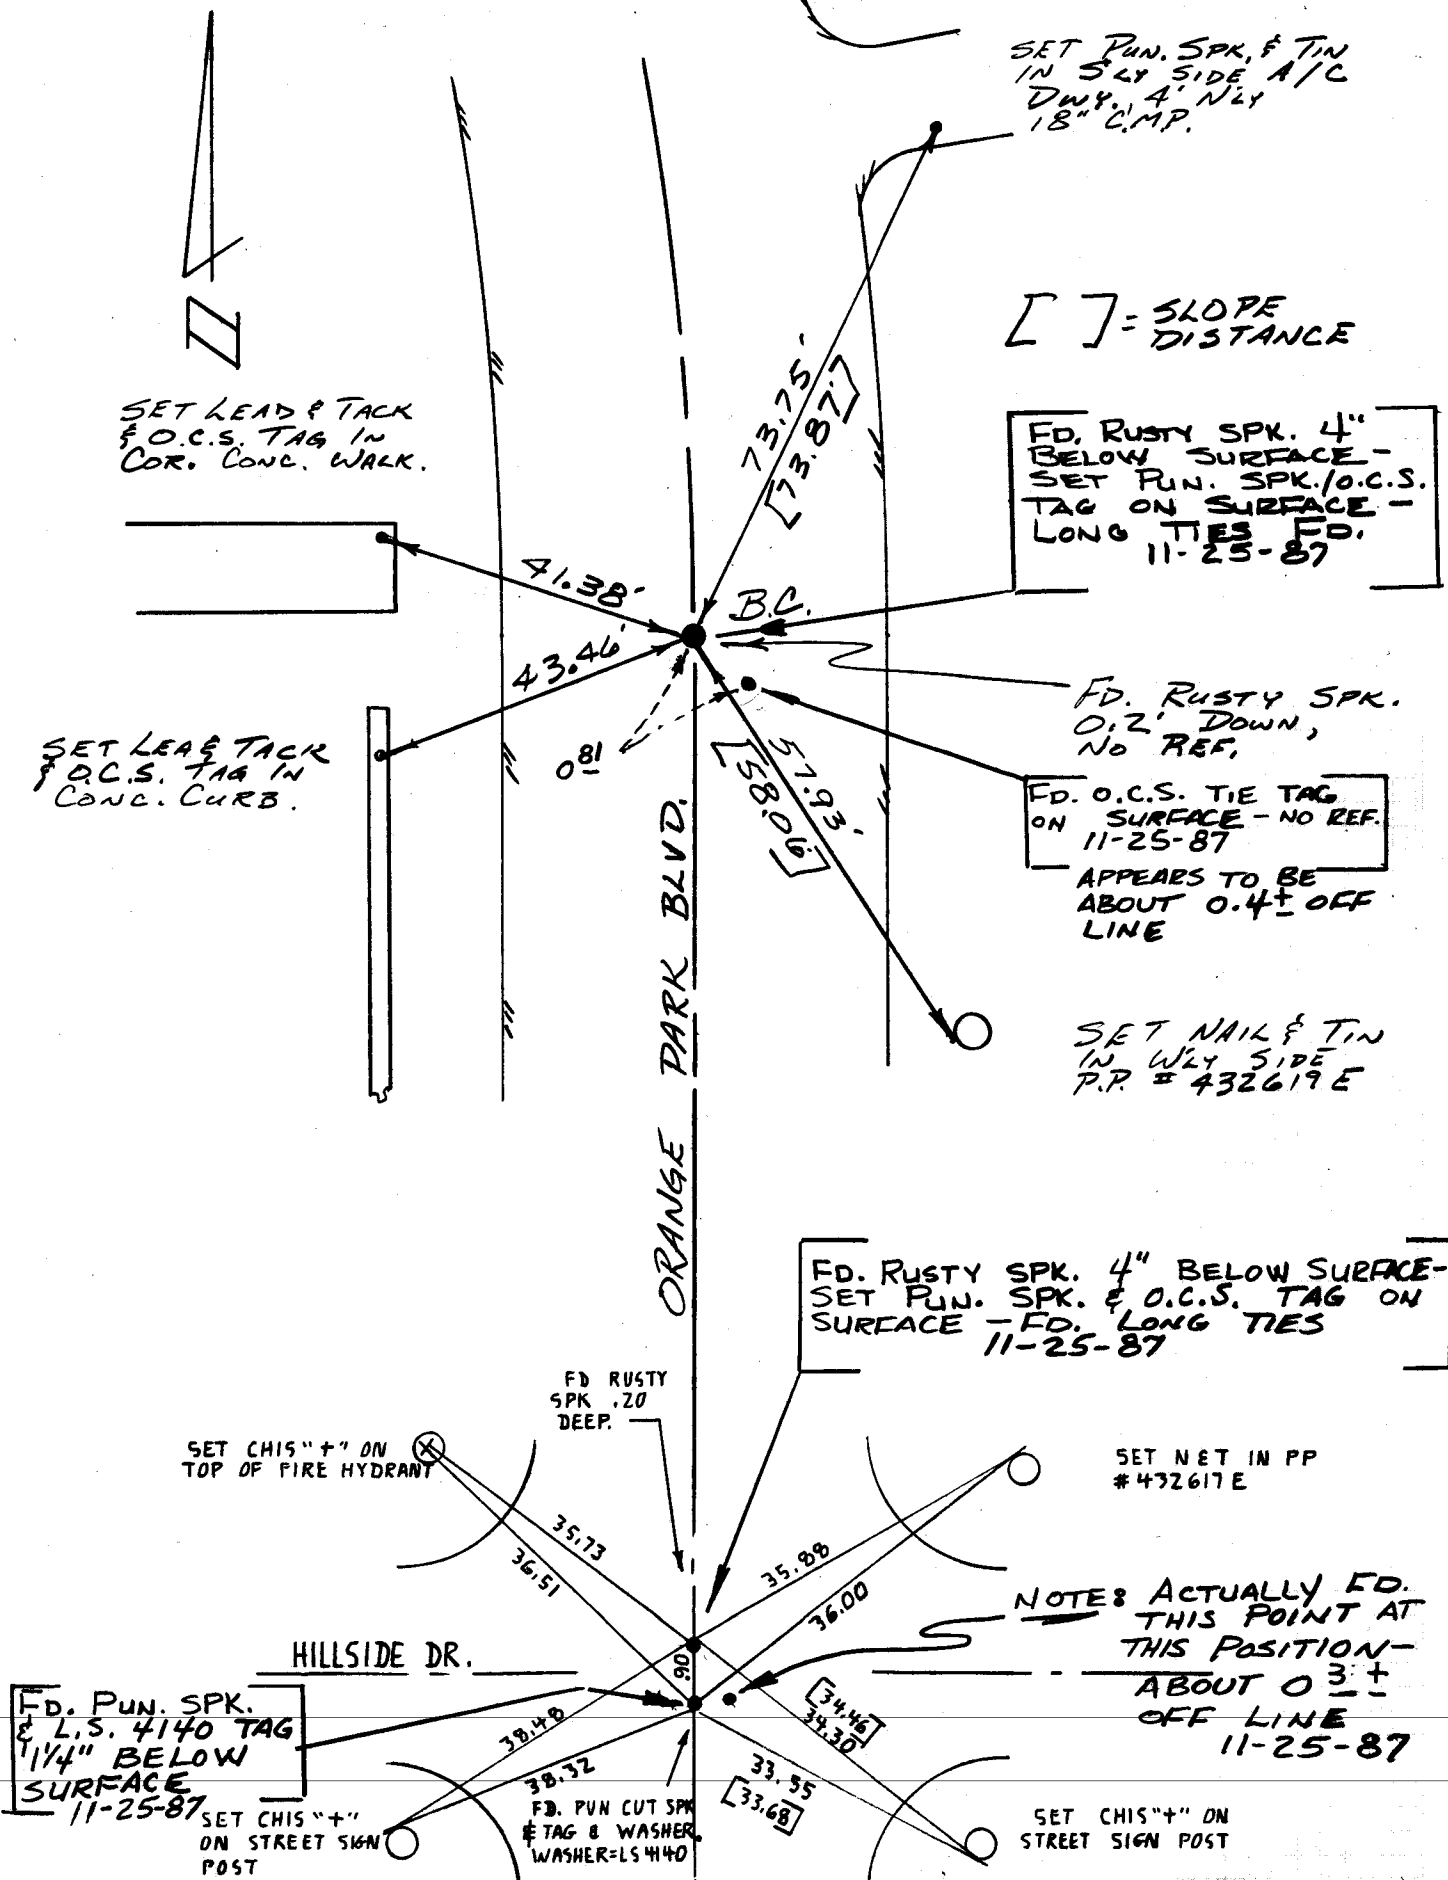

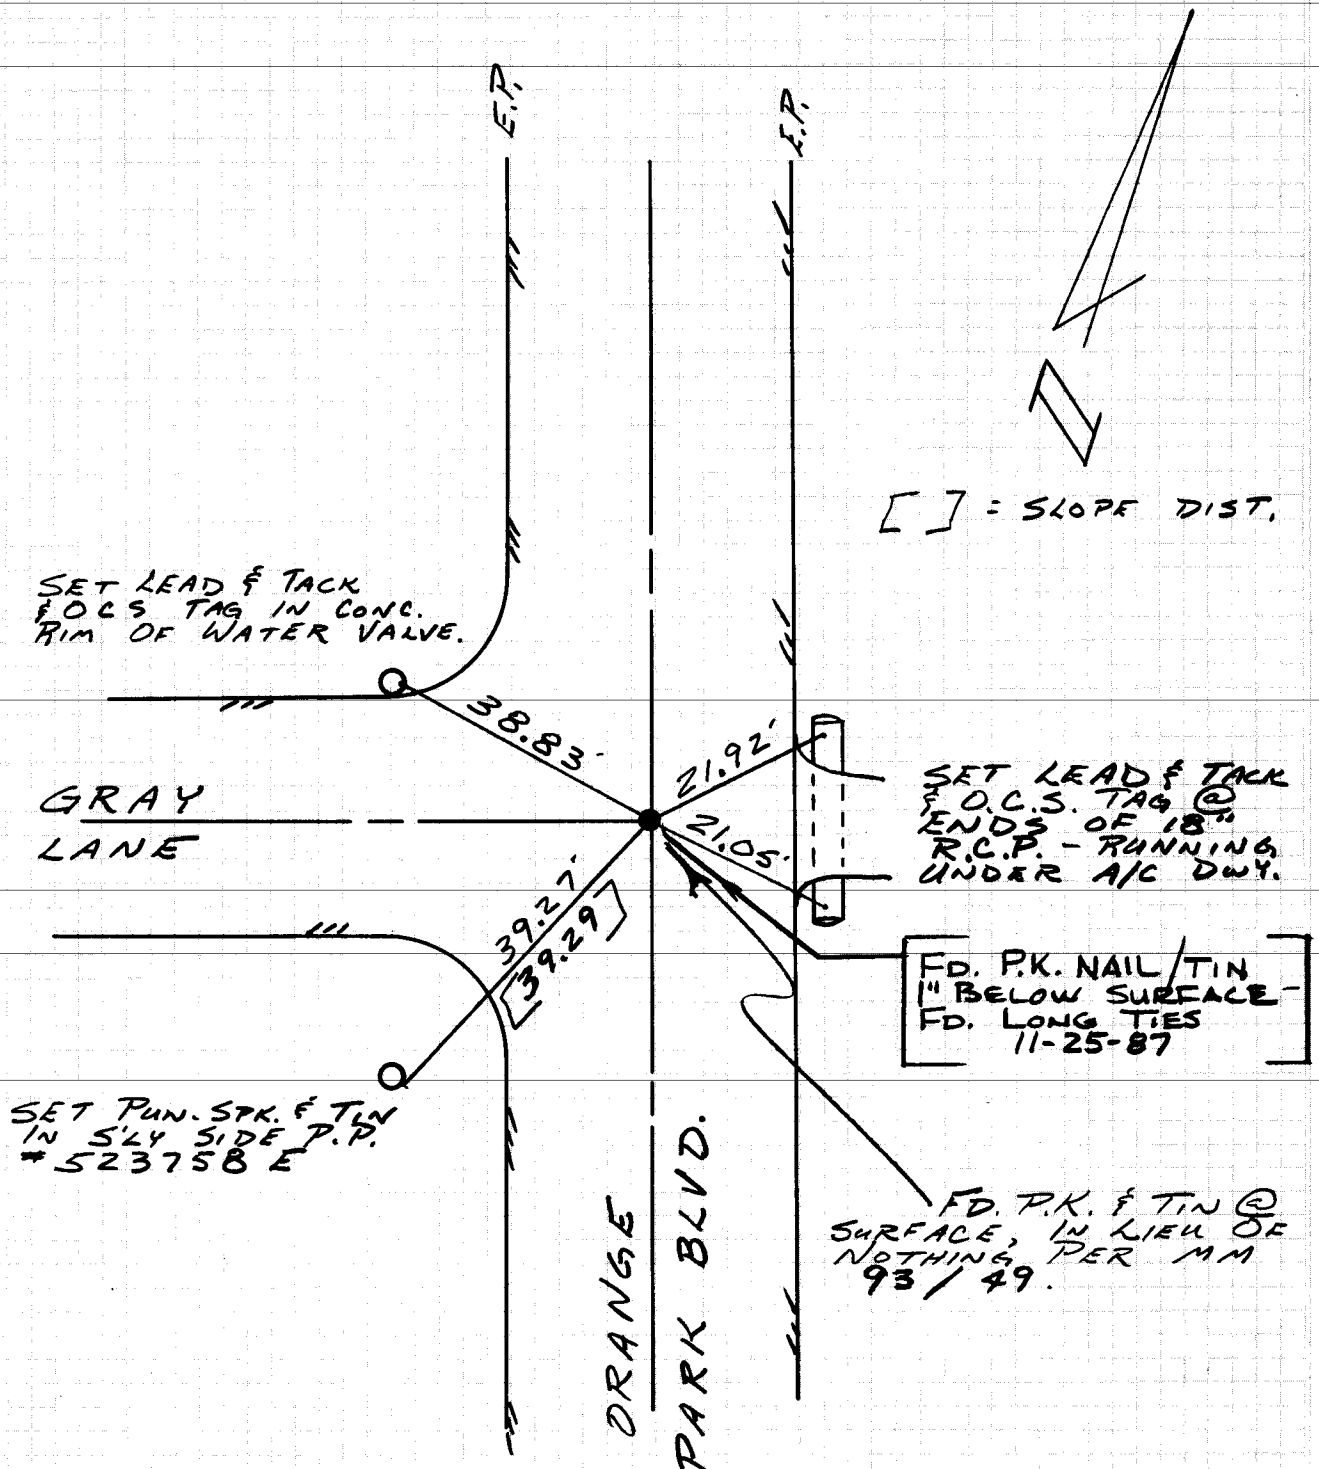


THE TIES SHOWN HEREON ARE FOR THE PURPOSE OF PERPETUATING THE MONUMENTATION CURRENTLY EXISTING. NO ATTEMPT WAS MADE TO DETERMINE THE VALIDITY OF THE MONUMENTS OR THEIR PROPER LOCATION IN RELATION TO LEGAL BOUNDARY LINES IN THE AREA.

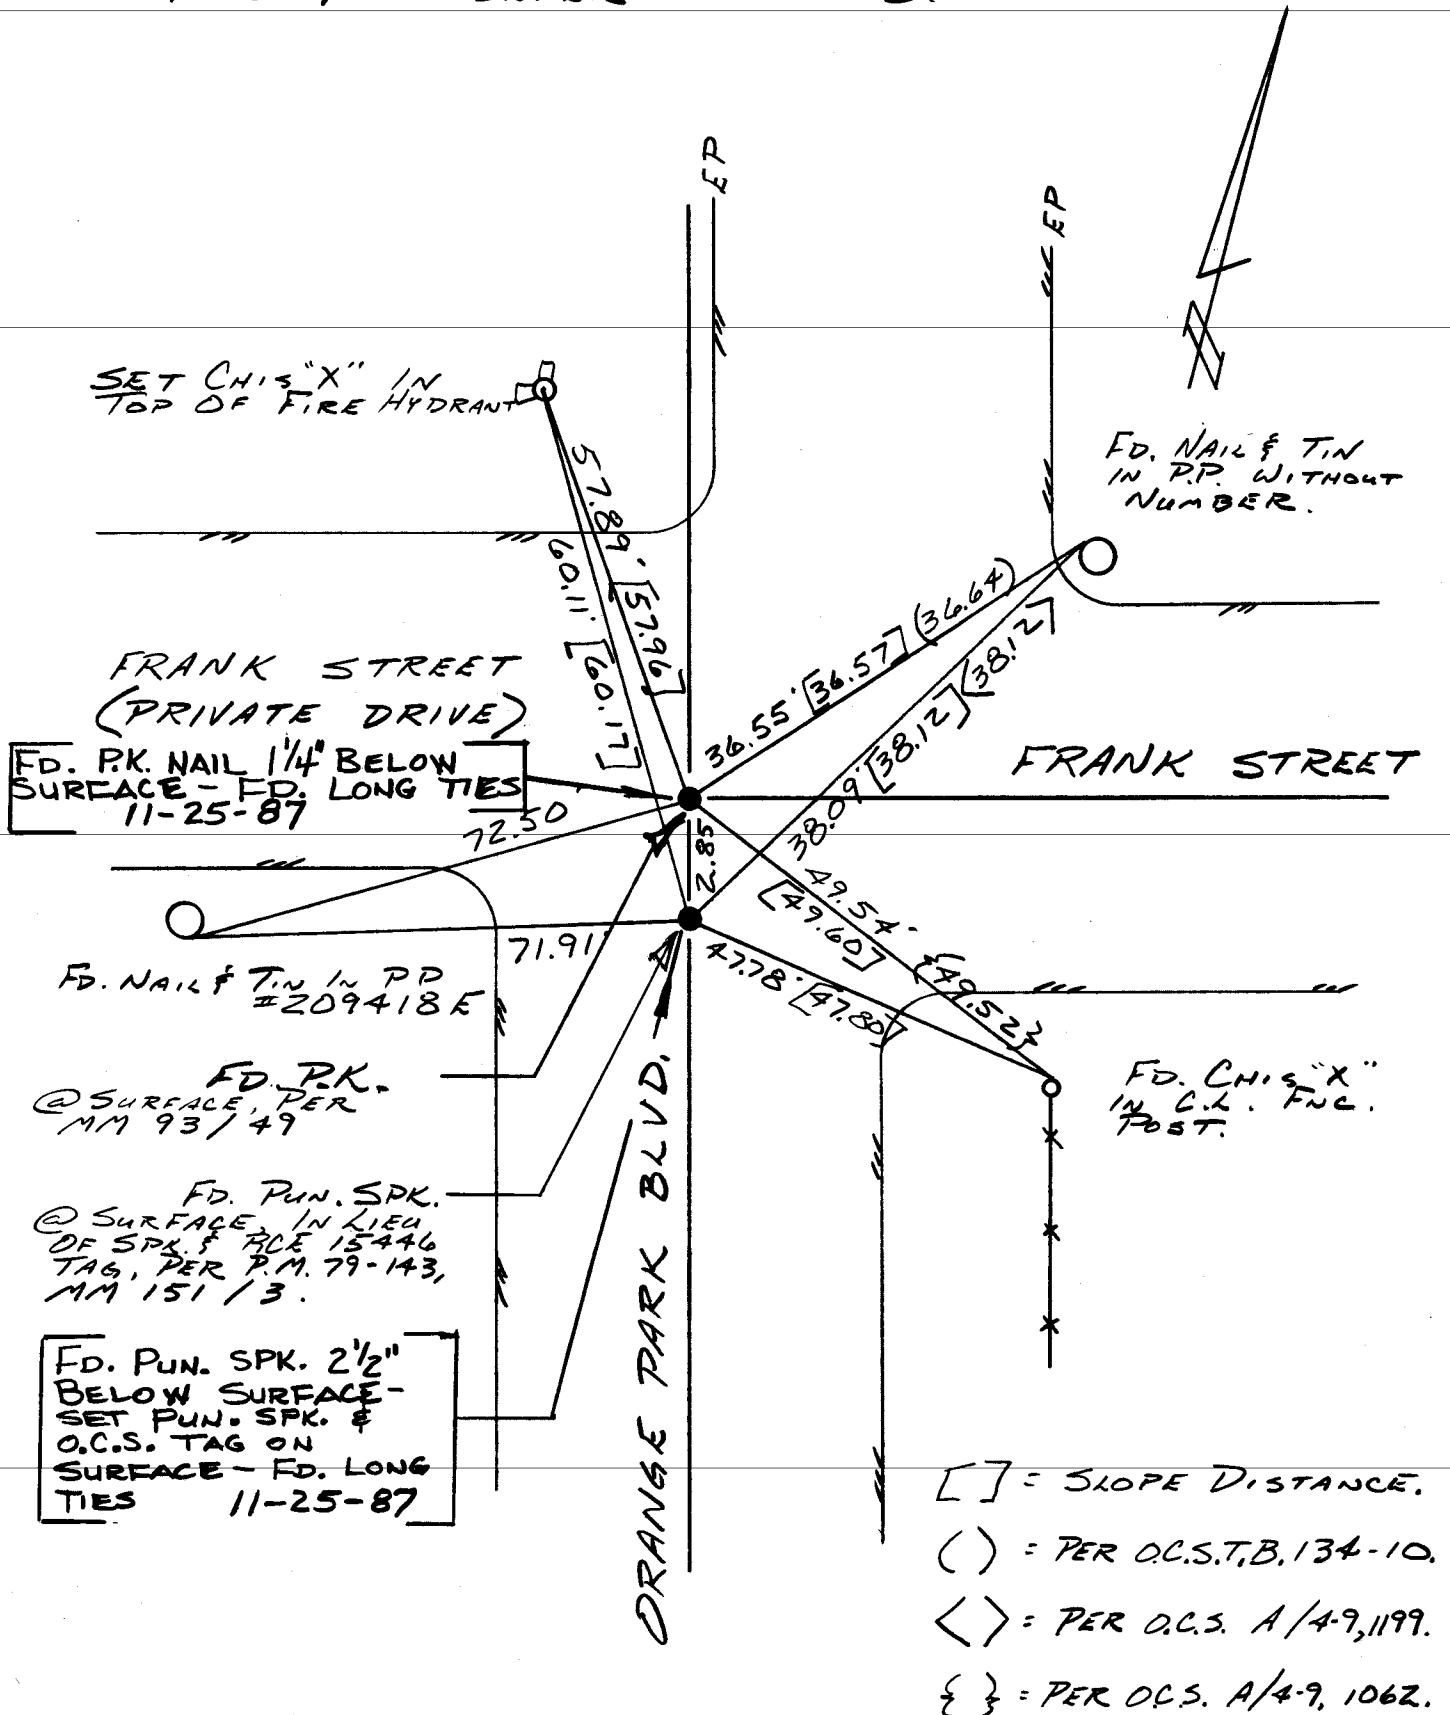


SET PUN. SPK. & O.C.S.
TAG ON SURFACE -
LONG TIES CHECK - S'ELY.
TIE APPARENTLY HAD AN
ERRONEOUS DIST.
11-25-87


NOTE:

O = SET LEAD, TACK & O.C. TAG.

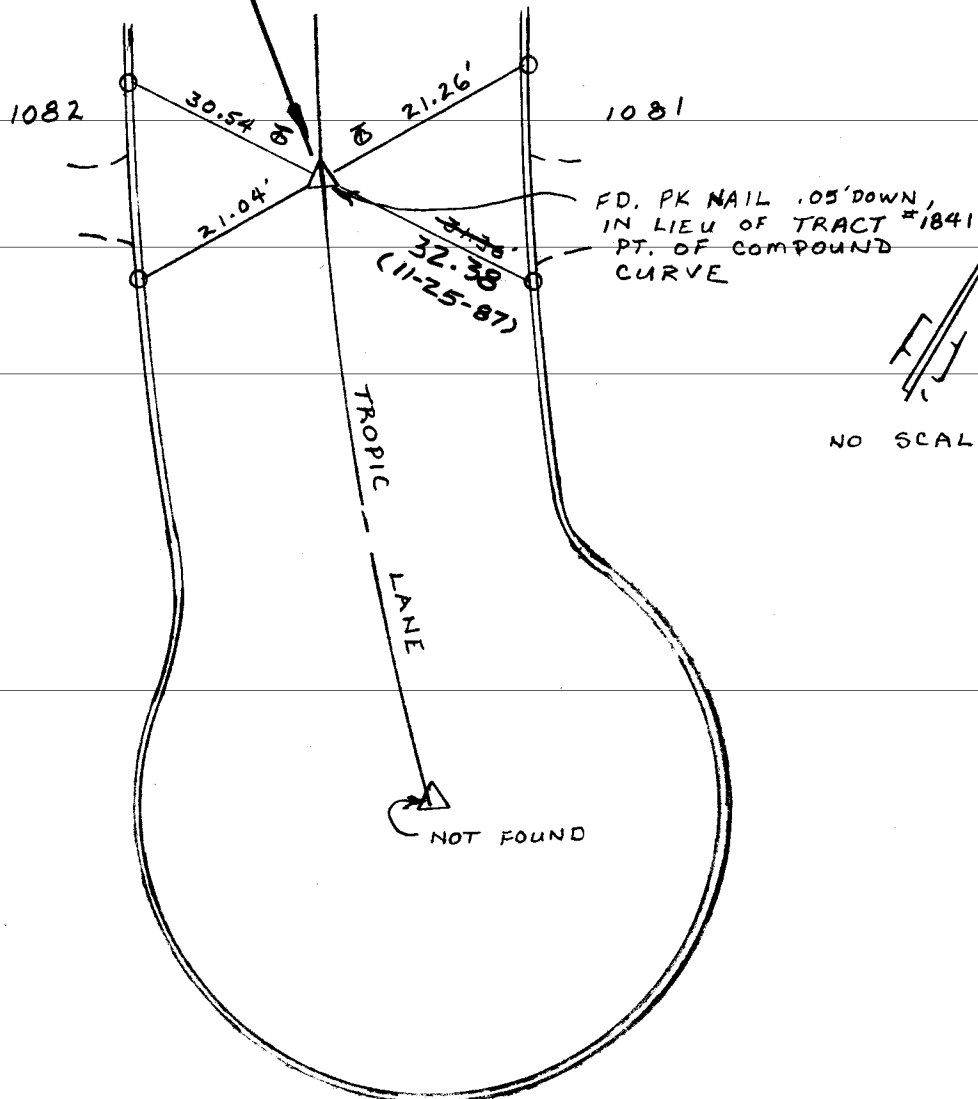

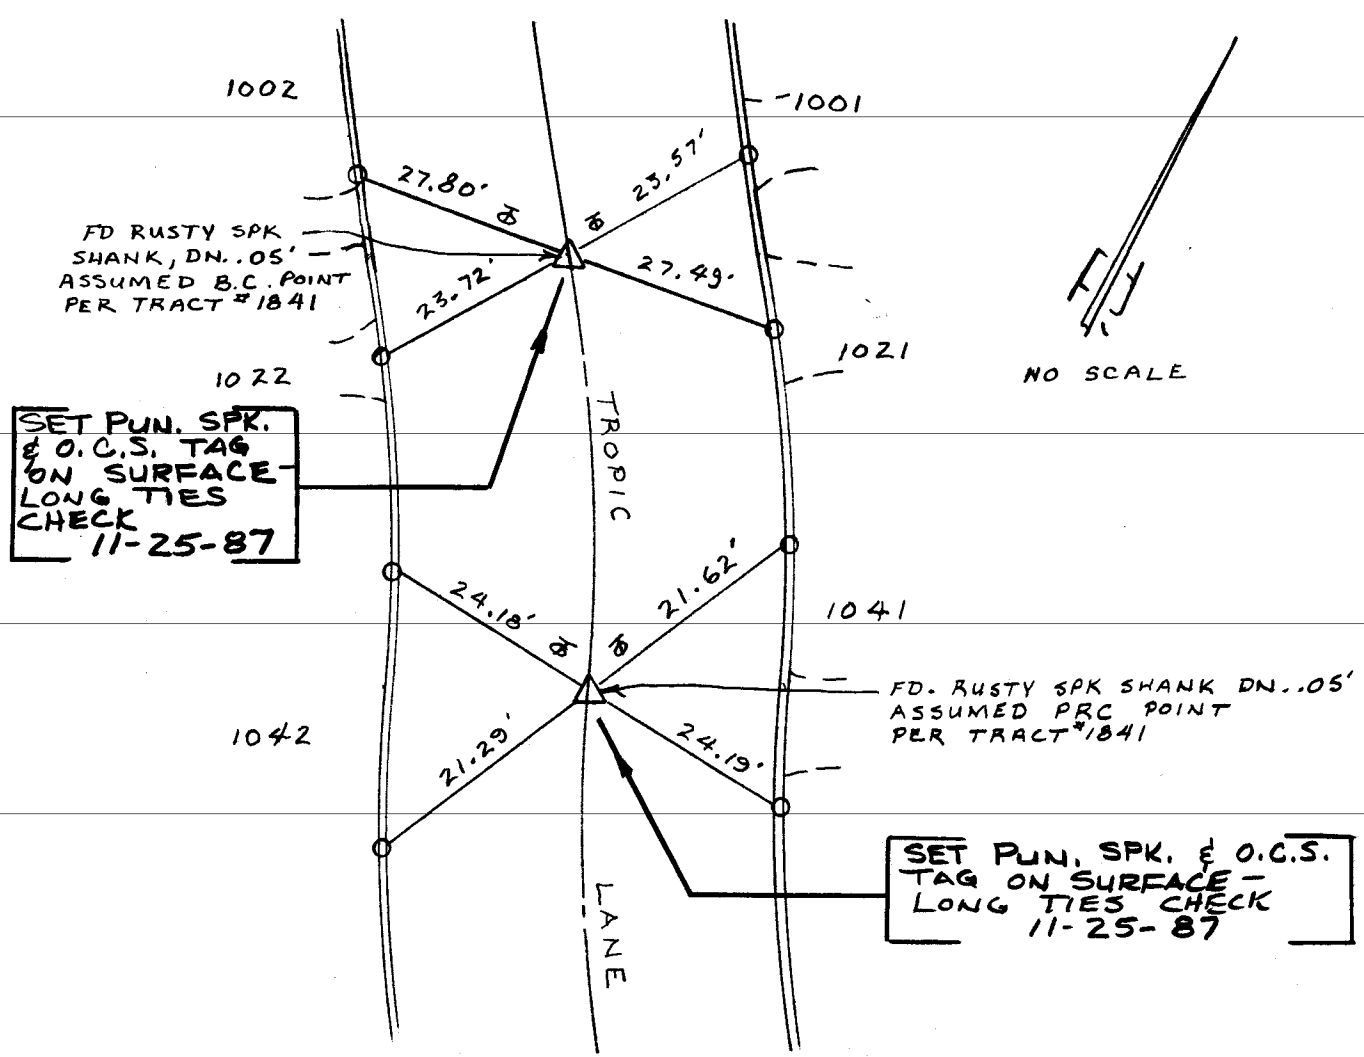

NOTE:
 O = SET LEAD, TACK & O.C. TAGS

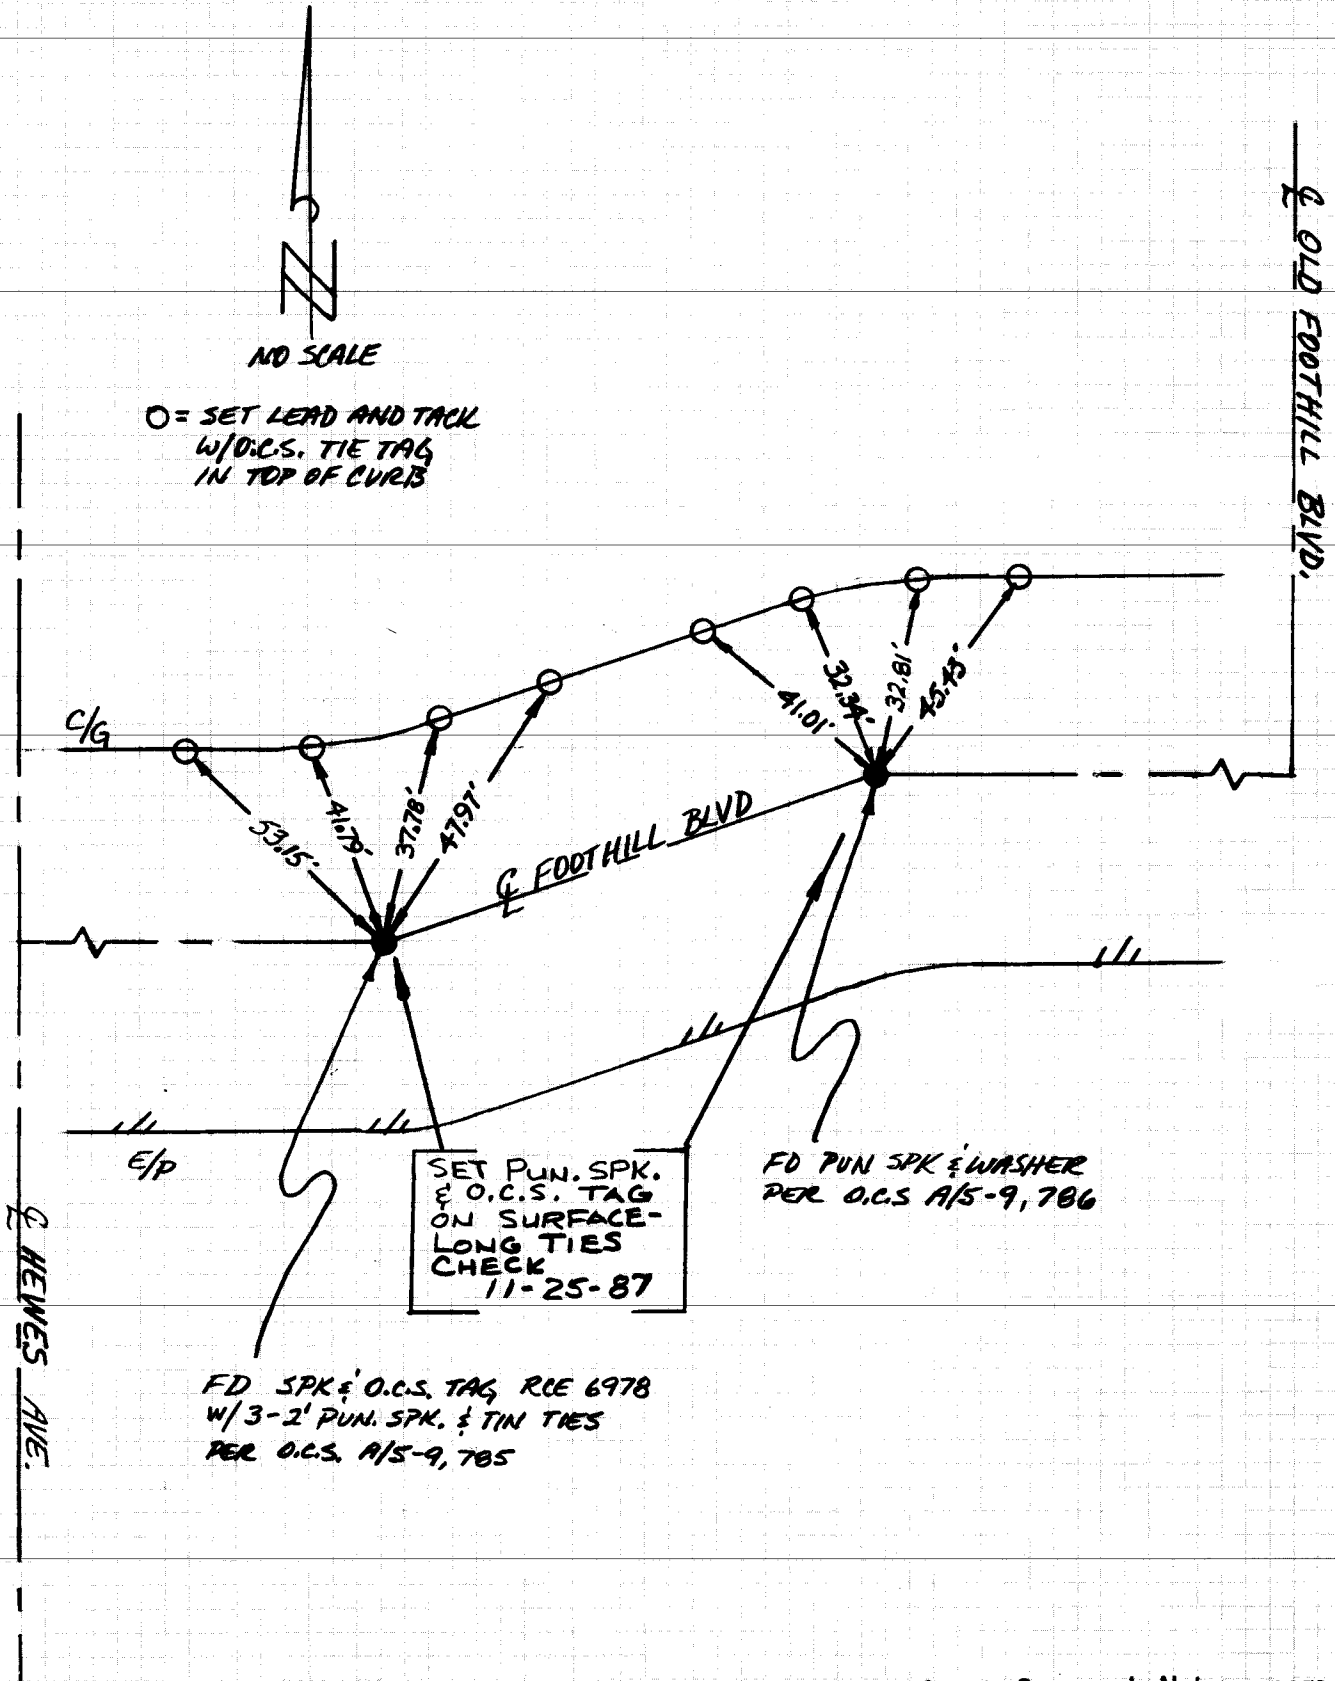



See Deputy County Surveyor's Note on page 1

B.K.

SURVEYED BY SANDEFER AND PARTY

DATE 6/30/86


ORANGE COUNTY SURVEYOR

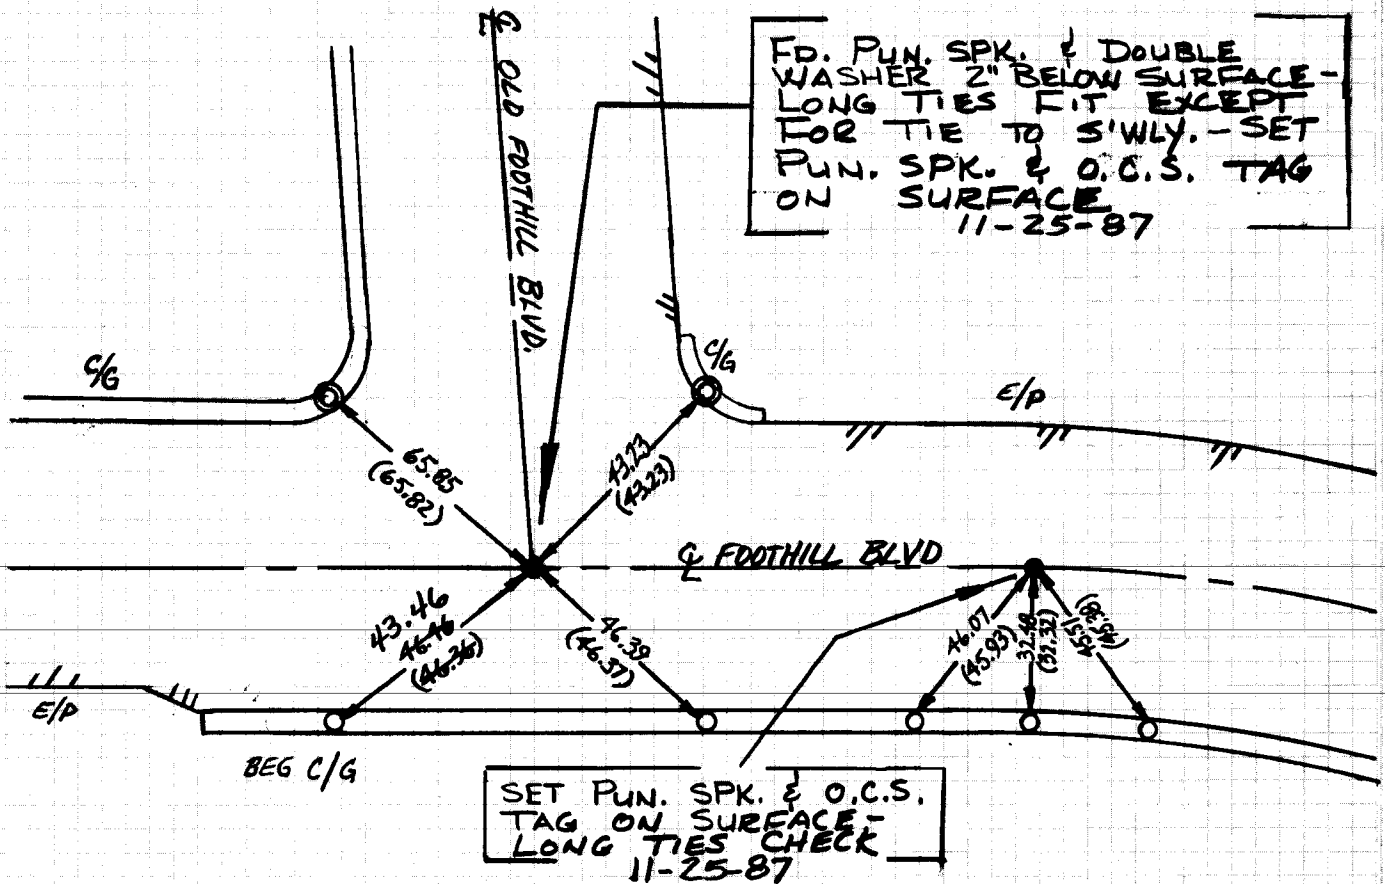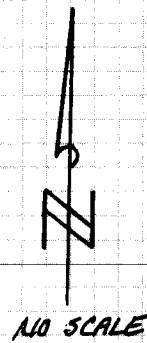

- FD CHIS "X" IN TOP OF CURB PER O.C.S. A/5-9, 786
SET LEAD AND TAG W/O.C.S. TIETAG, IN SAME
- ⊙ FD LEAD AND NAIL IN TOP OF CURB
- FD PUN. SPK AND DOUBLE WASHER PER O.C.S.
A/5-9, 786, 787
- () DIST AS PER O.C.S. A/5-9, 786, 787

See Deputy County Surveyor's Note on page 1

B.K.

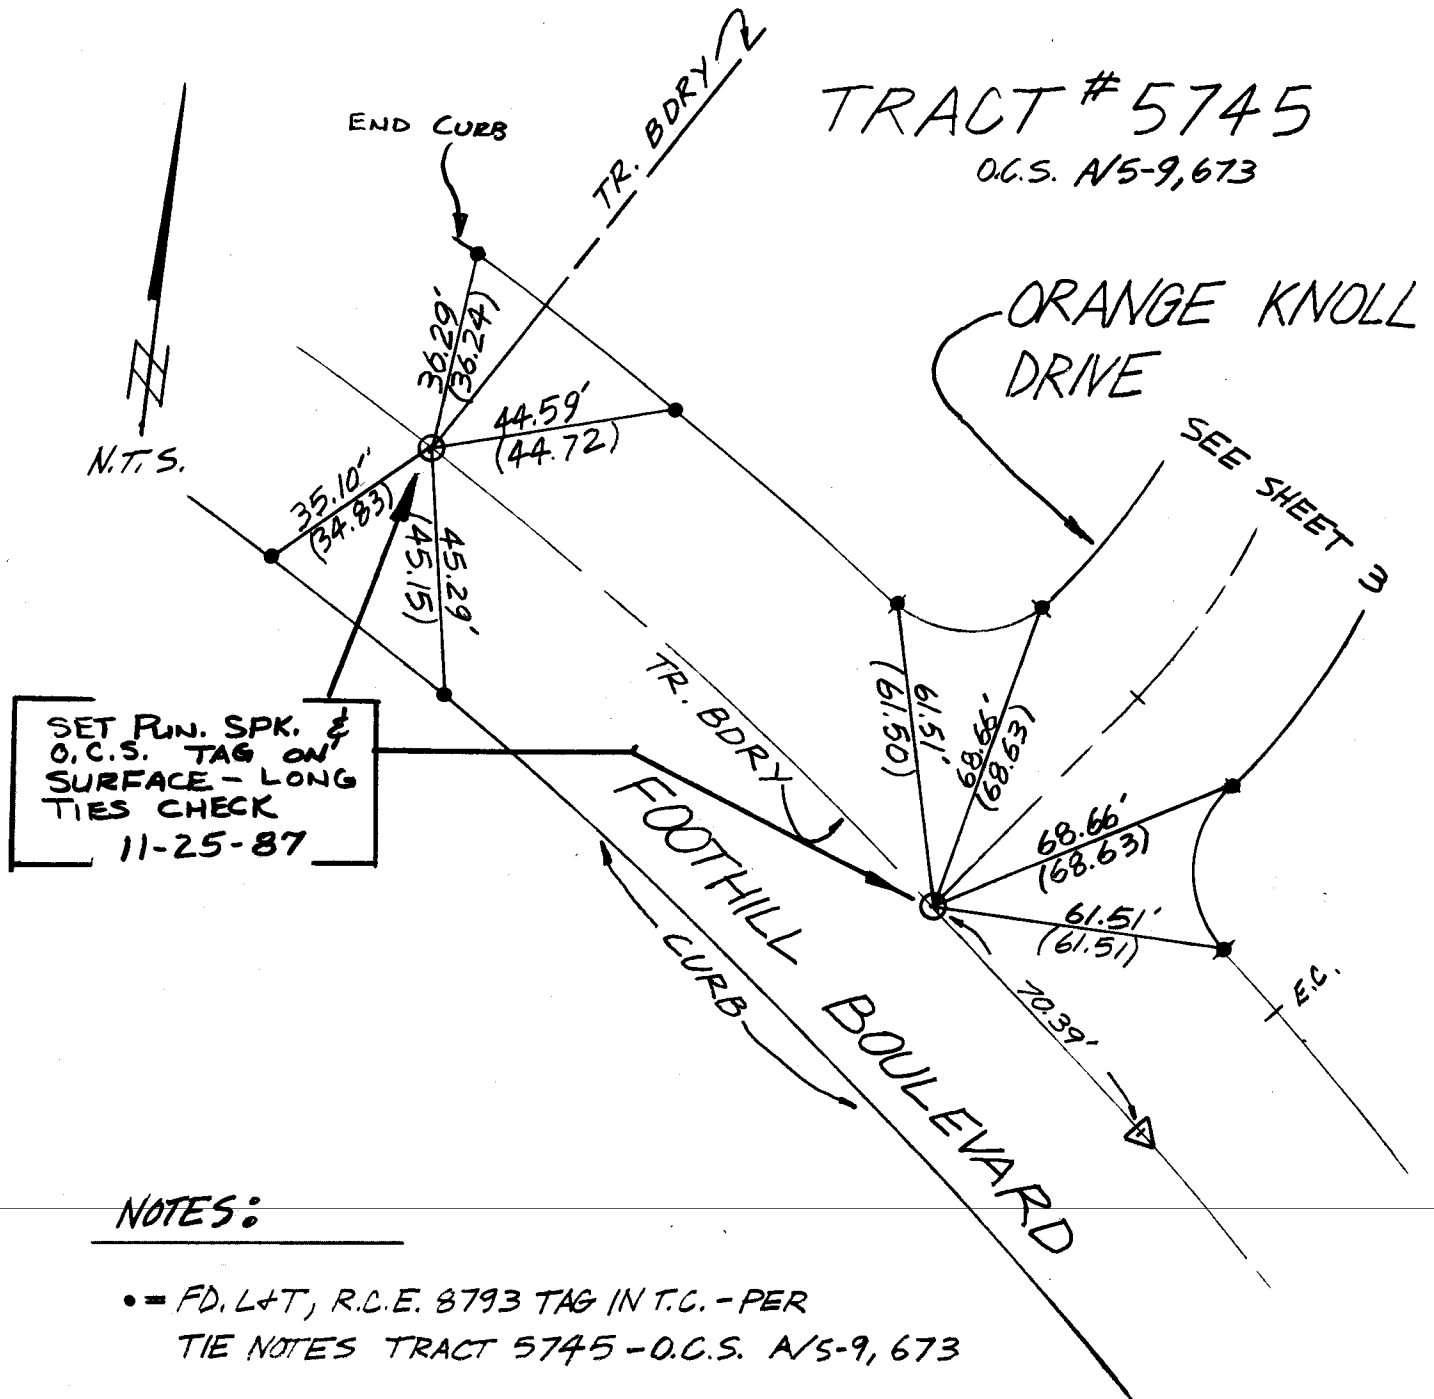

NOTES:

- = FD. L+T, R.C.E. 8793 TAG IN T.C. - PER
 TIE NOTES TRACT 5745 - O.C.S. A/5-9, 673
- O = FD. PUN. RND. HEAD SPK., NO WASHER, DN. .04'
 PER TIE NOTES TRACT 5745 - O.C.S. A/5-9, 673
- () = DIST. PER TIE NOTES TRACT 5745 - O.C.S. A/5-9, 673
- Δ = FD. O.C.S. TYPE 'A' WELL MON. W/2" PUN. BRASS DISC.
 DN. 12" PER TIE NOTES TRACT 5745 - O.C.S. A/5-9, 783