


JENNINGS-HALDERMAN-HOOD 12/69  
HUGH E. HALDERMAN-R.C.E. 8793

SHEET 1 OF 7 SHEETS

DATE: FILED BY OCS JAN 1970



SCALE: 1"=40'

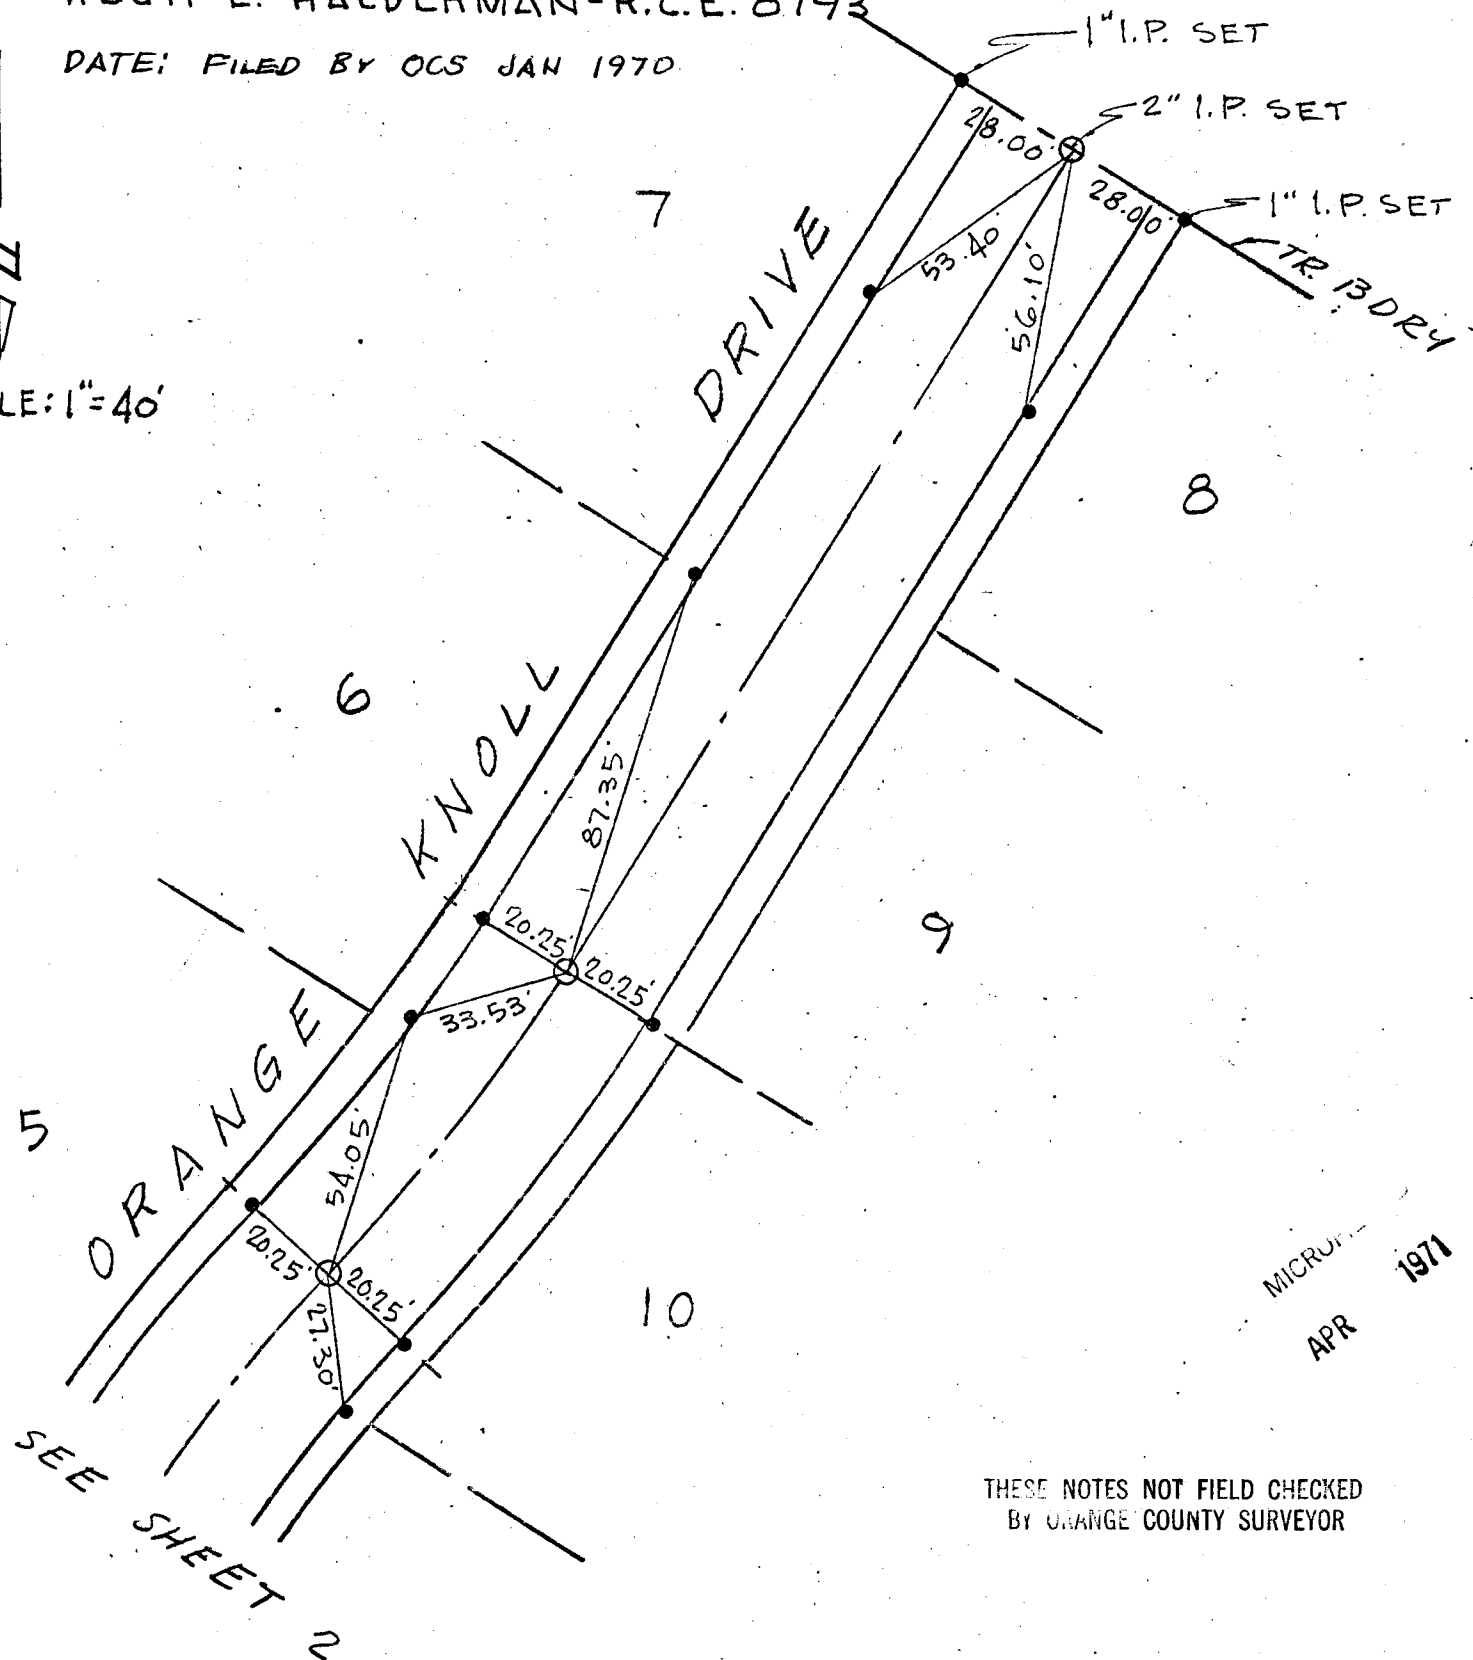

MICROFILMED  
APR 1971


THESE NOTES NOT FIELD CHECKED  
BY ORANGE COUNTY SURVEYOR

- Indicates spike and washer set, unless otherwise noted
- Indicates L & T marked R.C.E. 8793 set in curb, unless otherwise noted
- △ Indicates o.c.s. type "A" monument set

JENNINGS-HALDERMAN-HOOD 12/69 SHEET 2 OF 7 SHEETS  
 HUGH E. HALDERMAN-R.C.E. 8793 SEE SHEET 1



SCALE: 1"=40'

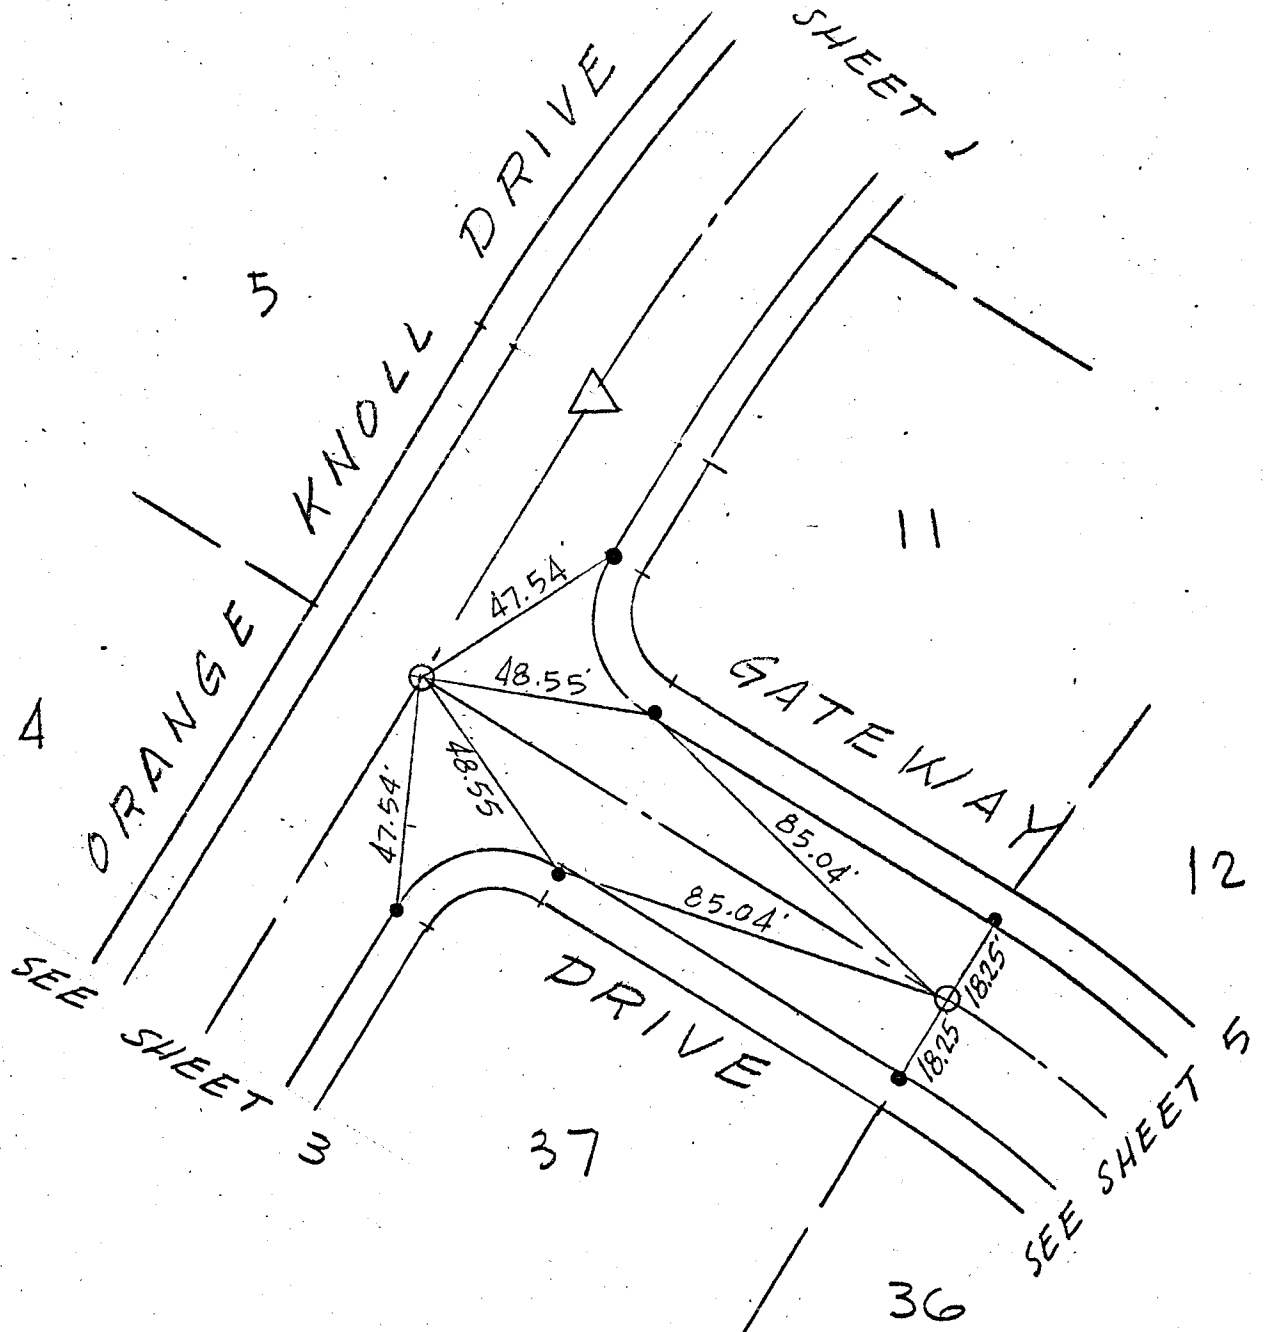

MICROFILMED

APR 1971

THESE NOTES NOT FIELD CHECKED  
 BY ORANGE COUNTY SURVEYOR

- Indicates spike and washer set, unless otherwise noted
- Indicates L & T marked R.C.E. 8793 set in curb, unless otherwise noted
- △ Indicates O.C.S. type "A" monument set

JENNINGS-HALDERMAN-HOOD


12/69

SHEET 3 OF 7 SHEETS

HUGH E. HALDERMAN-R.C.E. 8793



SCALE: 1"=40'

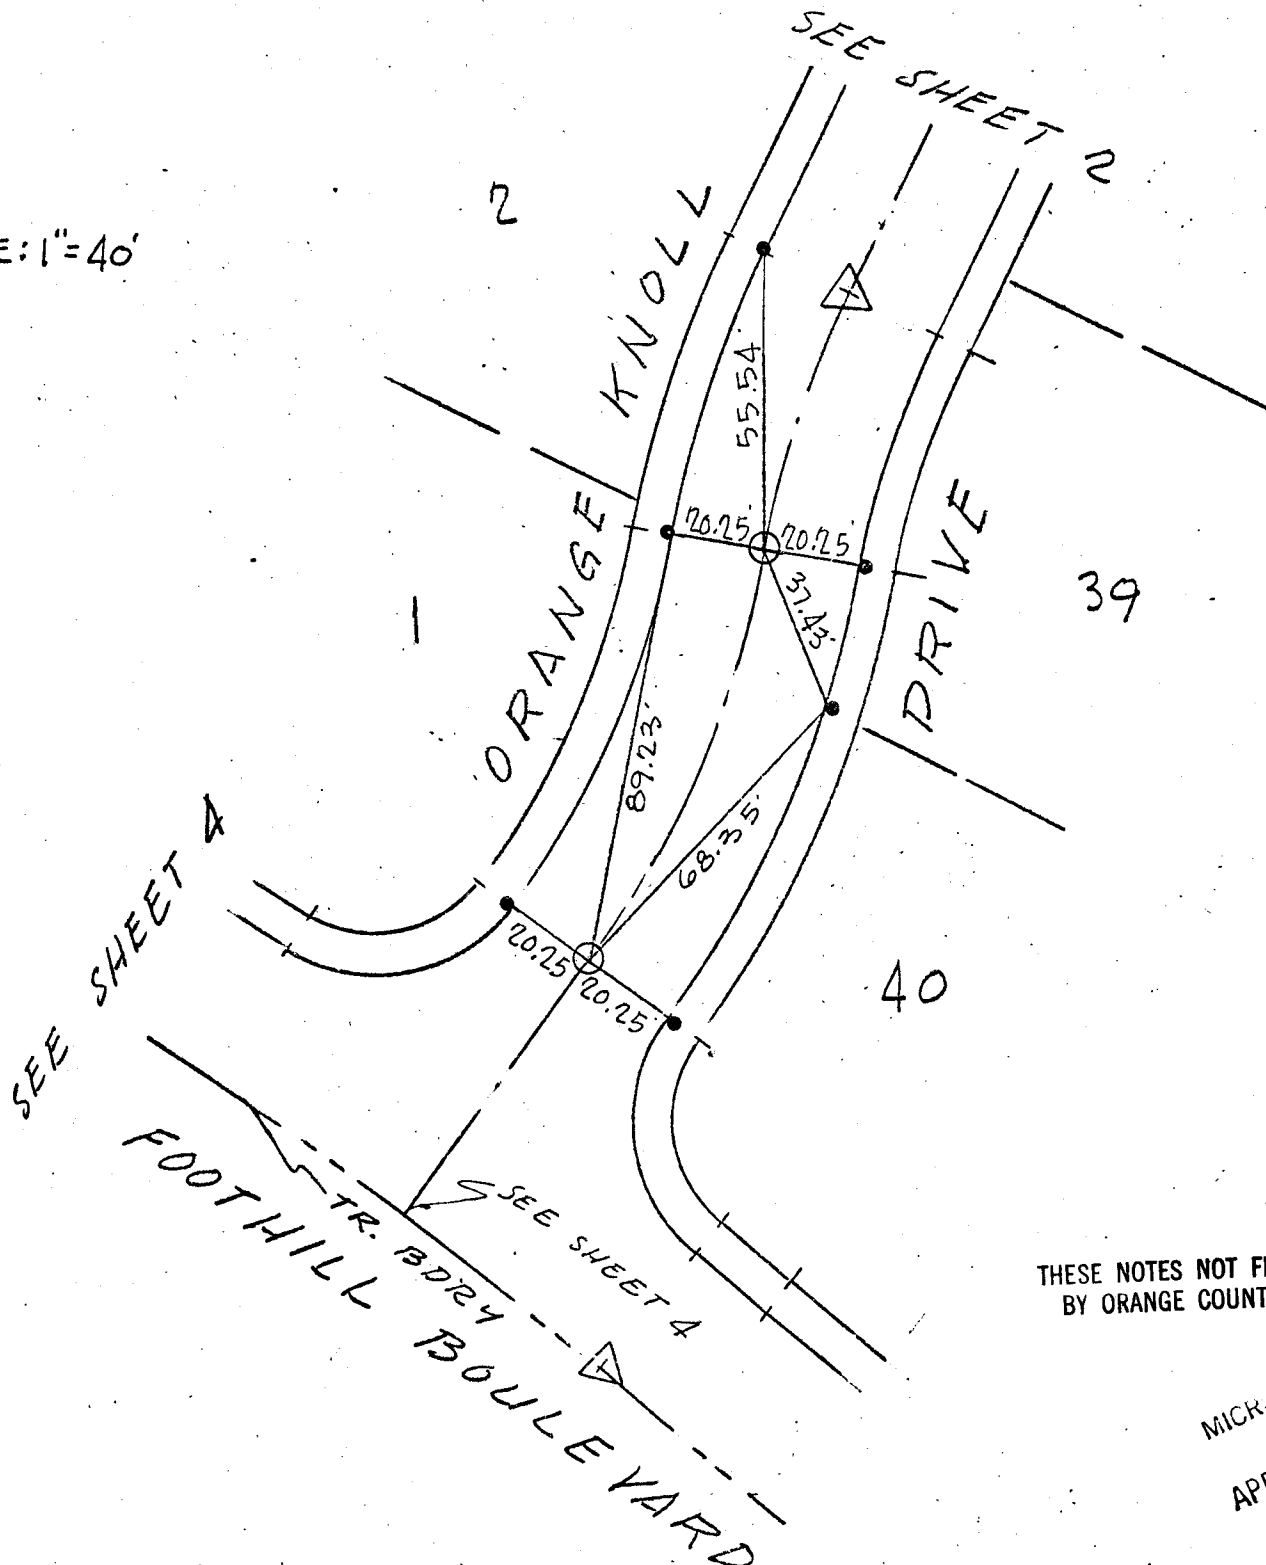

THESE NOTES NOT FIELD CHECKED  
BY ORANGE COUNTY SURVEYOR

MICRO

APR



1971

○ Indicates spike and washer set, unless otherwise noted

• Indicates L & T marked R.C.E. 8793 set in curb, unless otherwise noted

△ Indicates O.C.S. type "A" monument set

SHEET 4 OF 7 SHEETS

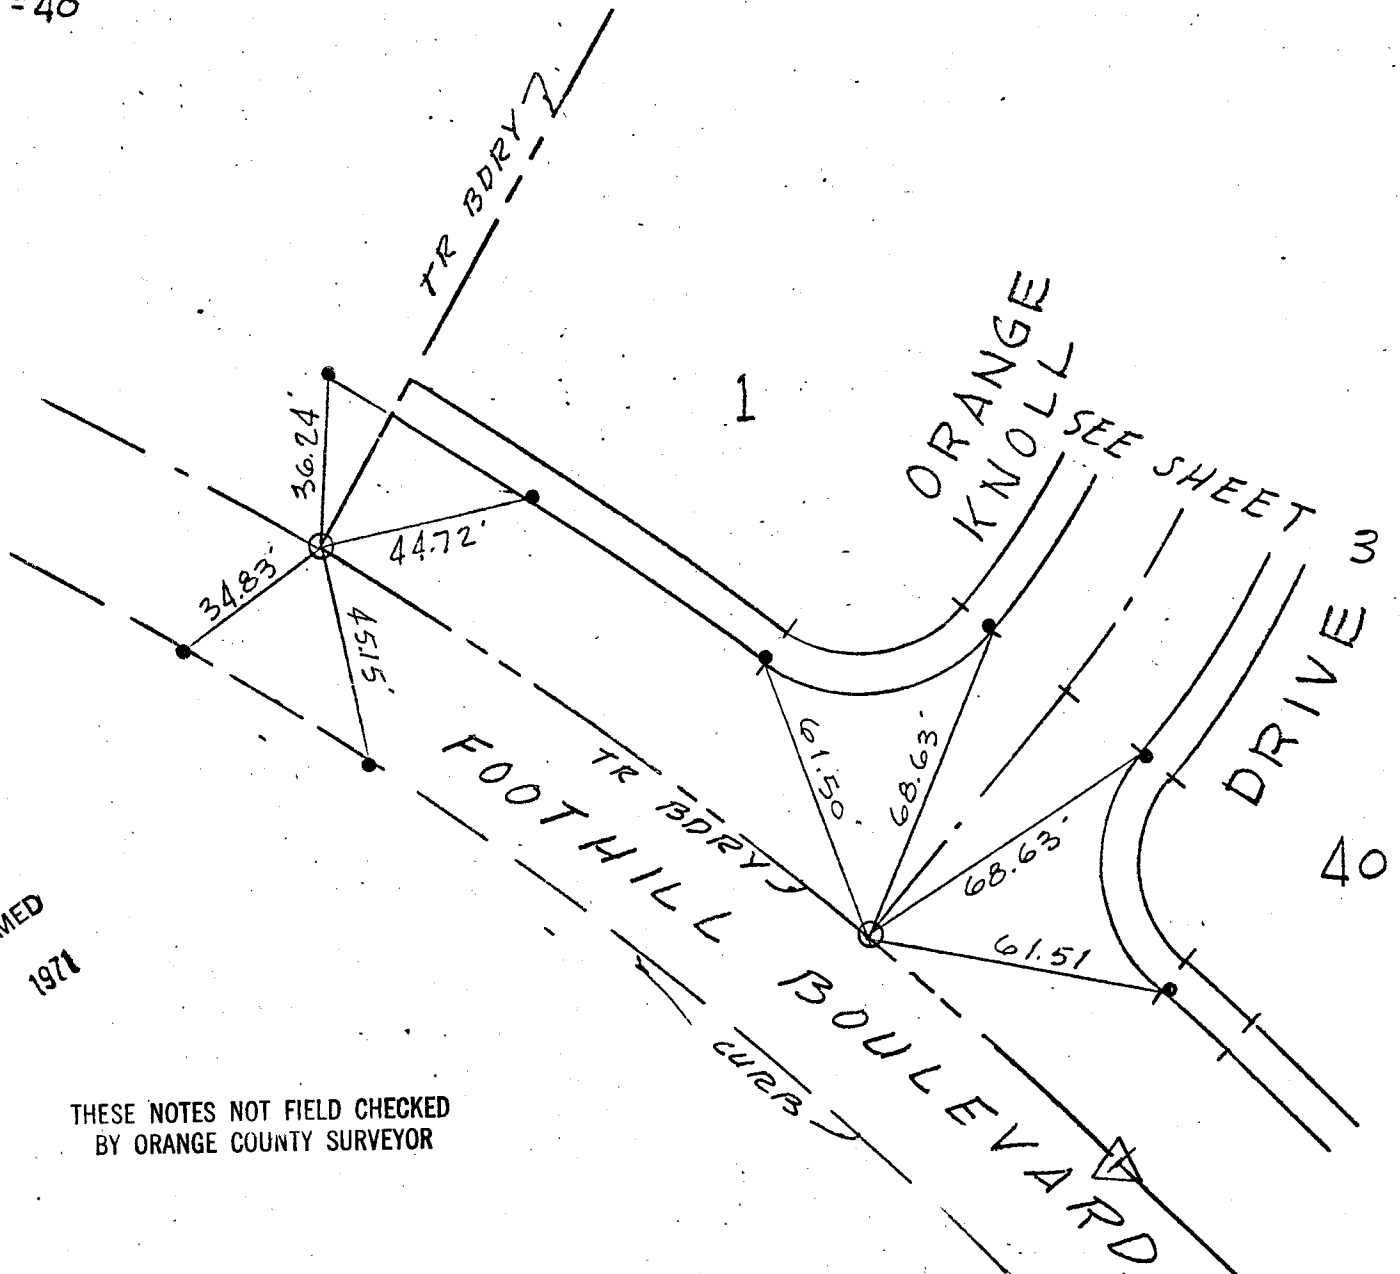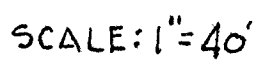


MICROFILMED  
APR 1971

THESE NOTES NOT FIELD CHECKED  
BY ORANGE COUNTY SURVEYOR

- Indicates spike and washer set, unless otherwise noted
- Indicates L & T marked R.C.E 8793 set in curb, unless otherwise noted
- △ Indicates o.c.s type "A" monument set

12/69

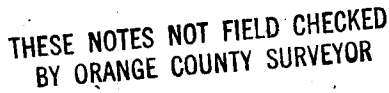


- Indicates spike and washer set, unless otherwise noted
- Indicates L & T marked R.C.E 8793 set in curb, unless otherwise noted
- △ Indicates d.c.s type "A" monument set

JENNINGS-HALDERMAN-HOOD  
HUGH E. HALDERMAN-R.C.E. 8793

12/69

SHEET 6 OF 7 SHEETS

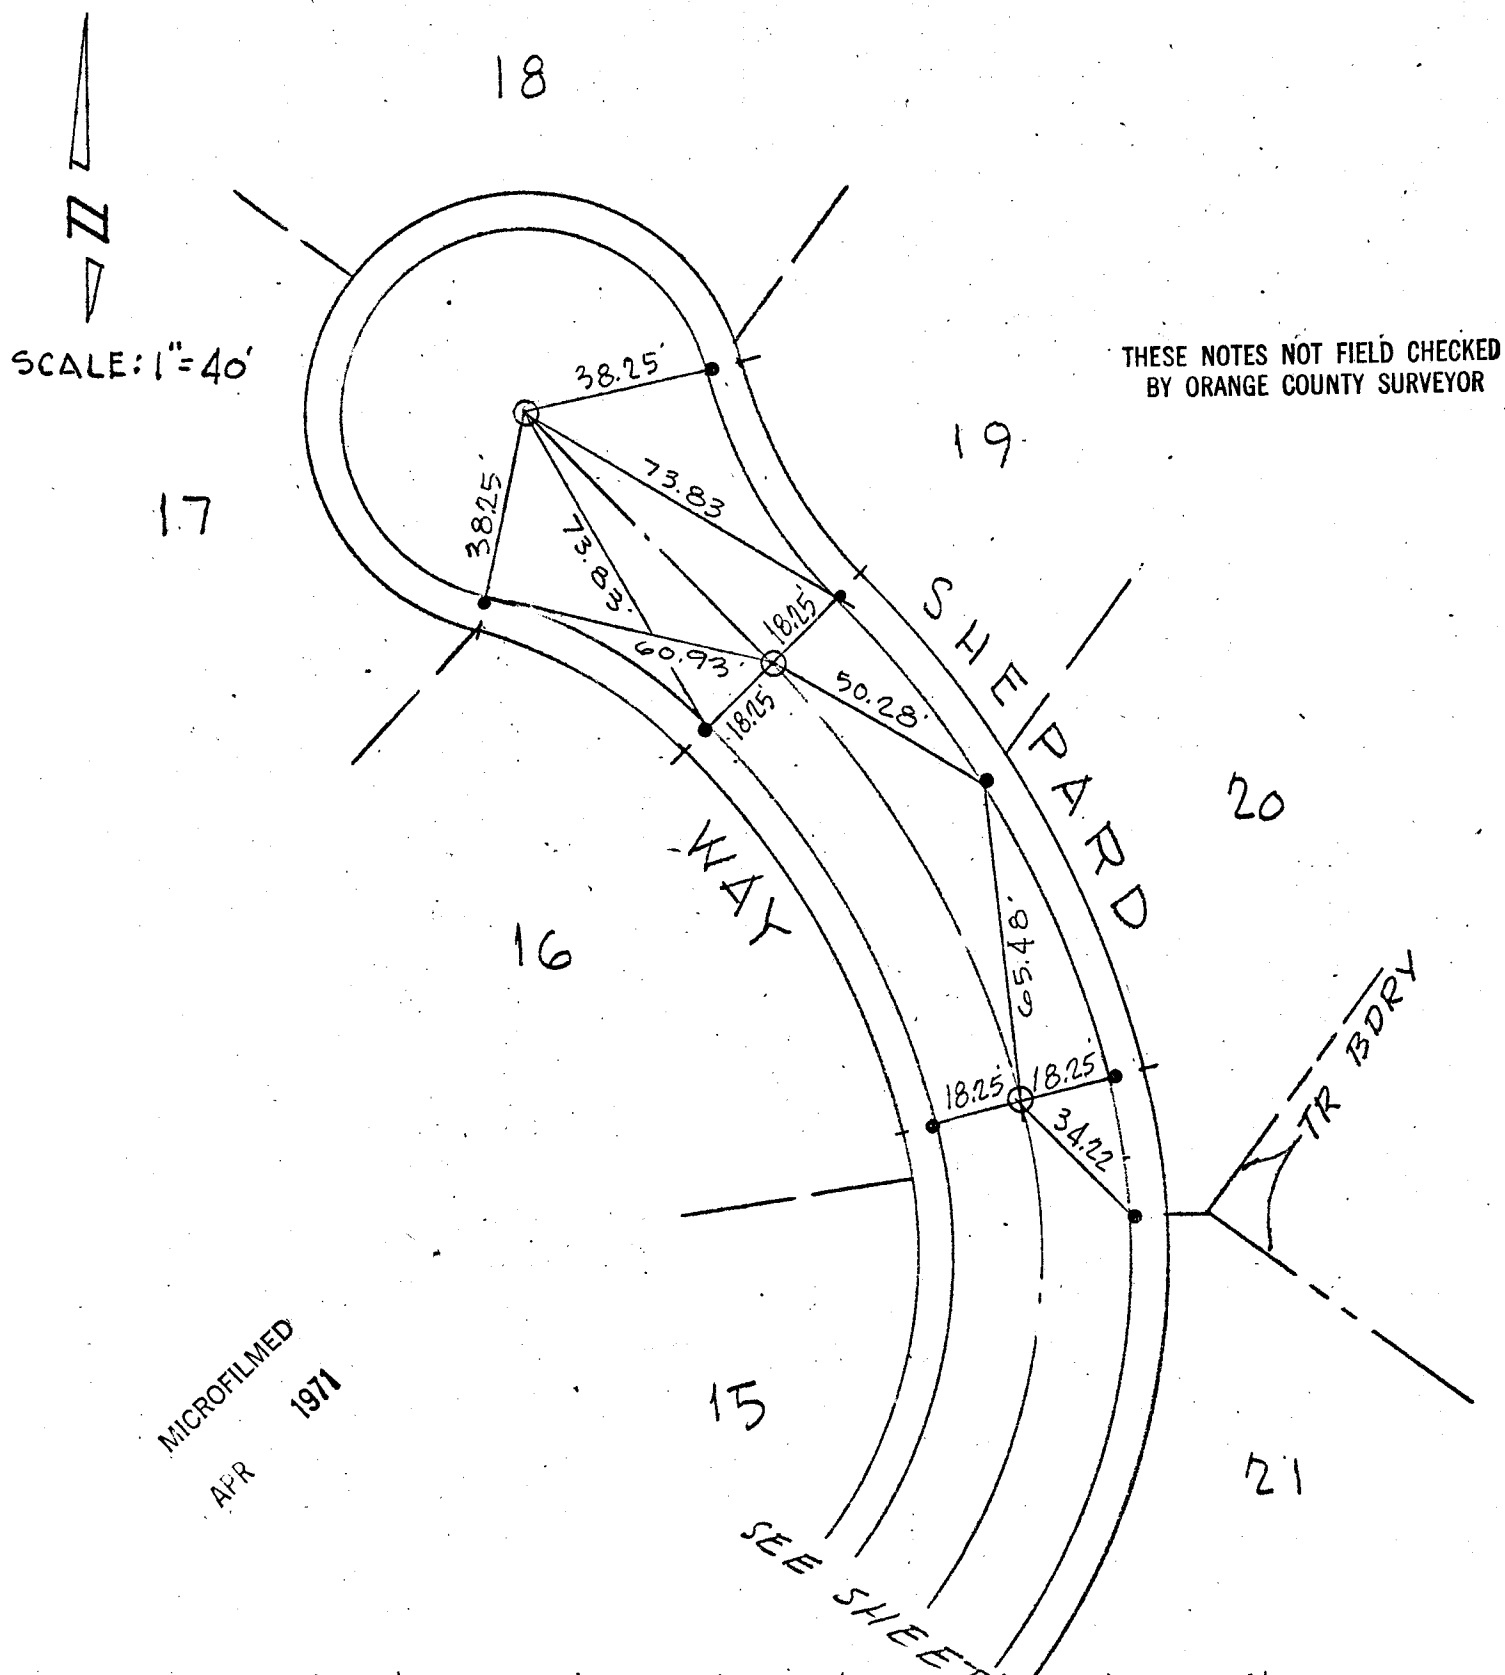


○ Indicates spike and washer set, unless otherwise noted

• Indicates L & T marked R.C.E. 8793 set in curb, unless otherwise noted

△ Indicates a.c.s. type "A" monument set

JENNINGS-HALDERMAN-HOOD 12/69 SHEET 7 OF 7 SHEETS  
 HUGH E. HALDERMAN-R.C.E. 8793

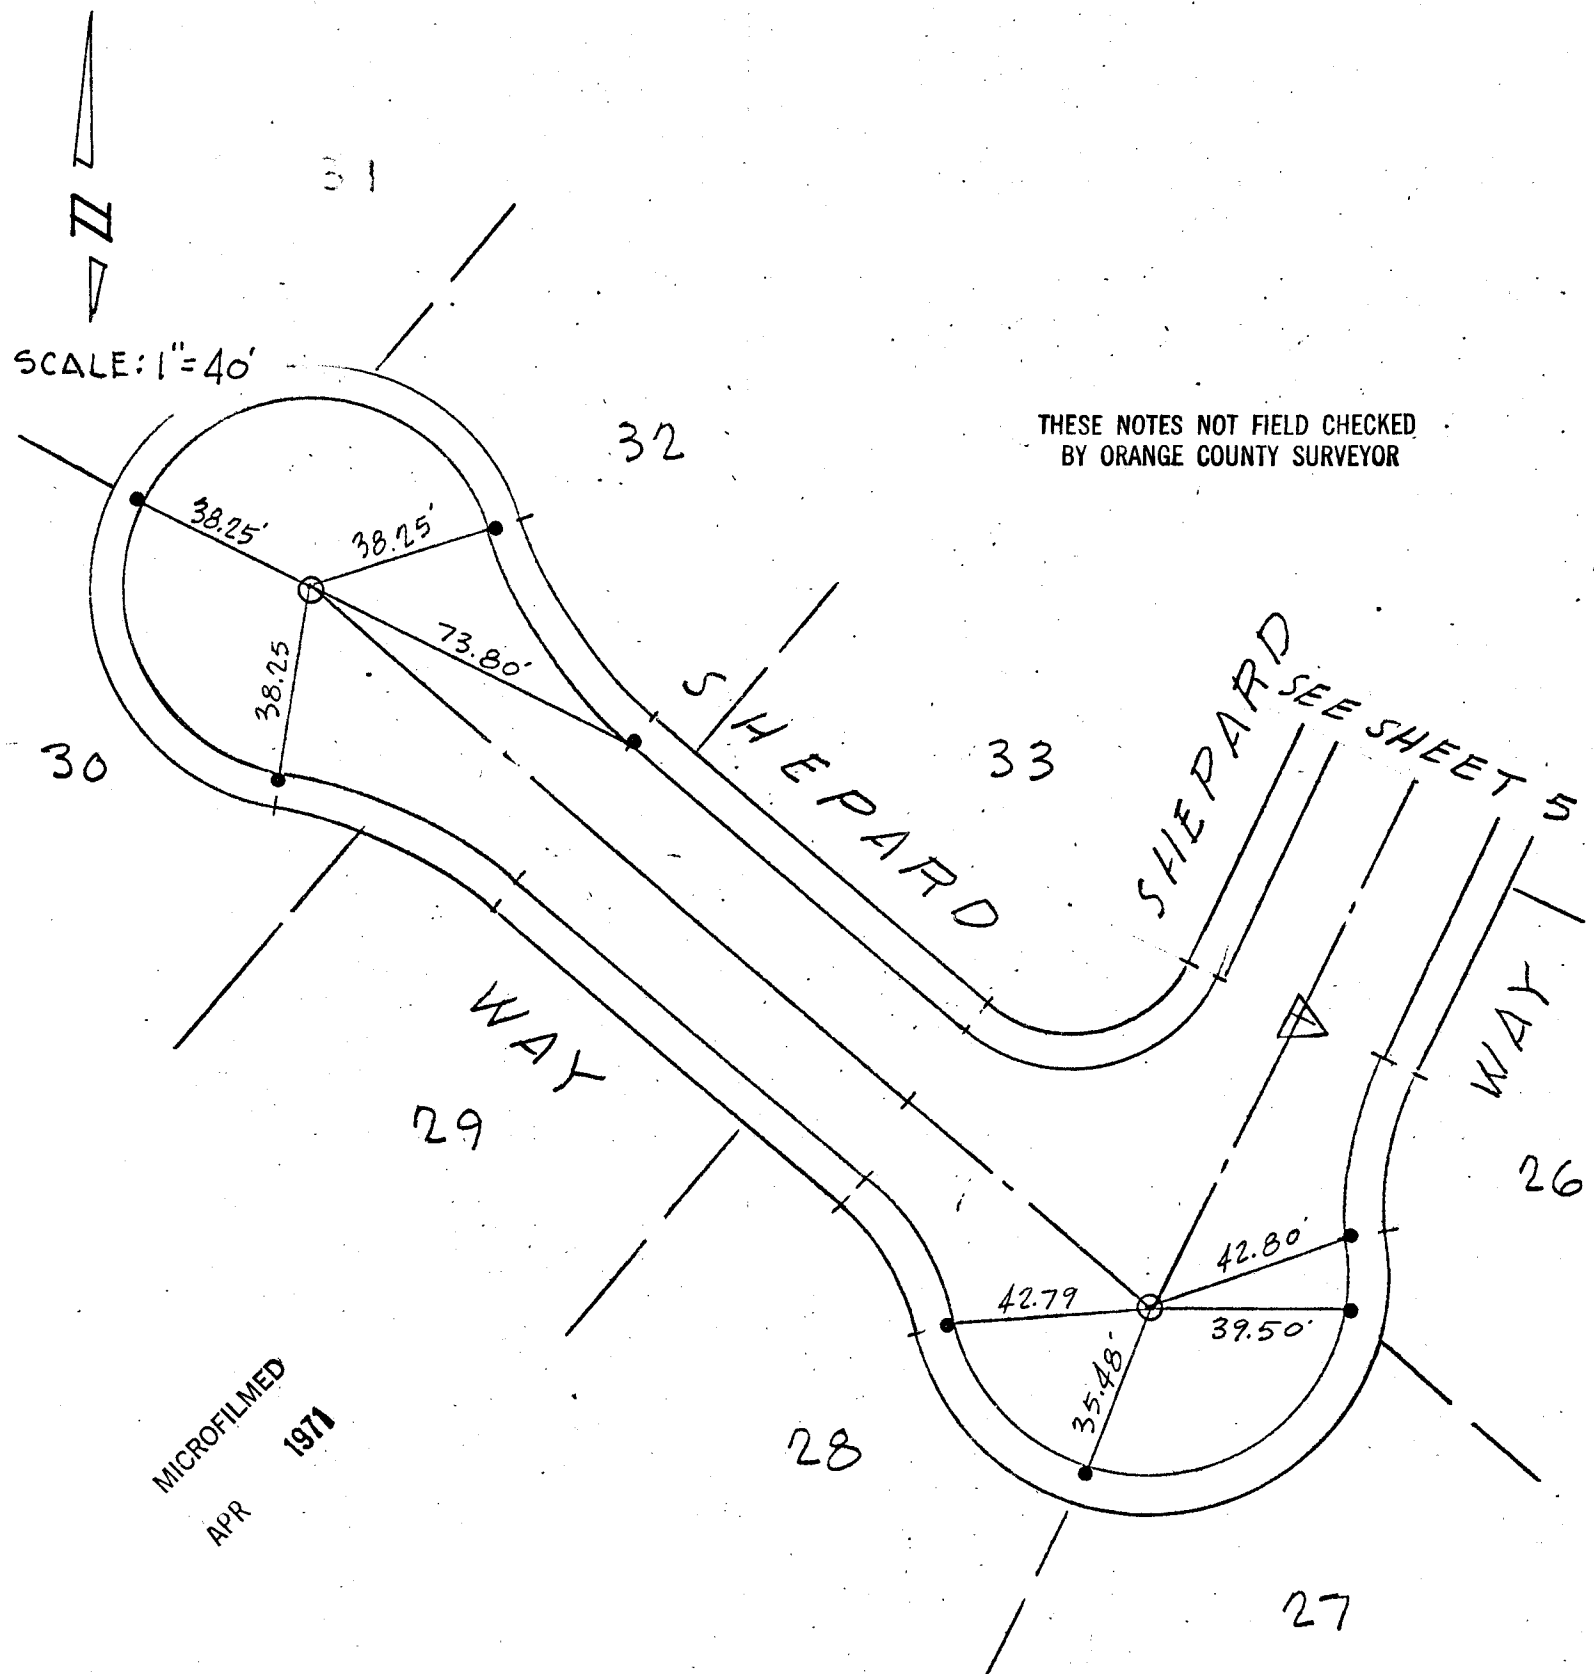

○ Indicates spike and washer set, unless otherwise noted

• Indicates L & T marked R.C.E. 8793 set in curb, unless otherwise noted

△ Indicates o.c.s type "A" monument set