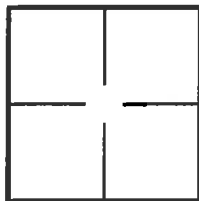


# CORNER RECORD

Document Number 2015-2271BCity of TUSTIN County of ORANGE, CaliforniaBrief Legal Description ORANGE KNOLL DRIVE; 158'± N'LY OF FOOTHILL BOULEVARD

## CORNER TYPE

Government Corner ☐ Control ☒  
Meander ☐ Property ☐  
Rancho ☐ Other ☐

Date of Survey 8/18/2015

## COORDINATES (Optional)

N. \_\_\_\_\_  
E. \_\_\_\_\_  
Zone \_\_\_\_\_ NAD27 ☐ NAD83 ☐  
NAD83 Epoch \_\_\_\_\_  
Elevation \_\_\_\_\_  
Vertical Datum: NGVD29 ☐ NAVD88 ☐  
Units: Metric ☐ Imperial ☐ U.S. Survey ☒

Corner — Left as found ☒ Found and tagged ☐ Established ☐ Reestablished ☒ Rebuilt ☐

Identification and type of corner found; Evidence used to identify or procedure used to establish or reestablish corner:  
FOUND AS DESCRIBED ON THE REVERSE OF THIS SHEET.

A description of the physical condition of the monument as found and as set or reset: \_\_\_\_\_  
SEE PAGE 2

## SURVEYOR'S STATEMENT

This Corner Record was prepared by me or under my direction in conformance with  
the Professional Land Surveyors' Act on 9/7/2015


Signed [Signature] P.L.S. or R.C.E. No. L.S. 5411

## COUNTY SURVEYOR'S STATEMENT

This Corner Record was received SEP 10 2015examined and filed DEC 12 2015Signed [Signature] P.L.S. or R.C.E. No. 6131Title CHIEF DEPUTY SURVEYOR

County Surveyor's Comment \_\_\_\_\_

R-1 = COUNTY OF ORANGE CORNER RECORD 2015-2218 A  
 [ ] = RECORD & MEASURED DISTANCE PER R-1

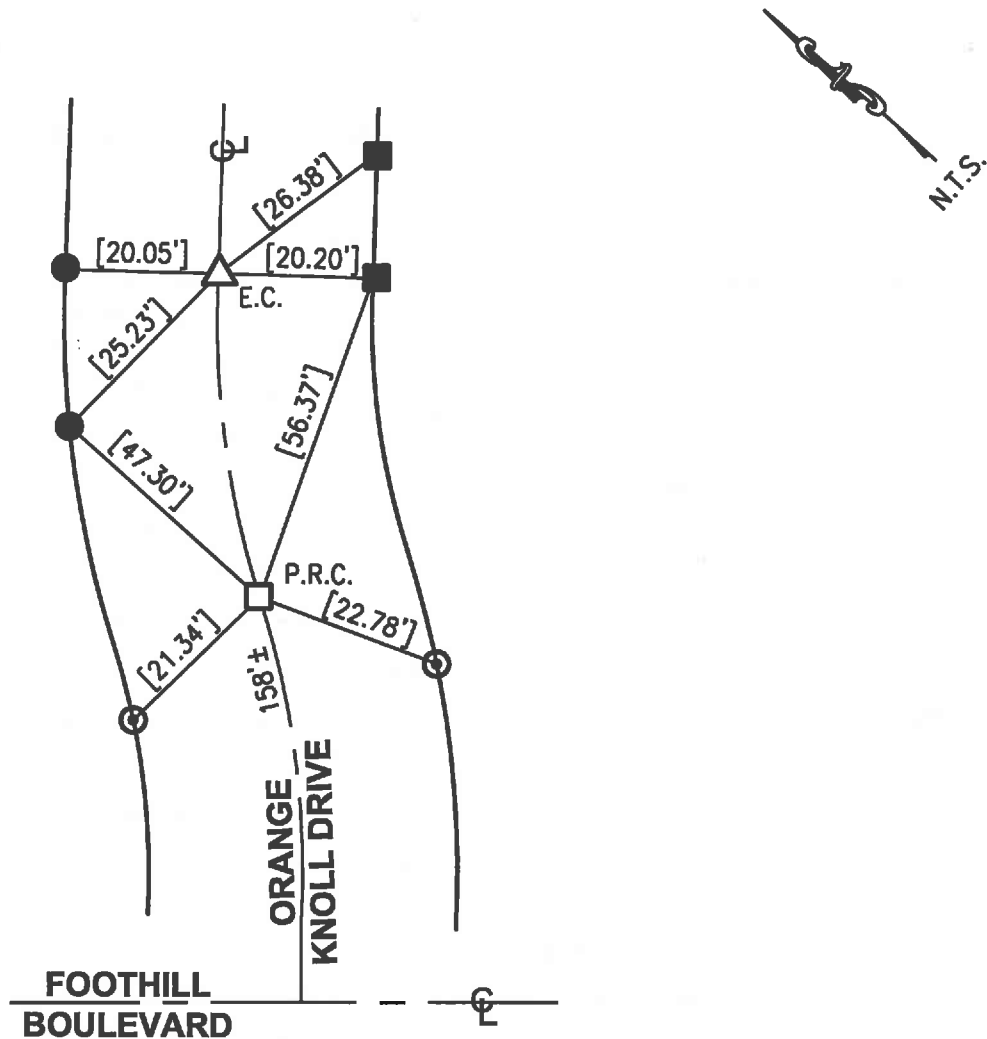

- △ SET GEAR SPIKE & WASHER "LS 5411" PER TIES ON R-1, FLUSH, AFTER CONSTRUCTION.
- FD. SURVEY WELL MONUMENT WITH 2" PUNCHED DISK PER R-1, DOWN 1.2', AFTER CONSTRUCTION.
- FD. LEAD, TACK & TAG "OCS TIE" IN T.C. PER R-1.
- FD. LEAD, TACK & TAG "RCE 8793" IN T.C. PER R-1.
- ⊙ FD. LEAD, TACK & TAG "LS 5411" IN T.C. PER R-1.

THE PURPOSE OF THIS RECORD IS TO DOCUMENT THE PERPETUATION OF FOUND MONUMENT(S) PURSUANT TO THE PLS ACT SECTION 8771. NO CLAIM IS MADE REGARDING THE CORRECTNESS OF THE POSITION(S) OF SAID MONUMENT(S), NOR THE DIMENSIONAL RELATIONSHIP TO STREET CENTERLINES OR PROPERTY BOUNDARIES.

15-RJN-765