

LEMON HILL DR. & LEMON
CIRCLE & LEMON LEAF HL
(TRACT NO. 11080)


A/5-9 1168

1 OF 6

BY JRV ENGINEERING
JUSTO R. VILLAR, RCE 29801

DATE 11-27-91 - 12-2-91

ORANGE COUNTY SURVEYOR

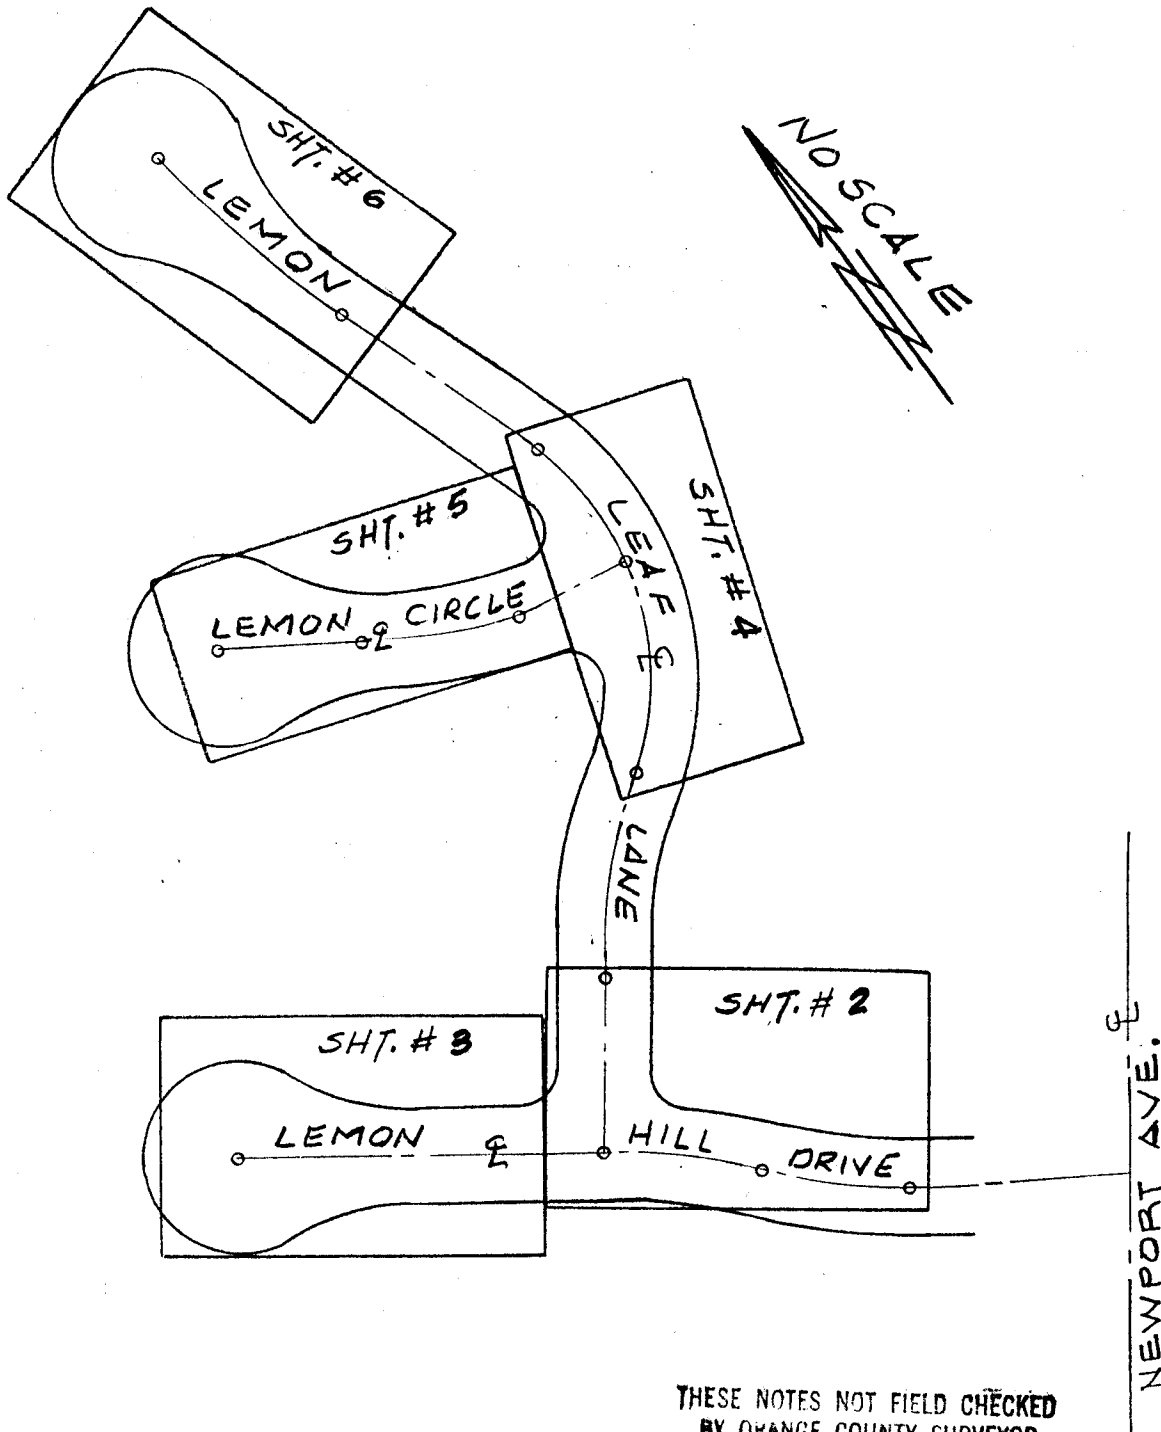

THESE NOTES NOT FIELD CHECKED
BY ORANGE COUNTY SURVEYOR

LEMON HILL DR. & LEMON
CIRCLE & LEMON LEAF LN.
(TRACT NO. 11080)


A/5-9 1169

2 OF 6

JRY ENGINEERING
JUSTO R. VILLAR, RCE 29801

11-27-91-12-2-91

ORANGE COUNTY SURVEYOR

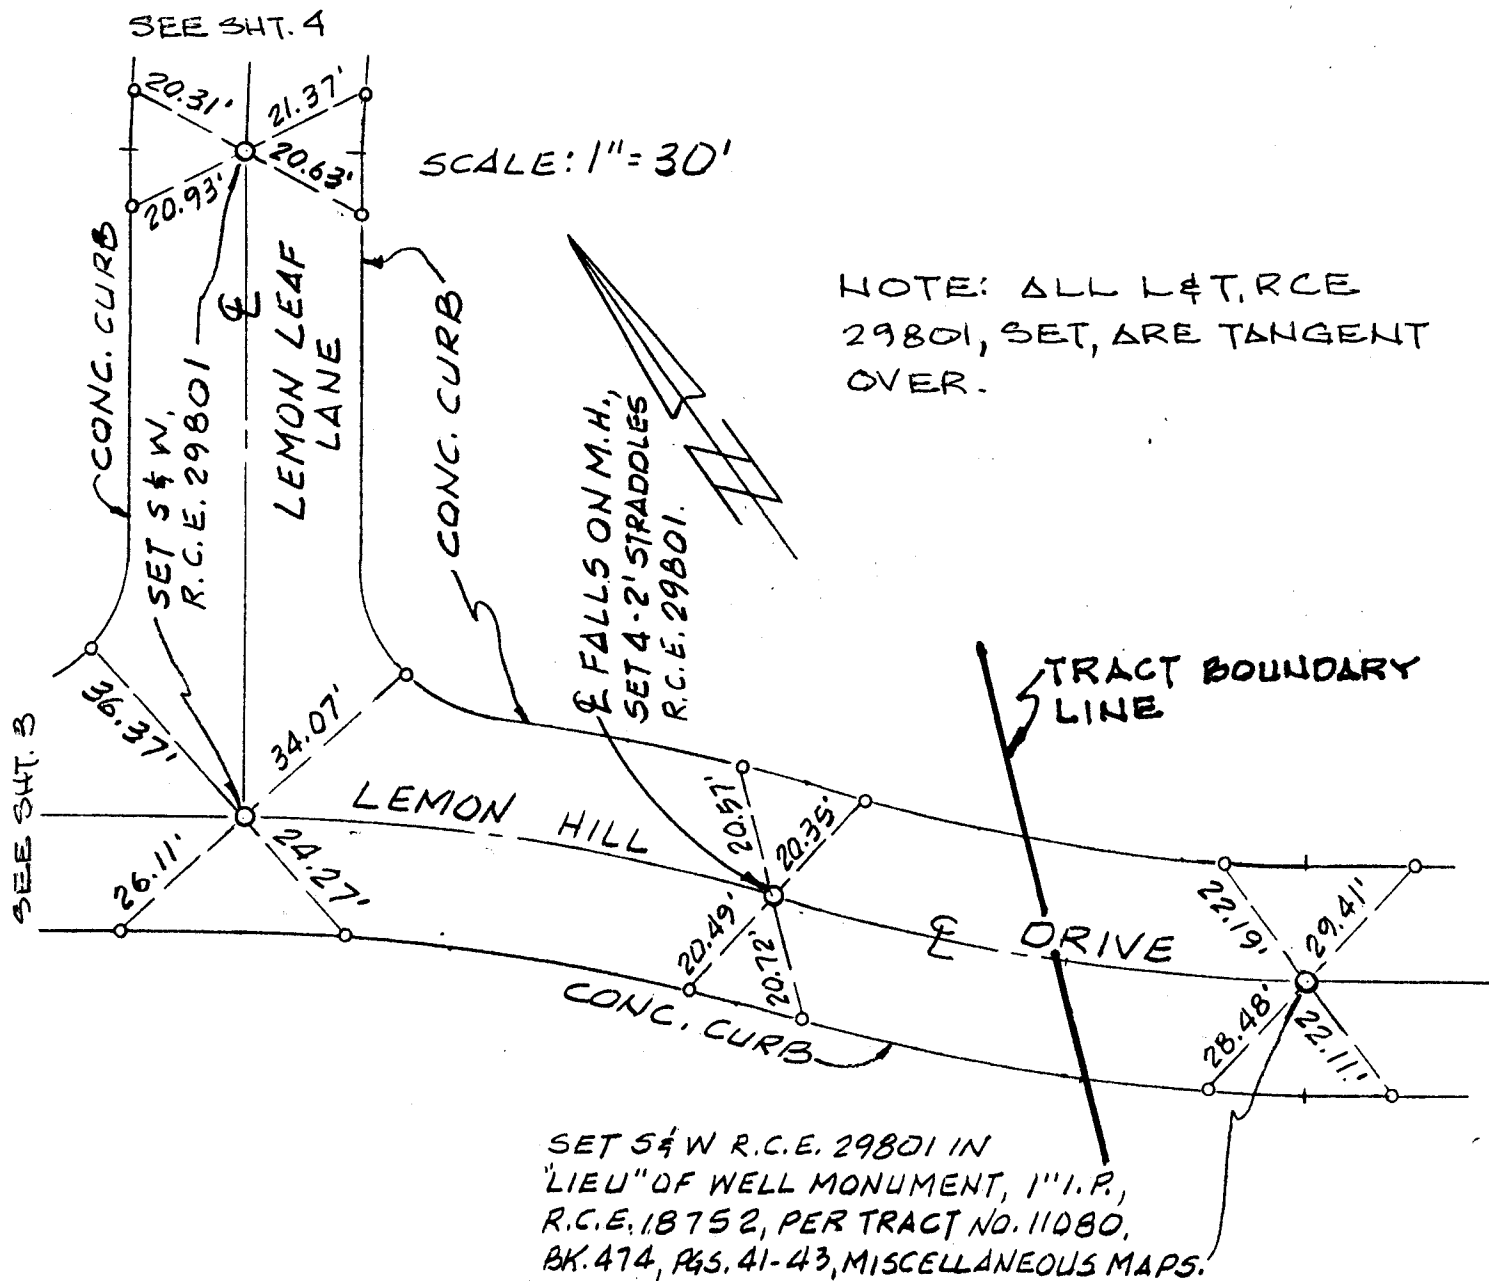

o--- INDICATES SET L&T
R.C.E. 29801, IN CONC.
CURB, UNLESS NOTED
OTHERWISE, IN "LIEU"
OF R.C.E. 18752

NOTE: S 4 W R.C.E. 29801 SET IN
"LIEU" OF SPIKE & TIN,
R.C.E. 18752, PER TRACT NO.
11080, BK. 474, PGS. 41-43,
MISCELLANEOUS MAPS.

THESE NOTES NOT FIELD CHECKED
BY ORANGE COUNTY SURVEYOR

LEMON HILL DR. & LEMON
CIRCLE & LEMON LEAF LN.
(TRACT NO. 11080)


A/5-9 1170

3 OF 6

JRV ENGINEERING
JUSTO R. VILLAR, RCE 29801

11-27-91-12-2-91

ORANGE COUNTY SURVEYOR

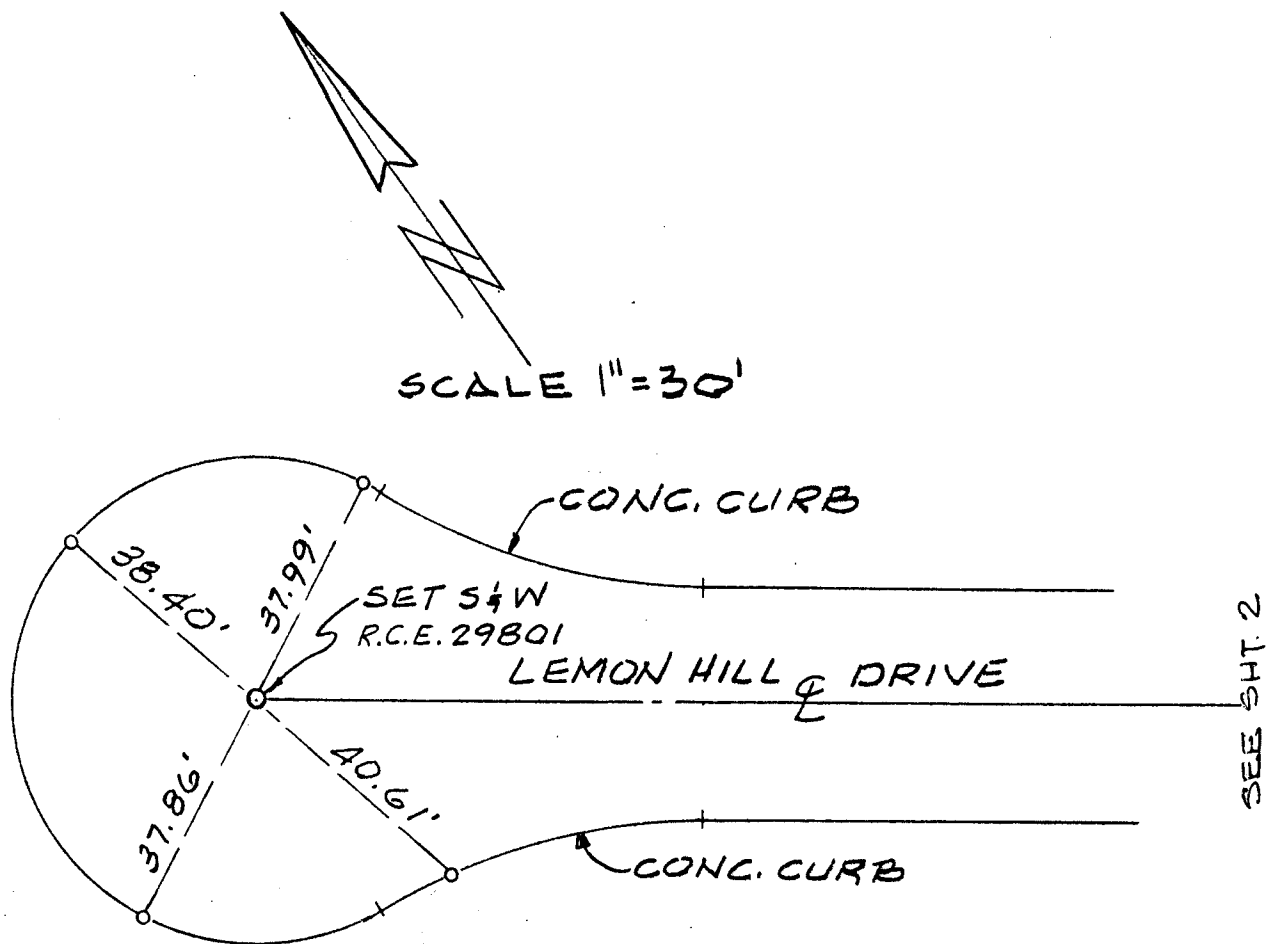

--- INDICATES SET L&T,
R.C.E. 29801 IN CONC.
CURB UNLESS NOTED
OTHERWISE, IN "LIEU"
OF R.C.E. 18752

NOTE: S&W, R.C.E. 29801, SET
IN "LIEU" OF SPIKE & TIN,
R.C.E. 18752, PER TRACT
NO. 11080, BK. 474, PGS. 41-43,
MISCELLANEOUS MAPS.

NOTE: ALL L&T, RCE 29801,
SET, ARE TANGENT OVER

THESE NOTES NOT FIELD CHECKED
BY ORANGE COUNTY SURVEYOR


LEMON HILL DR & LEMON
CIRCLE & LEMON LEAF LN
(TRACT NO. 11080)
JRV ENGINEERING
JUSTO R. VILLAR, RCE 29801

A/5-9 1171

4 OF 6

11-27-91-12-2-91

ORANGE COUNTY SURVEYOR

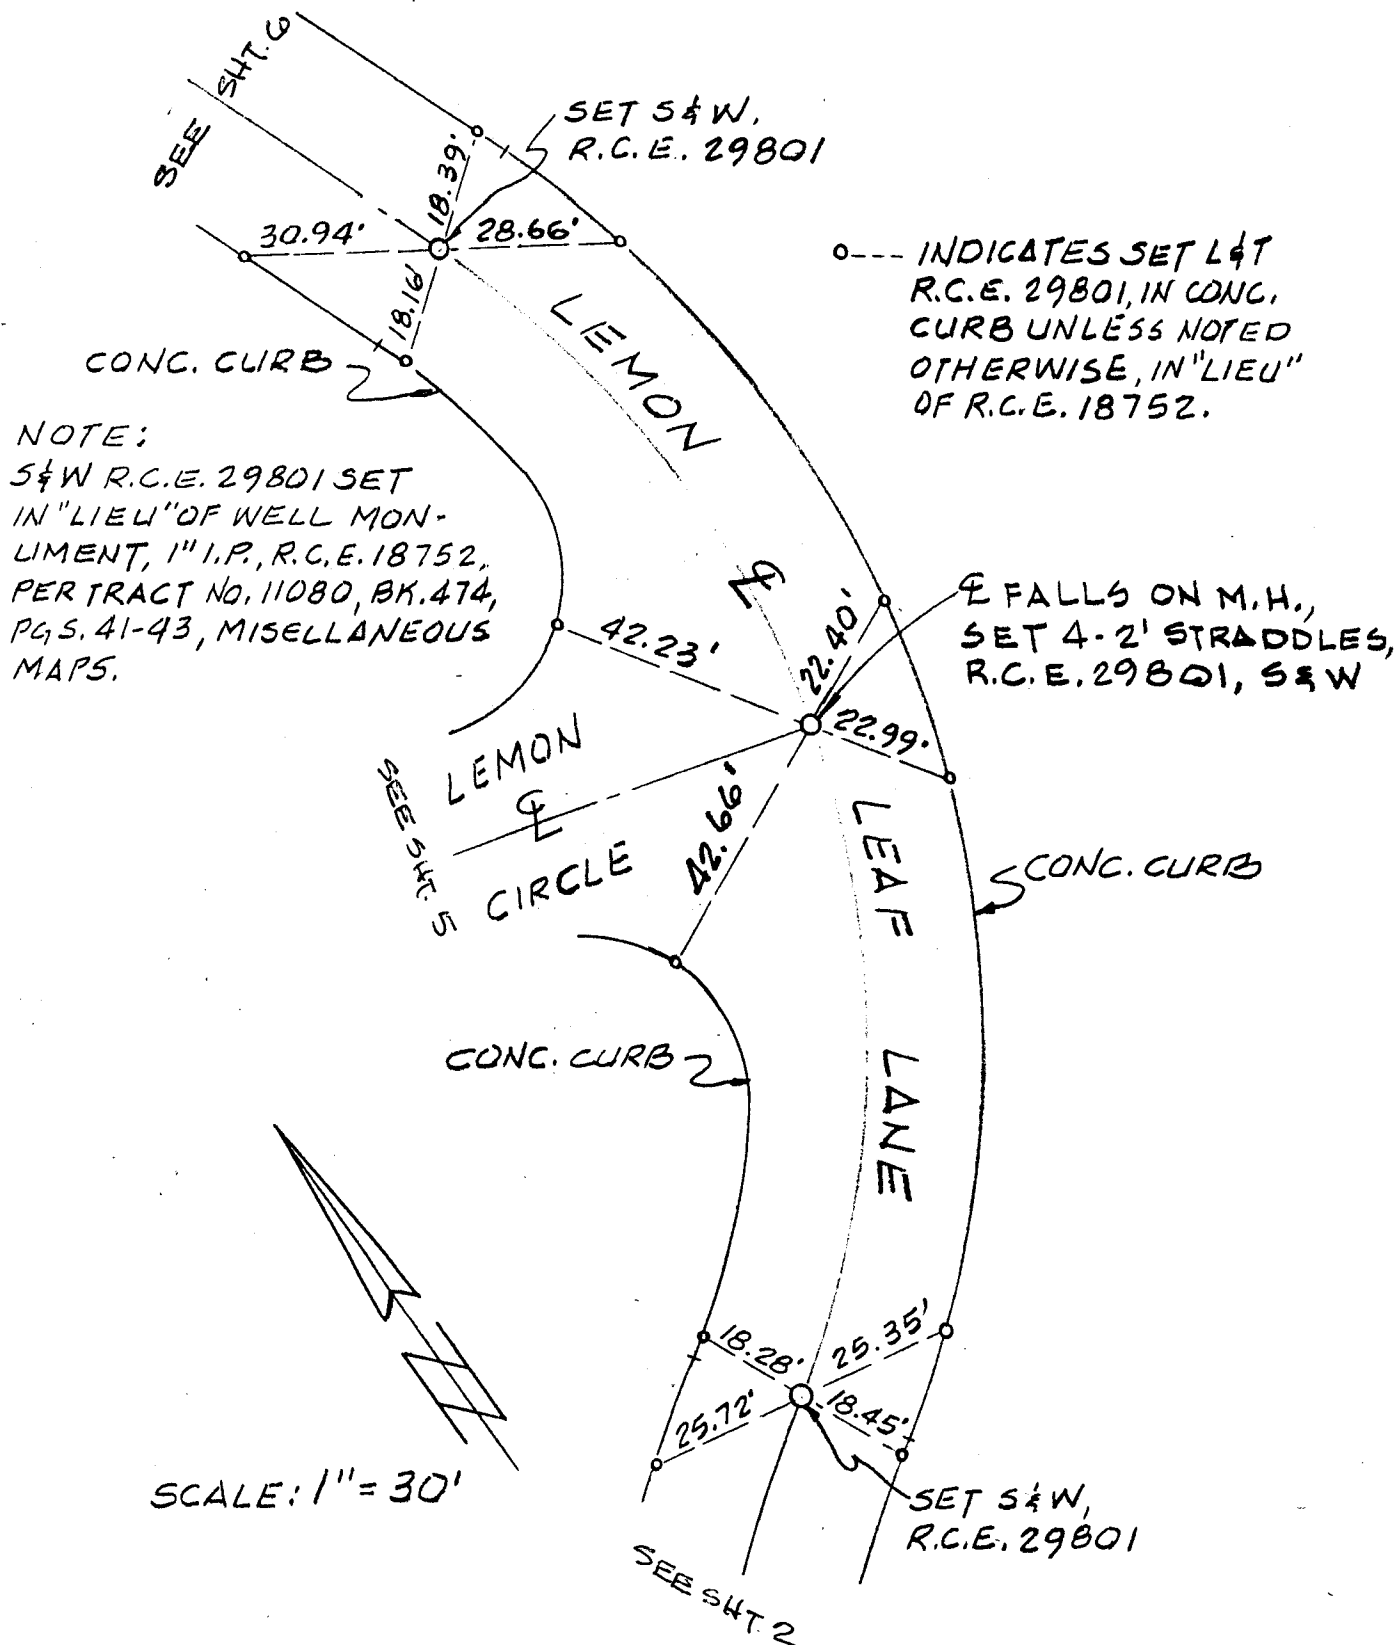

NOTE: ALL L&T, RCE 29801,
SET, ARE TANGENT OVER

THESE NOTES NOT FIELD CHECKED
BY ORANGE COUNTY SURVEYOR

LEMON HILL DR. & LEMON
CIRCLE & LEMON LEAF LN.
(TRACT NO. 11080)


A/5-9 1172

5 OF 6

DESIGNED BY JRV ENGINEERING
JUSTO R. VILLAR, RCE 29801


NO. 11-27-91-12-2-91

ORANGE COUNTY SURVEYOR

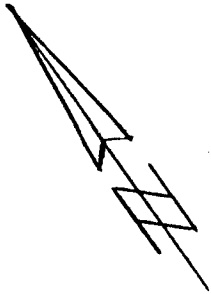

NOTE: ALL L&T, RCE 29801,
SET, ARE TANGENT OVER

SCALE: 1"=30'

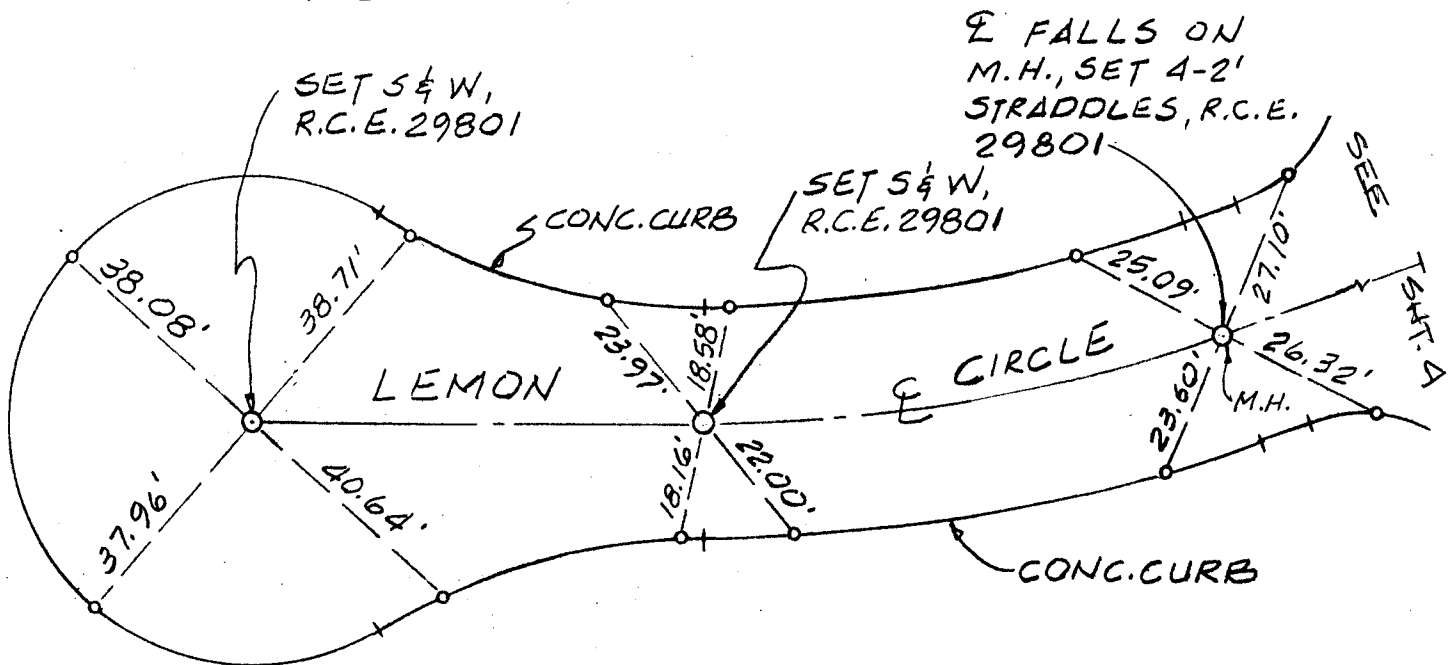

o--- INDICATES SET L & T,
R.C.E. 29801 IN CONC.
CURB UNLESS NOTED
OTHERWISE, IN "LIEU"
OF R.C.E. 18752

NOTE: S & W R.C.E. 29801, SET
IN "LIEU" OF SPIKE & TIN,
R.C.E. 18752, PER TRACT
NO. 11080, BK. 474, PGS 41-43,
MISCELLANEOUS MAPS.

THESE NOTES NOT FIELD CHECKED
BY ORANGE COUNTY SURVEYOR

LEMON HILL DR. & LEMON
CIRCLE & LEMON LEAF LN.
(TRACT. NO. 11080)
JRV ENGINEERING
JUSTO R. VILLAR, RCE 29801

A/5-9 1173

6 OF 6

11-27-91 - 12-2-91

ORANGE COUNTY SURVEYOR

NOTE: ALL L&T, RCE 29801,
SET, ARE TANGENT OVER

