


E Ties by: Voorheis-Trindle-Nelson Co. Inc.
Frank W. Richardson, L.S. 2921

THESE NOTES NOT FIELD CHECKED
BY ORANGE COUNTY SURVEYOR

Party:
J. Knox
11-30-66

MICROFILM

OCT 1972

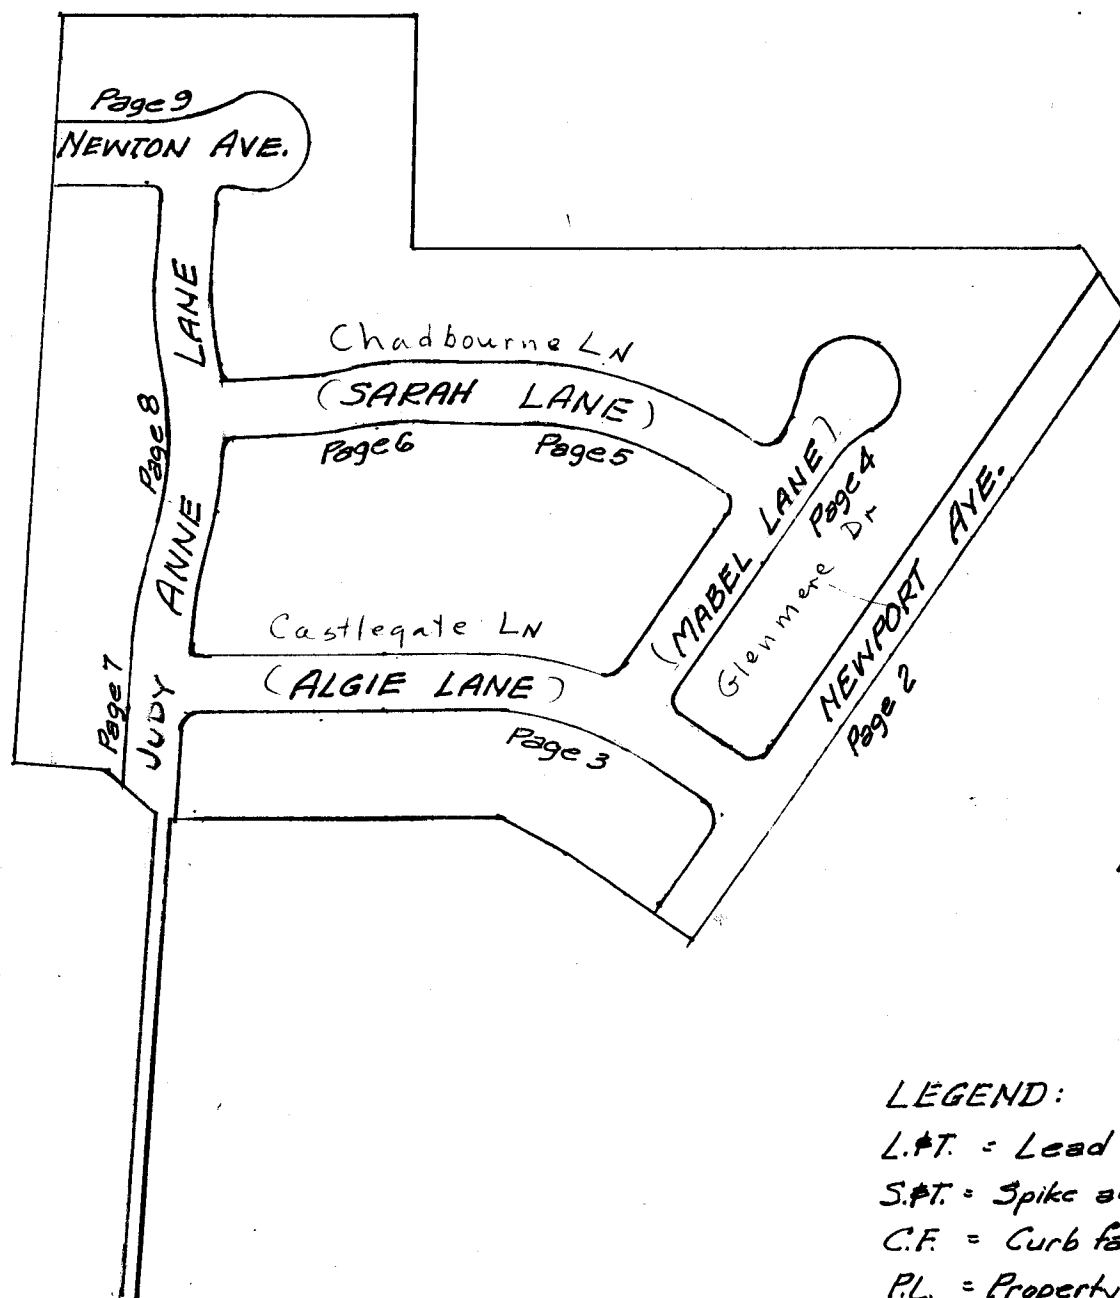

No Scale


LEGEND:

- L.#T. = Lead and tack
- S.#T. = Spike and tin
- C.F. = Curb face
- P.L. = Property line

THESE NOTES NOT FIELD CHECKED
BY ORANGE COUNTY SURVEYOR

MICROFILM


OCT 1972

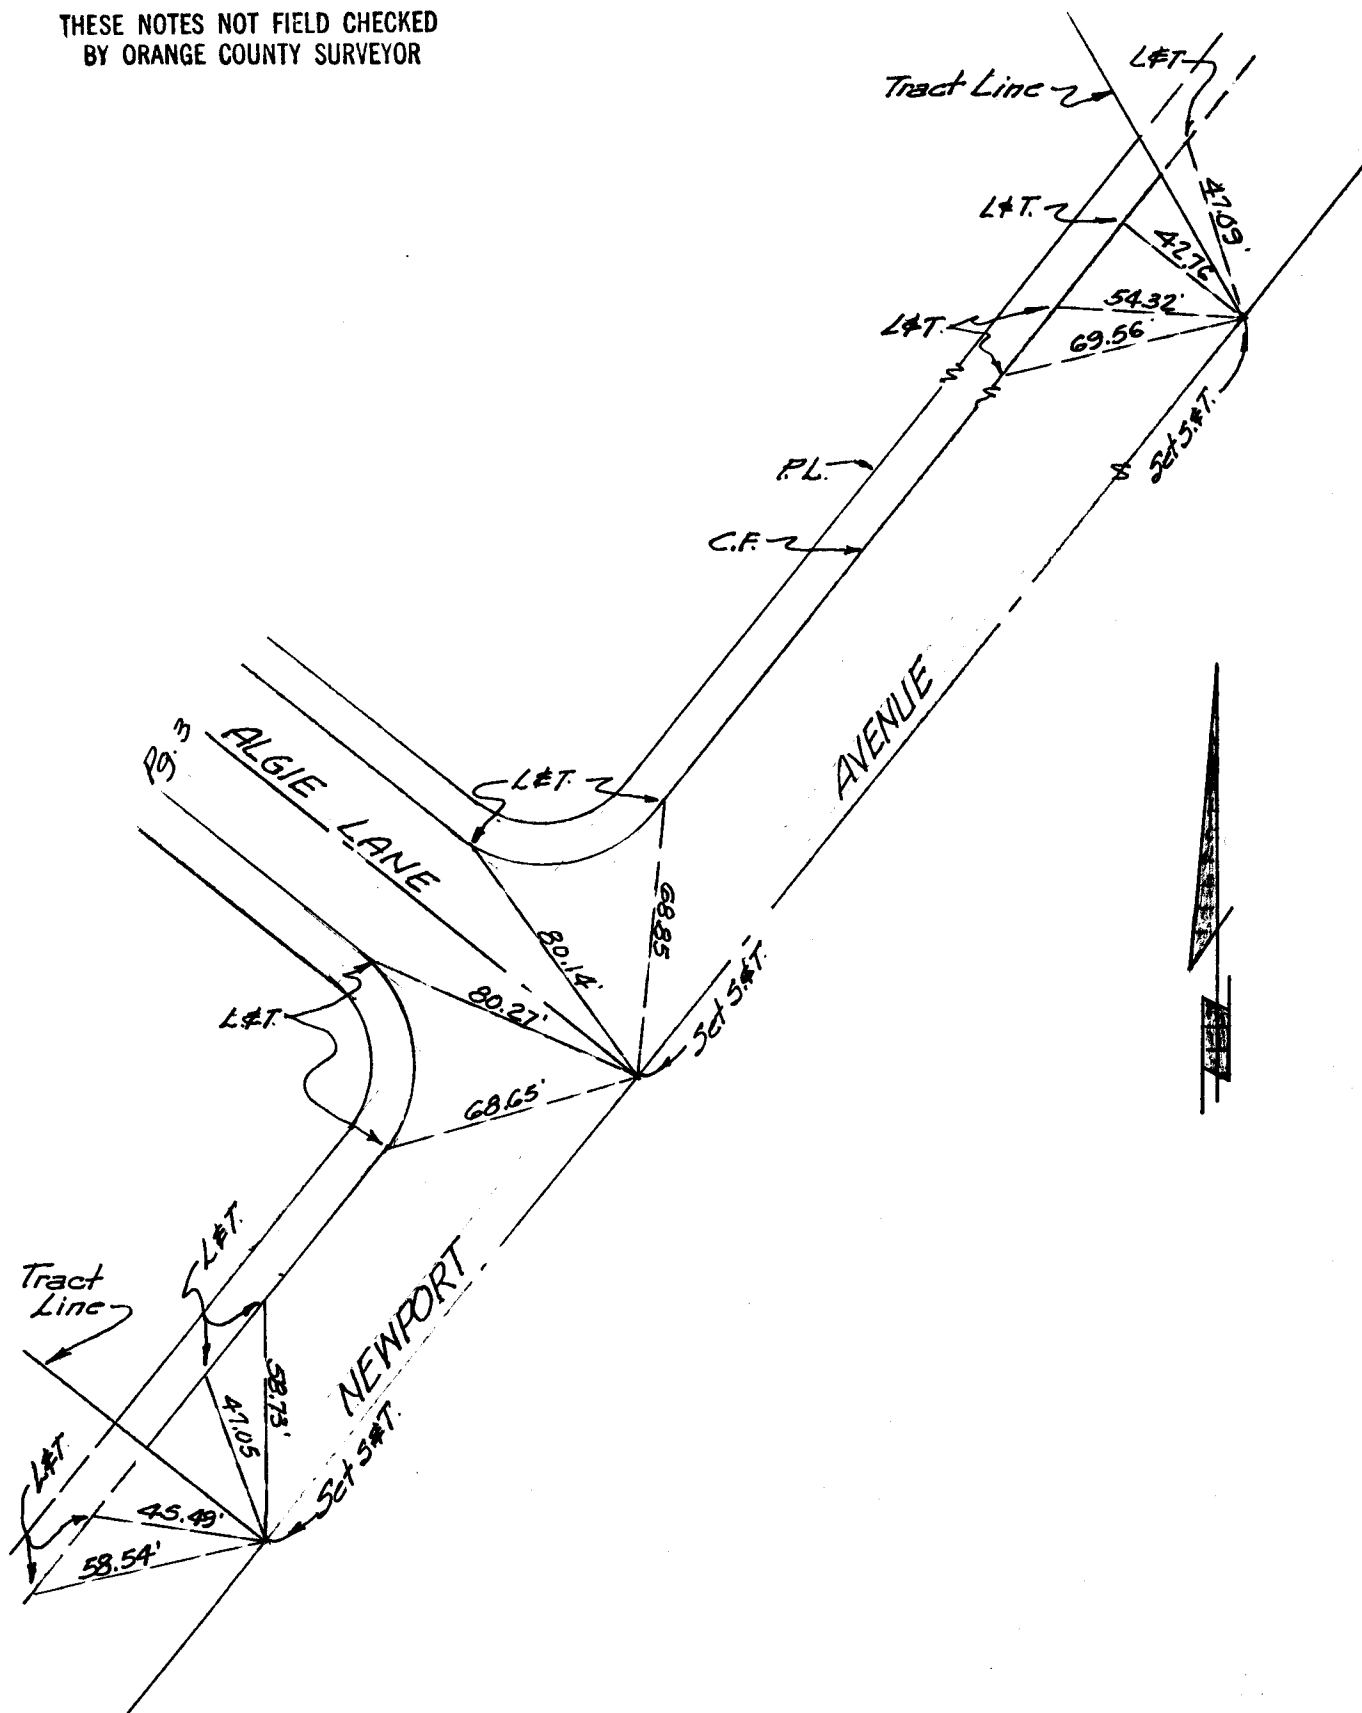

THESE NOTES NOT FIELD CHECKED
BY ORANGE COUNTY SURVEYOR


MICROFILMED

OCT 1972

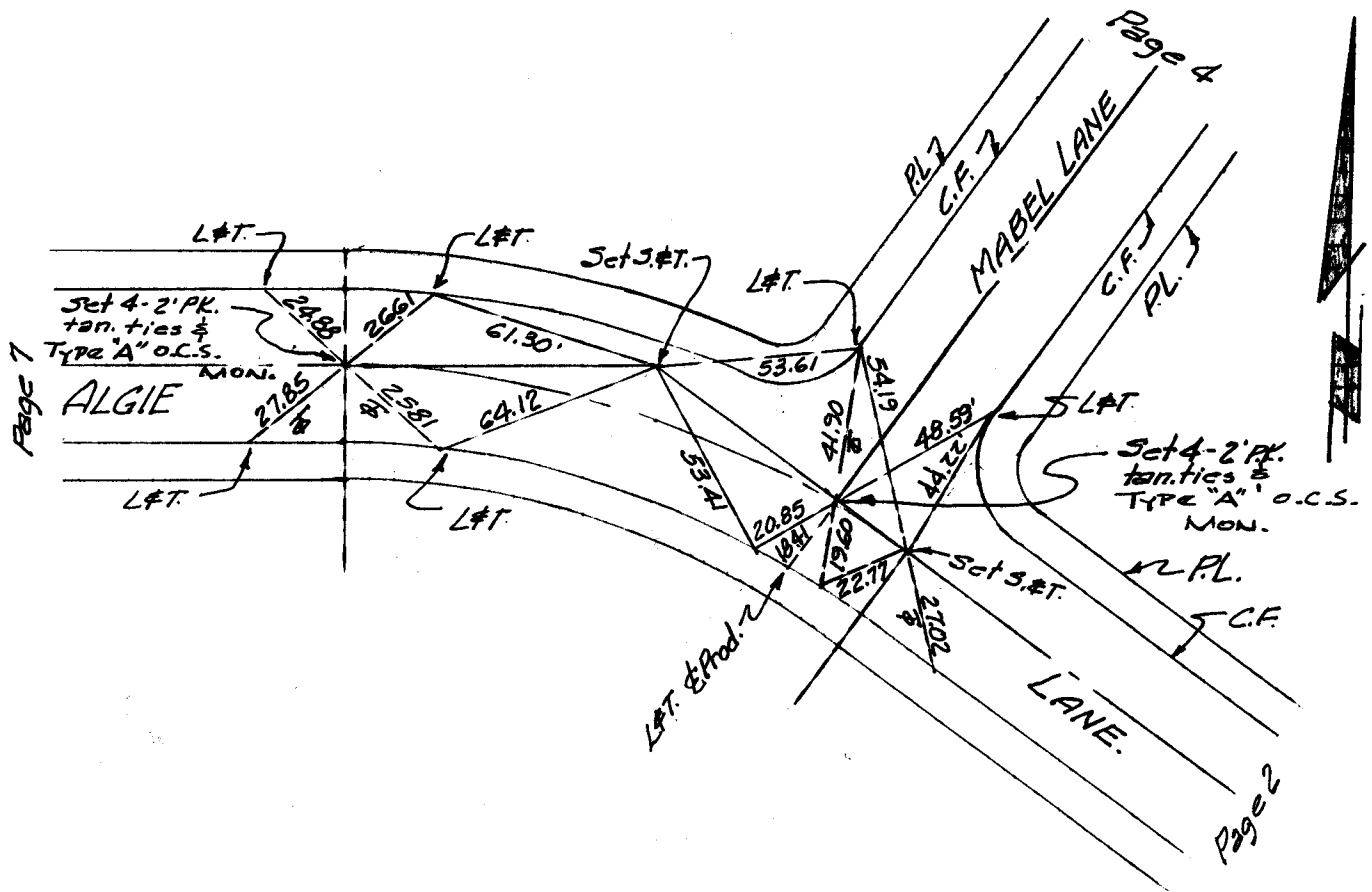


MICROFILM

OCT 1972

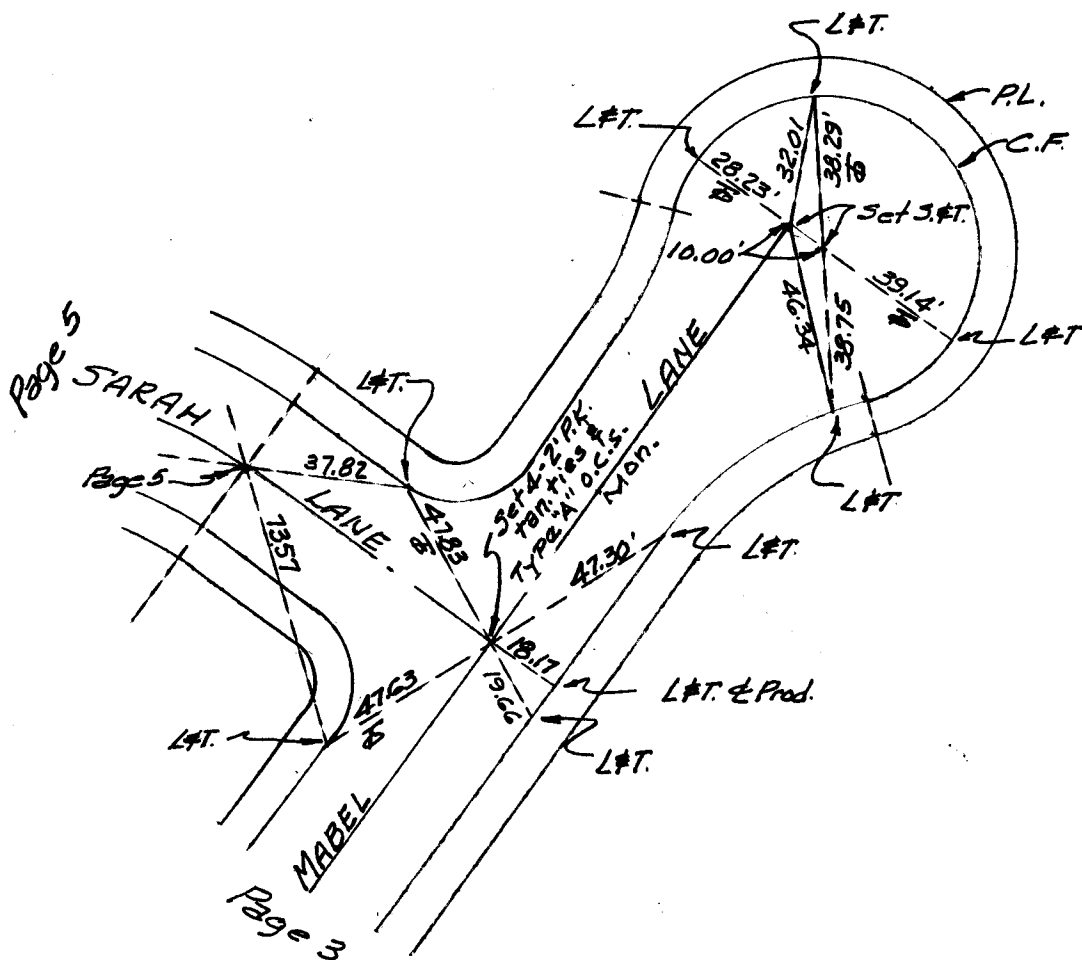

THESE NOTES NOT FIELD CHECKED
BY ORANGE COUNTY SURVEYOR

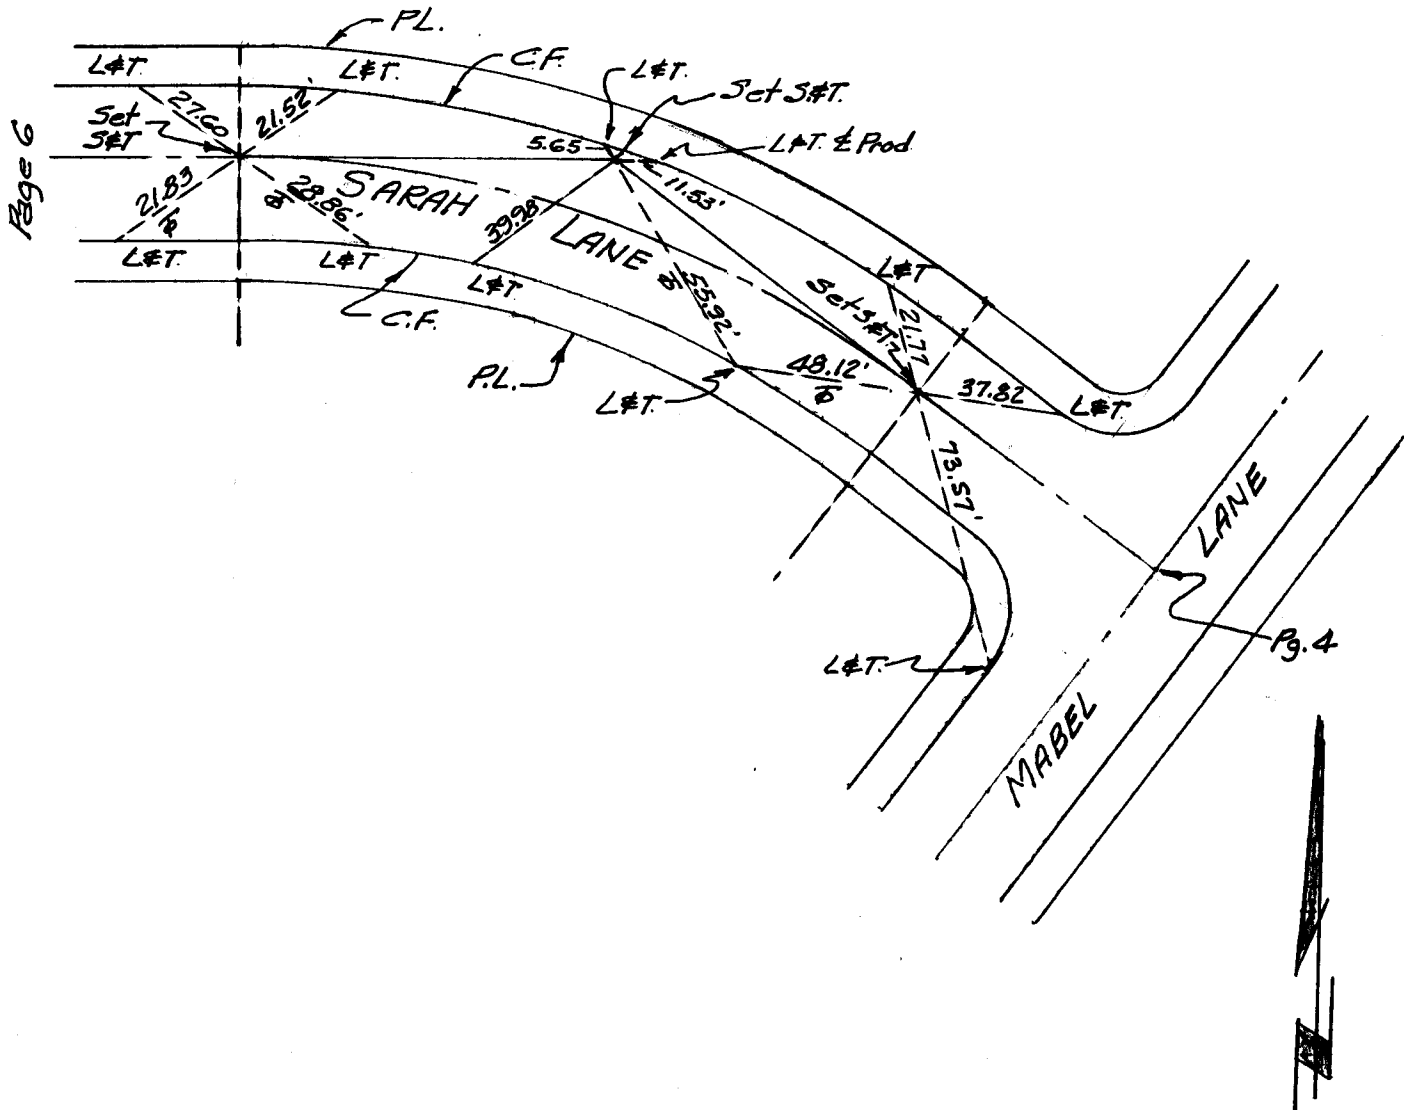


MICROFILM

OCT 1972

THESE NOTES NOT FIELD CHECKED
BY ORANGE COUNTY SURVEYOR

MICROFILM *

OCT 1961

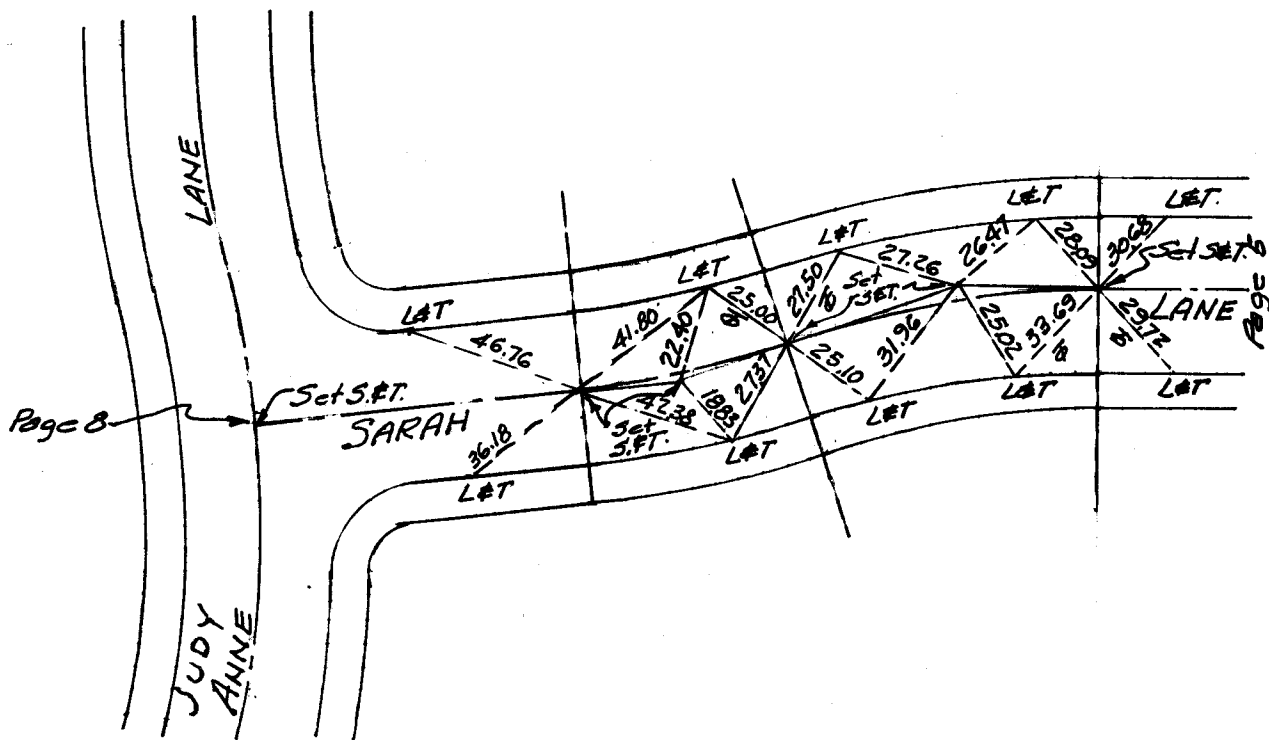


THESE NOTES NOT FIELD CHECKED
BY ORANGE COUNTY SURVEYOR

MICROFILMED

OCT 1972


Page 8

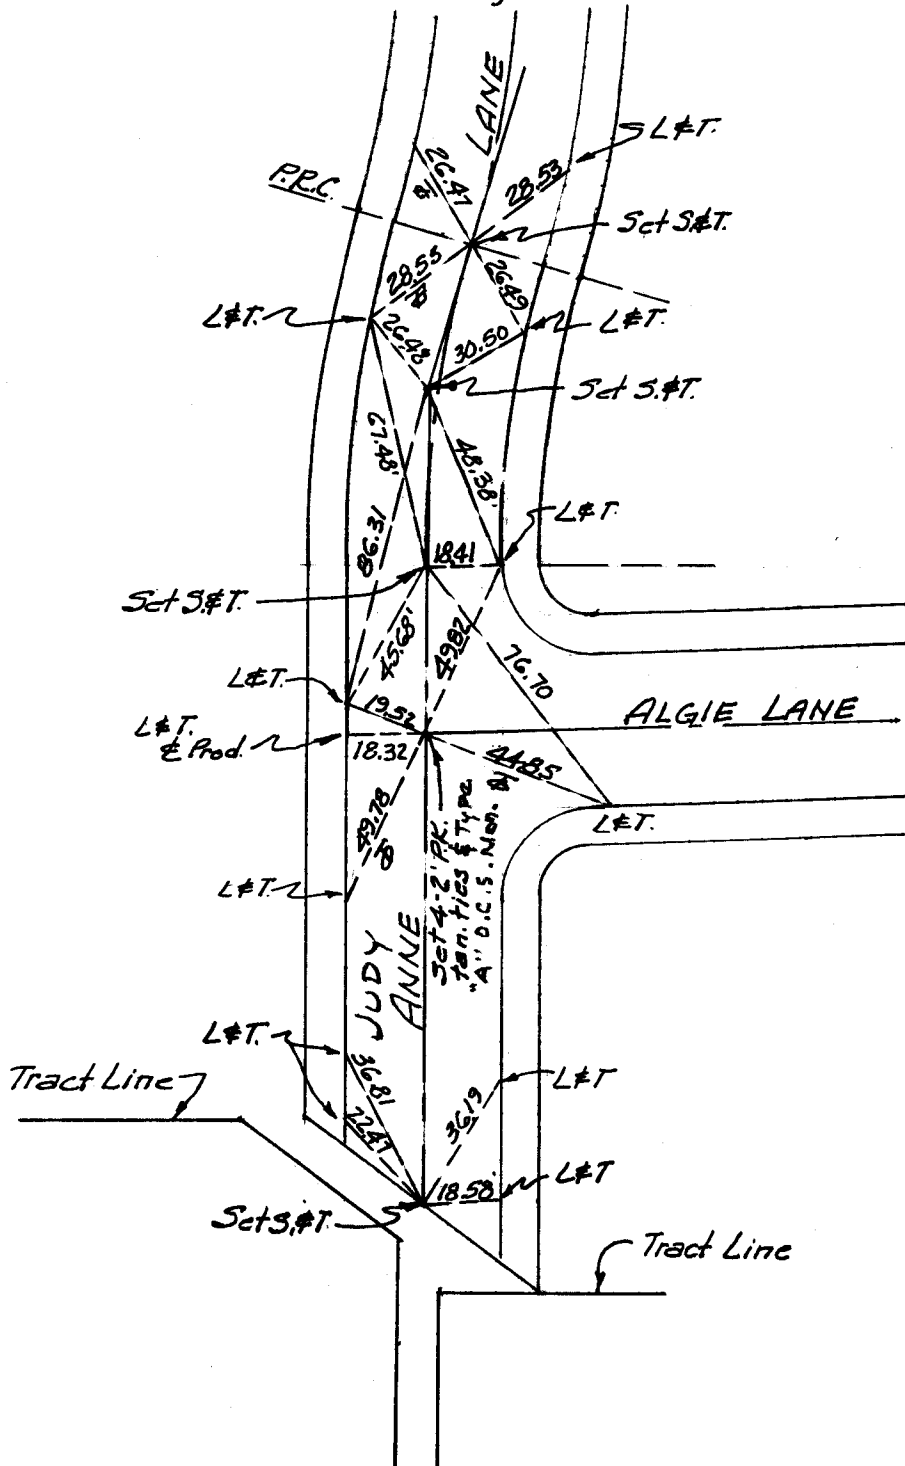


Page 3



7161 130

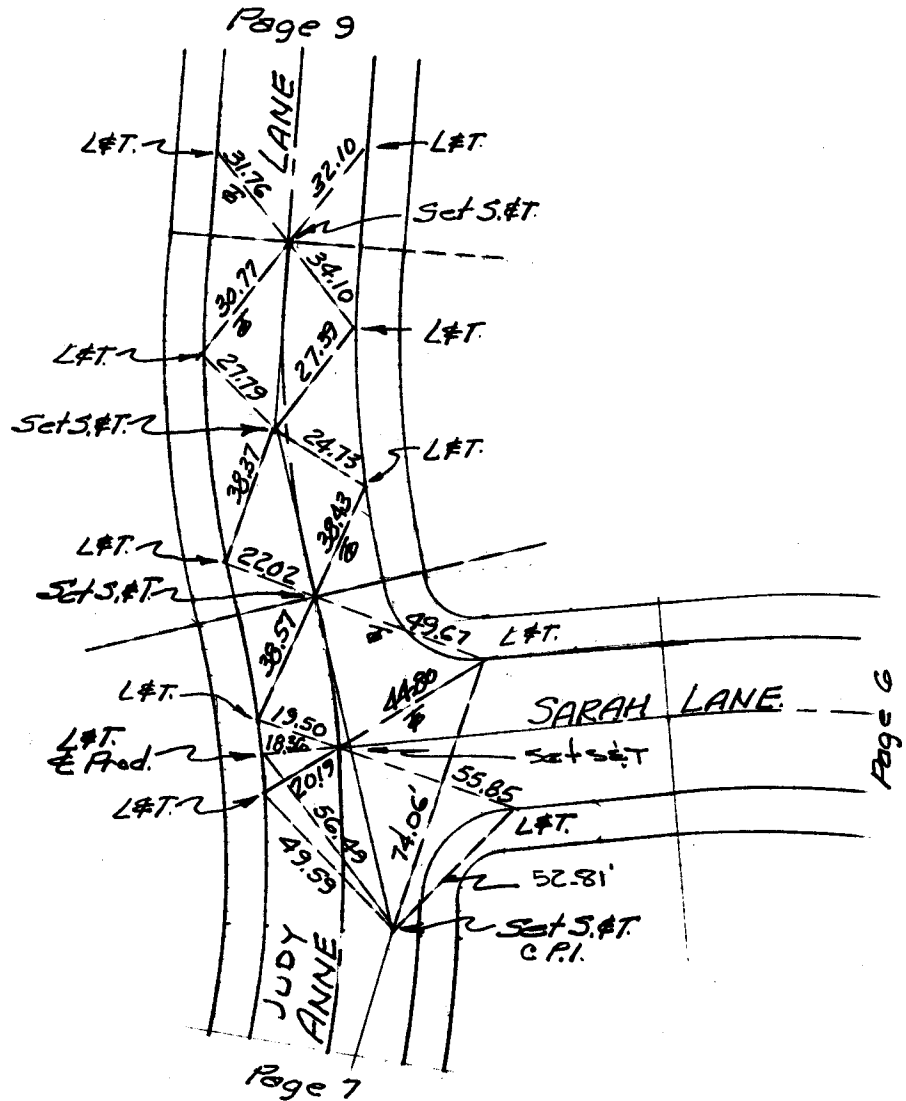

THESE NOTES NOT FIELD CHECKED
BY ORANGE COUNTY SURVEYOR

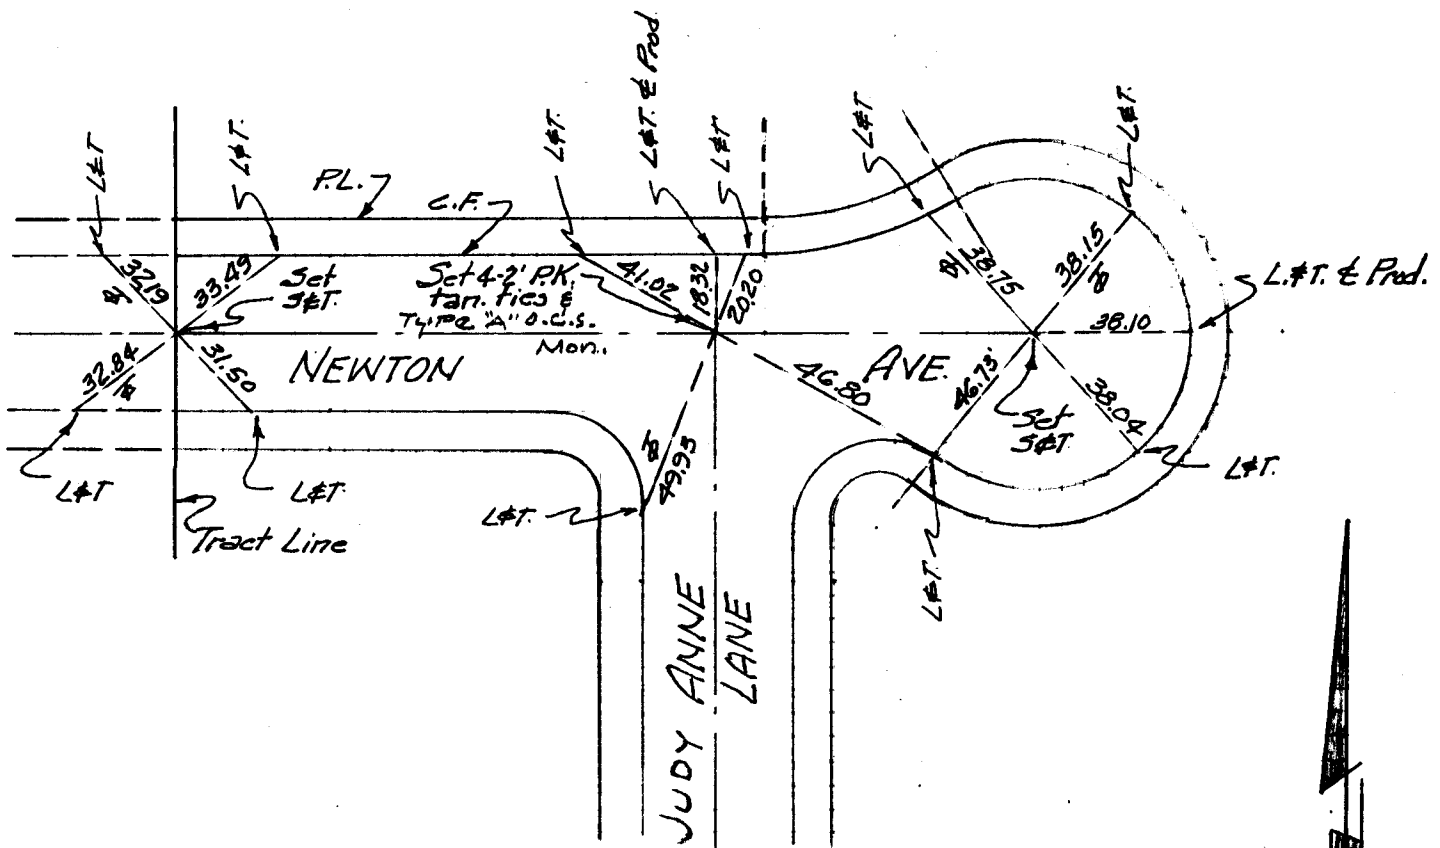

MICROF
OCT 19/2