


CORNER RECORD

Document Number 2002-1150
City of Tustin County of Orange, California

Brief Legal Description Int. Fairhaven / Ethelbee, EC - Fairhaven

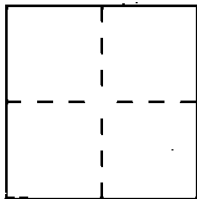

CORNER TYPE

Government Corner ☐ Control ☒
Meander ☐ Property ☐
Rancho ☐ Other ☐
Date of Survey Nov, 2001

COORDINATES (Optional)

N. _____
E. _____
Zone _____ Datum _____
Elev. _____

Corner — Left as found ☐ Found and tagged ☐ Established ☒ Reestablished ☒ Rebuilt ☐

Identification and type of corner found: Evidence used to identify or procedure used to establish or reestablish the corner:


centerline control set per caltrans project plans,
contract no. 12-013404; centerline plans, reset
per caltrans SCM ORA-055 12.5 A

A description of the physical condition of the monument as found and as set or reset: physical
descriptions are as noted on reverse side

SURVEYOR'S STATEMENT

This Corner Record was prepared by me or under my direction in conformance with the Land Surveyors' Act on Nov. 10 19 2001

Signed [Signature] L.S. or R.C.E. Number 6585

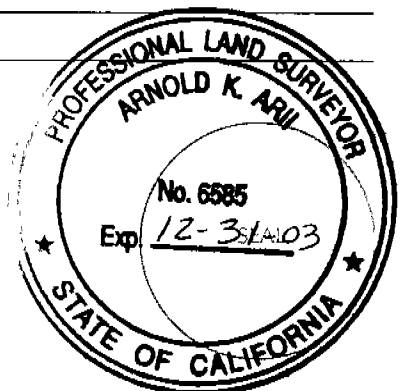

COUNTY SURVEYOR'S STATEMENT


This Corner Record was received JUL 11 2002 19 and examined and filed AUG - 2 2002 19

Signed Michael K. Sullivan Title DEPUTY COUNTY SURVEYOR



County Surveyor's Comment _____

- Set Brd spike w/ punchmark & washer stamped "caltrans" per project plans for route 55 widening, contract no 12-012404
- Rd aluminum cap, stamped Orange County Surveyor EBEE NO REF.
- Set lead, tack & tag, stamped "caltrans"
- △ Set outspike w/ punchmark & washer stamped "caltrans" to replace destroyed monument per caltrans SCA 125-12.5A PA # 14

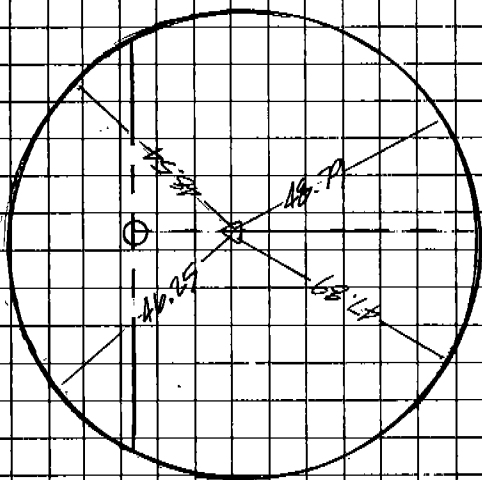

DETAIL

