


RECEIVED FROM MCDANIEL ENG. 11/60

THESE NOTES NOT FIELD CHECKED
BY ORANGE COUNTY SURVEYOR

THESE NOTES NOT FIELD CHECKED
BY ORANGE COUNTY SURVEYOR

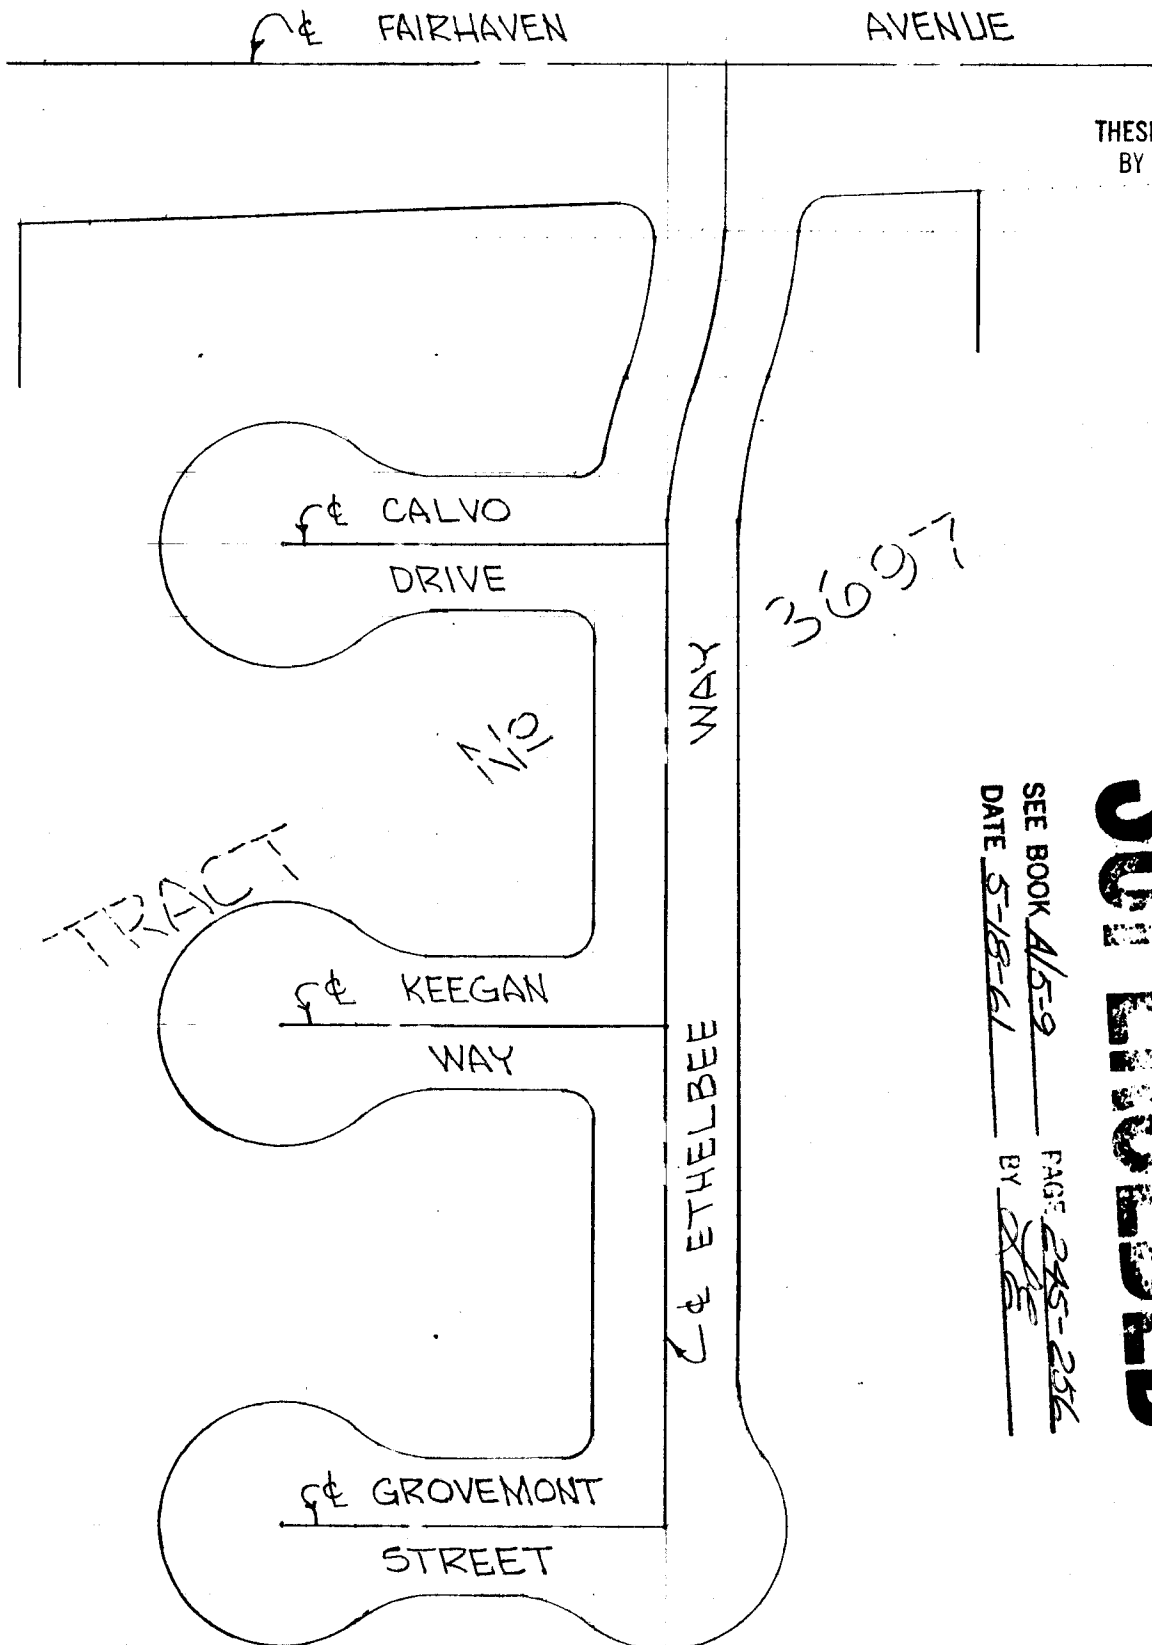



SEE BOOK A/5-9 PAGE 245-256
DATE 5-18-61 BY AS

ϕ TIES, FAIRHAVEN AVE. &
ETHEL BEE WAY

A/5-9

PAGE 2 OF 5 182

RECEIVED MCDANIEL ENG. 11/60

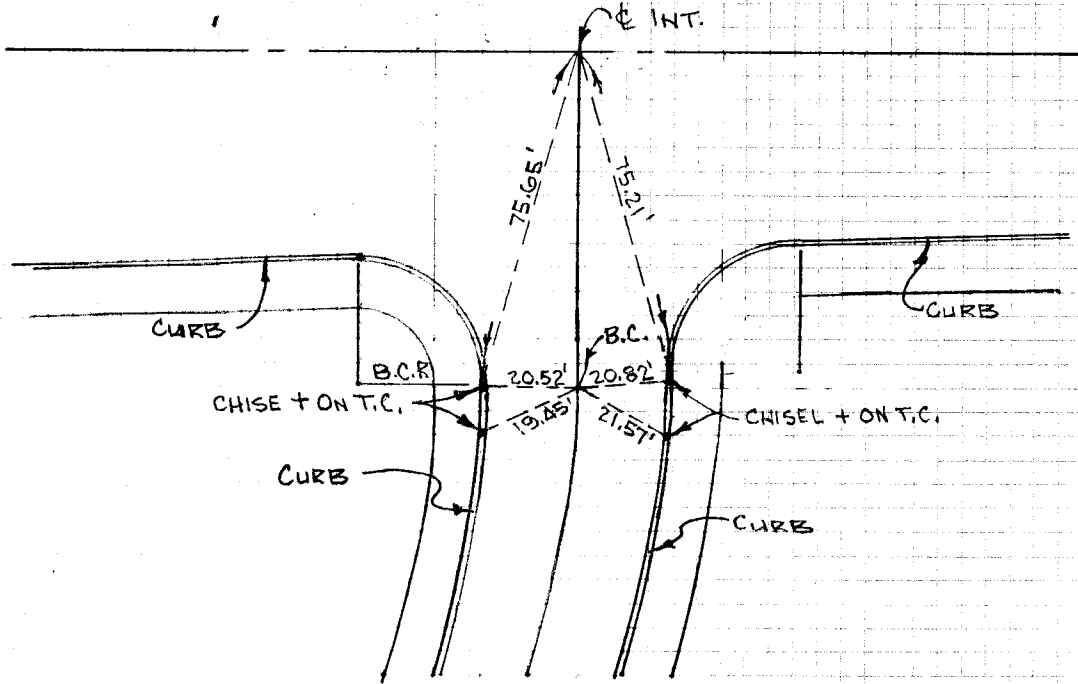

SUPERSEDED

SEE BOOK A/5-9

PAGE 245-256

DATE 5-18-61

BY LE

ORANGE COUNTY SURVEYOR

DATE

CHECKED BY

± TIES, ETHELBEE WAY &
CALVO DRIVE

A/5-9

3 OF 5 183


RECEIVED MCDANIEL ENG. 11/60


THESE NOTES NOT FIELD CHECKED
BY ORANGE COUNTY SURVEYOR

THESE NOTES NOT FIELD CHECKED
BY ORANGE COUNTY SURVEYOR

SUPERSEDED

SEE BOOK A/5-9 PAGE 245-256
DATE 5-18-61 BY SE

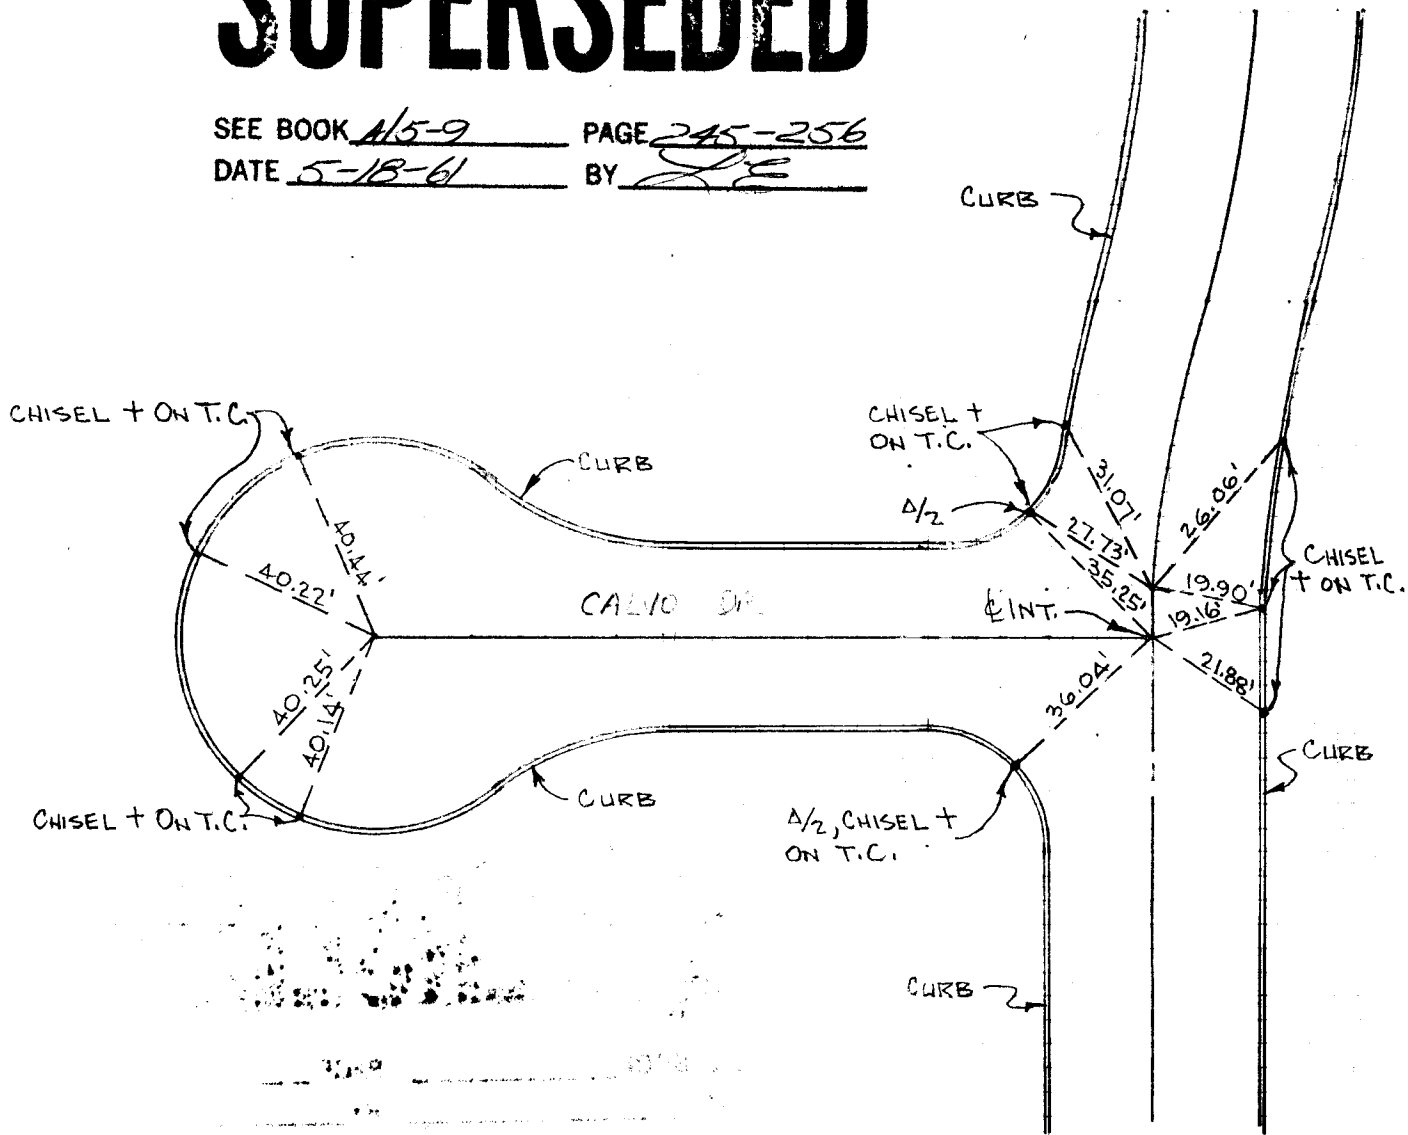

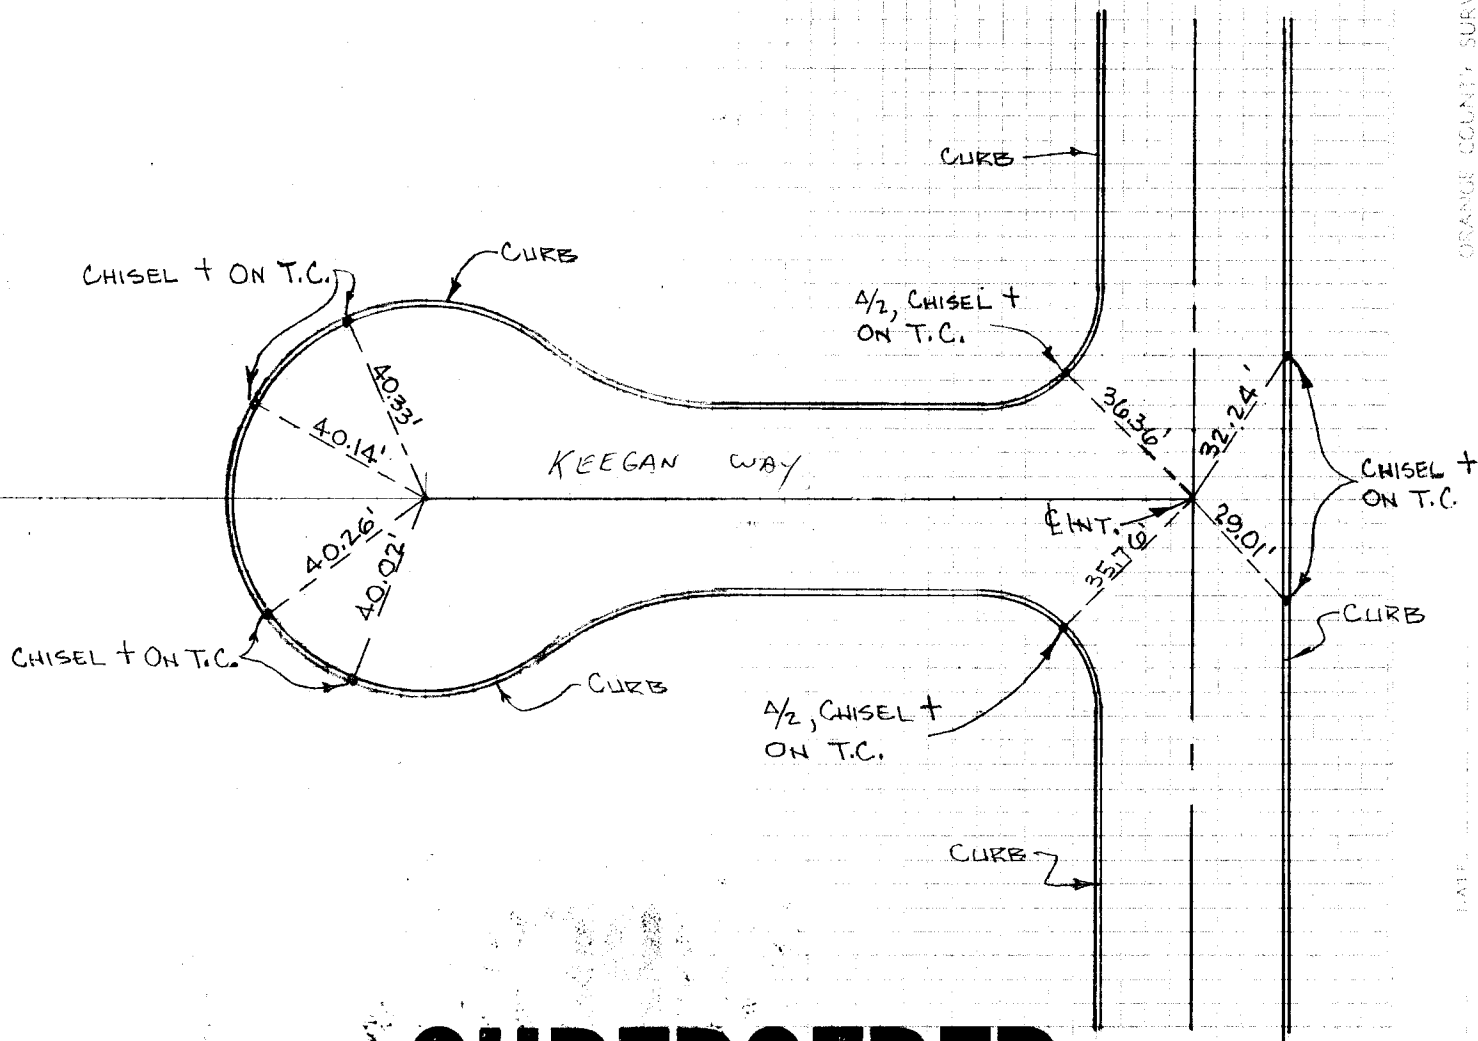

ORANGE COUNTY SURVEYOR

L.A.P.

CHECKED BY

SUPERSEDED

SEE BOOK A/5-9 PAGE 245-256
DATE 5-18-61 BY LE


¢ TIES, ETHELBEE WAY &
GROVEMONT STREET

A/5-9

5 OF 5 185

RECEIVED MCDANIEL ENG. 11/60

THESE NOTES NOT FIELD CHECKED
BY ORANGE COUNTY SURVEYOR
THESE NOTES NOT FIELD CHECKED
BY ORANGE COUNTY SURVEYOR

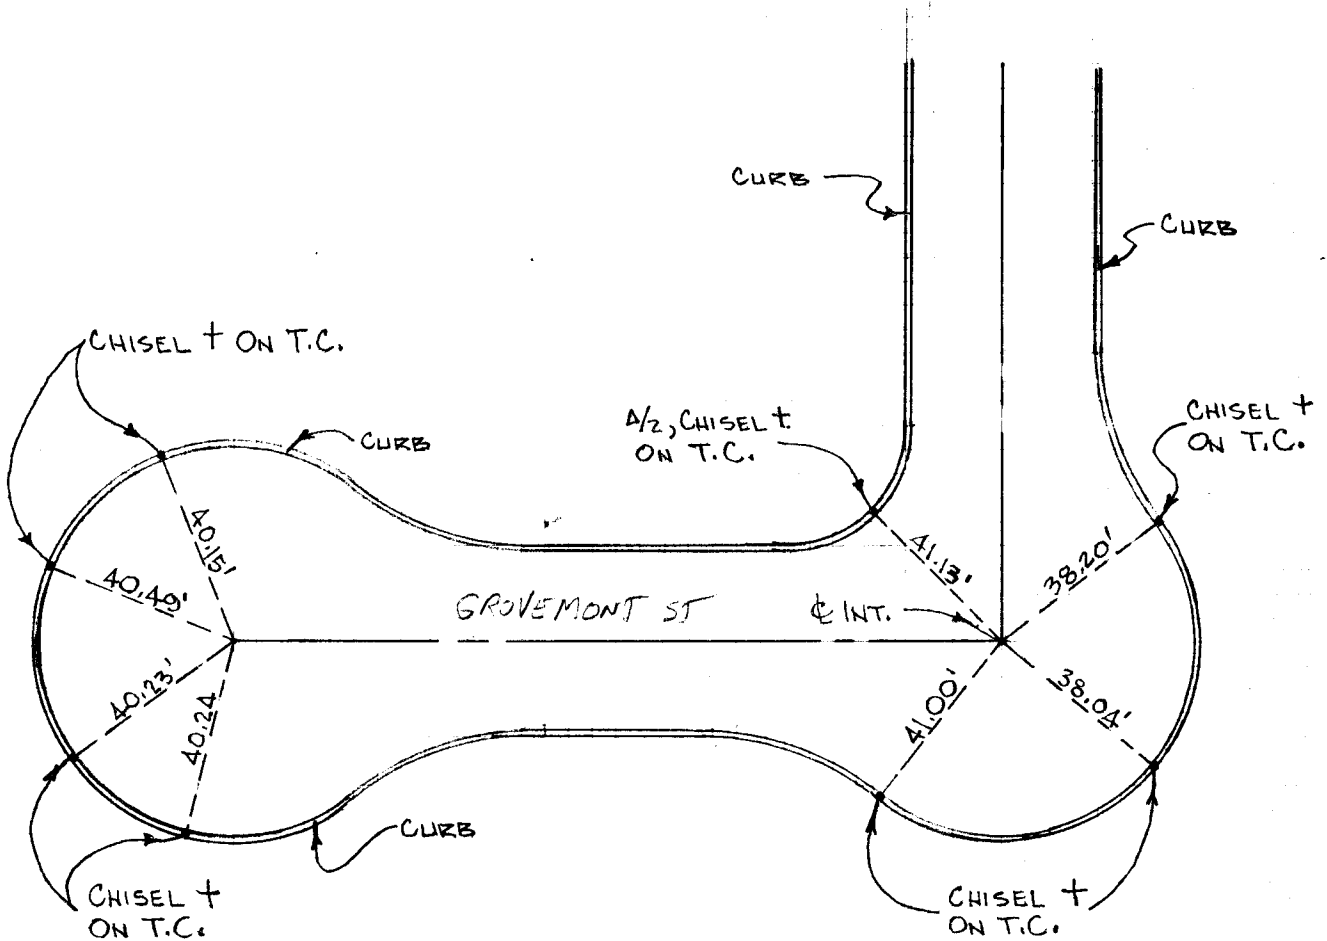

SUPERSEDED

SEE BOOK A/5-9 PAGE 245-256
DATE 5-18-61 BY LE