


1-12-61

JOHN SIEGEL & CO.
RCE 10770

THESE NOTES NOT FIELD CHECKED
BY ORANGE COUNTY SURVEYOR

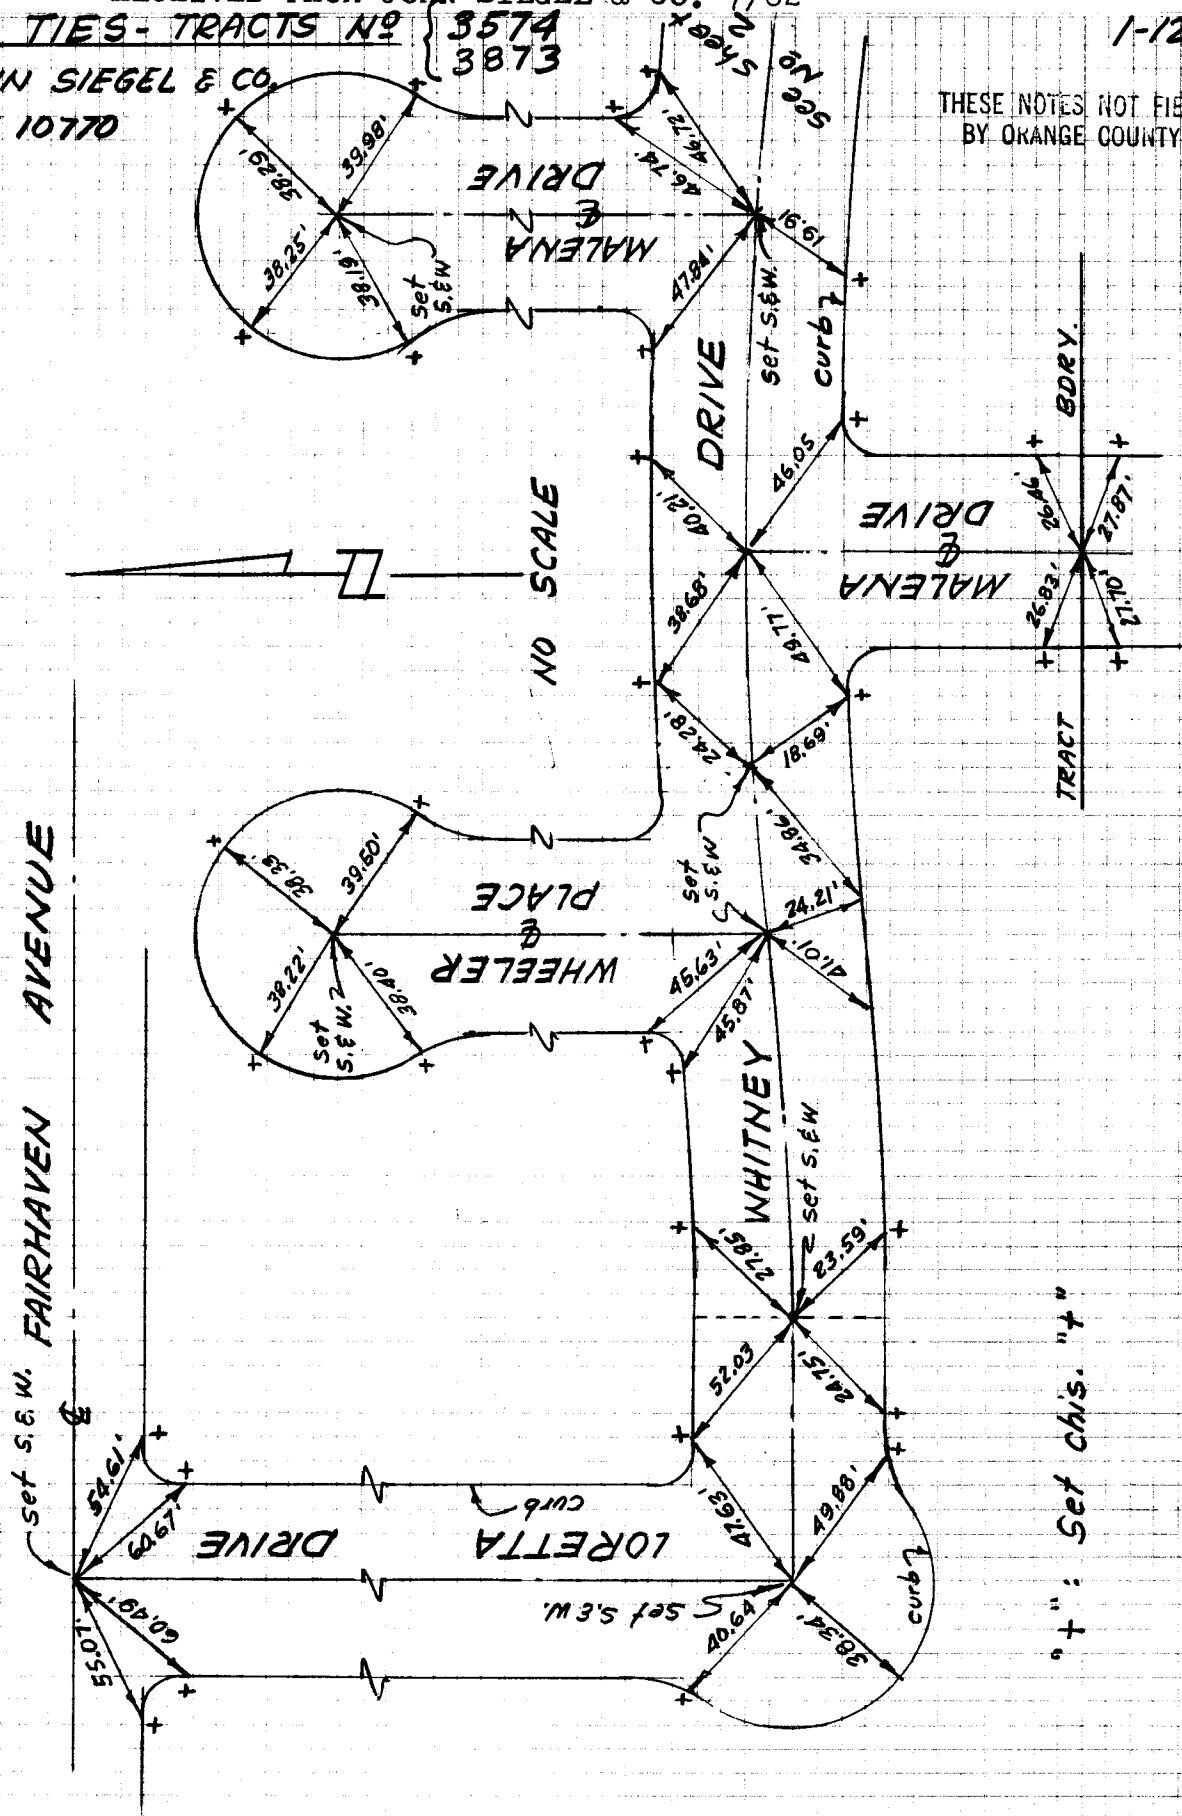

" + " : Set chis. " + "

RECEIVED FROM JOHN SIEGEL & CO. 7/62

Sheet 2 of 2 sheets

4 TIES - TRACTS NO 3574 & 3873

JOHN SIEGEL & CO.

1-12-61

R.C.E. 10770

THESE NOTES NOT FIELD CHECKED
BY ORANGE COUNTY SURVEYOR

