


Block: E8E2, Module: 72
CORNER RECORD

WM 200

Document Number CR98-320

City of UNINCORPORATED ORANGE COUNTY County of ORANGE, California

Brief Legal Description 310'± SOUTH OF INTERSECTION OF FAIRHAVEN AV. & FLINT DR

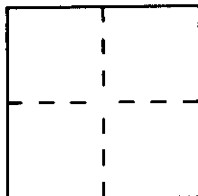

CORNER TYPE

Government Corner ☐ Control ☒
Meander ☐ Property ☐
Rancho ☐ Other ☐
Date of Survey 6/22/98

COORDINATES

(Optional)

N 2228265.310
E 6084275.099
Zone 11 Datum 83
Elev 1991.35 EPOCH
(OCS ADJUST)

Corner — Left as found ☐ Found and tagged ☐ Established ☐ Reestablished ☒ Rebuilt ☐


Identification and type of corner found Evidence used to identify or procedure used to establish or reestablish the corner
REESTABLISHED MONUMENT BY HOLDING O.C.S.T.B. A/S-9, 1985
BY FLYNN 12-18-85.

A description of the physical condition of the monument as found and as set or reset SET LARGE PUNCHED
CAKE AND 1 1/2" OCS BRASS WASHER IN A/C

SURVEYOR'S STATEMENT

This Corner Record was prepared by me or under my direction in conformance with
the Land Surveyors' Act on 13 JULY 1998

Signed T. Sandefer LS or RCE Number 5967

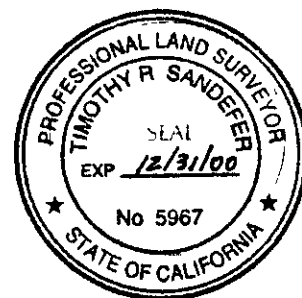

COUNTY SURVEYOR'S STATEMENT

This Corner Record was received JULY 30 1998 and examined
and filed JULY 30 1998

Signed Michael K. Sullivan Title DEPUTY



County Surveyor's Comment

FAIRHAVEN

AV.

(R) = RECORD PER
O.C.S.T.B. A/5-9,
985

FD. LD & T & O.C.S.
TIE TAG IN T.C.
PER O.C.S.T.B.
A/5-9, 985

FD CHIS "t" IN T.C.
PER O.C.S.T.B.
A/5-9, 985

FD CHIS "t" IN T.C.
PER O.C.S.T.B.
A/5-9, 985.

SET LG. PUN.
SPK w/ 1/2"
O.C.S. WASHER,
FLUSH IN A/C.

FD LD & T & O.C.S.
TIE TAG IN T.C.
PER O.C.S.T.B.
A/5-9, 985

FLINT



NO SCALE