

ORANGE COUNTY SURVEYOR SURVEY NOTES

A/5-9 1027

ALIGNMENT INDEX BOOK AND PAGE

ALIGNMENT NOTES PG. 1 OF 26

PPB _____ WORK ORDER NUMBER R20296434

SURVEY NOTES PAGE 1 OF 26

SURVEY COMPLETION DATE 11-8-88

SURVEY FILE NUMBER R 87-55

PROJECT NAME E TIES, AREA 3

SURVEY LIMITS FAIRHAVEN AVE, FROM YORBA ST. E'LY TO HEWES; ALSO TR# 4511 (ALL OF MAUVE DR., SHADEL DR, LIMETREE WAY, & ALLTHORN DR.)

PURPOSE OF SURVEY TO RE-ESTABLISH WITH TIES AND POSSIBLY RE-SET MONUMENTATION THAT HAS BEEN PAVED OVER.

THOMAS BROS.:

BLOCK AND MODULES:

PG 17: F-4, F-5

5852 - 81 THRU 87

PG 18: A-4, A-5,

B-4, B-5

SURVEY NOTE PAGE INDEX:

EQUIPMENT:

PERSONNEL:

TITLE PG 1 OF 26

TOPCON ET-1

DOYLE - P.C.

FAIRHAVEN 2-19 OF 26
NOTES

ENGELMANN - R

TR 4511 20-26 OF 26
NOTES

RUFFING - P

REFERENCES/REMARKS:

DEPUTY COUNTY SURVEYOR'S NOTE:

The purpose of these notes is to show the relationship of the points and/or lines shown hereon to either the control lines, or to each other. The Deputy County Surveyor does not warrant at this time, that the points or lines shown hereon are true and correct boundary, deed, or control points or lines. Without further analysis, the interpretation of these notes is left to the discretion of the user.

John Canas
Deputy County Surveyor

By: John Thomas
Supervising Land Surveyor


DOYLE

NOTES: RUFFING


9.12.88


NOTE: DISTANCES SHOT WITH TOTAL
STATION.

TRACT 2007

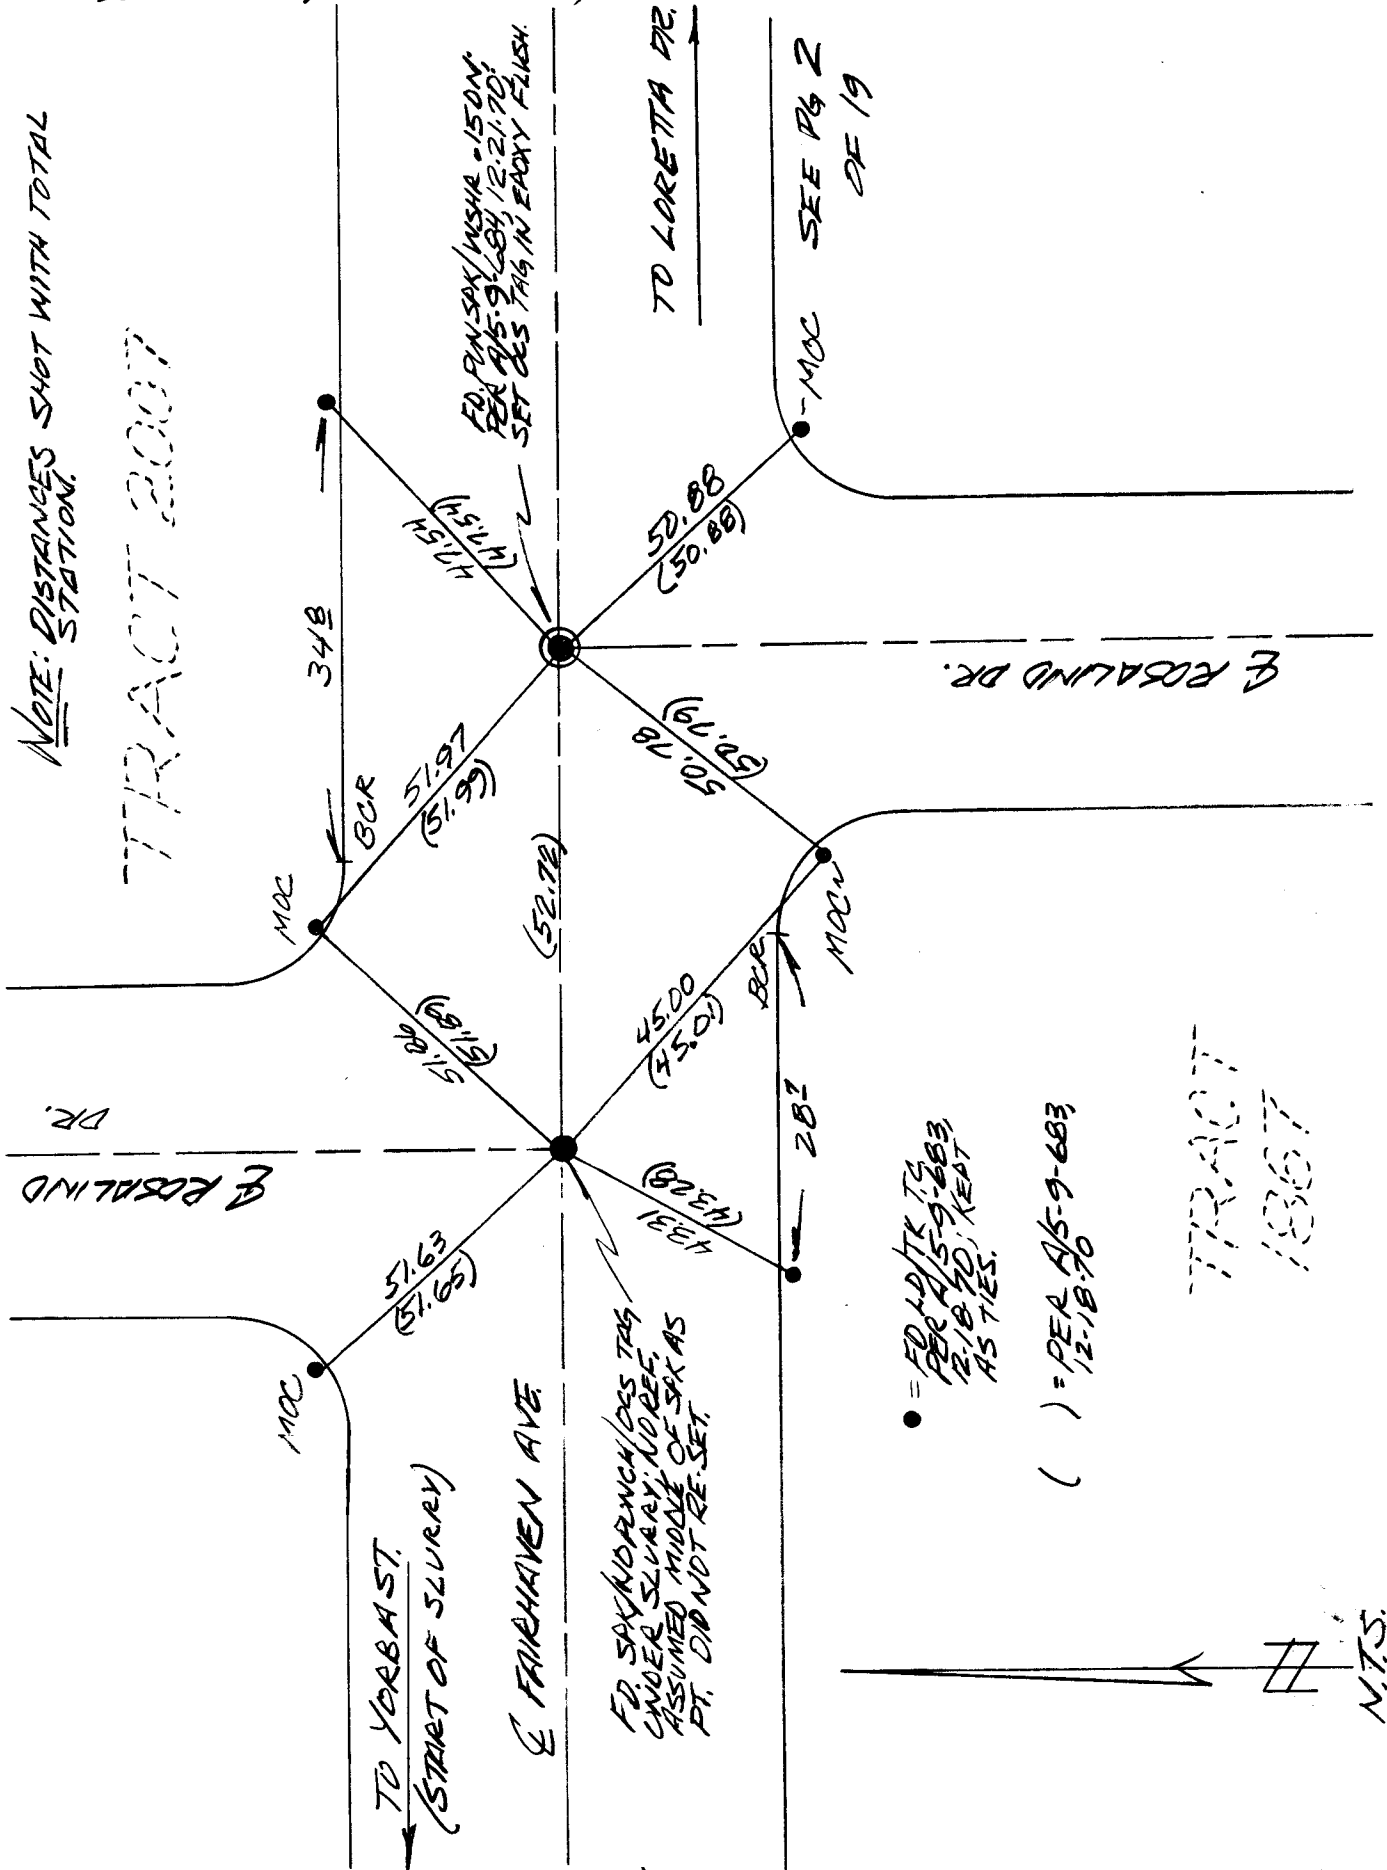

9-12-88

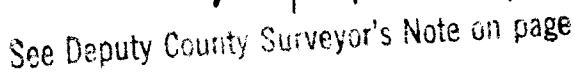


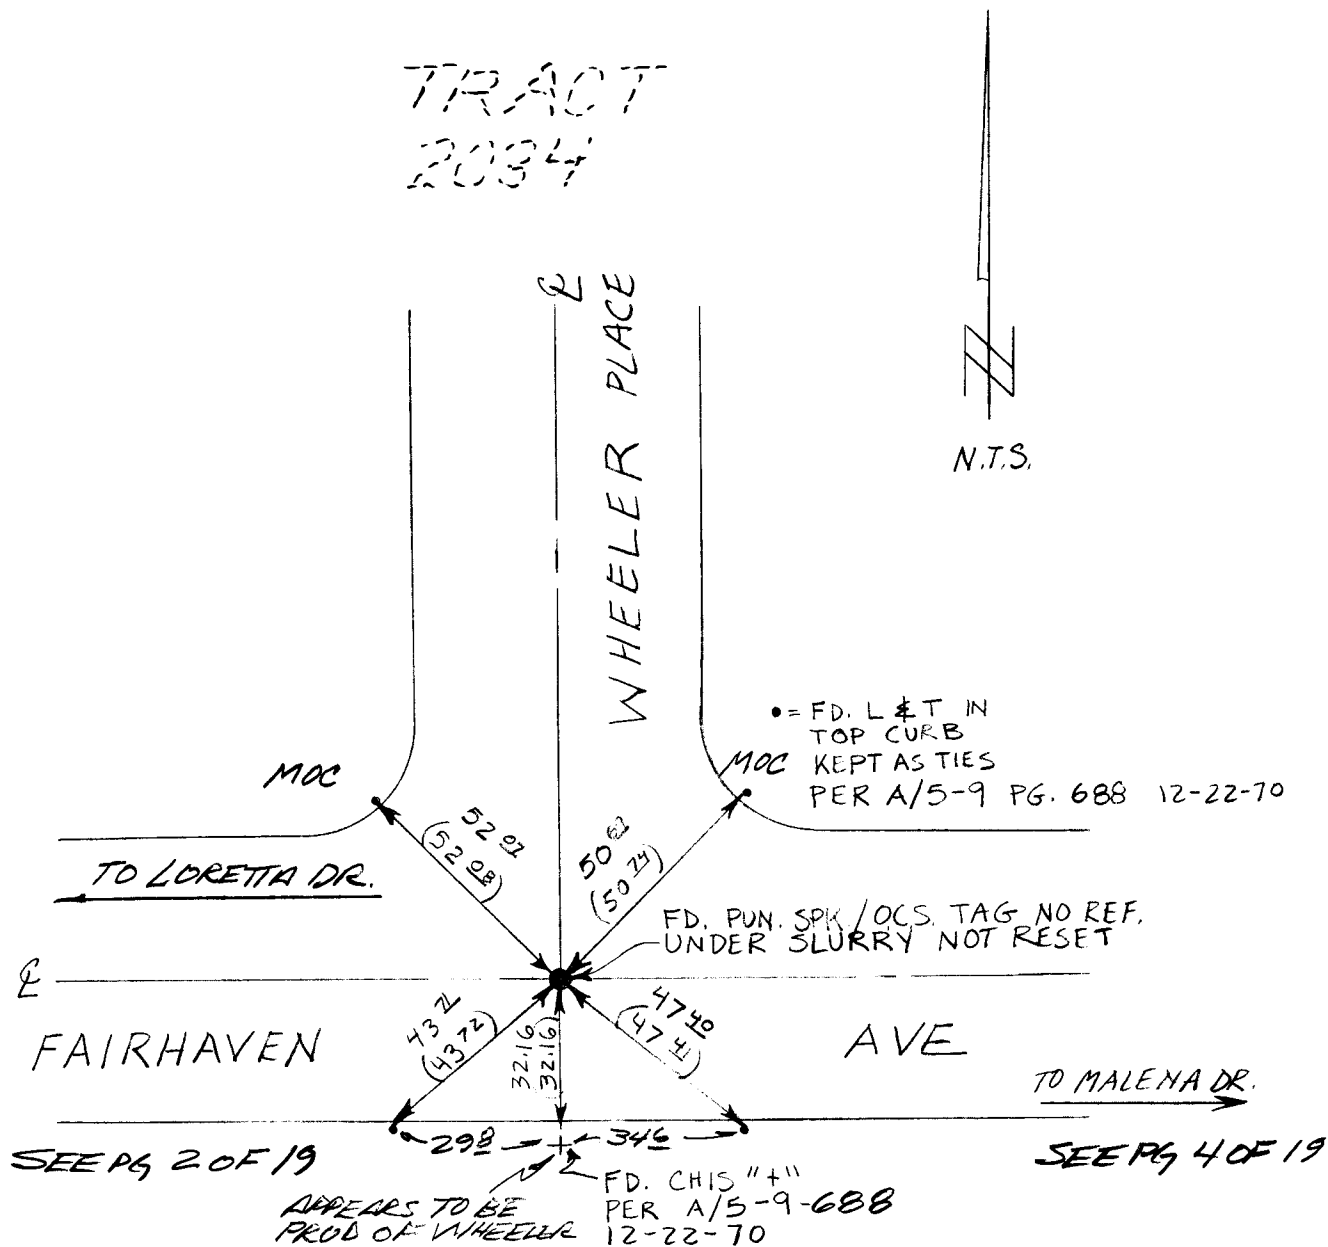

NOTE:

() PER A/5-9 PG. 688 12-22-70
DISTANCES SHOT W/ TOTAL STATION.


TRACT 3574

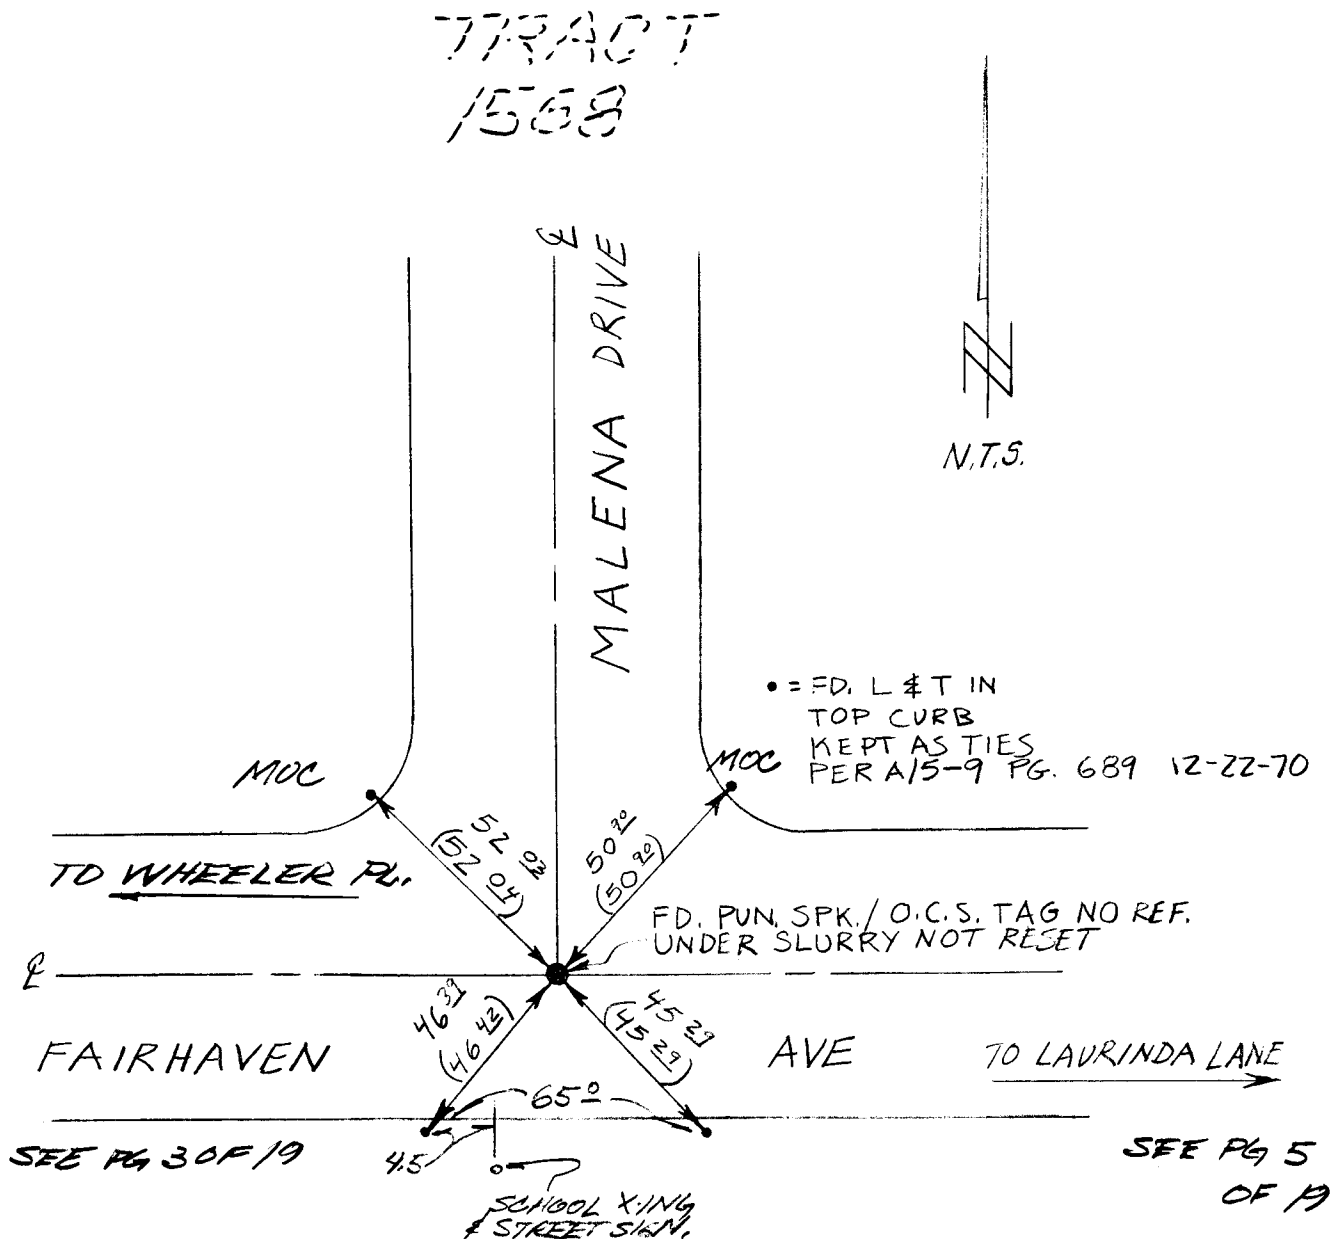

NOTE:

() PER A/5-9 PG. 689 12-22-70
DISTANCES SHOT W/TOTAL STATION.

TRACT 3574

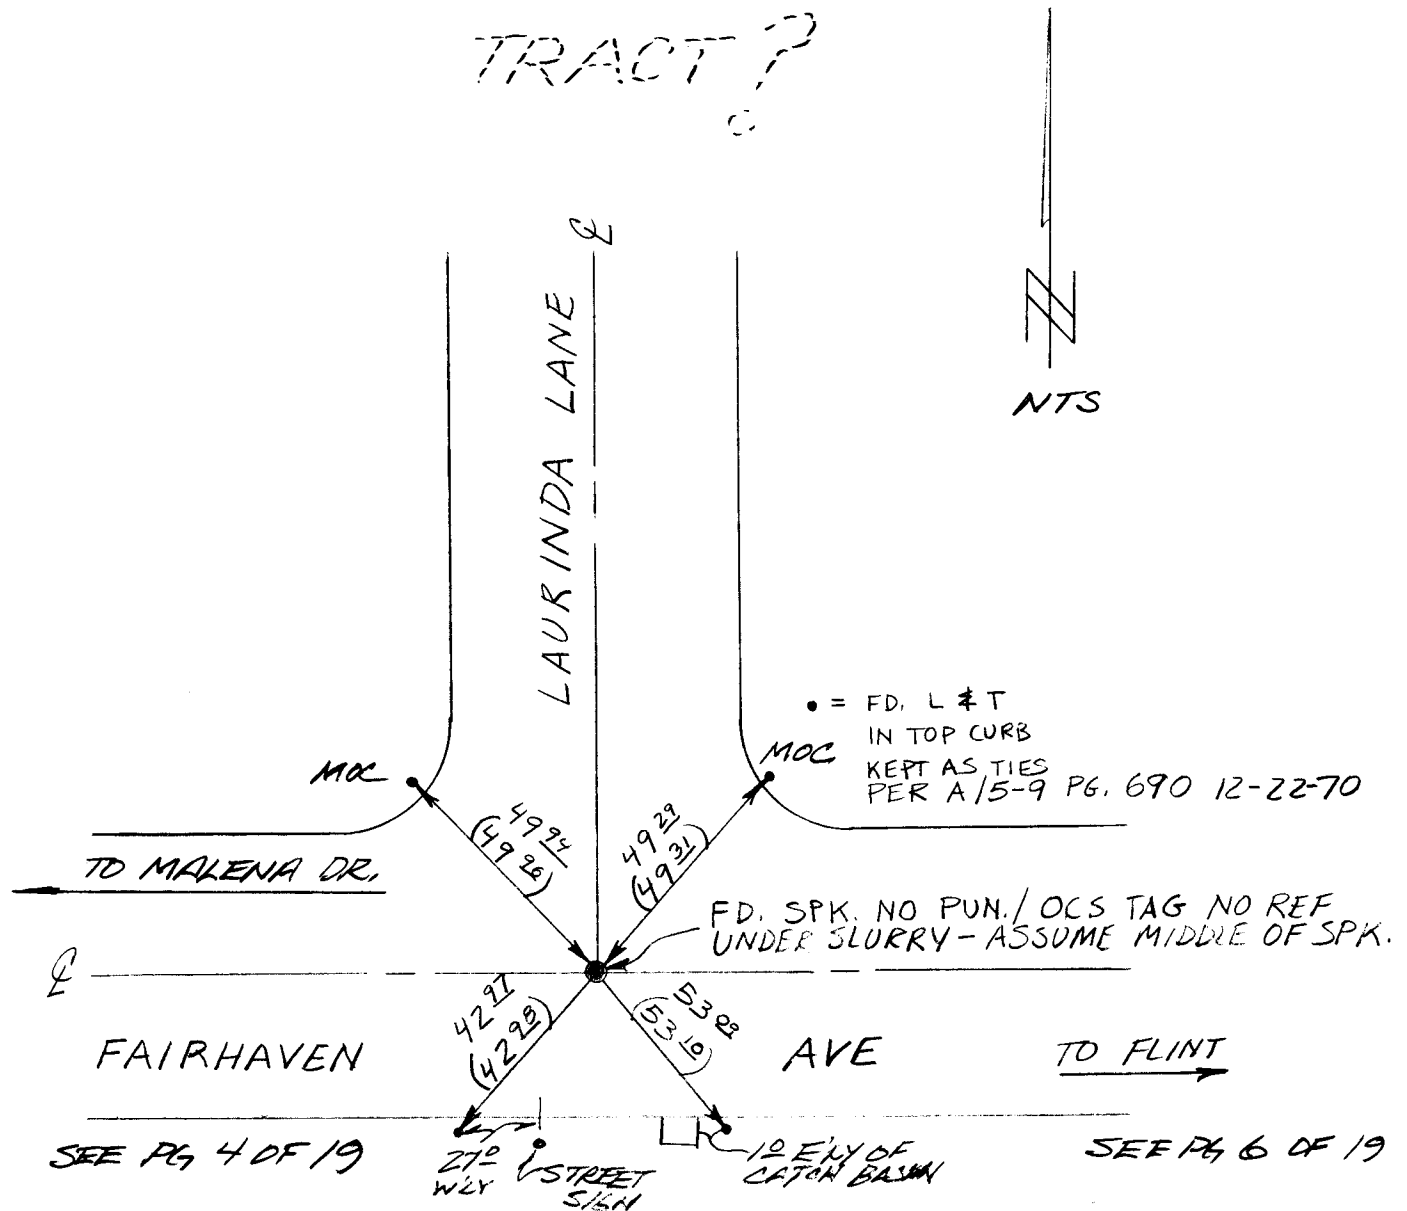

NOTE:

() PER A/5-9 PG. 690 12-22-70

ALL DISTANCES SHOT W/TOTAL STATION


TRACT
3873

PAVEMENT MGMT. - AREA 3

SURVEY OF FAIRHAVEN & TIES INDEX A/5-9 1033 PAGE 7 OF 26
 SURVEYED BY DOYLE NOTES: BARCLAY DATE 9-13-88 6 OF 19
 ORANGE COUNTY SURVEYOR

TRACT 2352


NOTE: DISTANCES SHOT WITH TOTAL STATION

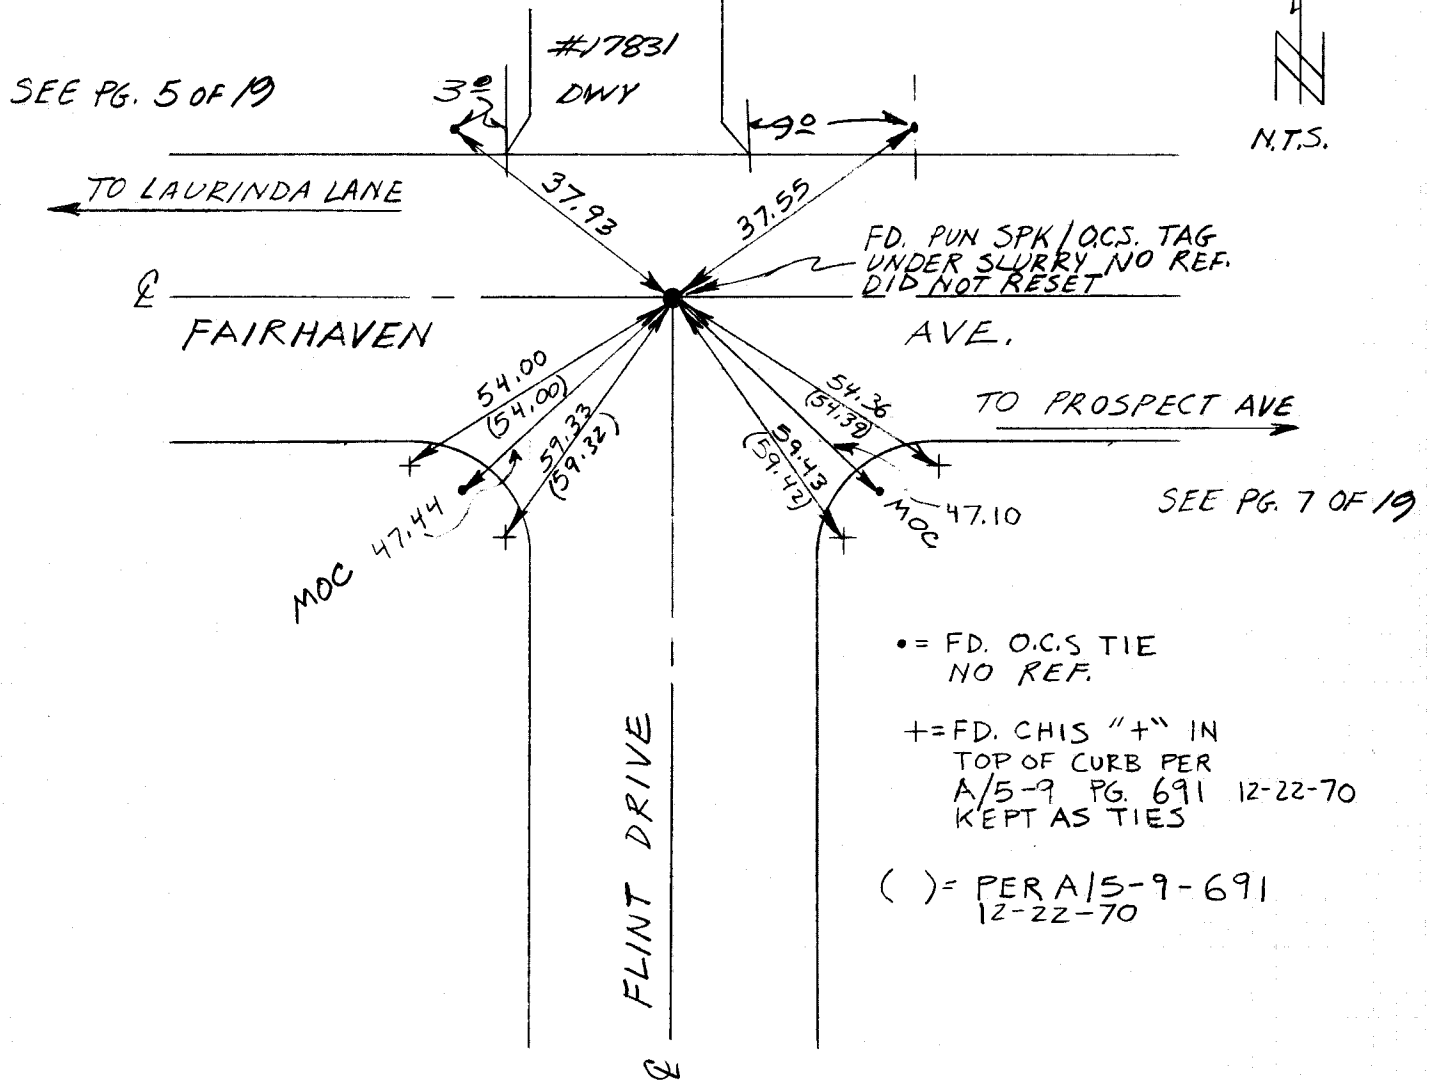

TRACT 3973

PAVEMENT MGMT. - AREA 3

SURVEY OF **FAIRHAVEN & TIES** INDEX **A/5-9** 1034 PAGE **8 OF 26**
 SURVEYED BY **DOYLE** NOTES: **BARCLAY** DATE **9-13-88** **7 OF 19**
 ORANGE COUNTY SURVEYOR

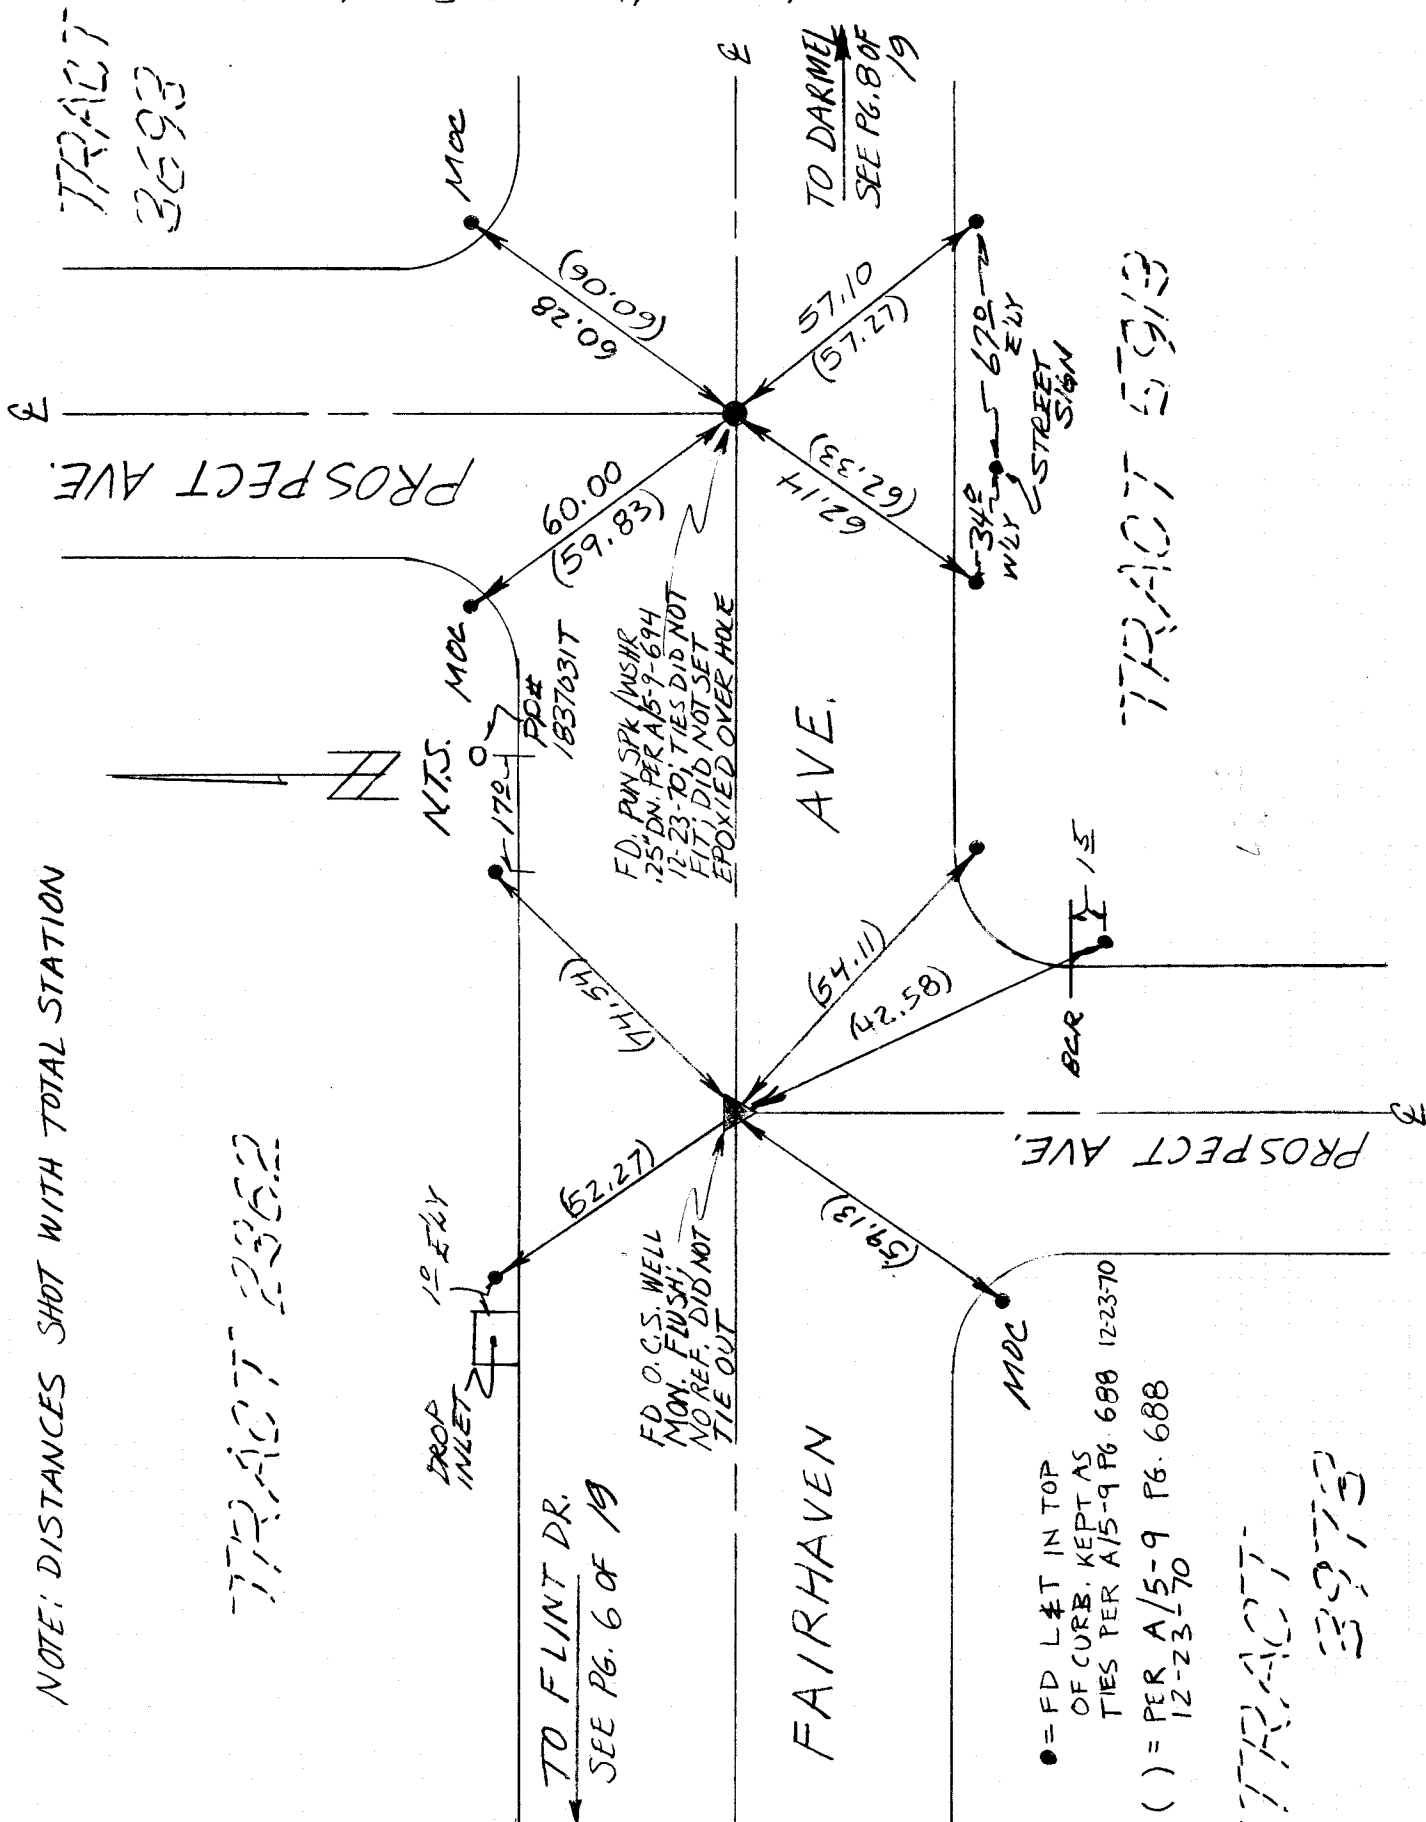

NOTE: DISTANCES SHOT WITH TOTAL STATION

PAVEMENT MGMT. - AREA 3

SURVEY OF FAIRHAVEN & TIES

A/5-9

1035

PAGE 9 OF 26


SURVEYED BY DOYLE NOTES: BARCLAY

DATE 9-13-88


8 OF 19
ORANGE COUNTY SURVEYOR

TRACT
3693

TRACT
2566

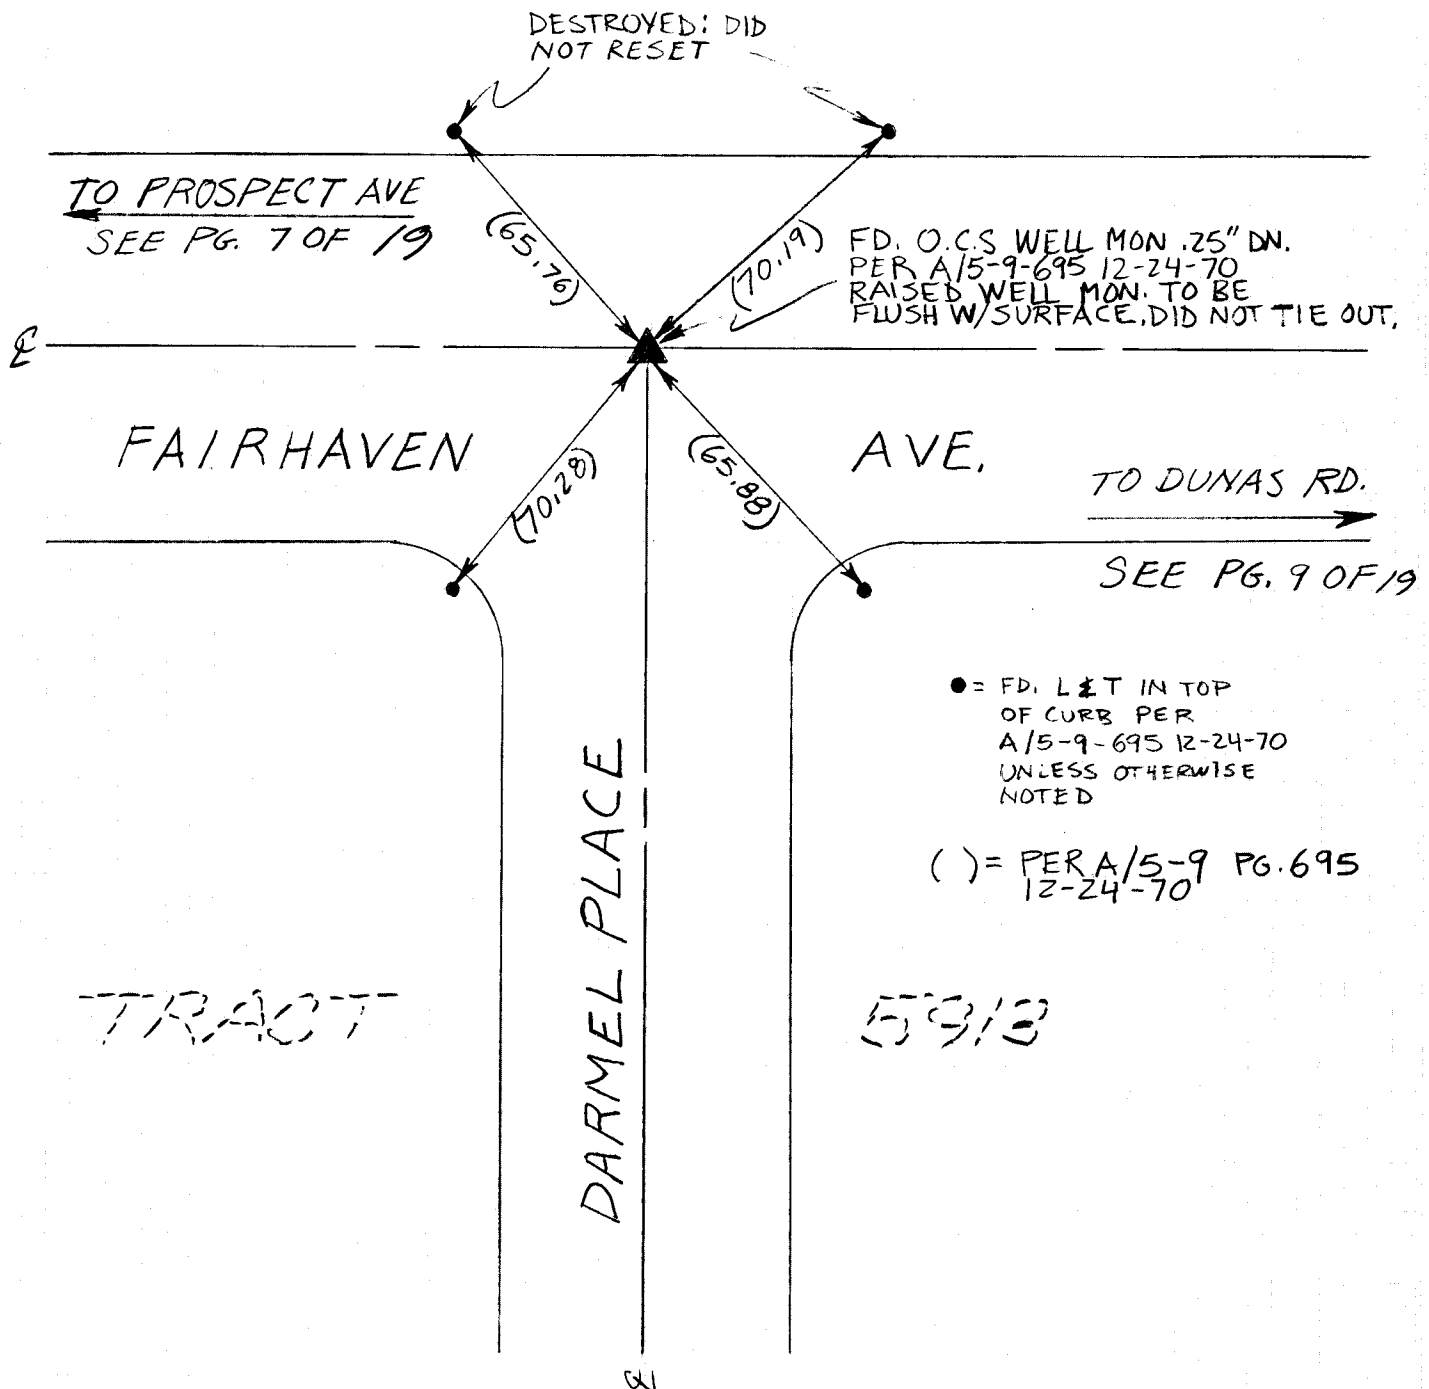

TRACT
2556

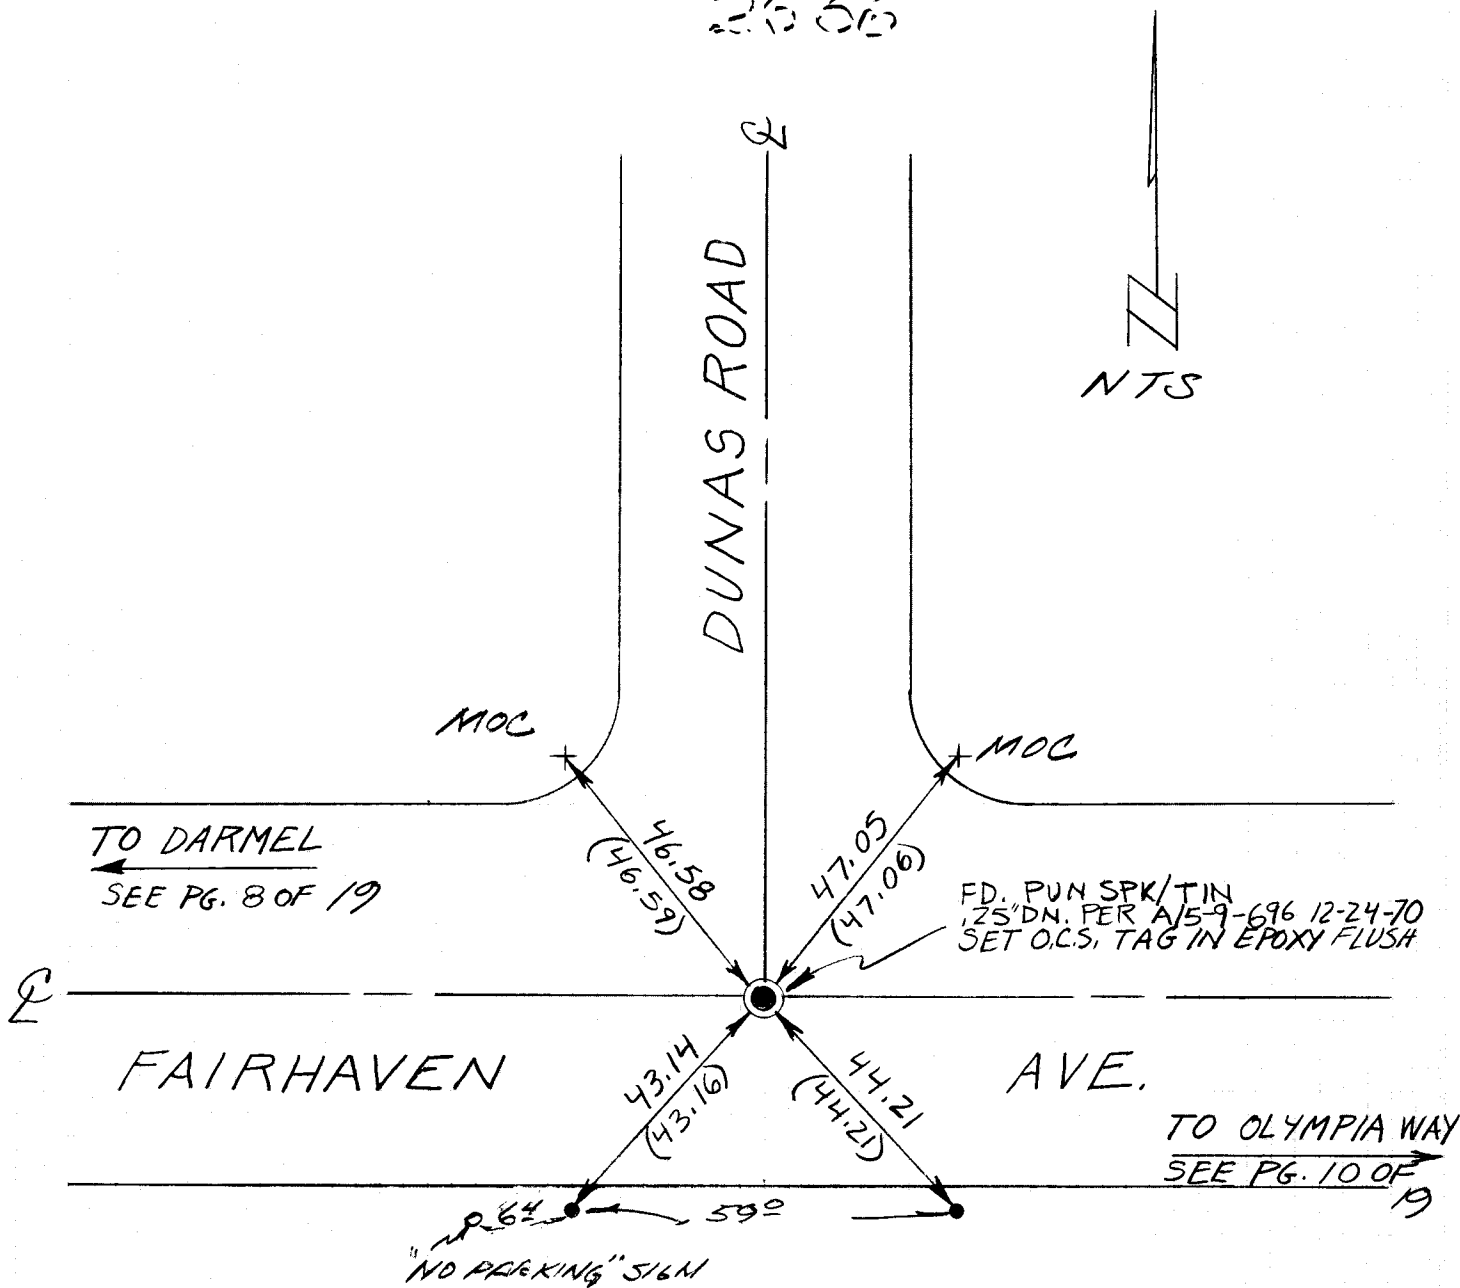

+ = FD. CHIS. "+" PER
A/5-9-696 12-24-70
KEPT AS TIES

• = FD. L & T IN TOP OF CURB
PER A/5-9-696 12-24-70
KEPT AS TIES

() = PER A/5-9-696 12-24-70

PAVEMENT MGMT. AREA 3

SURVEY OF FAIRHAVEN & TIES

A/5-9


1037

PAGE 11 OF 26
10 OF 19

SURVEYED BY DOYLE NOTES: RUFFING

DATE 9-19-88

ORANGE COUNTY SURVEYOR

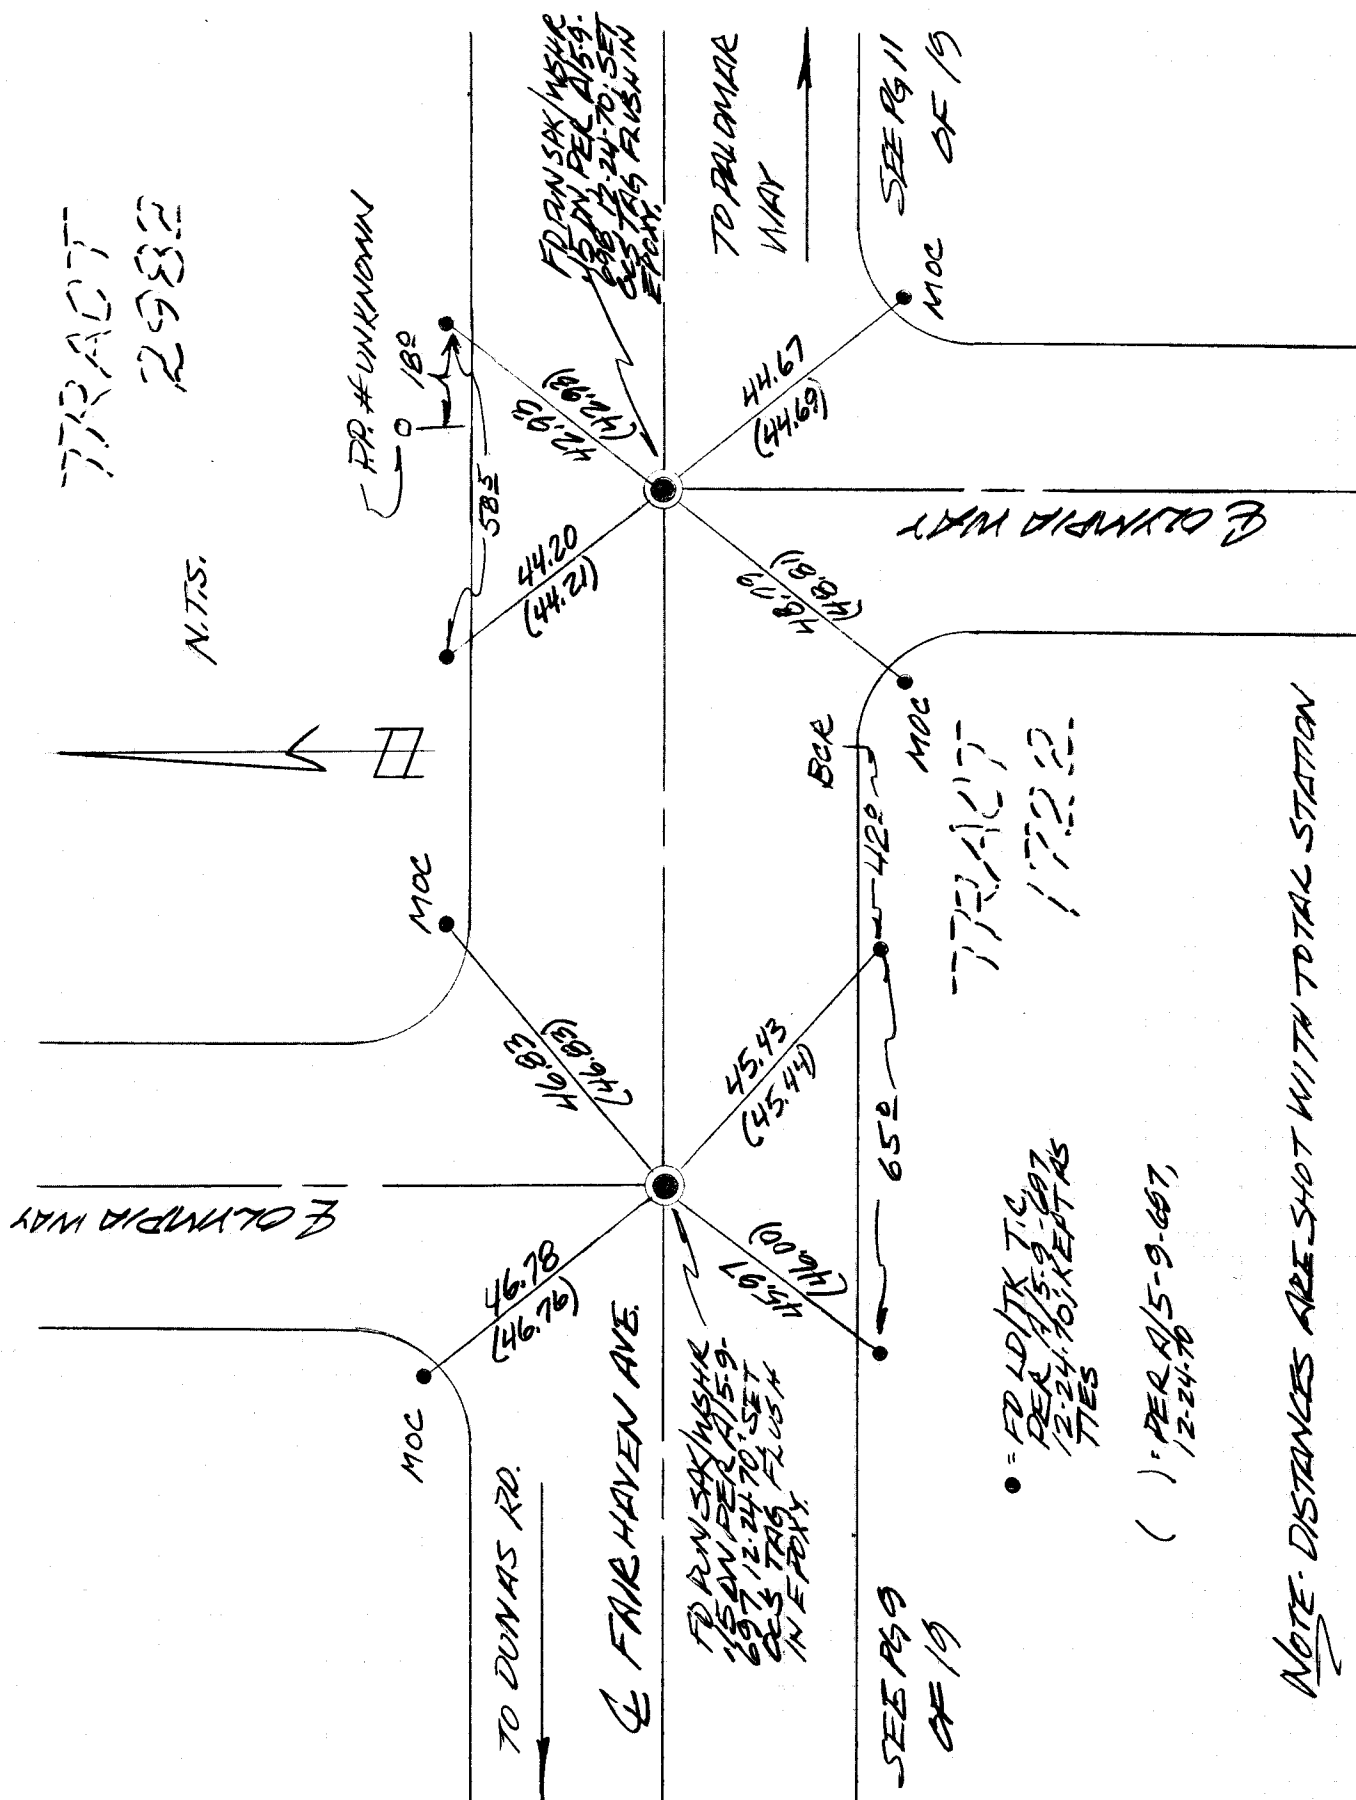

PAVEMENT MGMT. - AREA 3

SURVEY OF FAIRHAVEN & TIES


A/5-9 1038


PAGE 12 OF 26
11 OF 19

SURVEYED BY DOYLE NOTES: RUFFING

DATE 9-20-88

ORANGE COUNTY SURVEYOR

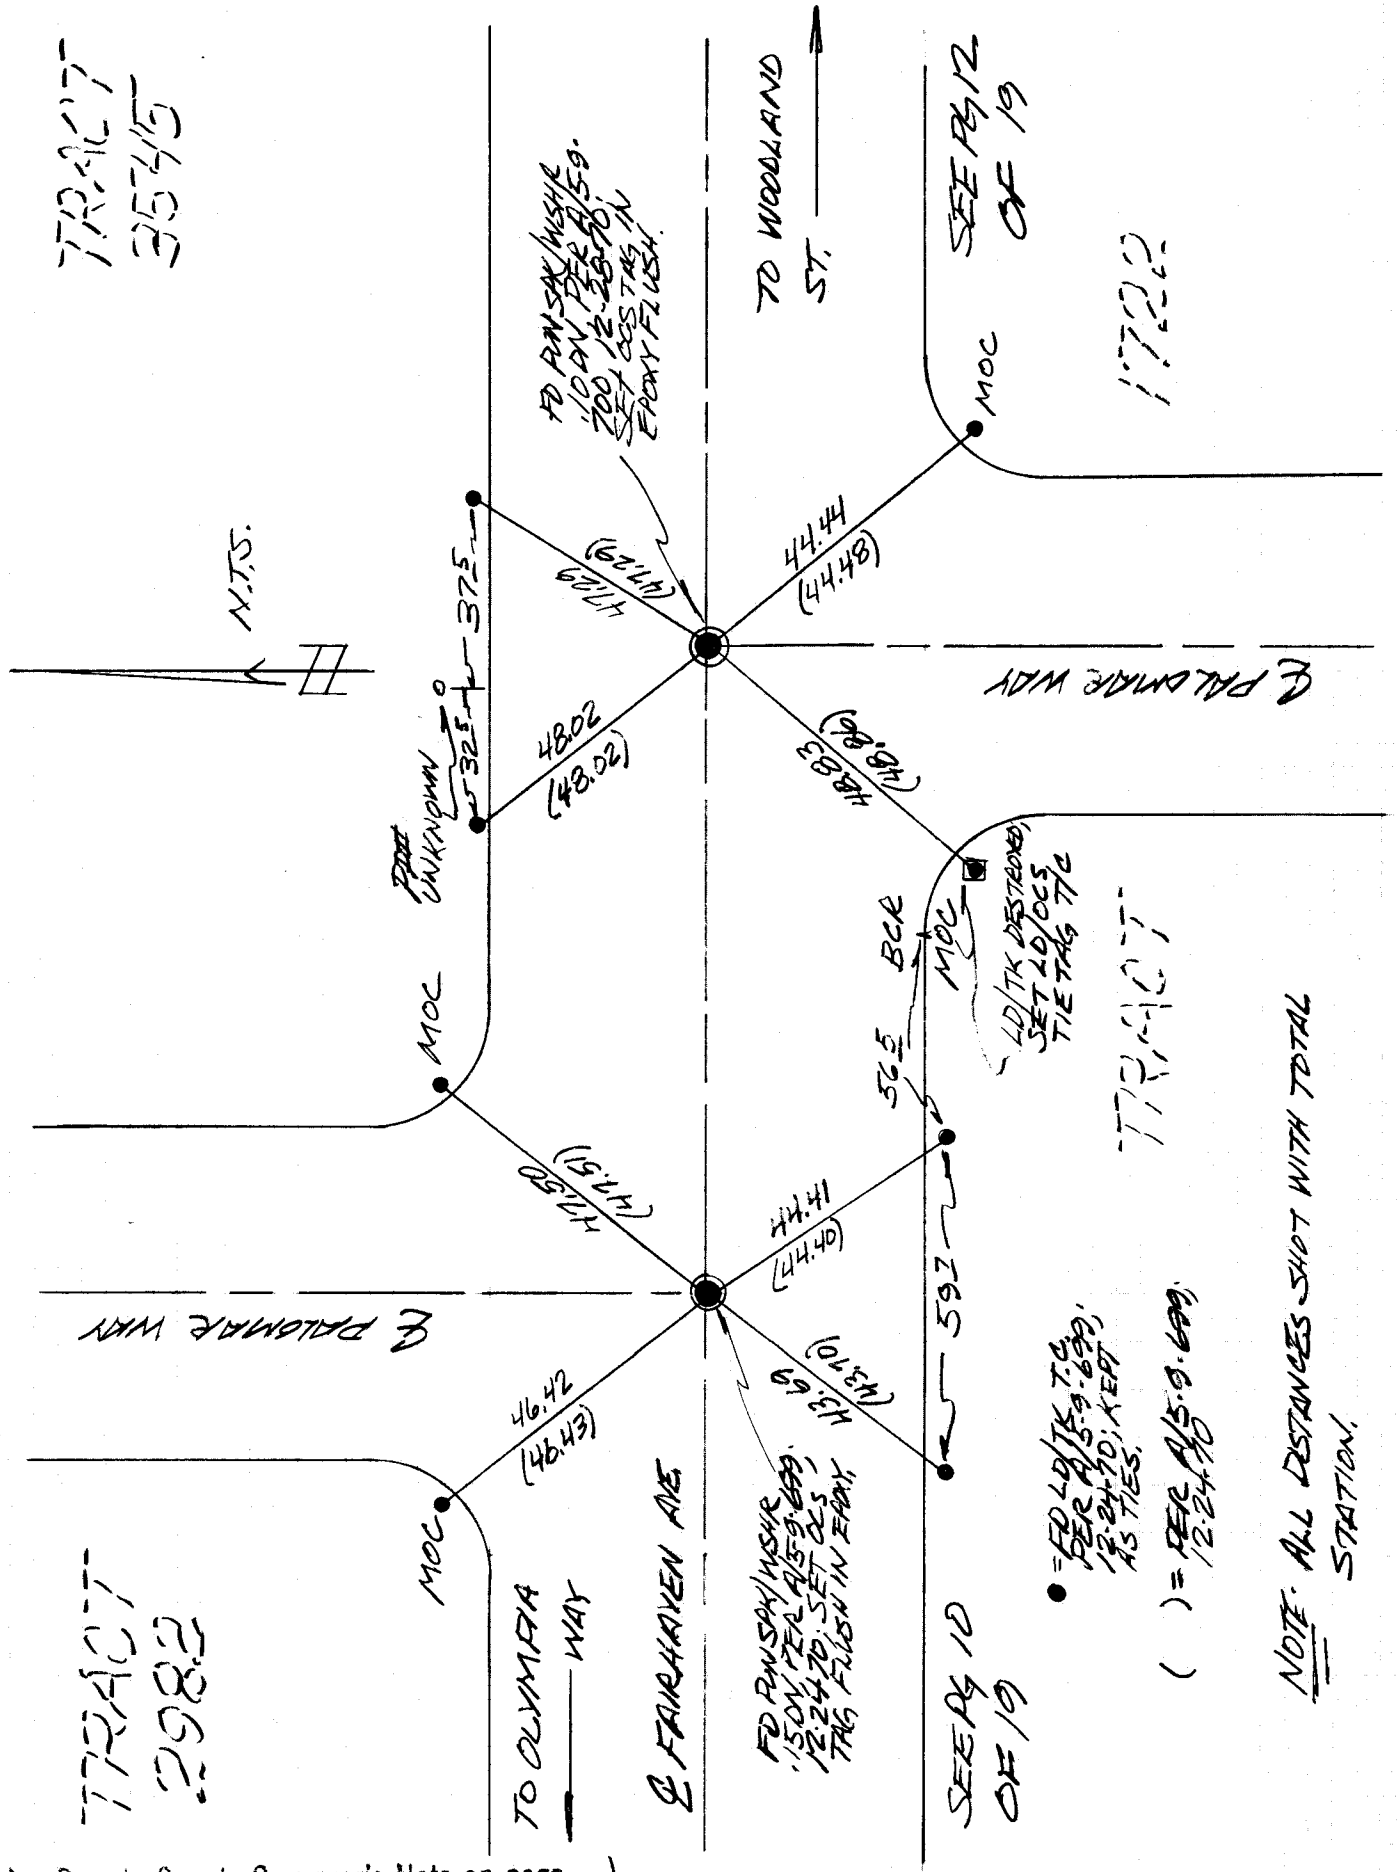

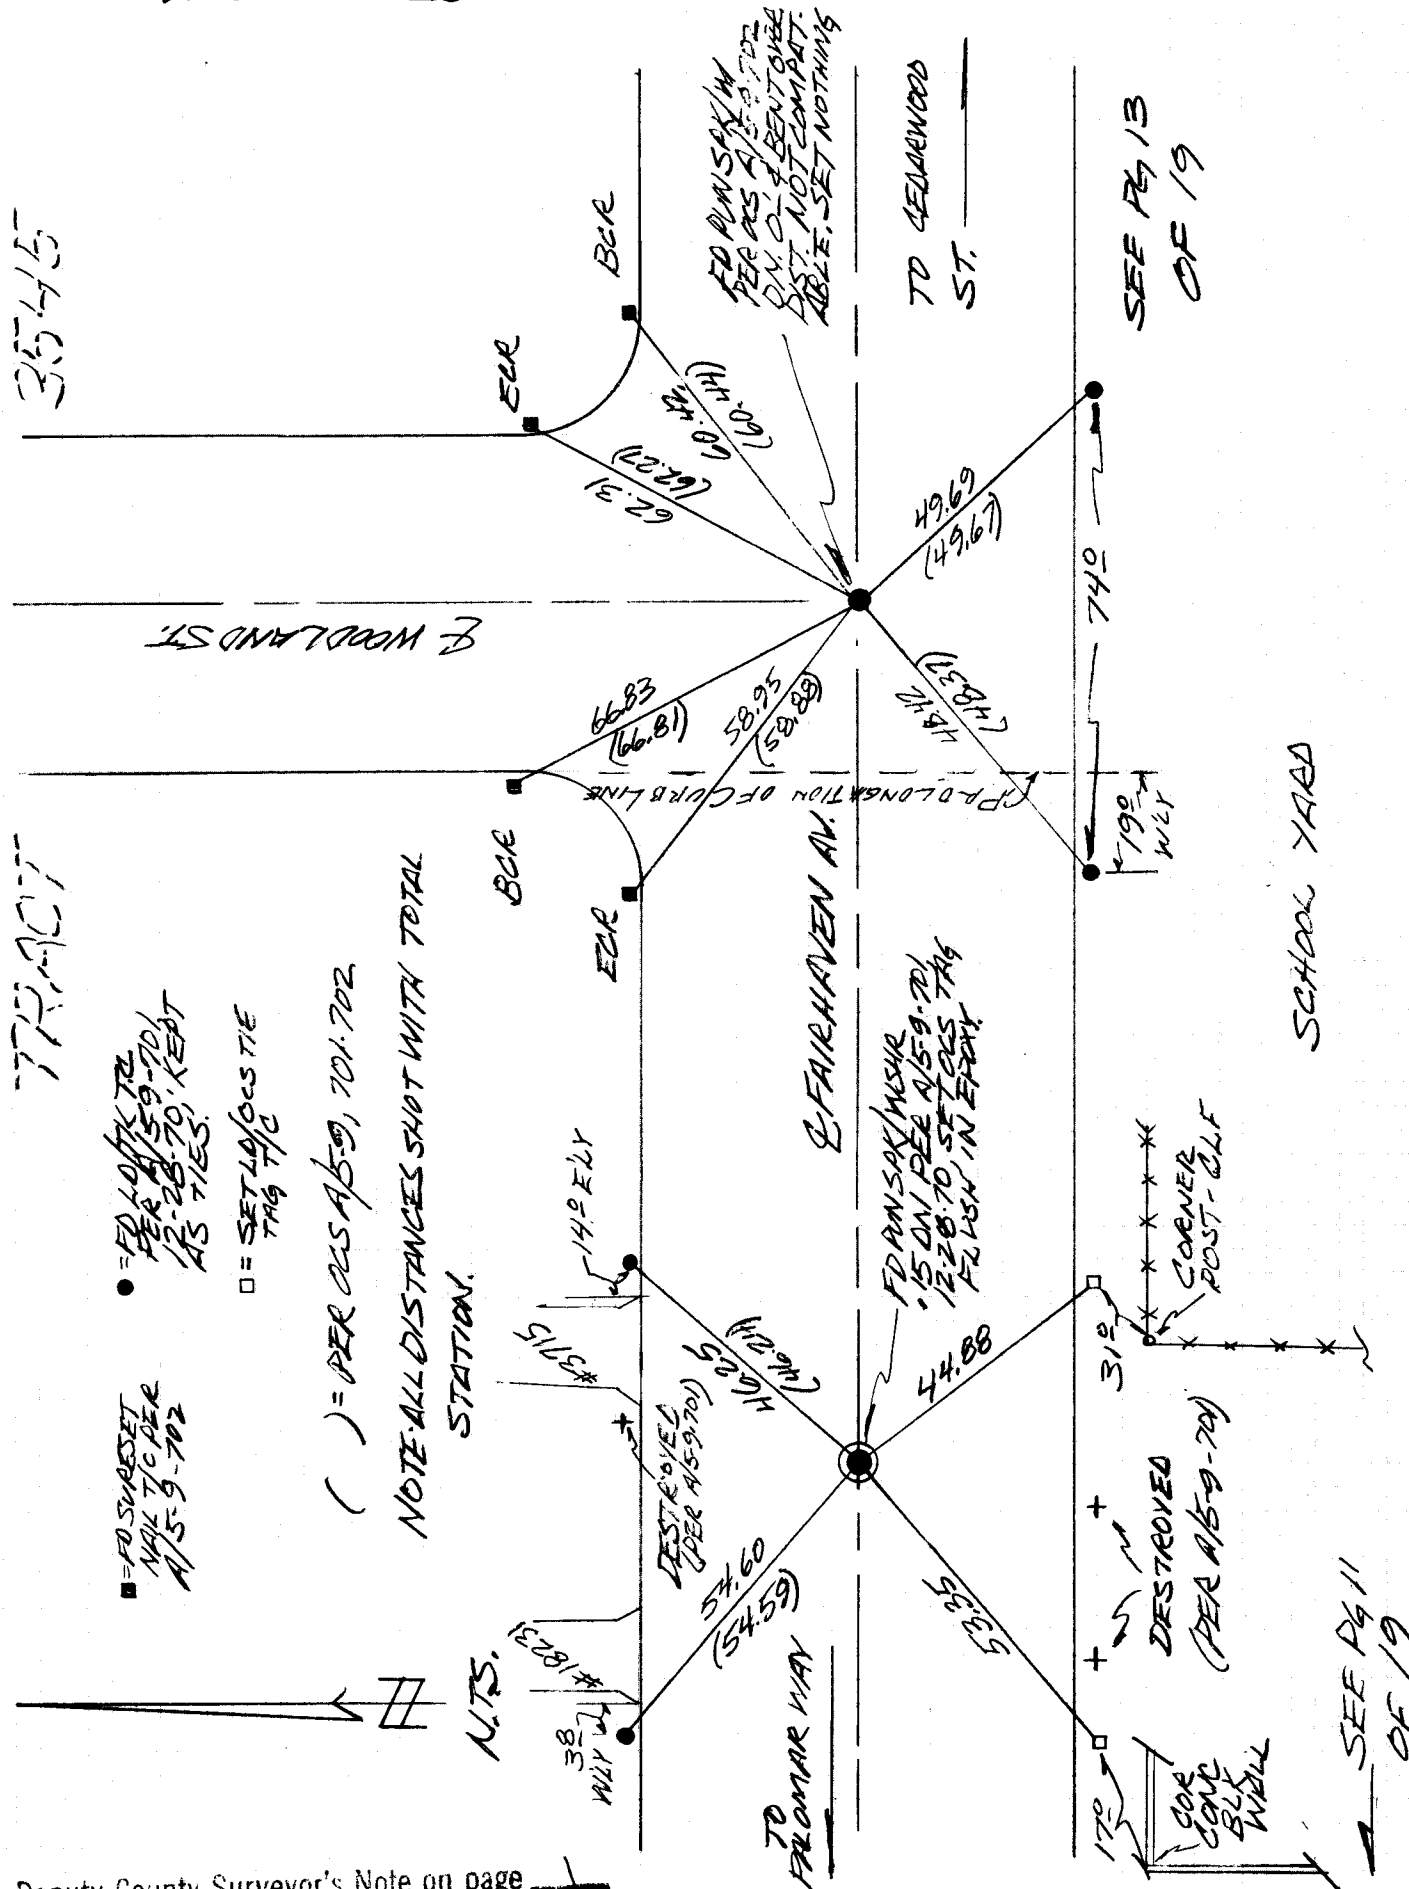


PAVEMENT MGMT. AREA 3
FAIRHAVEN AVE.

A/5-9 1040

14 of 26
13 OF 19

DOYLE NOTES: ENGELMANN


11-8-88

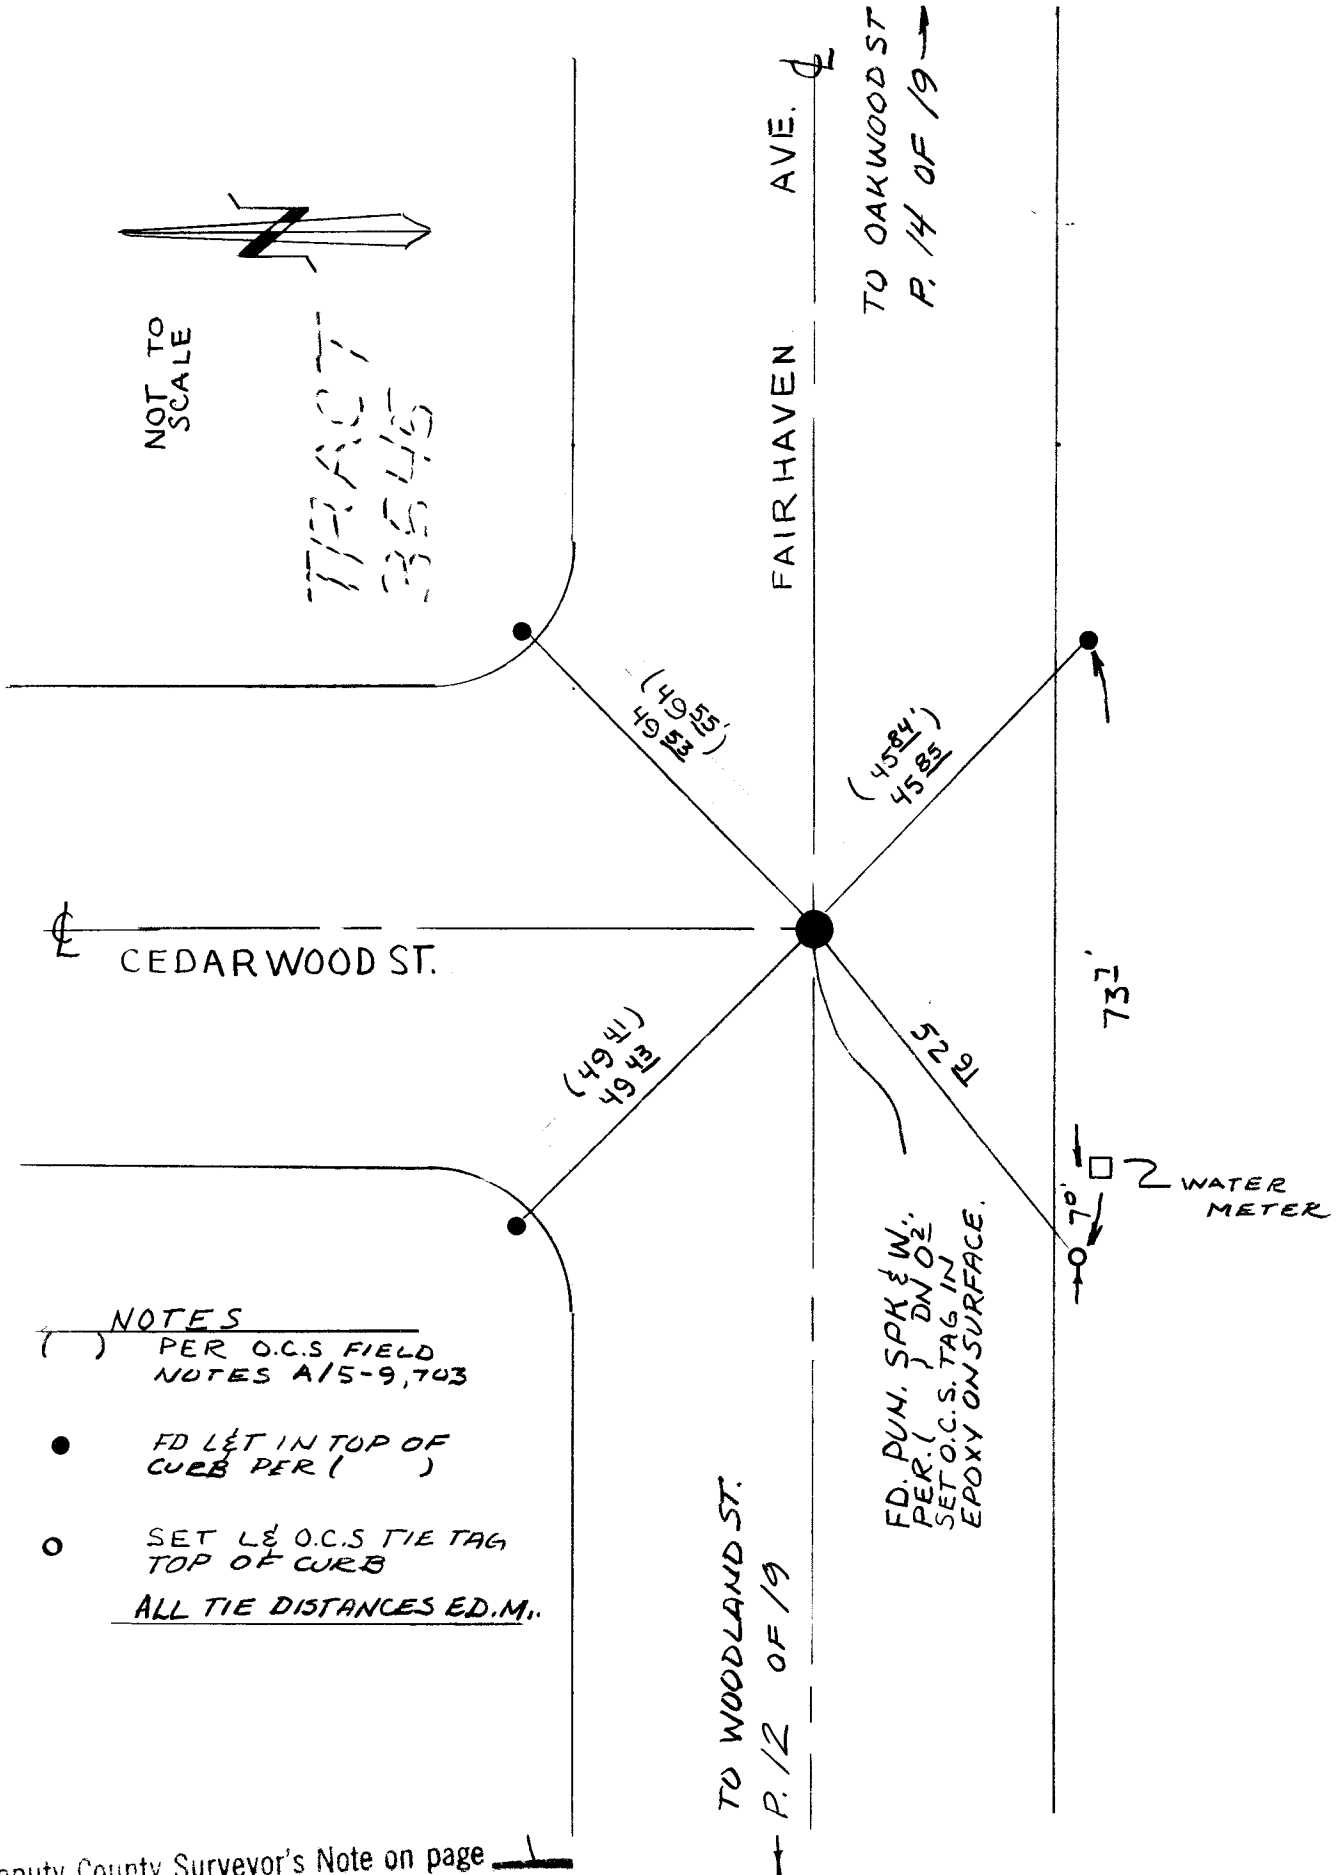

■ = FD 10/1K IN T/C
PER A/5-9, 704.

● = FD 5/1K IN T/C
PER A/5-9, 704.

NOTE: () ARE PER A/5-9, 704
ALL DISTANCES SHOT W/
TOPCON EDM.

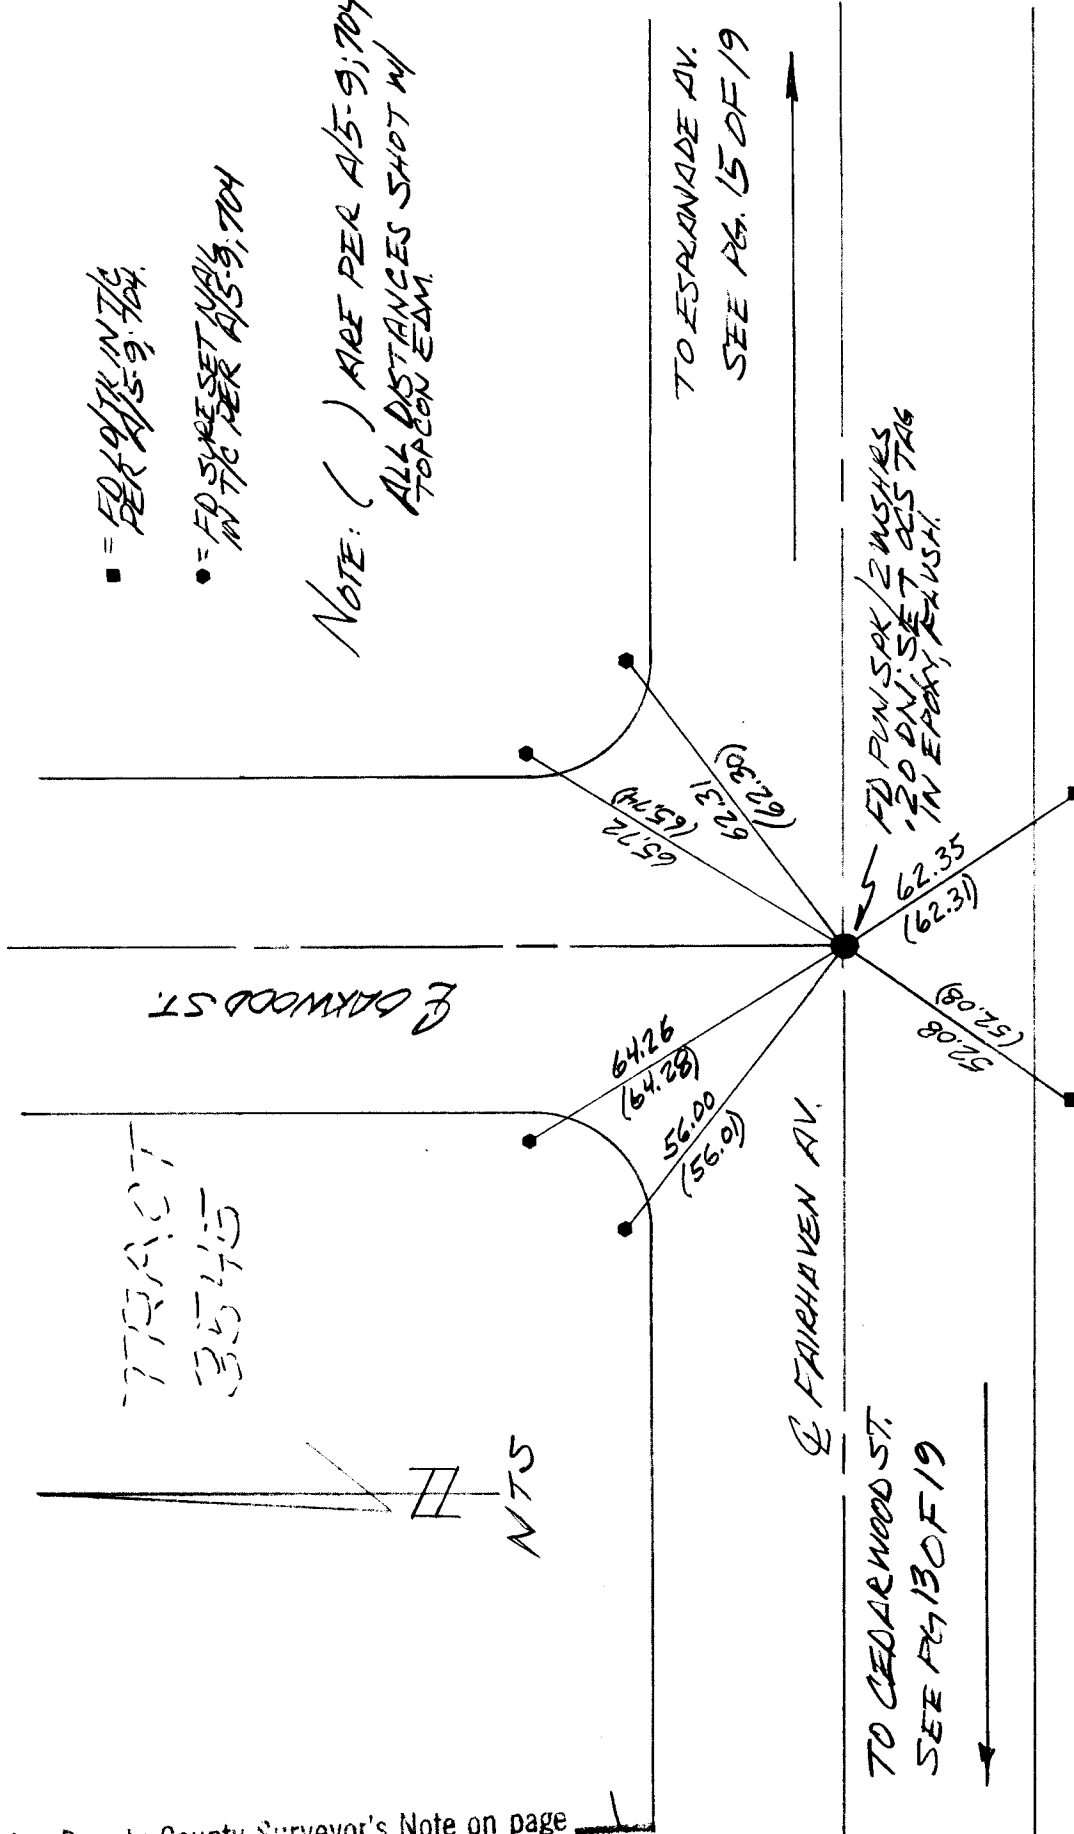

PAVEMENT MGMT-AREA 3
FAIRHAVEN & TIES


A/5-9

1042

160F 26
150F 19

DOYLE NOTE ENGELMAN

11-8-88

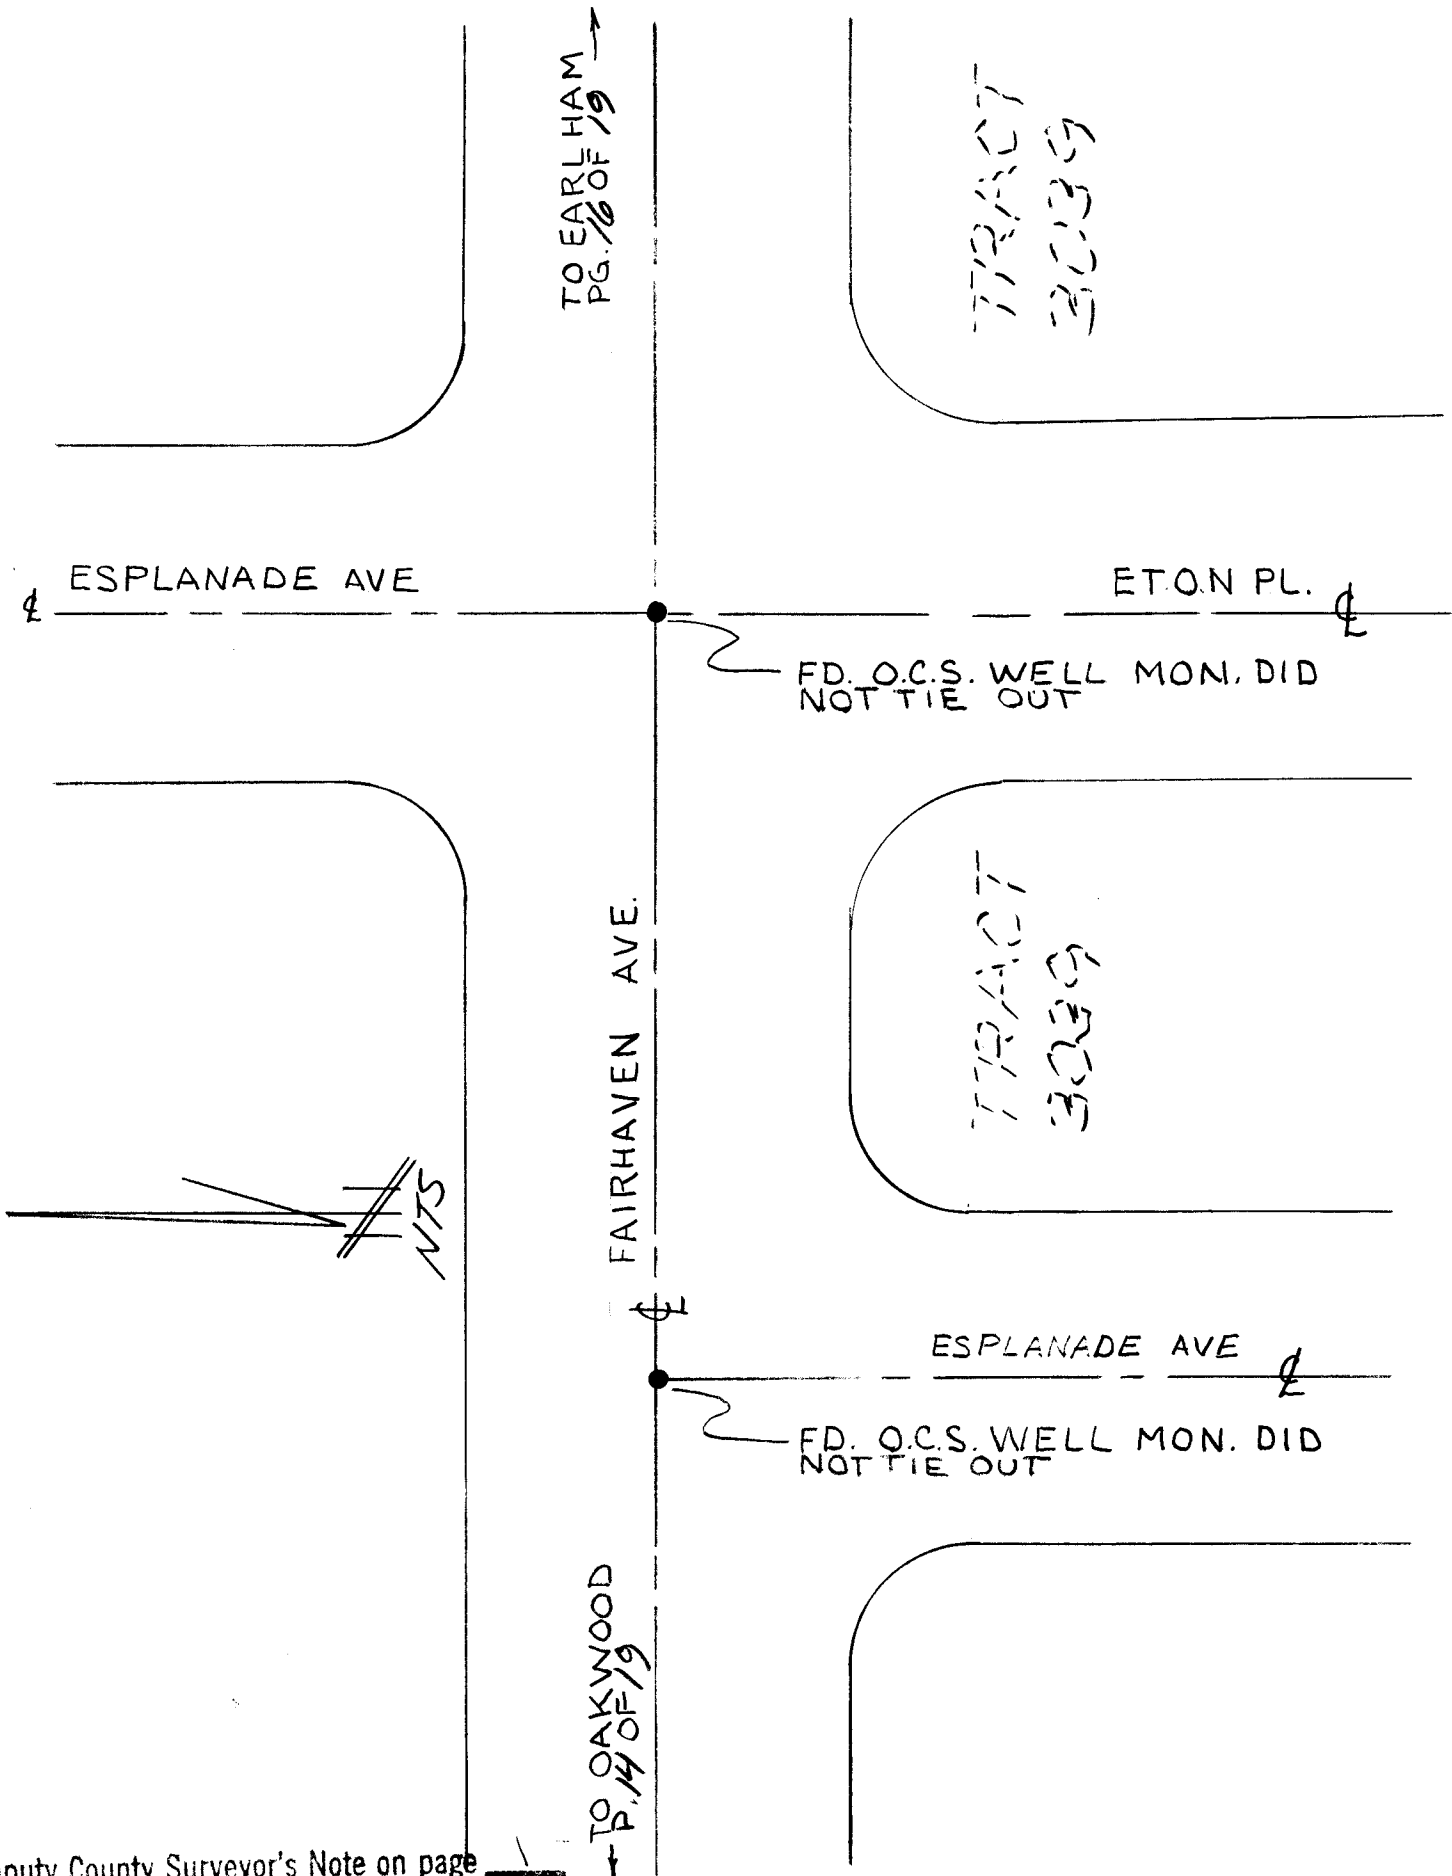

PAVEMENT MGMT. AREA 3

FAIRHAVEN & TIES

A/5-9

1043

17 OF 26
16 OF 19

DOYLE NOTES - RUFFING

11-8-88

TRACT
3361

● = FD RUN SAK 1/2 W/ 45°
D.W. 20. PER A/5-9;
707 & 708. SET GCS
TAG IN EXPOSED ON
SURFACE.

● = FD SURE-SET NAIL
IN T/C PER A/5-9;
707 & 708.

■ = FD L.D./TK IN T/C
PER A/5-9; 707 & 708.

TO CABARETOT.
SEE PAGE 17 OF 19

NOTE - () ARE PER OCS A/5-9; 707 &
708
- ALL DISTANCES SHOT W/
TORCON E.A.M.

TRACT
2739

EARLHAM ST.

NOT TO SCALE

FAIRHAVEN AVE

TO EATON PL./ESPLANADE
SEE PG 15 OF 19

EARLHAM ST.

TRACT
2739


FAIRHAVEN & TIES

1044

18 OF 26
17 OF 19

DATE 11-888

GRANGE COUNTY SURVEYOR

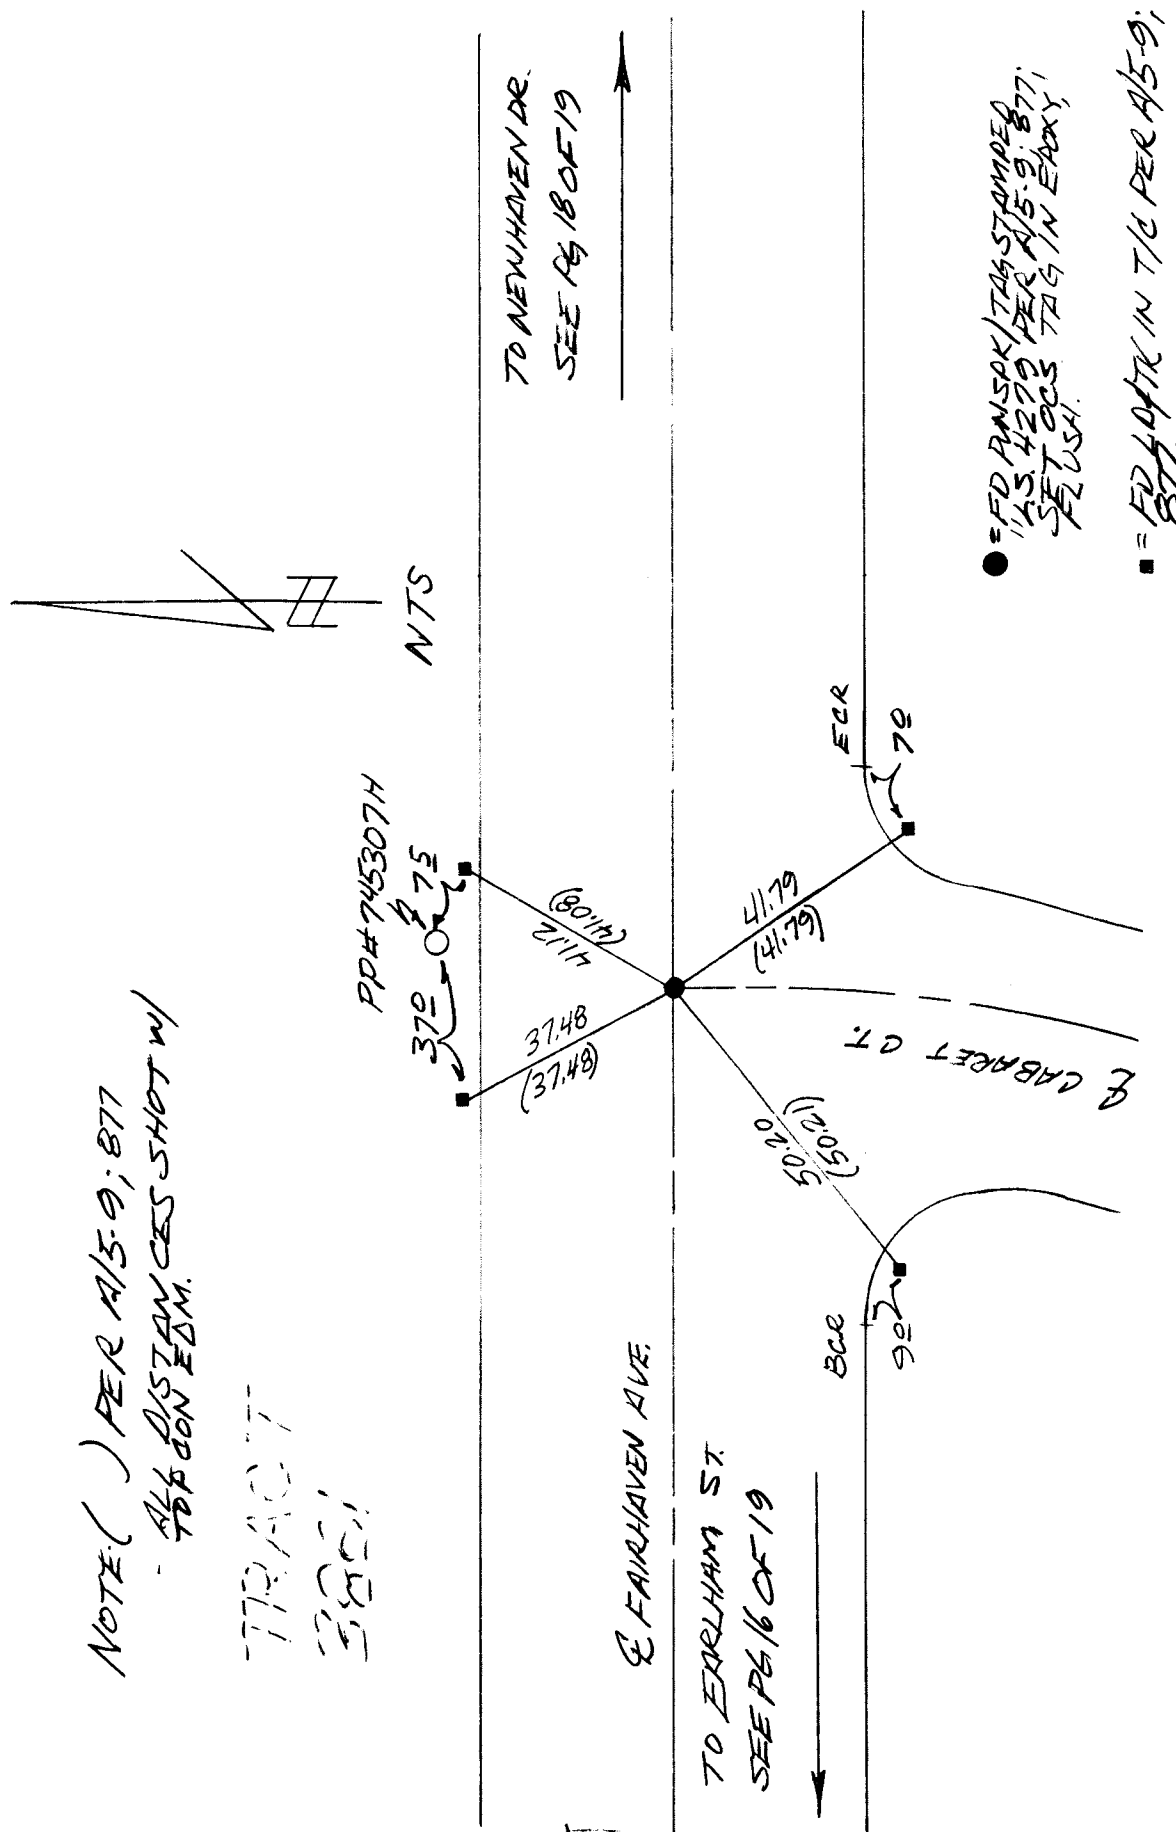

NOTE: () PER A/S-9; 877
- ALL DISTANCES SHOT W/
TOP CON EDM.

10/21/71

3 FAIRHAVEN AVE.

TO EARLHAM ST.
SEE PG 6 OF 19

1500


PAVEMENT MGMT-AREA 3
FAIRHAVEN & TIES

A/5-9 1045

DOYLE NOTES: ENGELMAN

11-8-88

19 OF 26
18 OF 19

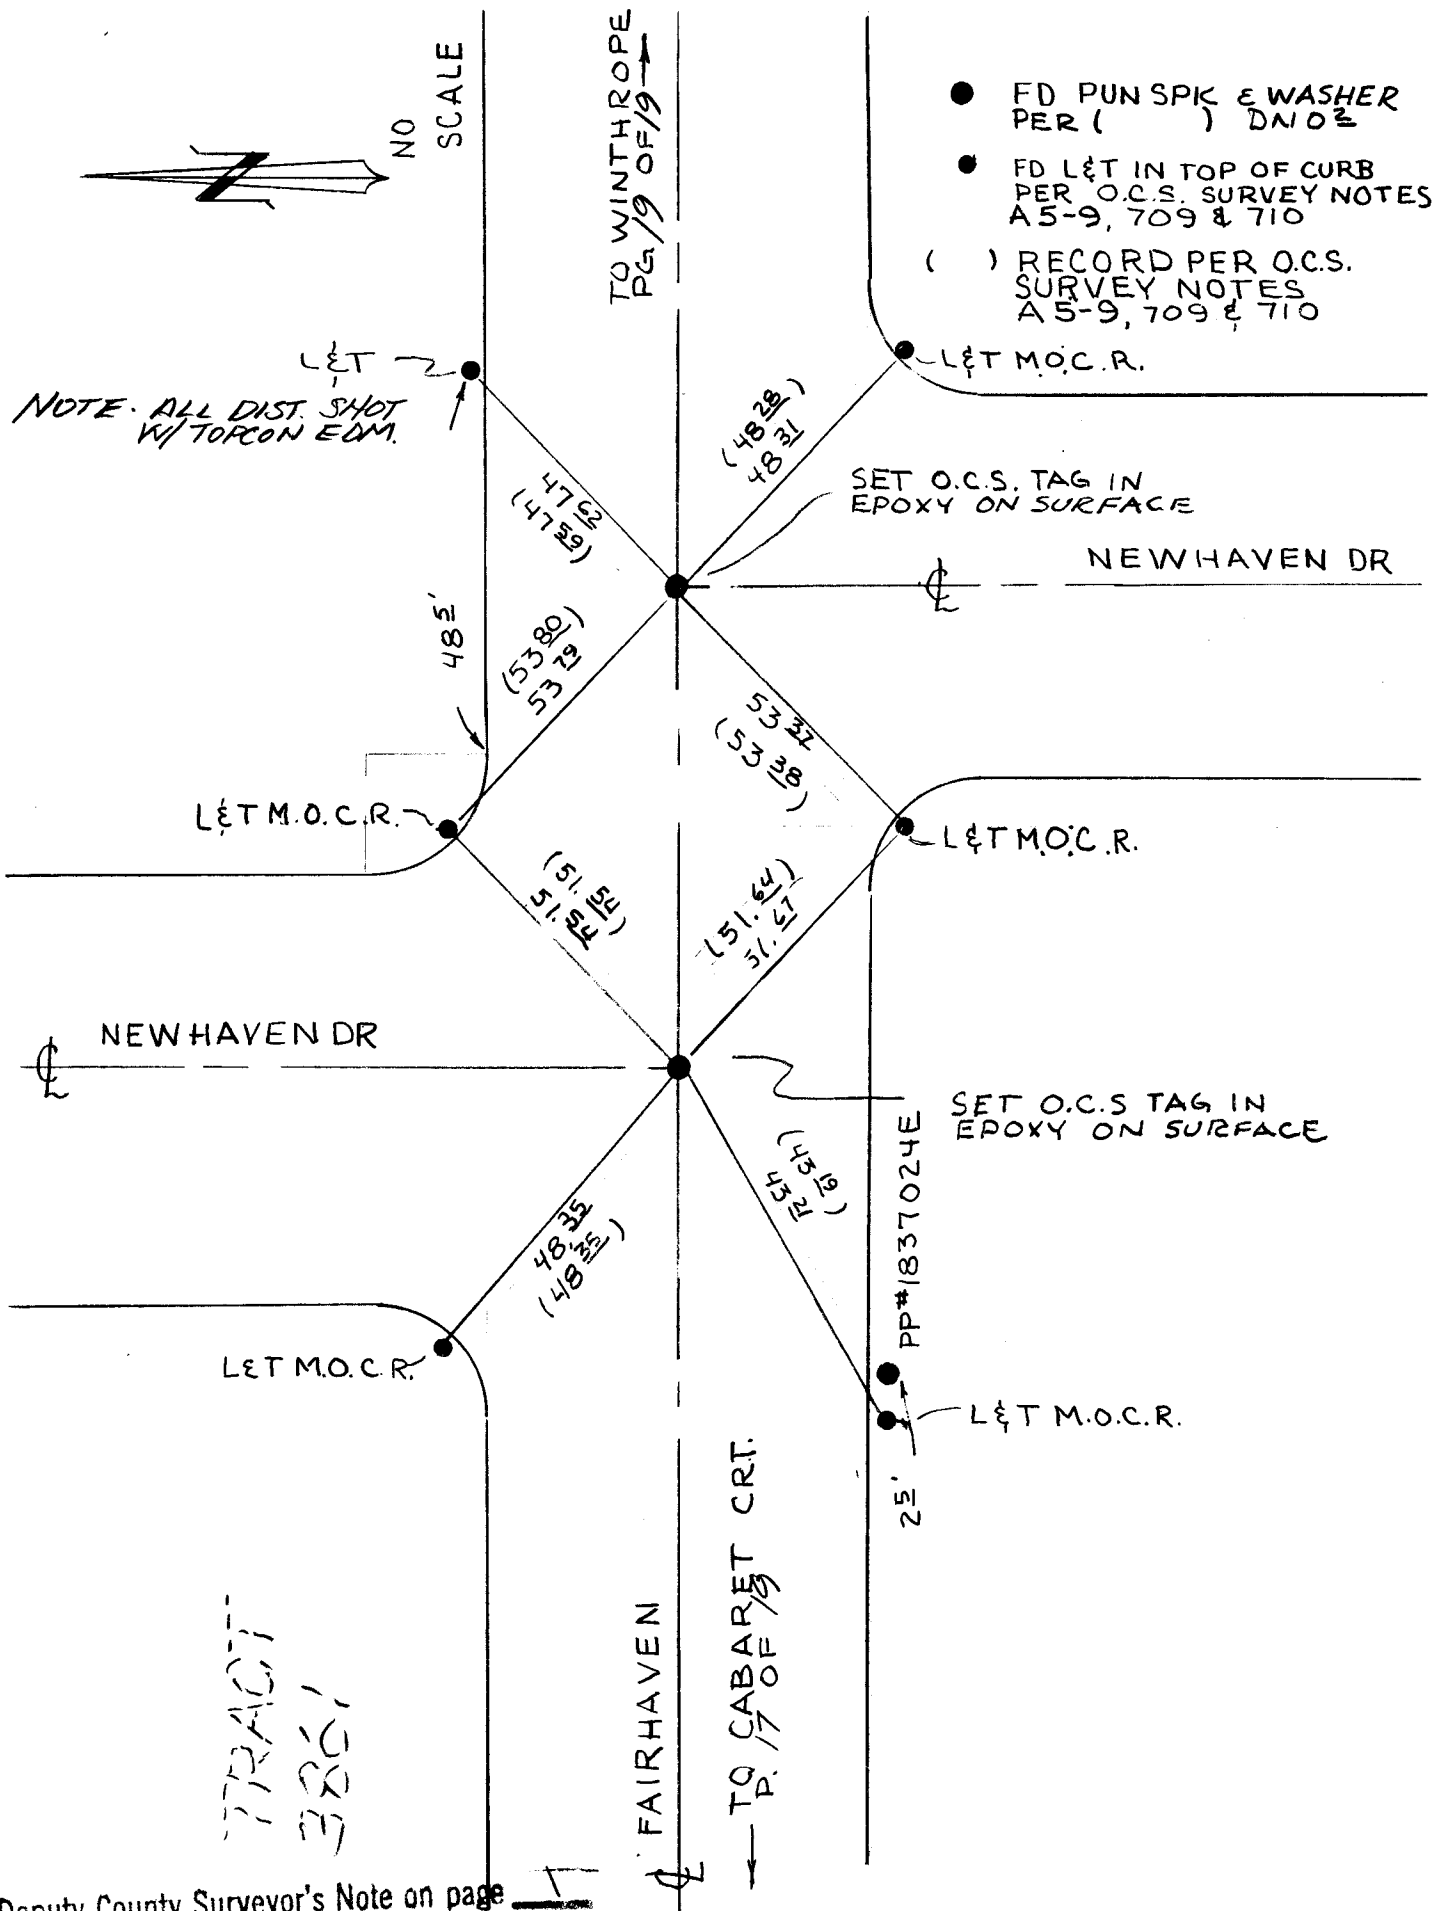

PAVEMENT MGMT. - AREA 3

FAIRHAVEN & TIES


A/5-9

1046

200F 26
190F 19

DOYLE


11-7-88

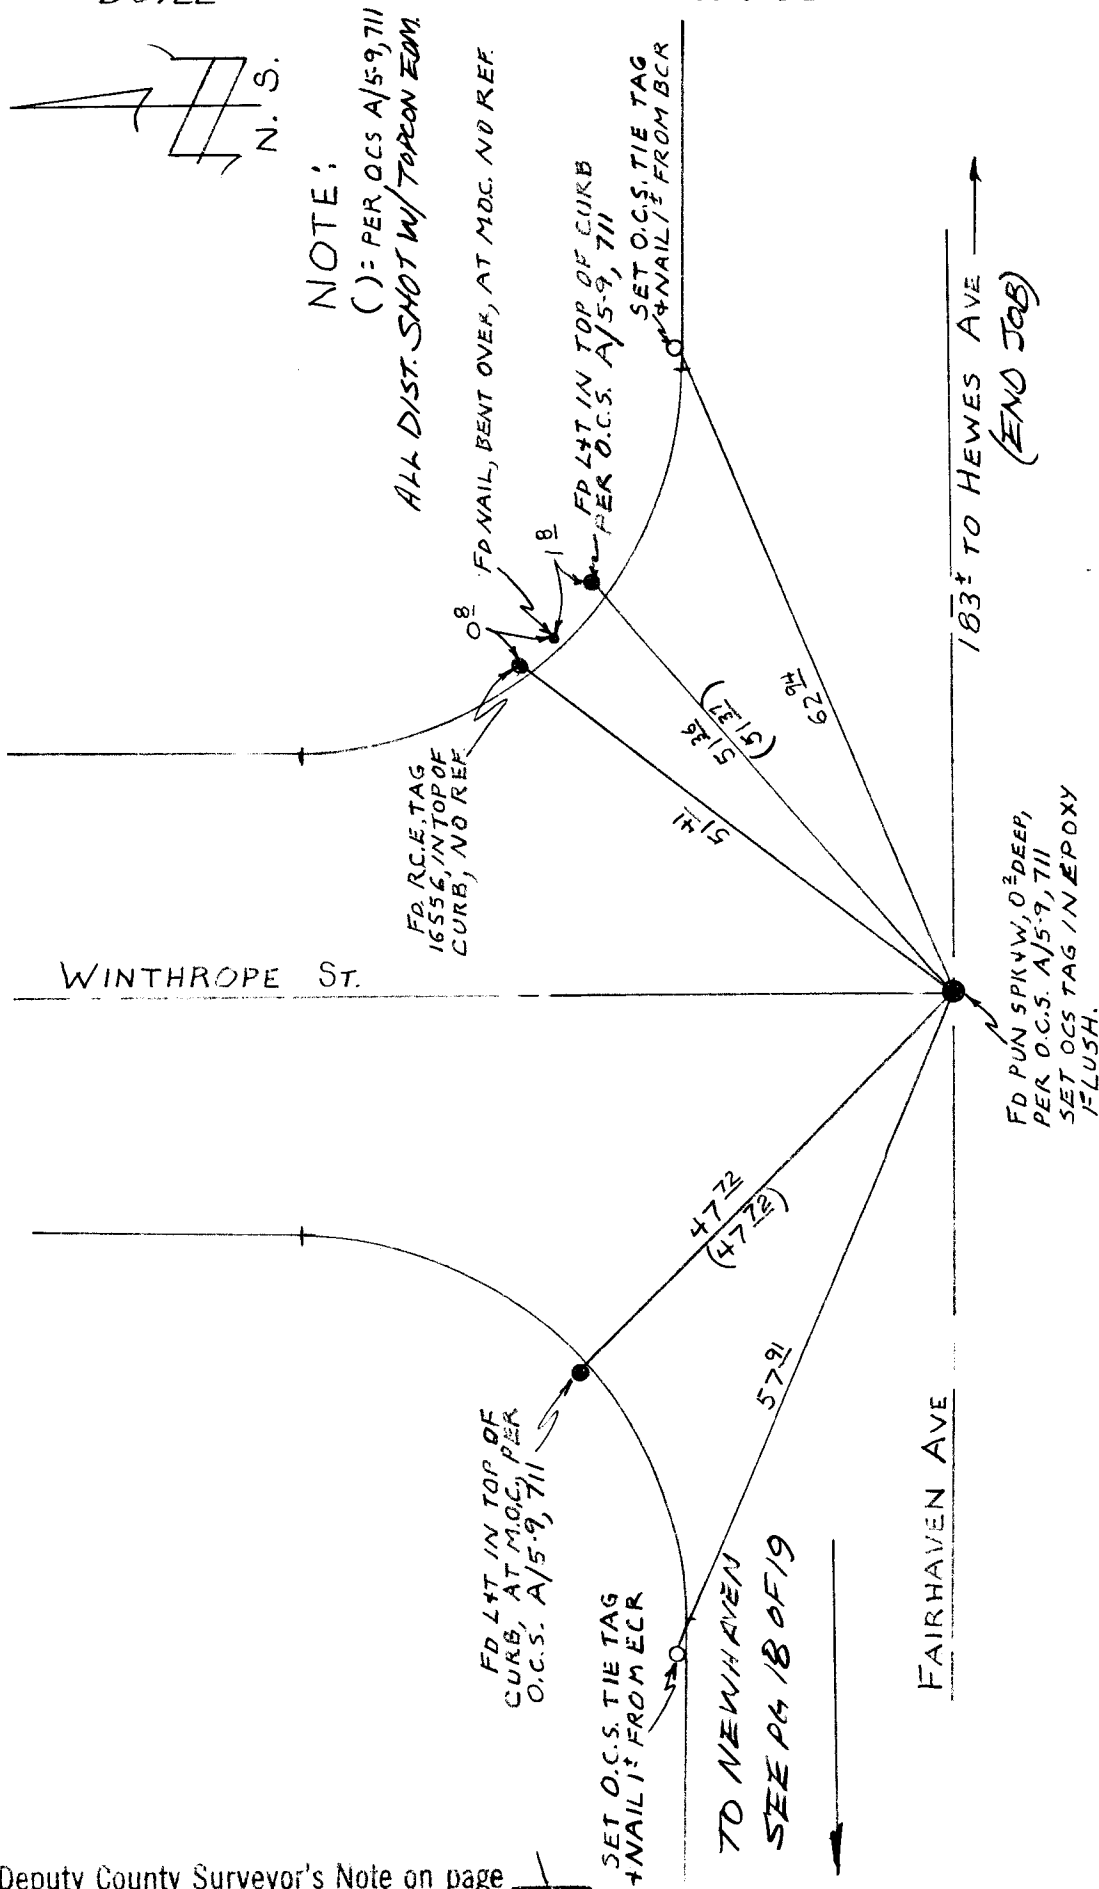

PAVEMENT MGMT.
DOYLE NOTES: PUFFING
(SEE PG 2 OF 6)

A/5-9 1047
9-8-88

21 OF 26
(1 OF 6)

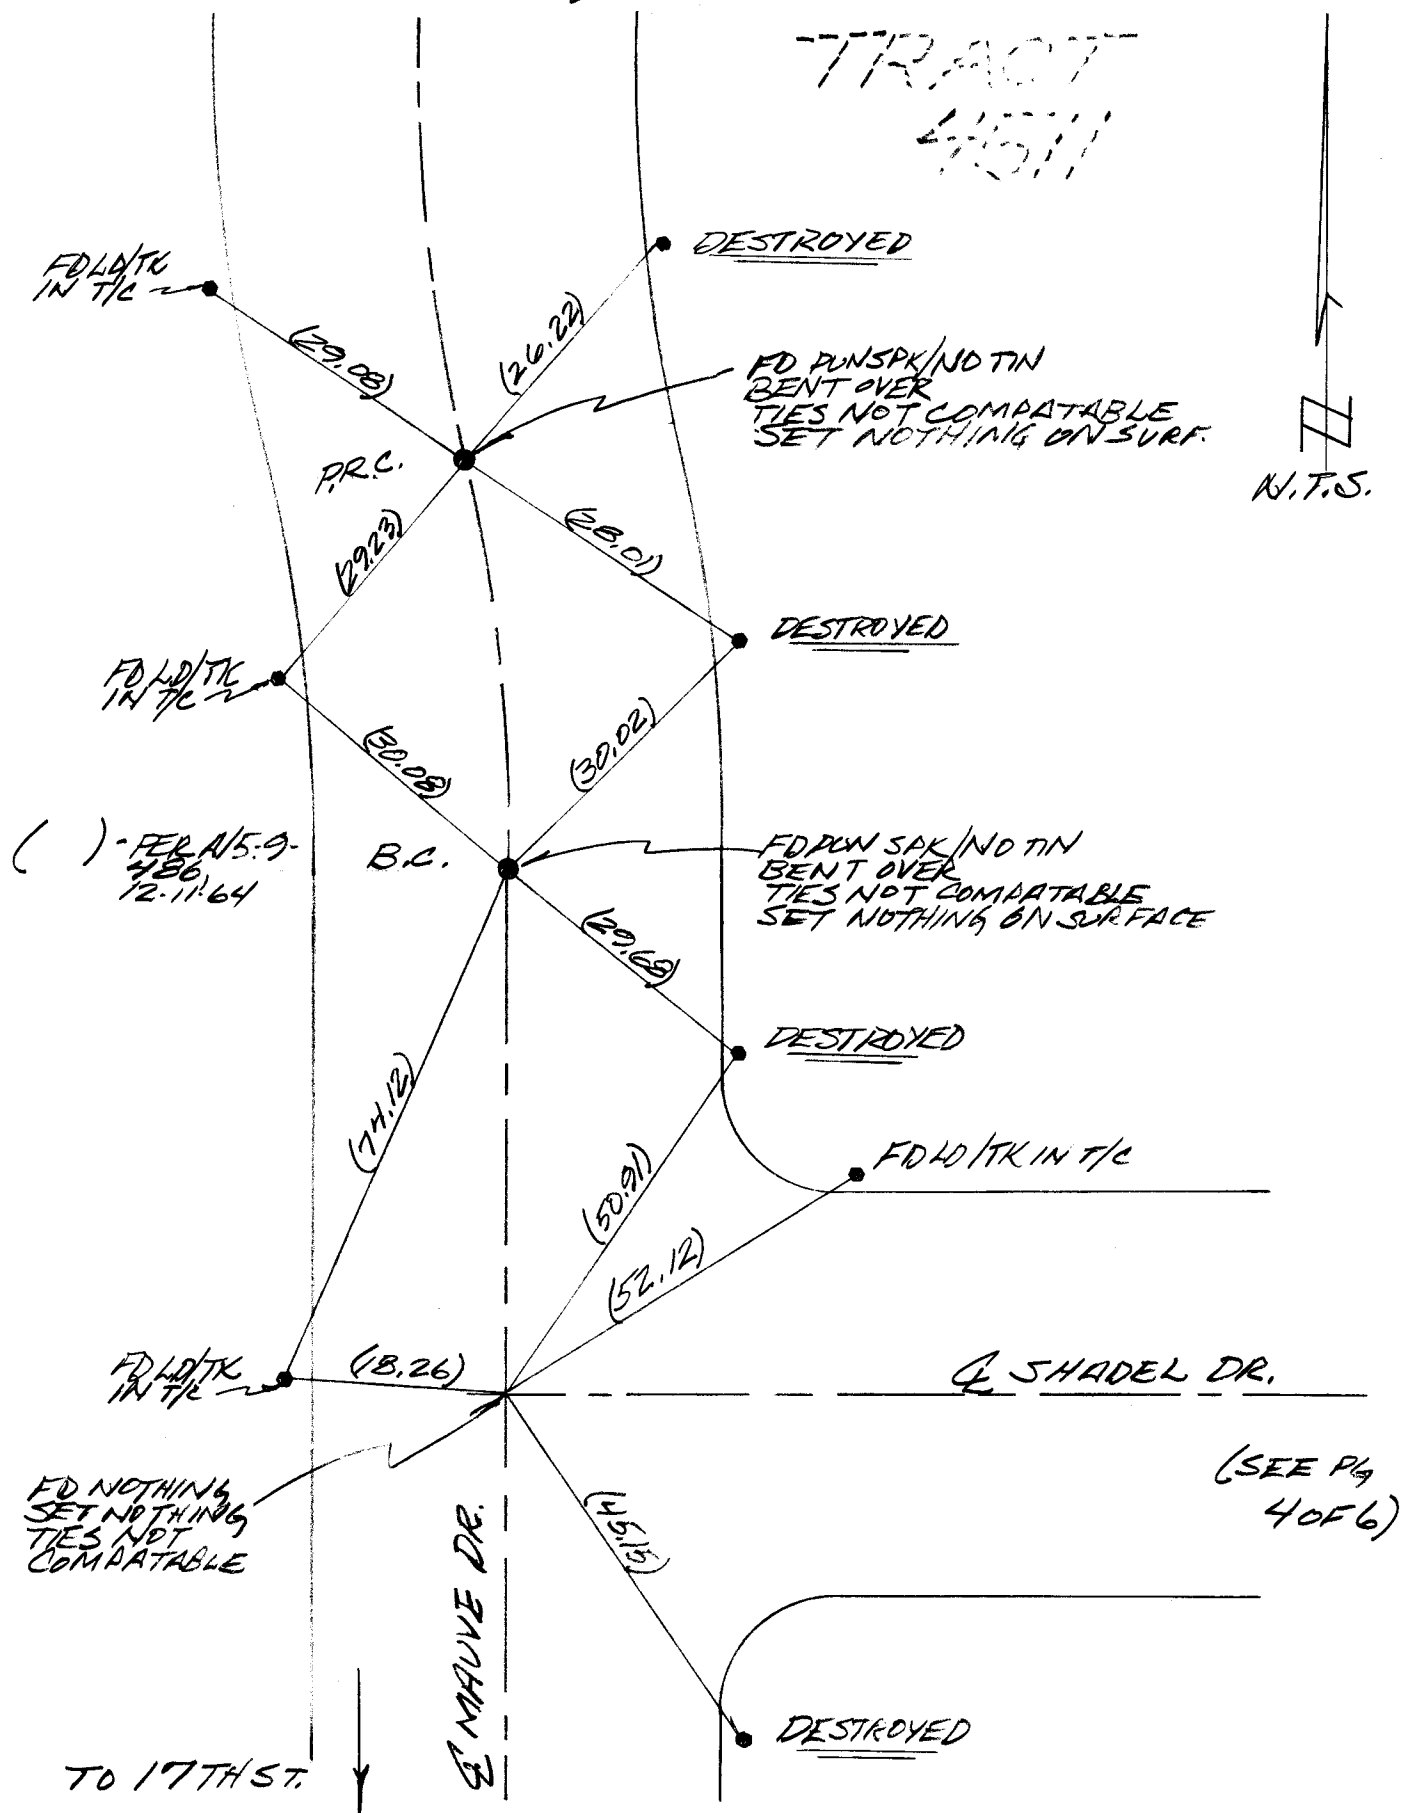

DOYLE NOTES: RUFFING

9888

TRACT
4-511

FD NOTHING
SET NOTHING
TIES NOT
COMPARABLE

FD PLN SAK NO TIN
BENT OVER.
SET NOTHING -
TIES NOT COM-
PARABLE

E.C.

DESTROYED

(SEE PG 10F6)

(SEE PG.
30F6)

N.T.S.

LIMETREE WAY

(SEE PG
50F6)

() - PER A/59-484,
12-11-64


• - FD LD/TK IN T/C
PER A/5-9; 12-11-64.

TR.4511
DOYLE

A/5-9
9-6-88

1049

230F26
(30F9)

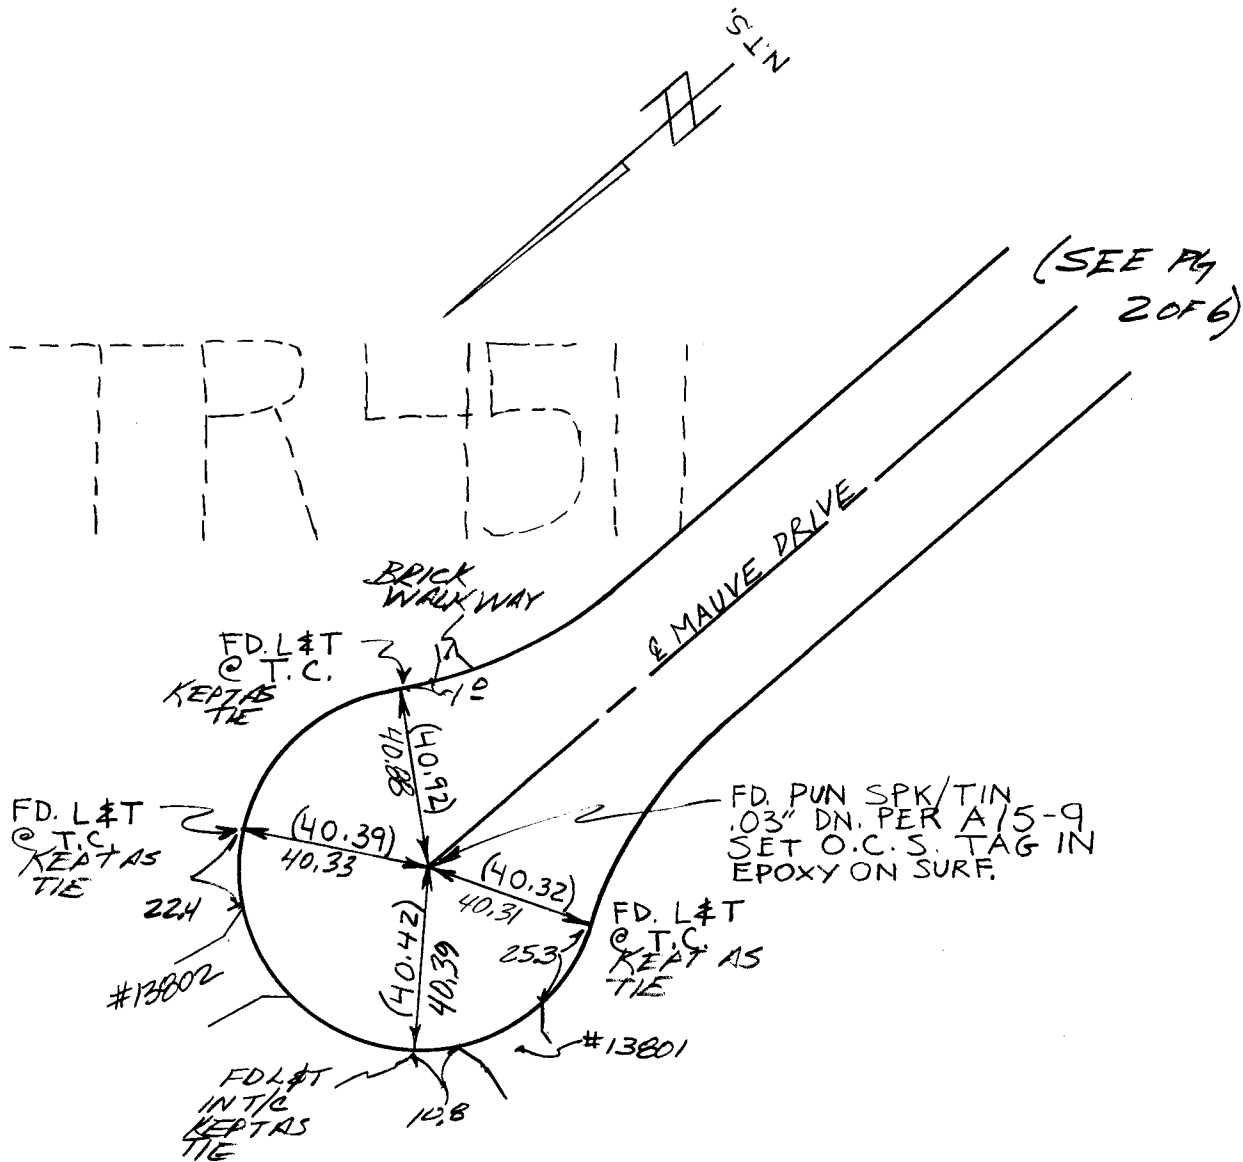

() FD. PER A/5-9-485
12-11-64

NOTE: DISTANCES FROM E SHOT
WITH TOTAL STATION.

See Deputy County Surveyor's Note on page 1

THE TIES SHOWN HEREON ARE FOR THE PURPOSE OF
PERPETUATING THE MONUMENTATION CURRENTLY EXISTING.
NO ATTEMPT WAS MADE TO DETERMINE THE VALIDITY OF
THE MONUMENTS OR THEIR PROPER LOCATION IN RELATION
TO LEGAL BOUNDARY LINES IN THE AREA.

PAVEMENT MANAGEMENT


A/5-9 1050

24 OF 26
(4 OF 6)

DOYLE NOTES: RUFFING

9.6.88

TRACT 4511

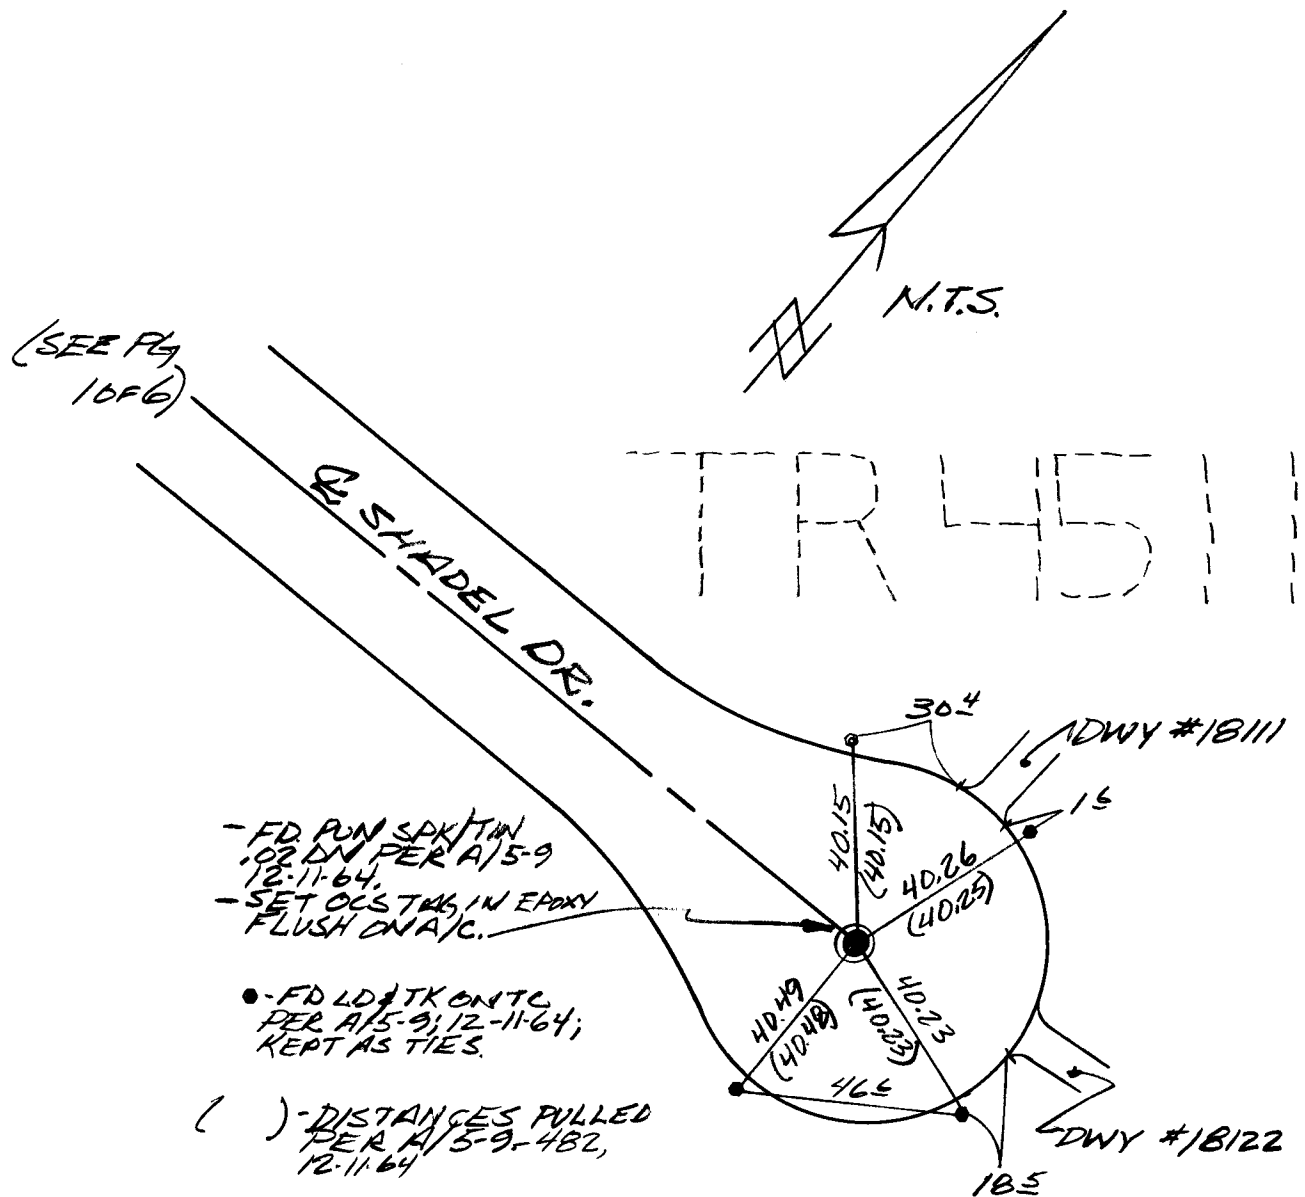

NOTE: DISTANCES FROM Σ SHOT WITH
TOTAL STATION.

THE TIES SHOWN HEREON ARE FOR THE PURPOSE OF
PERPETUATING THE MONUMENTATION CURRENTLY EXISTING.
NO ATTEMPT WAS MADE TO DETERMINE THE VALIDITY OF
THE MONUMENTS OR THEIR PROPER LOCATION IN RELATION
TO LEGAL BOUNDARY LINES IN THE AREA.

PAVEMENT MANAGEMENT

A/5-9


1051

DOYLE NOTES: RUFFING

9-6-88

25 OF 26
(5 OF 6)

ORANGE COUNTY SURVEYOR

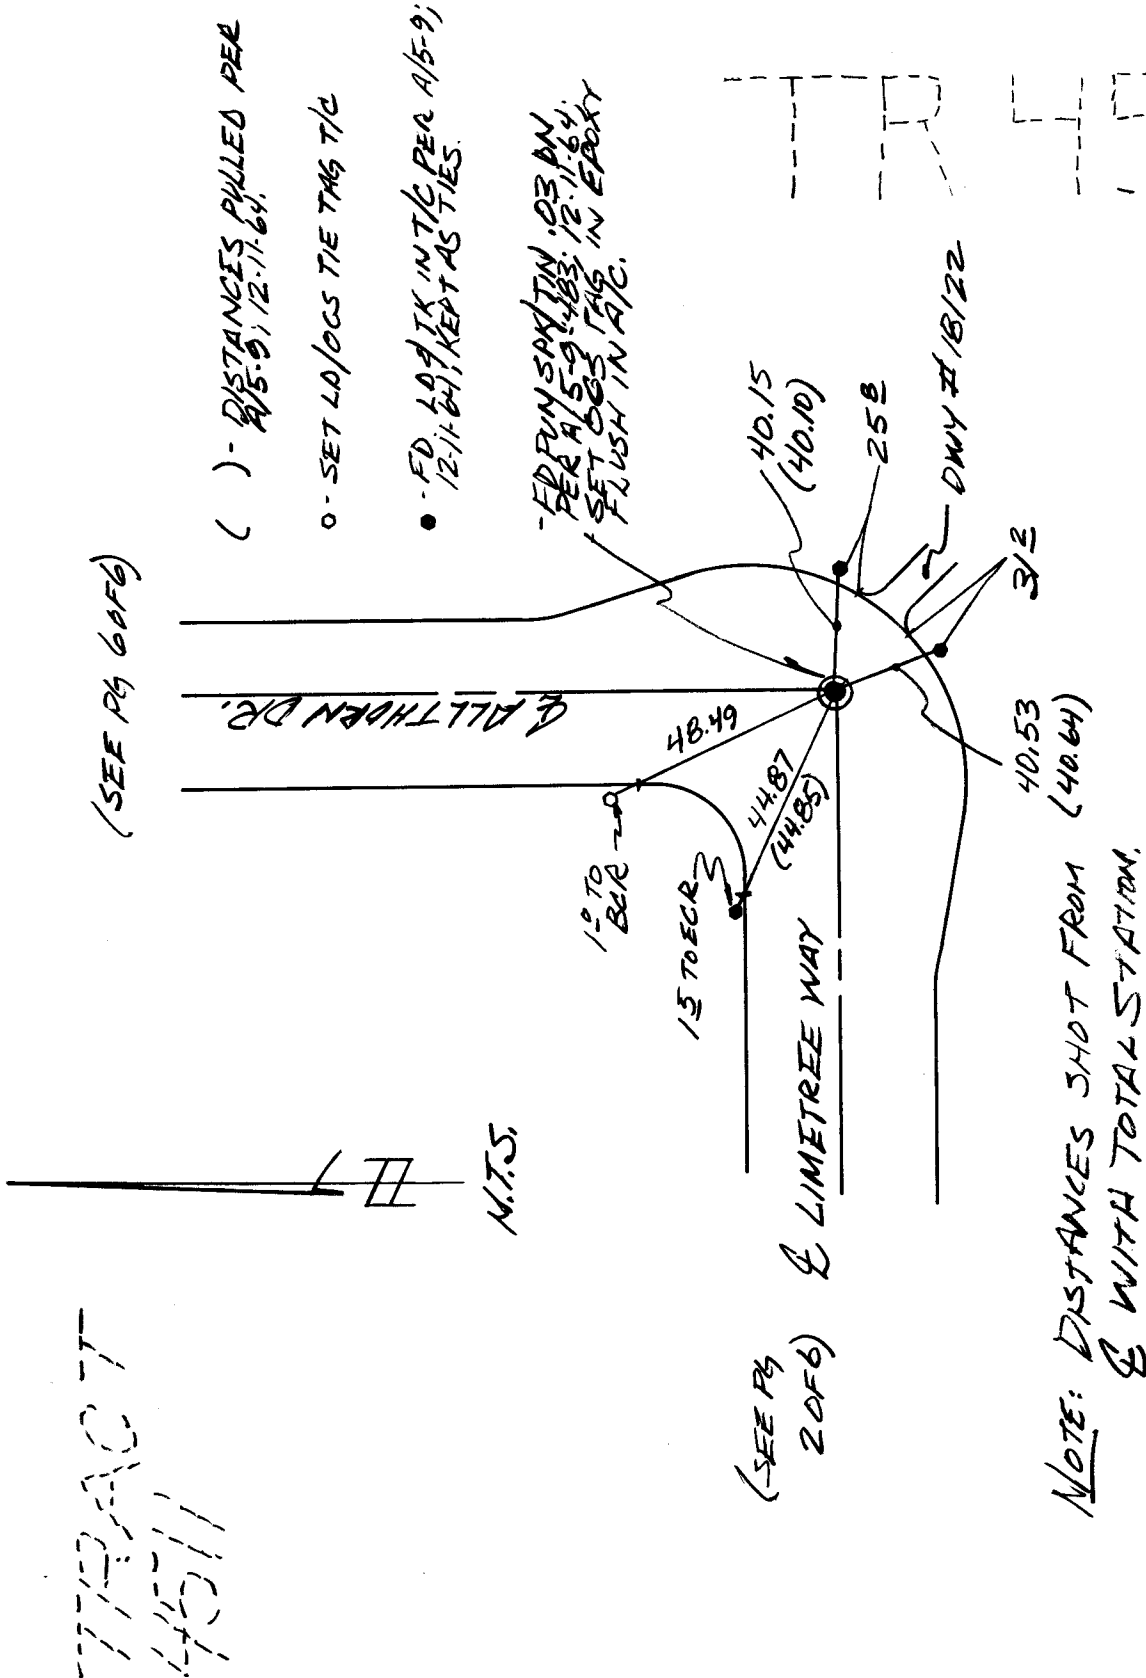

THE TIES SHOWN HEREON ARE FOR THE PURPOSE OF PERPETUATING THE MONUMENTATION CURRENTLY EXISTING. NO ATTEMPT WAS MADE TO DETERMINE THE VALIDITY OF THE MONUMENTS OR THEIR PROPER LOCATION IN RELATION TO LEGAL BOUNDARY LINES IN THE AREA.


DOYLE

A/5-9

1052

9-6-88

26 of 26
(6 of 6)

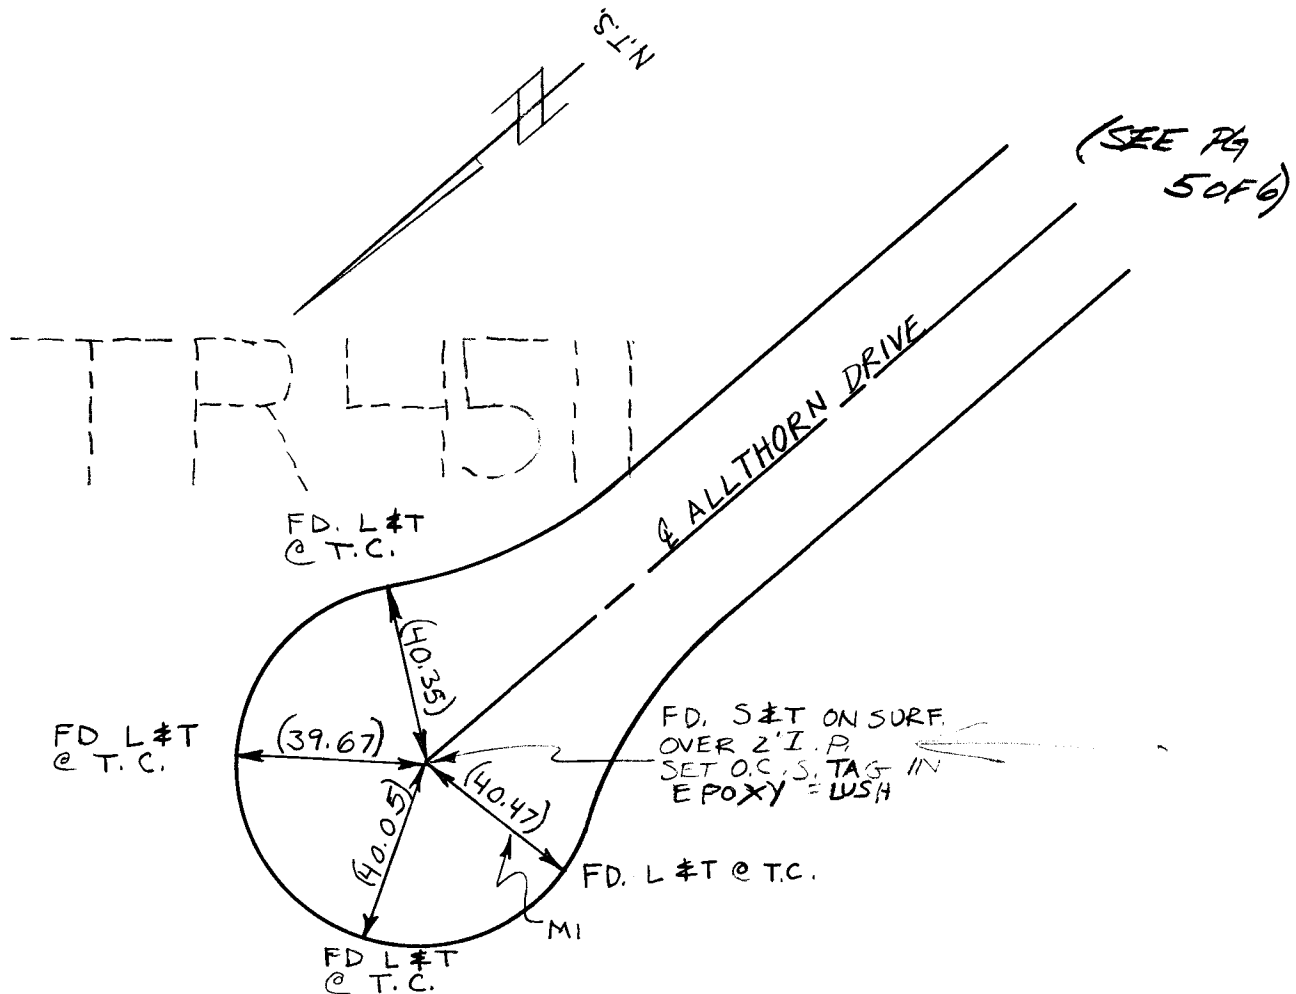

ROAD SLURRIED
UNABLE TO LOCATE W/DETECTOR
PULLED TIES

() PER A/5-9-480; 12-11-64

THE TIES SHOWN HEREON ARE FOR THE PURPOSE OF PERPETUATING THE MONUMENTATION CURRENTLY EXISTING. NO ATTEMPT WAS MADE TO DETERMINE THE VALIDITY OF THE MONUMENTS OR THEIR PROPER LOCATION IN RELATION TO LEGAL BOUNDARY LINES IN THE AREA.