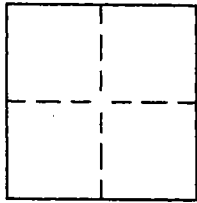


CORNER RECORD

Document Number 2006-1168BCity of UNINCORPORATED AREA County of ORANGE, CaliforniaBrief Legal Description PROSPECT AVENUE AT RAINIER DRIVE

CORNER TYPE

Government Corner ☐ Control ☐
Meander ☐ Property ☐
Rancho ☐ Other ☒
Date of Survey 6-28-06

COORDINATES (Optional)

N. _____
E. _____
Zone _____ NAD27 ☐ NAD83 ☐
NAD83 Epoch _____
Elev. _____
Vert. Datum: NGVD29 ☐ NAVD88 ☐
Meas. Units: Metric ☐ Imperial ☐
U.S. Survey foot ☒


Corner— Left as found ☐ Found and tagged ☐ Established ☐ Reestablished ☒ Rebuilt ☐

Identification and type of corner found: Evidence used to identify or procedure used to establish or reestablish the corner:
ESTABLISHED MONUMENTATION AS DESCRIBED ON PAGE 2.

A description of the physical condition of the monument as found and as set or reset: AFTER STREET
RECONSTRUCTION THE MONUMENTATION SHOWN ON PAGE 2 WAS REESTABLISHED.

SURVEYOR'S STATEMENT

This Corner Record was prepared by me or under my direction in conformance with
the Land Surveyors' Act on AUGUST 4, 2006
Signed David A. Bush (L.S. or R.C.E. No. NO. 7052)

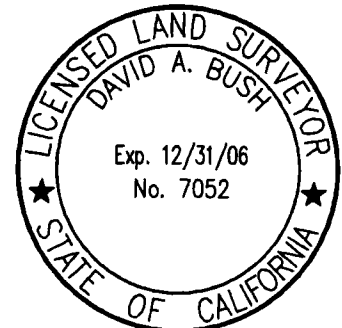

COUNTY SURVEYOR'S STATEMENT

This Corner Record was received AUG 09 2006
and examined and filed SEP 06 2006
Signed [Signature] (L.S. or R.C.E. No. 7212)
Title DEPUTY COUNTY SURVEYOR



County Surveyor's Comment _____

MONUMENT NOTES:

- △ SET SPIKE AND WASHER LS 7052, PER CORNER RECORD 2005-1253A, AFTER STREET RECONSTRUCTION.
- FOUND LEAD AND OCS TIE TAG IN TC, PER CORNER RECORD 2005-1253A, AFTER STREET RECONSTRUCTION.

THE TIES SHOWN HEREON ARE FOR THE PURPOSE OF PERPETUATING THE MONUMENTATION CURRENTLY EXISTING. NO ATTEMPT WAS MADE TO DETERMINE THE VALIDITY OF THE MONUMENTS OR THEIR PROPER LOCATION IN RELATION TO LEGAL BOUNDARY LINES IN THE AREA.

