

ORANGE COUNTY SURVEYOR
SURVEY NOTES

A/5-9 968

ALIGNMENT INDEX BOOK AND PAGE

ALIGNMENT NOTES PG. 1 OF 21

PPB _____ WORK ORDER NUMBER R38001434

SURVEY NOTES PAGE 1243 OF 21

SURVEY COMPLETION DATE 1-7-86

SURVEY FILE NUMBER R 85-52A"

PROJECT NAME ETIES VARIOUS STREETS

SURVEY LIMITS ETHEL BEE WAY FROM SANTA CLARA AVE TO LARKSTONE DR.
PALOMAR WAY FROM RAINIER DR TO CASSELLE AVE.

PURPOSE OF SURVEY LOCATE AND UP-DATE EXISTING MONUMENTS
AND MONUMENT TIES WITHIN COUNTY STREETS

THOMAS BROS.:

BLOCK AND MODULES:

SEE PG 3

SEE PG. 3

SURVEY NOTE PAGE INDEX:

EQUIPMENT:

PERSONNEL:

T-1 # 52405

100' CHAIN

FLYNN PC 

SAKACH T 

BUBE REC 

ZELMER REC 

MCNALLY EAI 

REFERENCES / REMARKS :

A/4-9, PAGE 353 A/5-9, PAGES 201, 212, 273, 383, 385, 683, 685, 687

MM 133/PAGES 3-4 MM 80/PAGES 11-12


TR 2034 TR 5928

RESET OR DUG UP POINTS AFTER CONST

7-8-86 / 12-1-87 NOTE: THE TIES SHOWN HEREIN
ARE FOR THE PURPOSE OF PERPETUATING THE MONUMENTATION
CURRENTLY EXISTING. NO ATTEMPT WAS MADE TO DETERMINE
THE VALIDITY OF THE MONUMENTS OR THEIR PROPER
LOCATION IN RELATION TO LEGAL BOUNDARY LINES IN THE AREA.

Q TIES VARIOUS STREETS
FLYNN & PARTY

1- -86

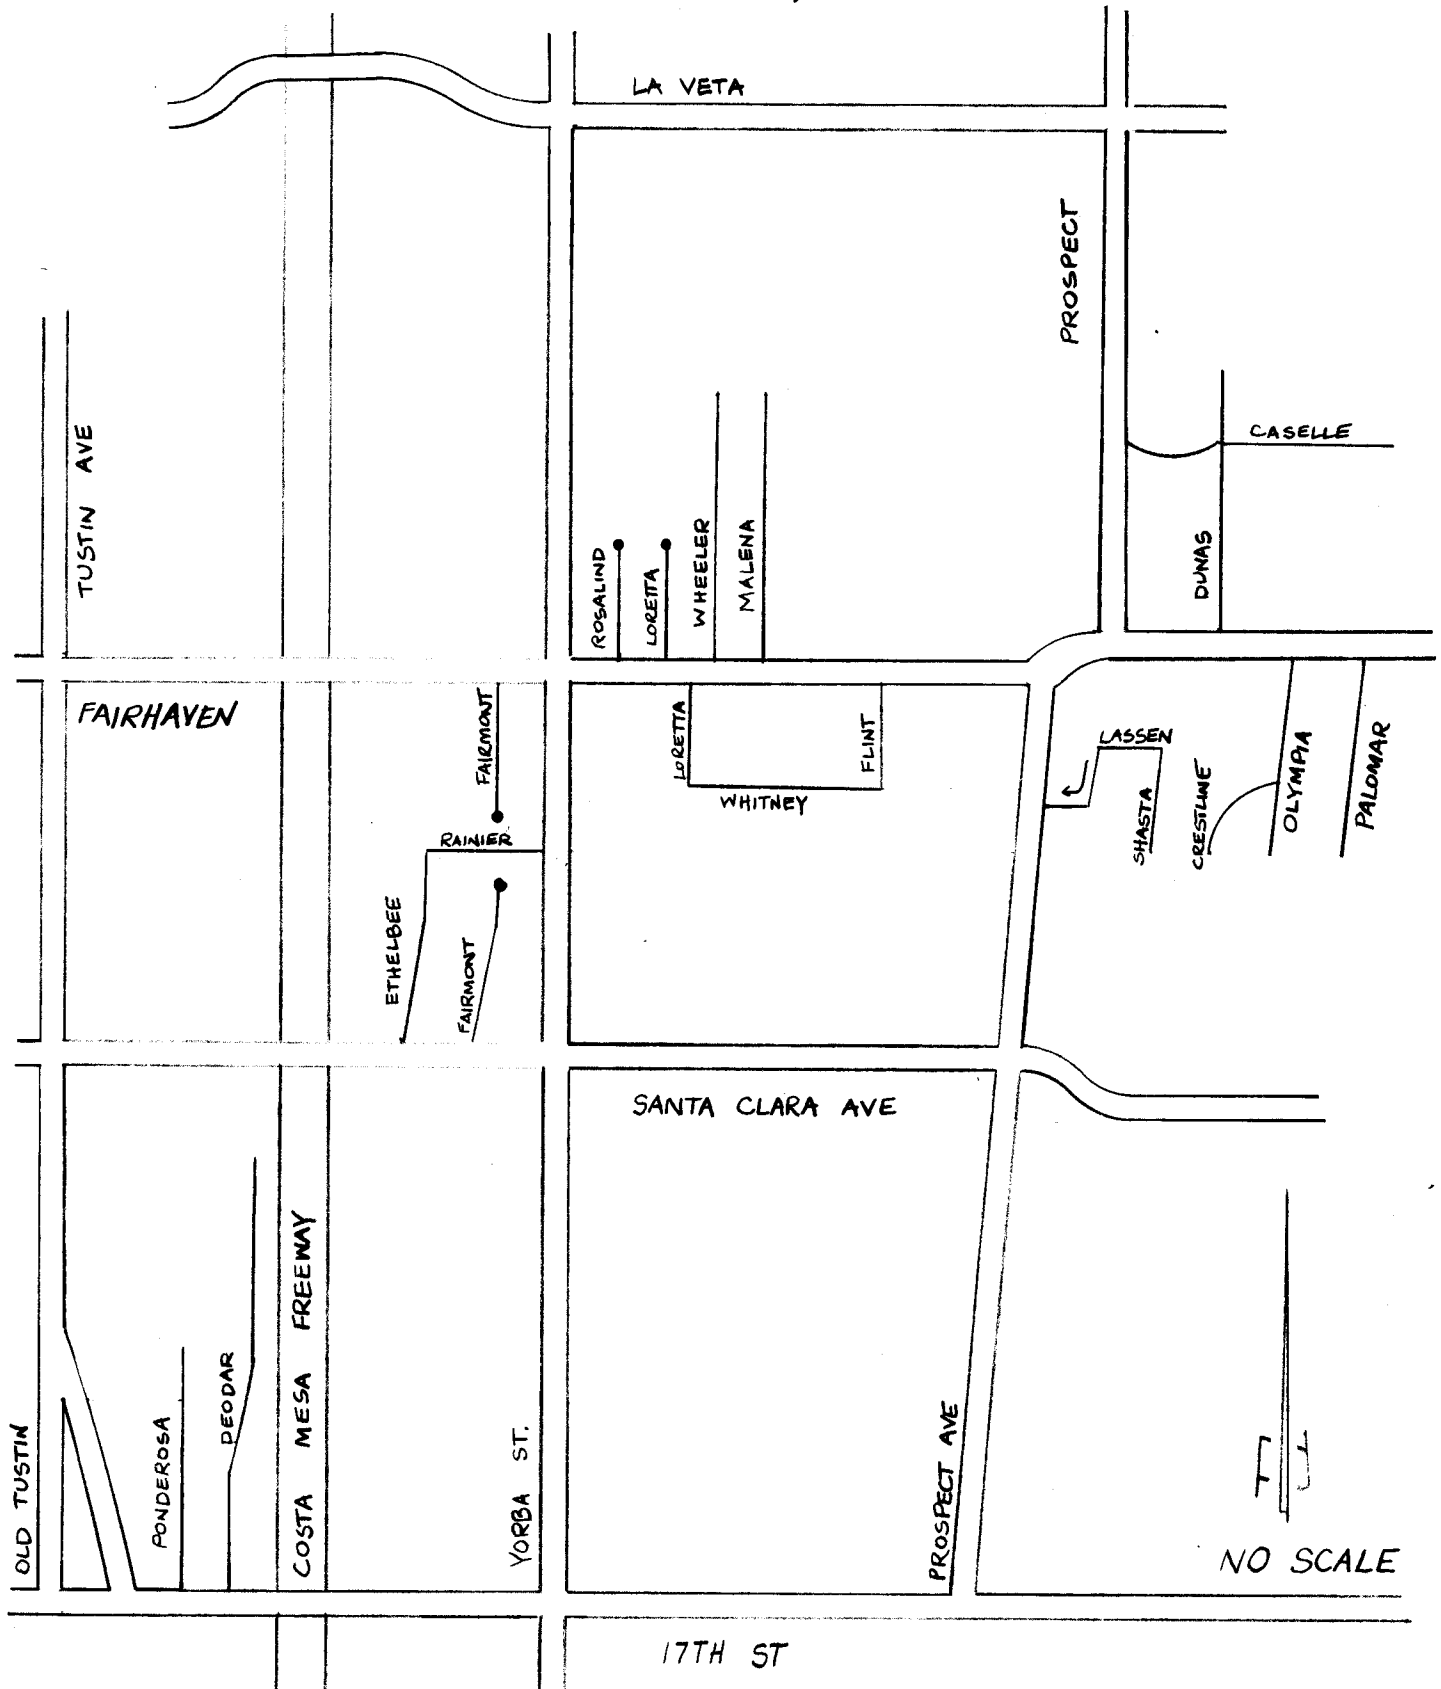

VICINITY

MAP

ETIES VARIOUS STREETS

FLYNN & PARTY

1- 86

STREET NAME	THOMAS GUIDE		BLOCK & MODULE				PAGE
	PAGE	SEE					
PONDEROSA	17-E-5		5851	38	48	58	4
DEODAR ST	17-E-5		5851	39	49	59	5 & 6
ETHEL BEE WAY.	17-E-5		5852	05	06	07	7
FAIRMONT MOUNT WAY.	17-E-5		5852	05	06	07	9
RAINIER DR.	17-F-5		5852	70			7 & 8
LORETTA DR.	17-F-4		5852	71	81		11 & 14
WHITNEY DR.	17-F-5		5852	71	72	73	14, 15, 16 & 17
FLINT DR.	17-F-5		5852	71	72		17 & 18
ROSALIND DR.	17-F-5		5852	94	95		10
WHEELER PL.	17-F-5		5852	81	91	71	12
MALENA DR.	17-F-4		5852	81	91	71	13 & 16
LASSEN DR.	17-F-5		5852	73			—
SHASTA WY.	17-F-5		5852	73			—
CRESTLINE DR.	18-A-5		5852	74	64		21
PALOMAR WY.	17-F-4		5852	74	64		—
CASSELLE AV.	17-F-4		5852	94	95		19 & 20
DUNAS RD.	18-A-4		5852	84	94		20


Q TIES VARIOUS STREETS

A/5-9 971

4 OF 21

FLYNN

12-23-85

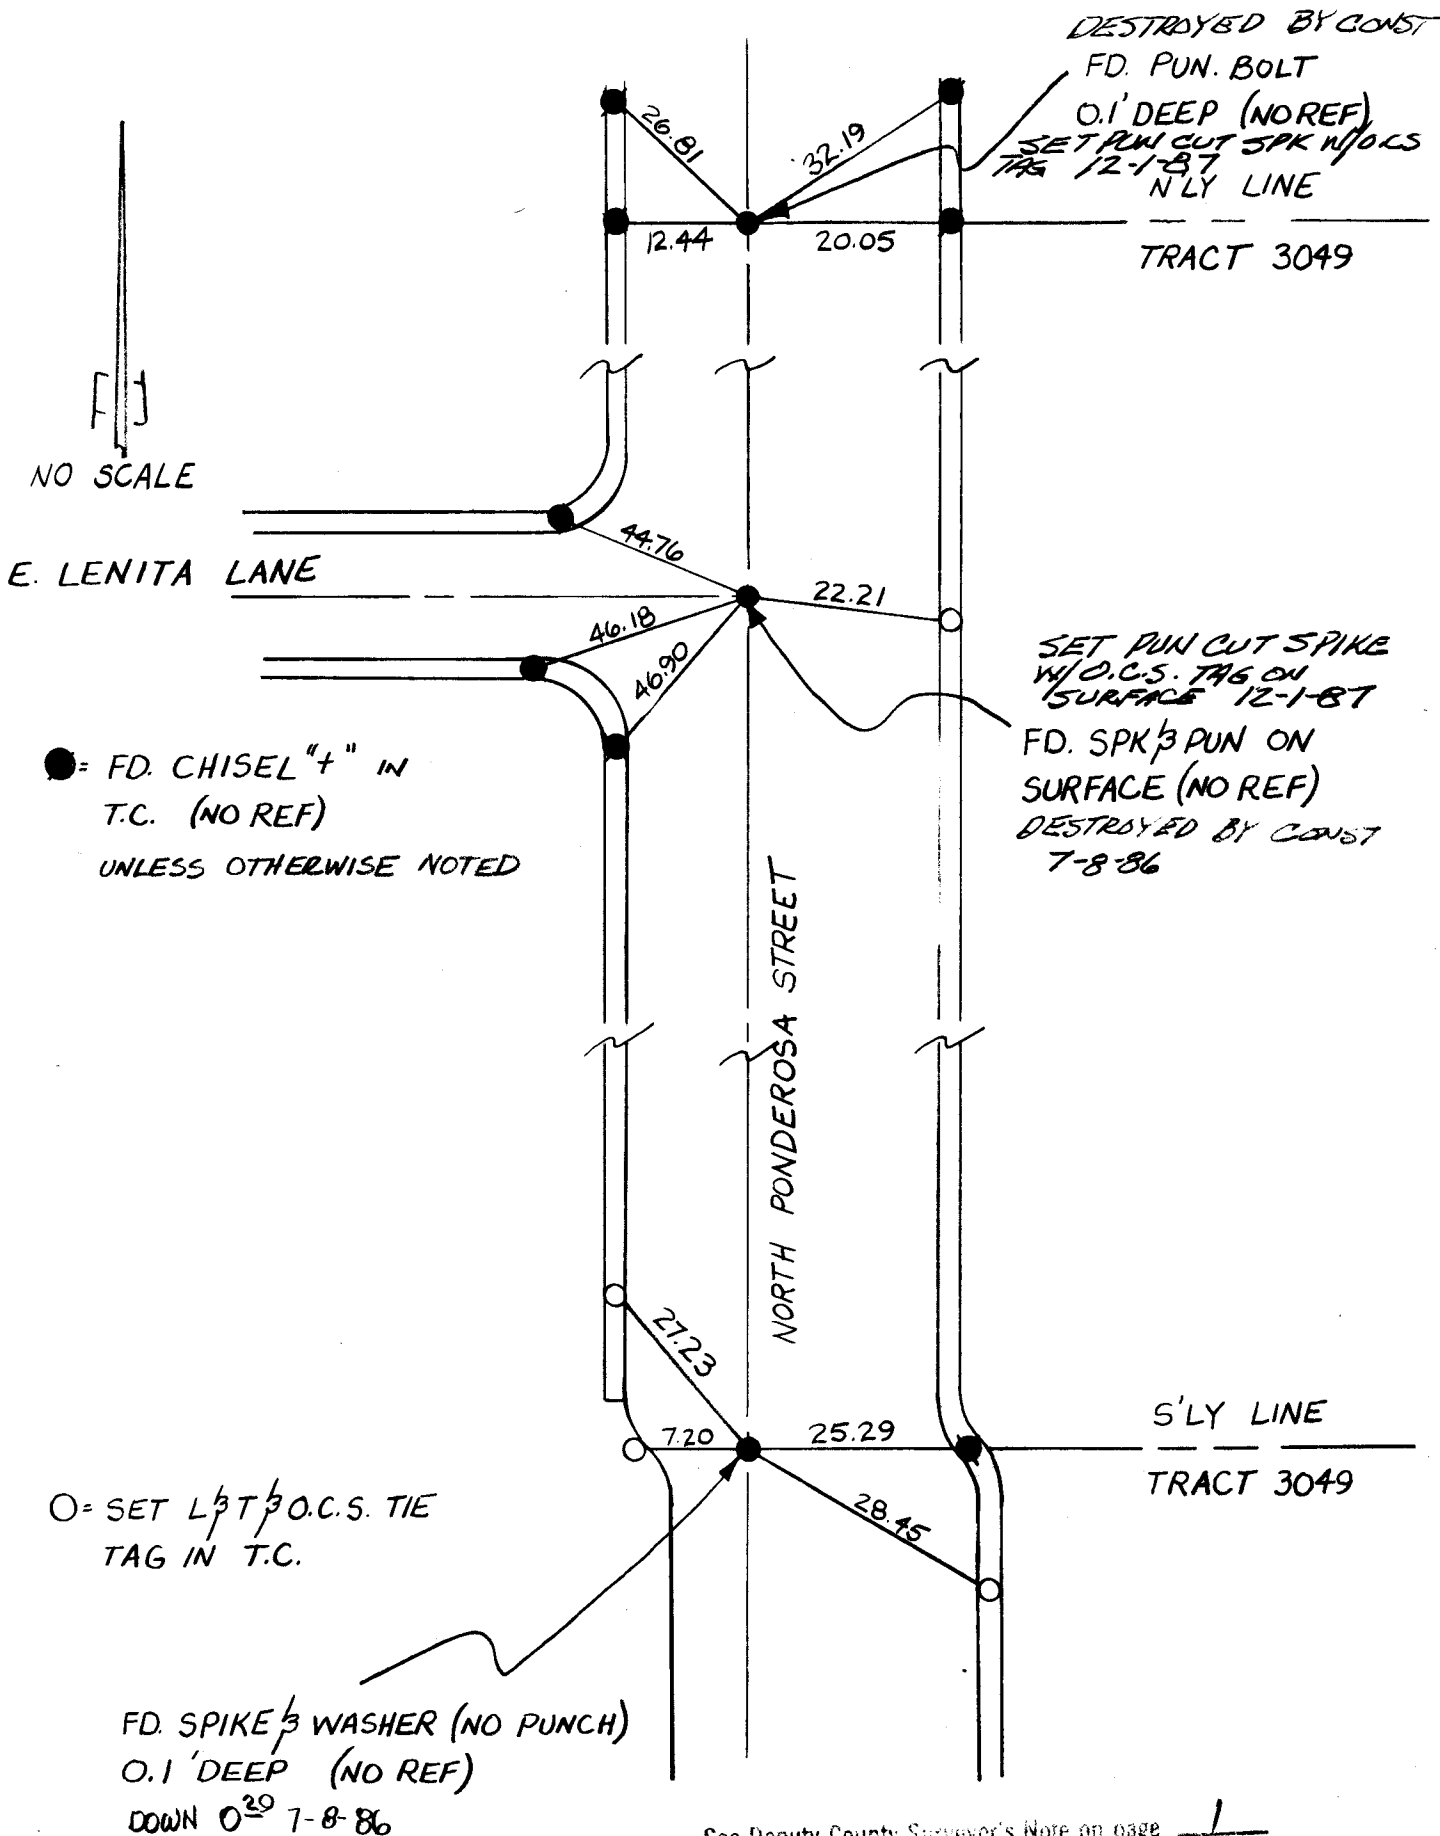

Q TIES VARIOUS STREETS

FLYNN


12-23-85

NOTE:

DID NOT RESET
NON REF POINTS AFTER
CONST. 12-1-87



NO SCALE

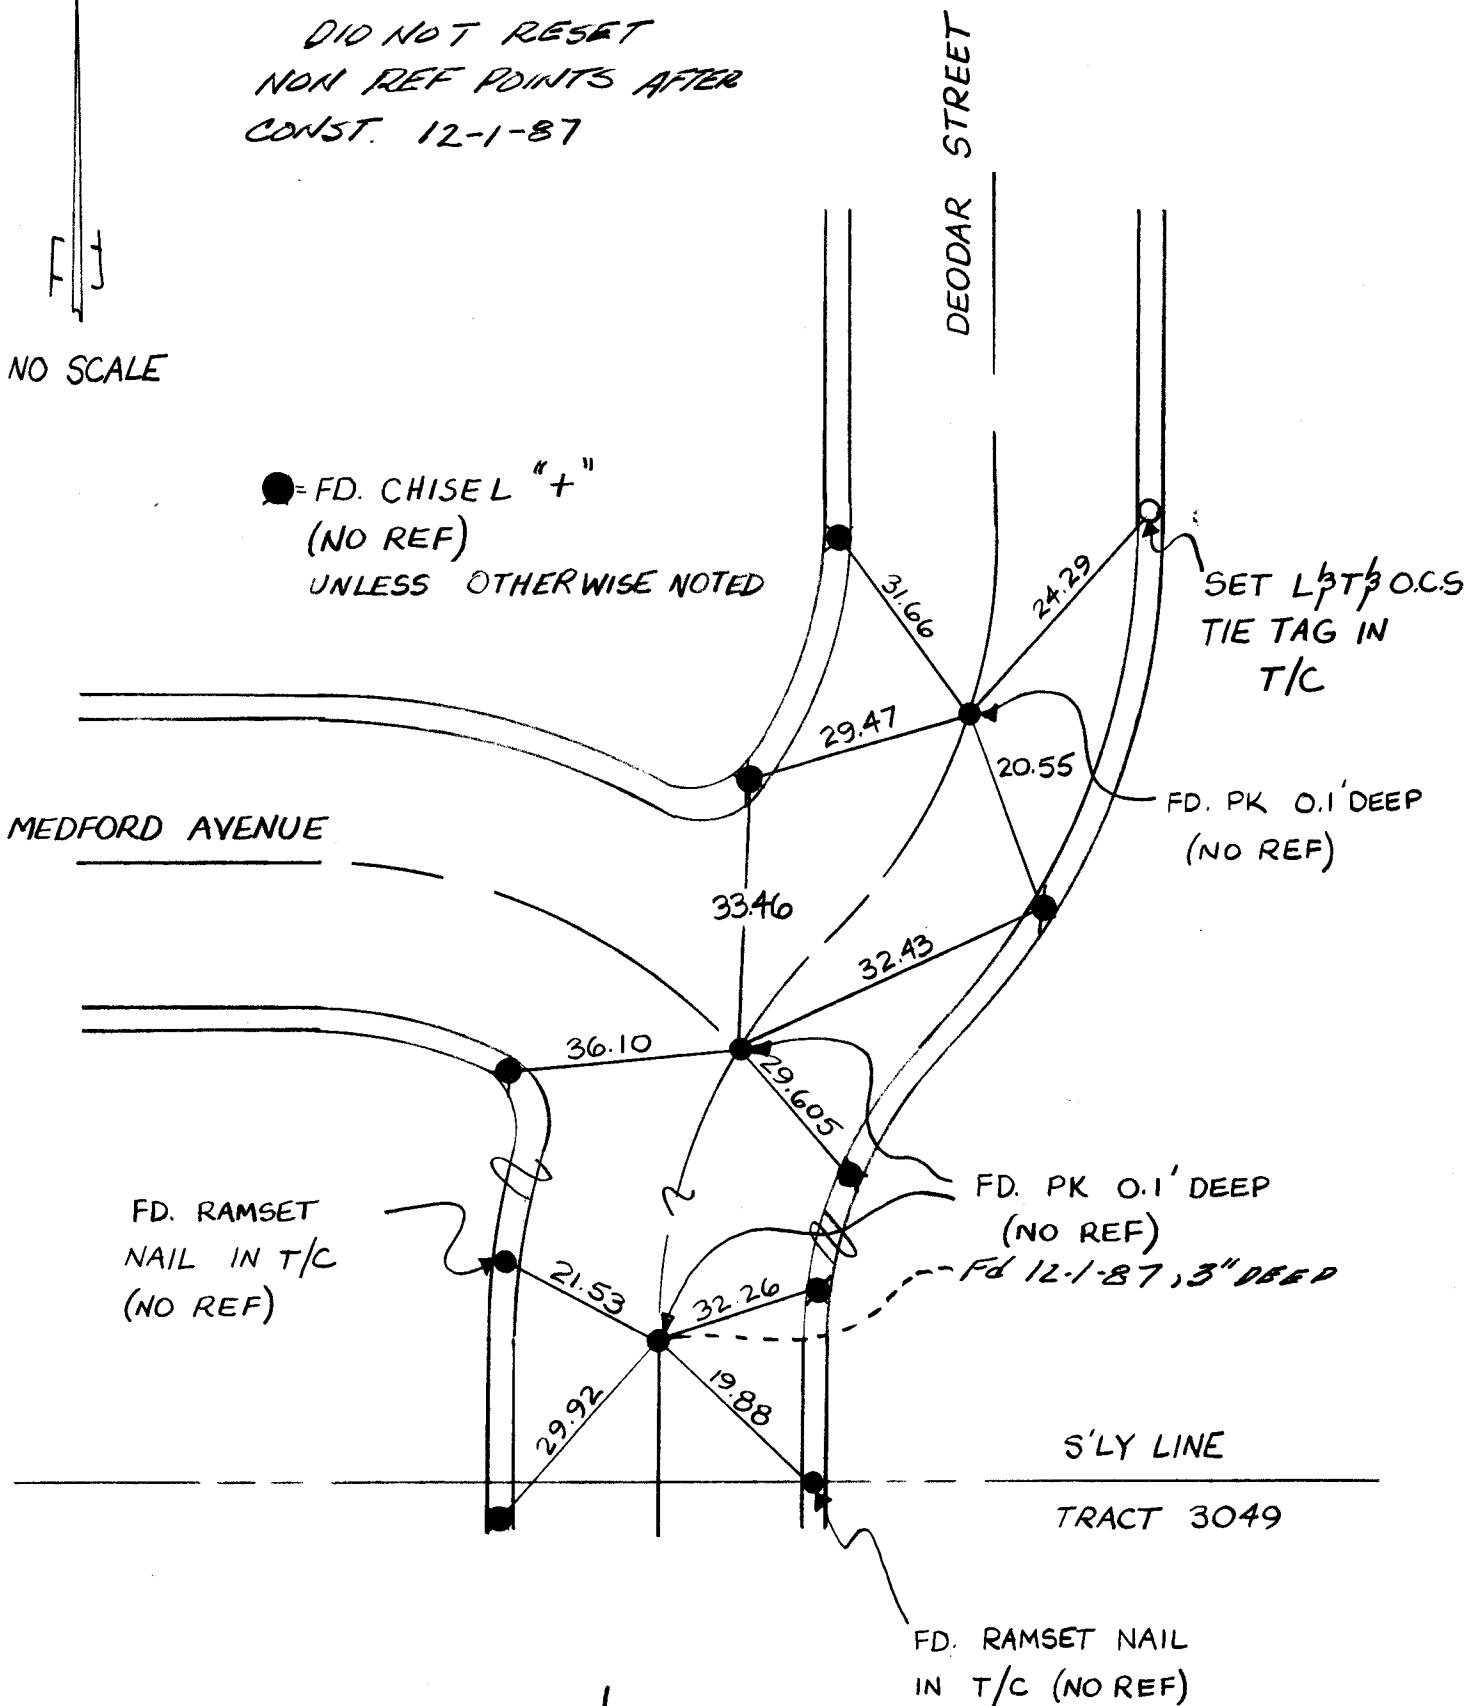



Q TIES VARIOUS STREETS

Flynn


12/16/85

O = Set L. & Tack O.C.S.
Tie tag in T.C.

LOT 28

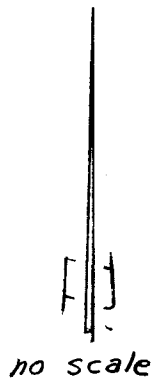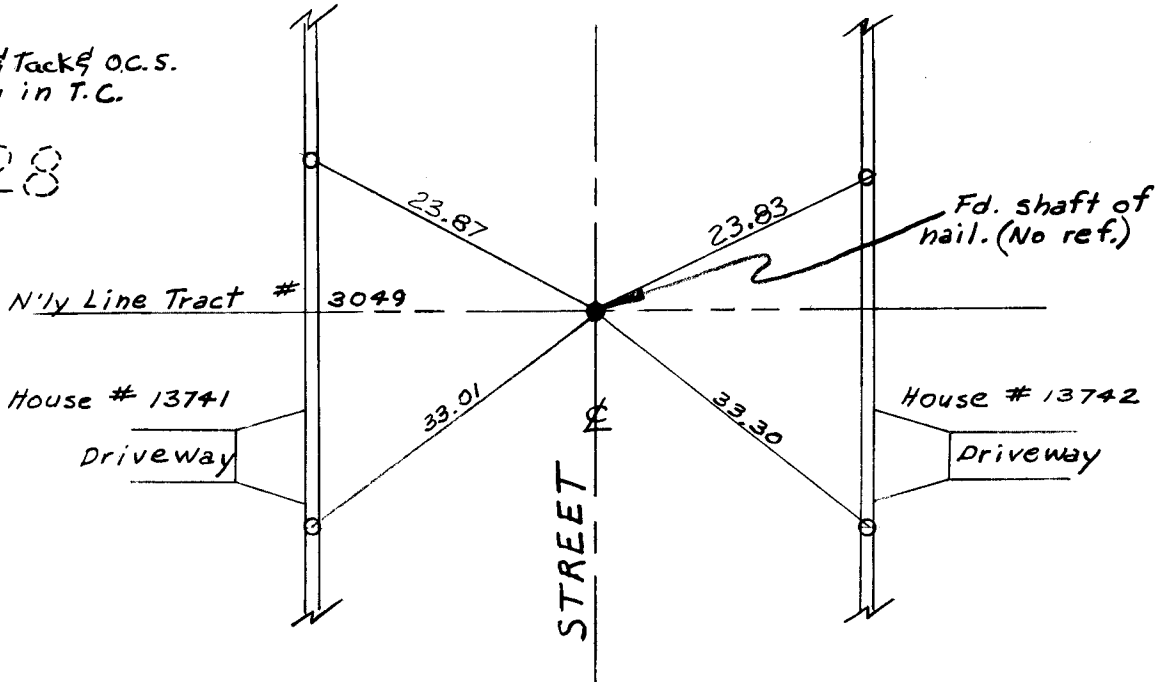

LOT 23

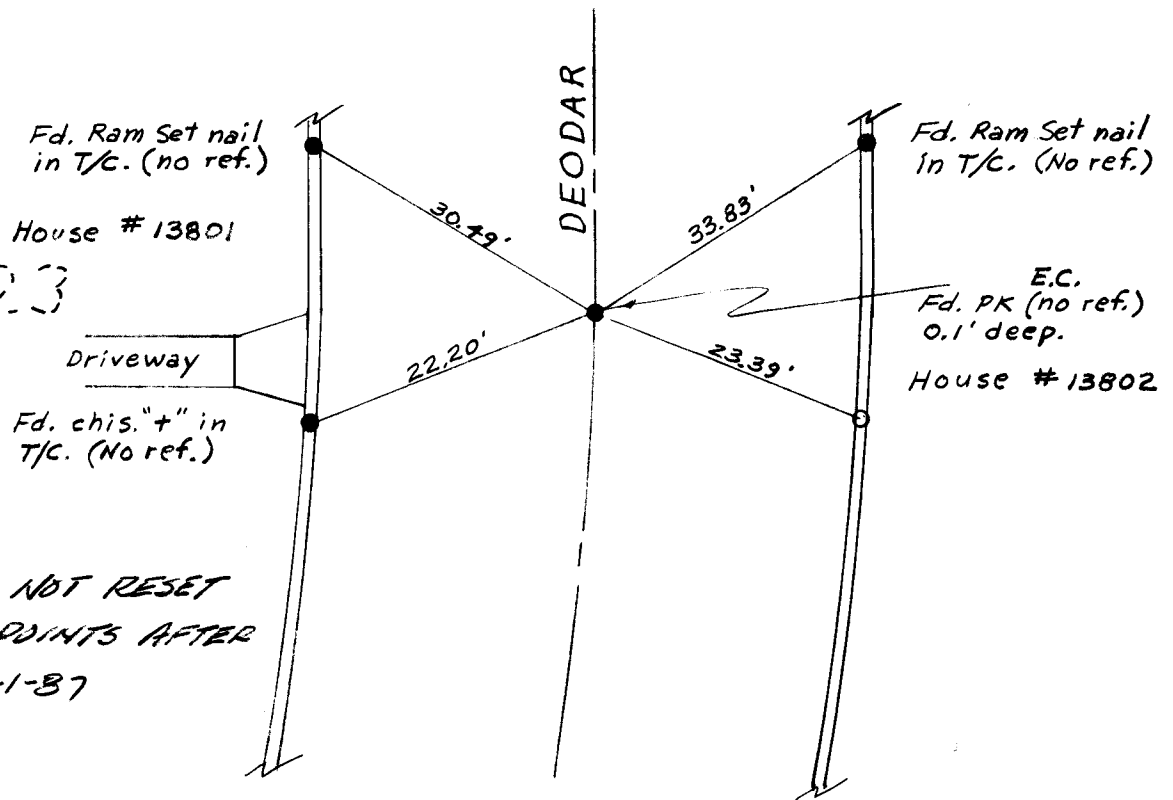


NOTE: DID NOT RESET
NON REF POINTS AFTER
CONST. 12-1-87

TRACT 3049

TIES VARIOUS STREETS

FLYNN

12/17/85

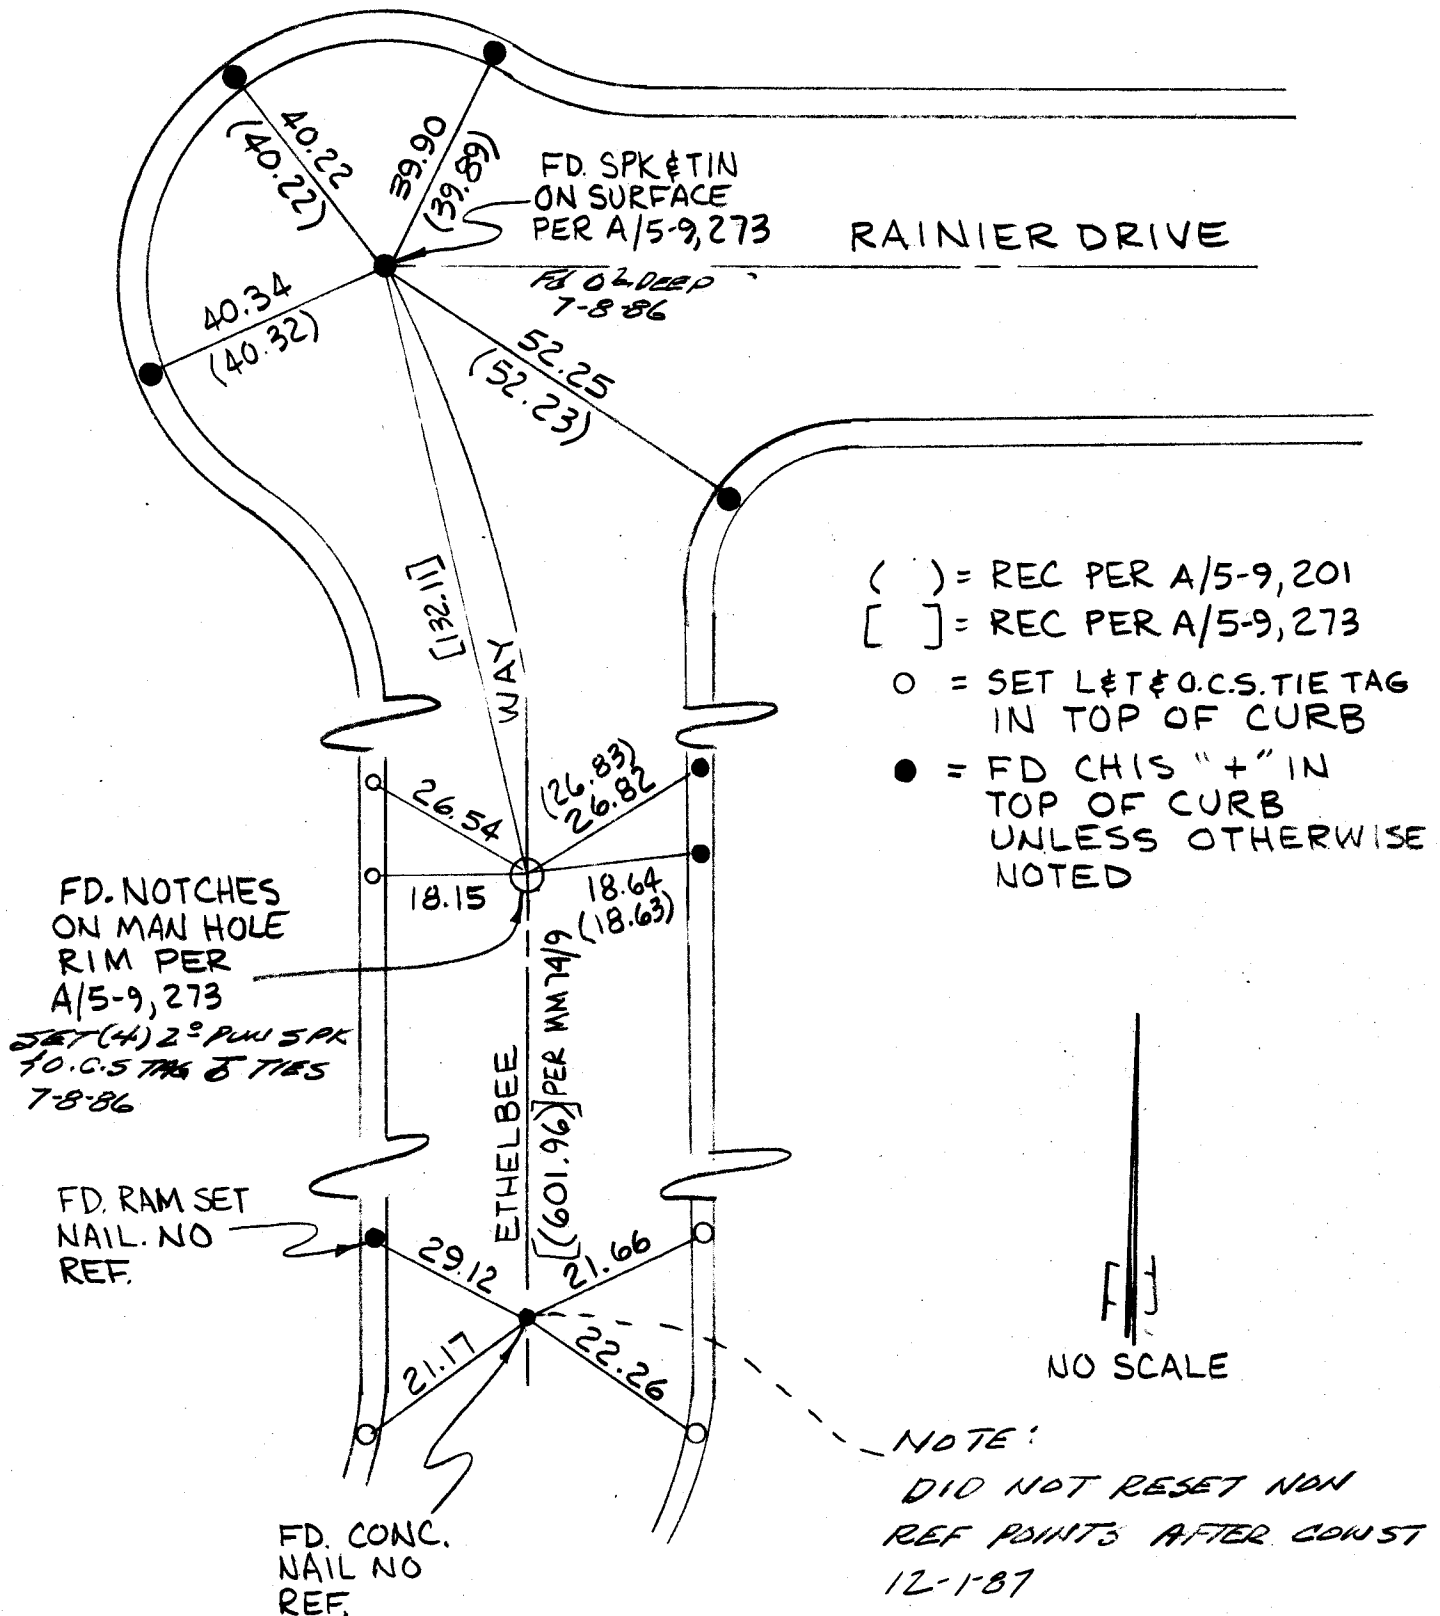

Q TIES VARIOUS STREETS

A/5-9 8⁹⁷⁵ OF 21

FLYNN

12/17/85
YORBA STREET


NO SCALE

E'LY TRACT LINE

● = FD. P.K. & T/N PER
O.C.S. A/5-9, PG. 212 & 213, 0'5 DEEP 7-8-86 UNLESS OTHERWISE NOTED
O=SET L&T O.C.S. TIE
TAG IN T/C

LOT 9

LOT 10

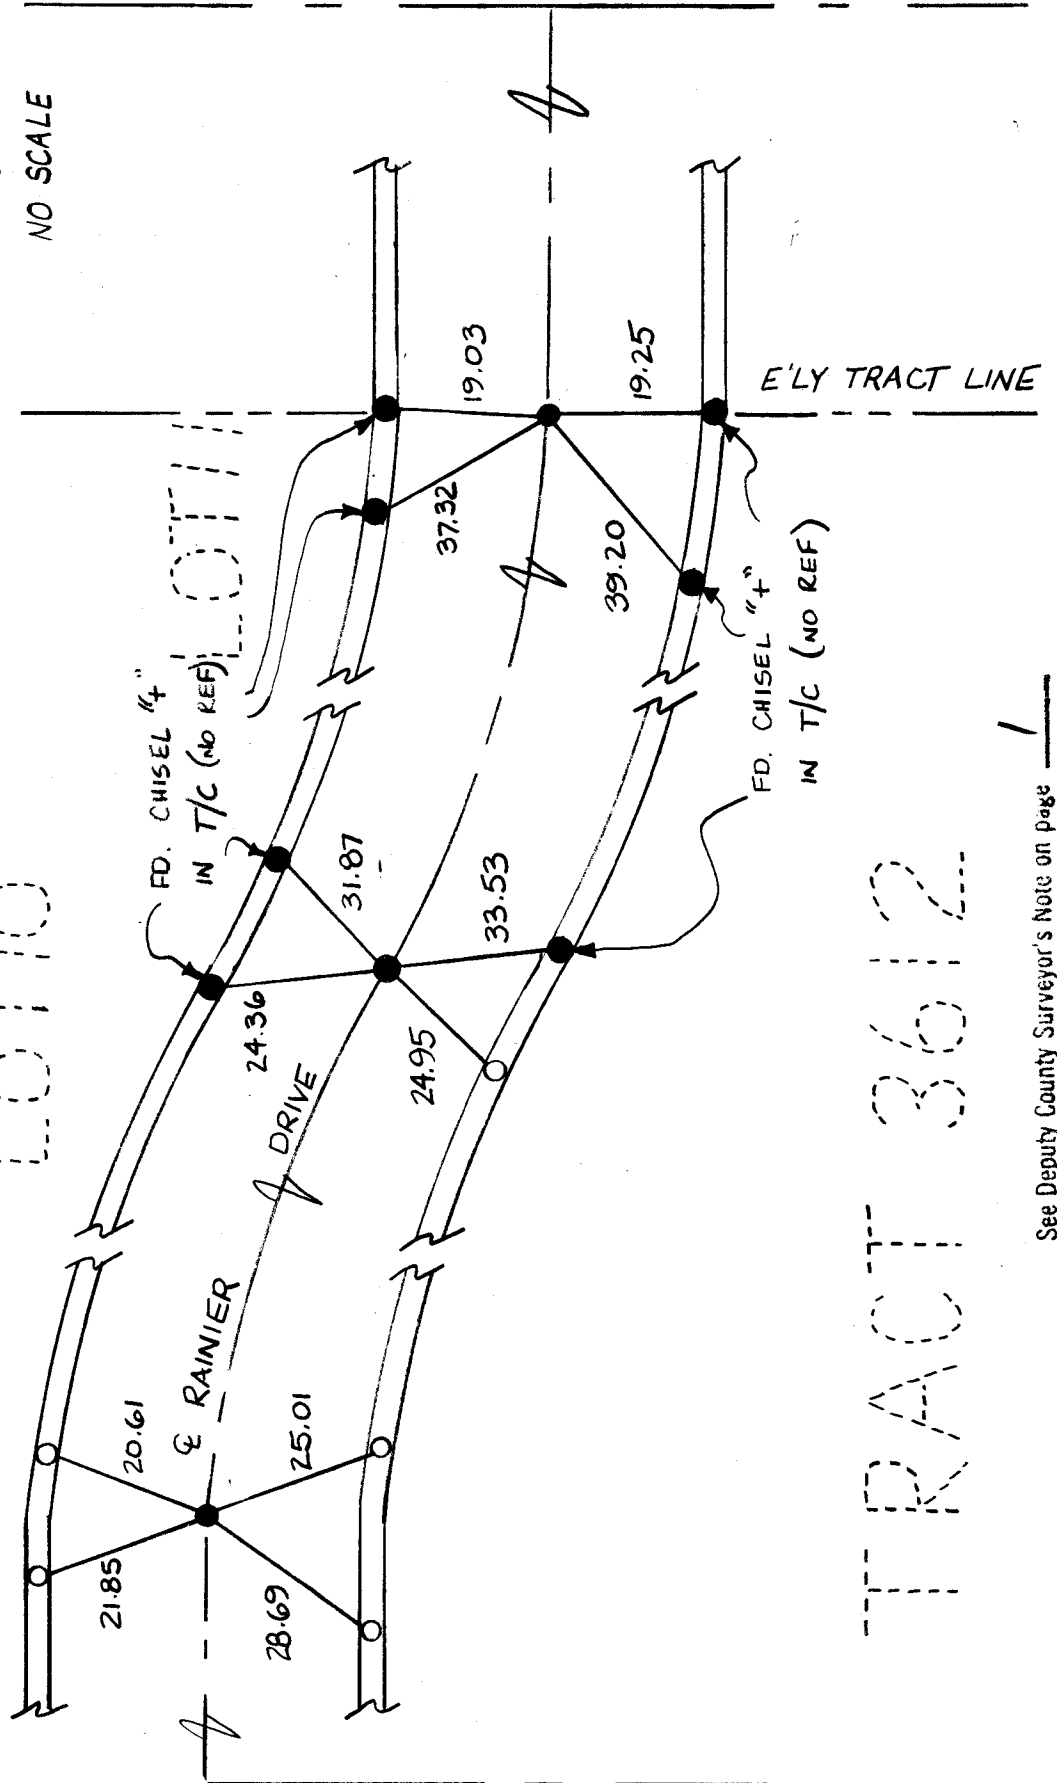


Q TIES VARIOUS STREETS
FLYNN

12/12/85

A/5-9 976

9 of 21

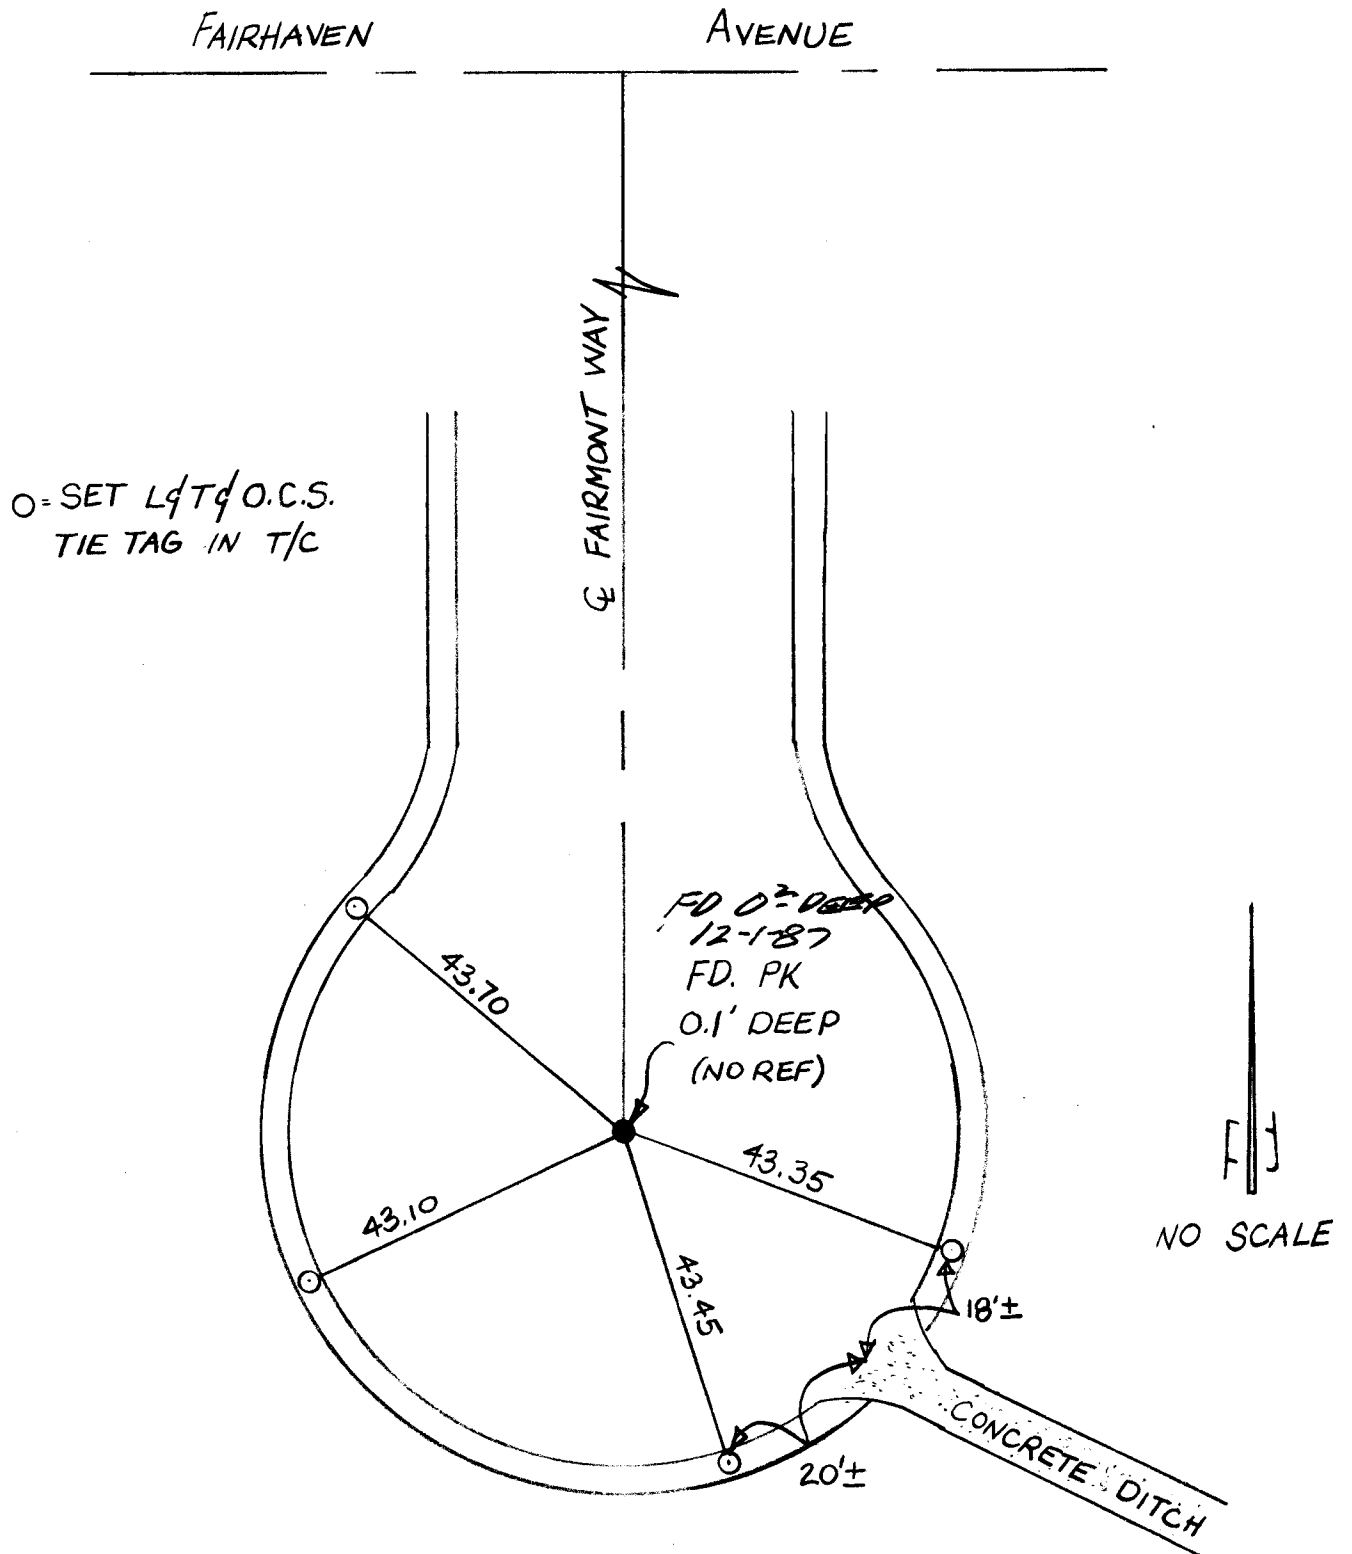

Q TIES VARIOUS STREETS

Flynn

12-18-85

LOT 17

Set L&T & O.C.S.
Tie tag

FD. SPIKE (NO REF) AT
INT. OF TIES PER A/5-9-683
0'5" DEEP 7-8-86

LOT 20

● = Fd. Hilti nail in
Top of curb per
A/59-683

() = RECORD DISTANCE
PER. A/ 5-9-683

ROSALIND DRIVE

FAIRHAVEN

AVE





No Scale

TRACT 2007

TIES VARIOUS STREETS
FLYNN


12-12-85

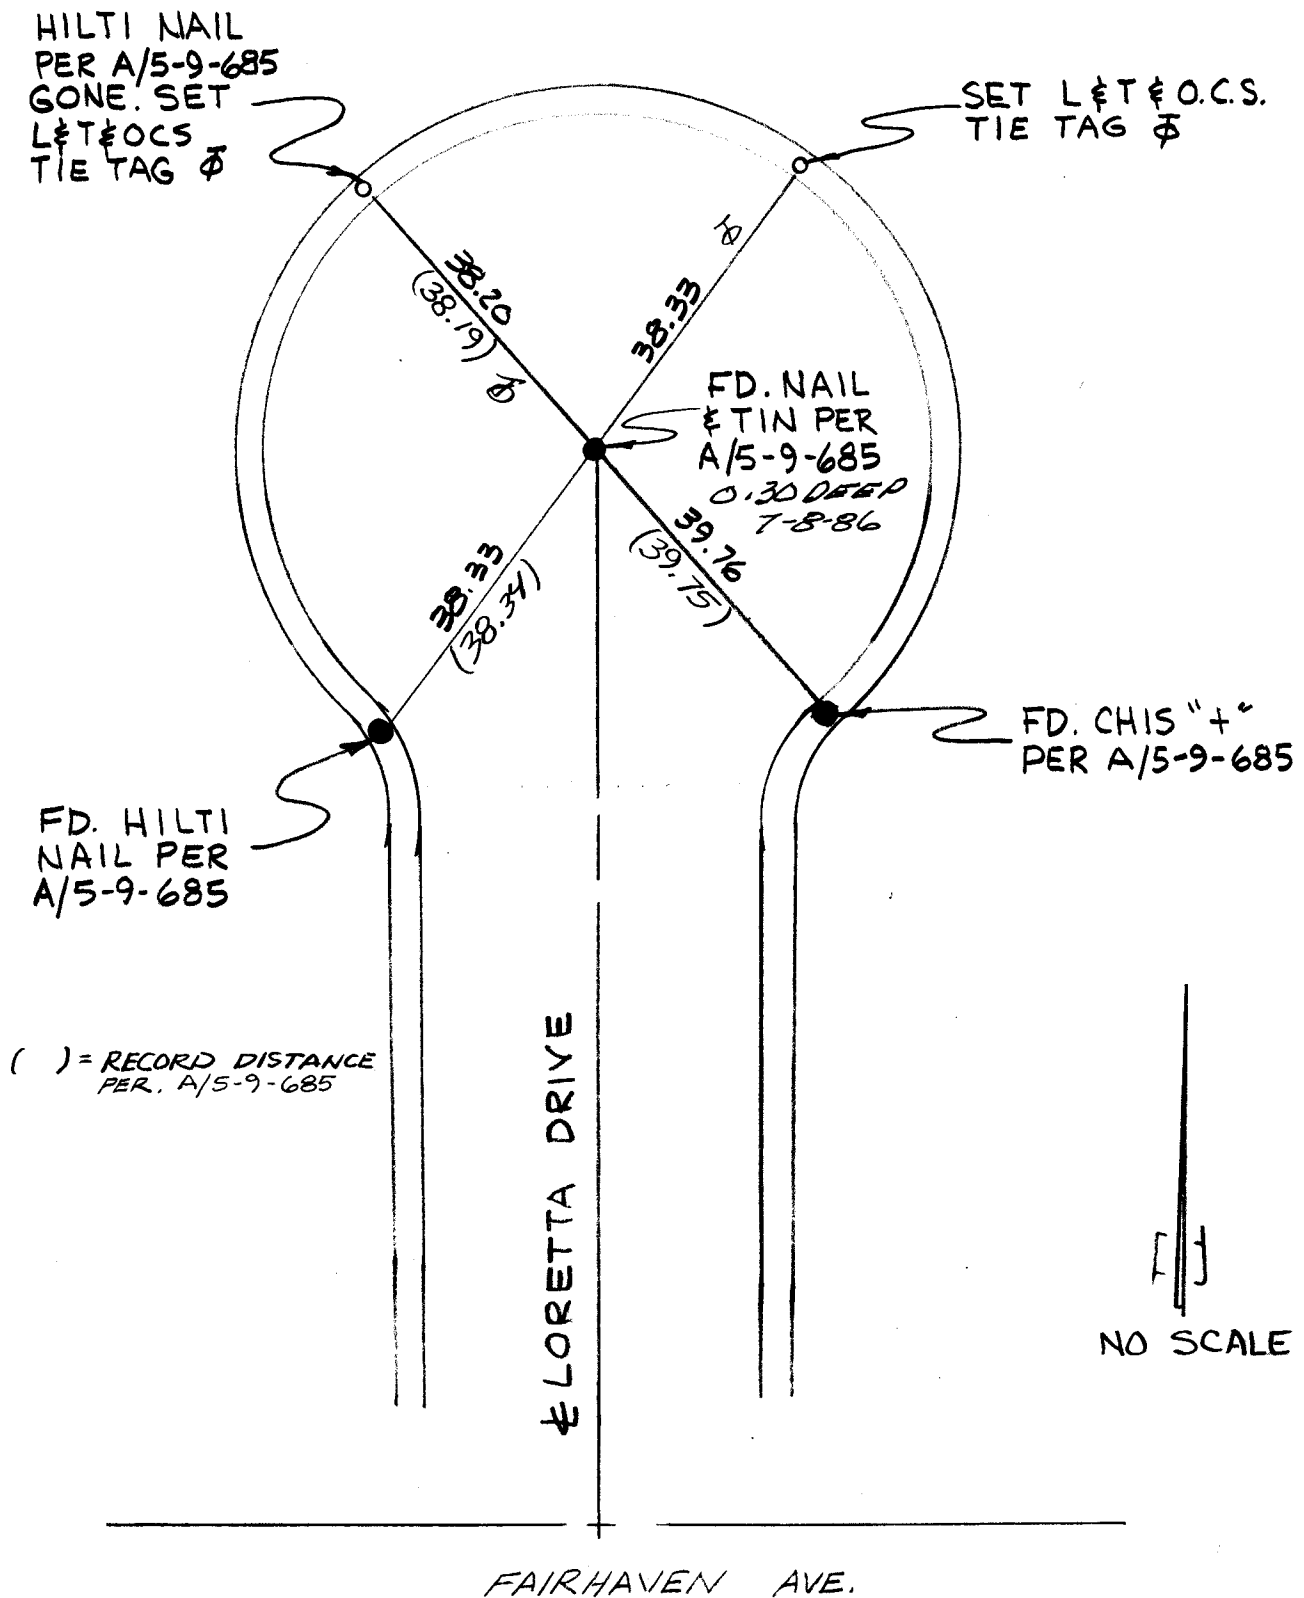

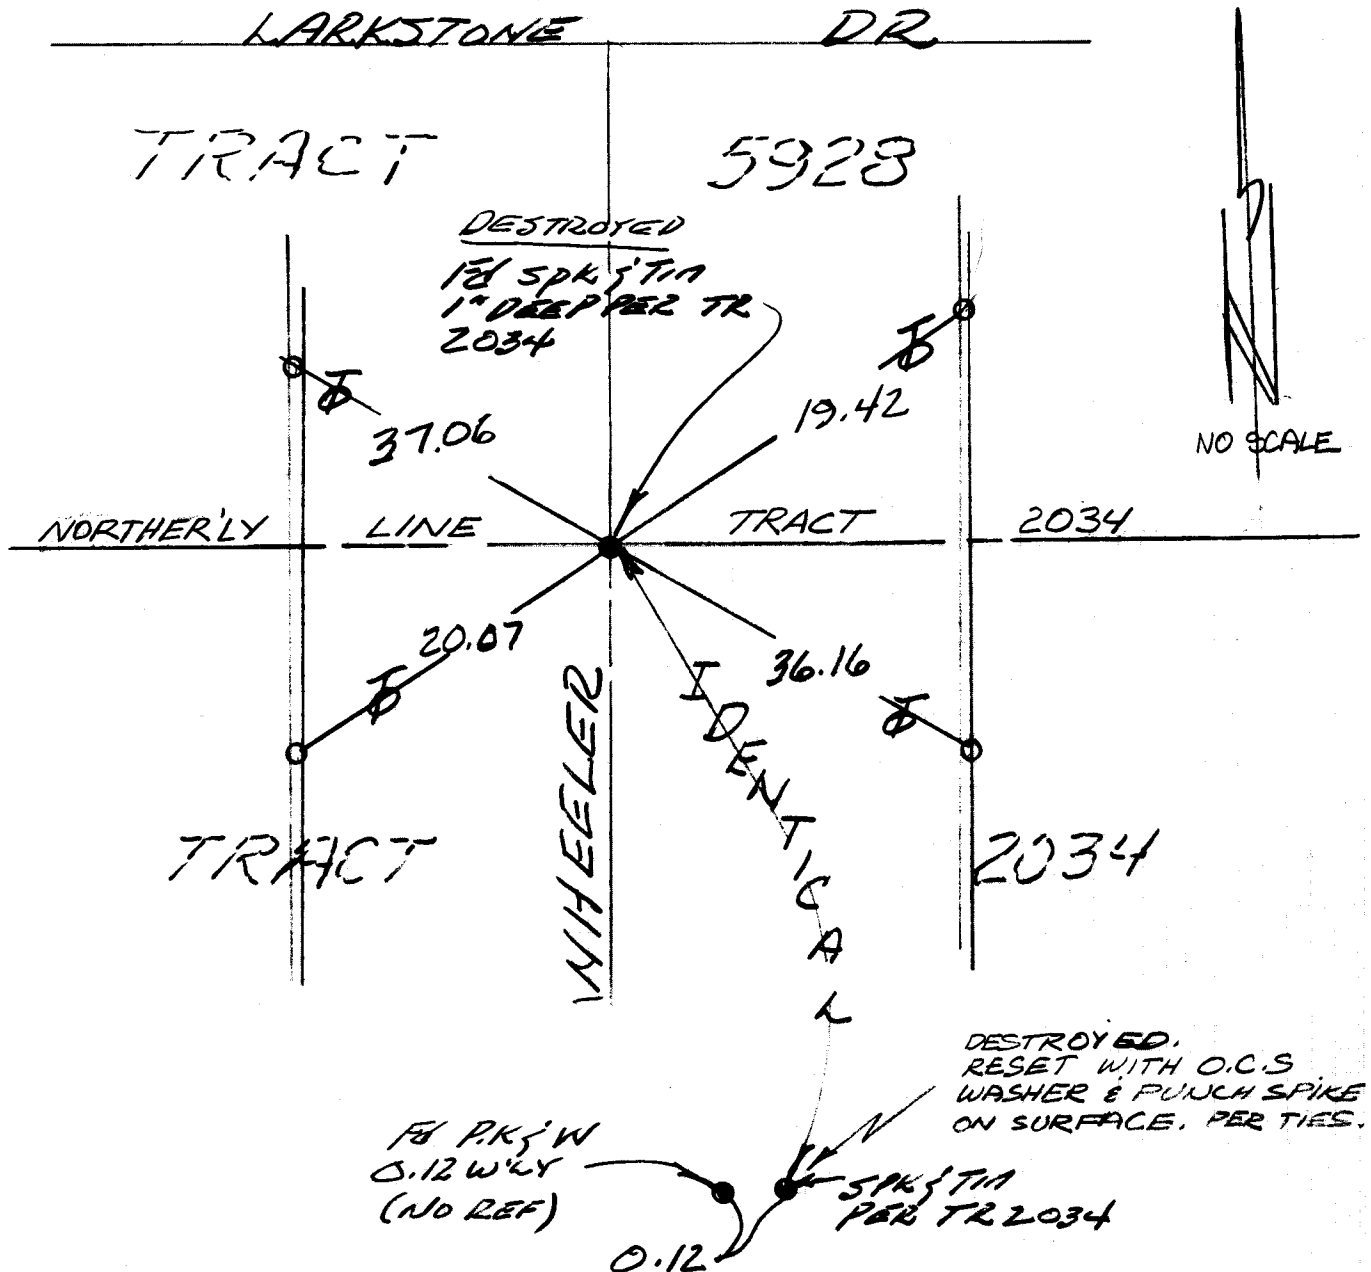

○ = SET L & T O.C.S
 TIE TAG IN T/L

LARKSTONE DR

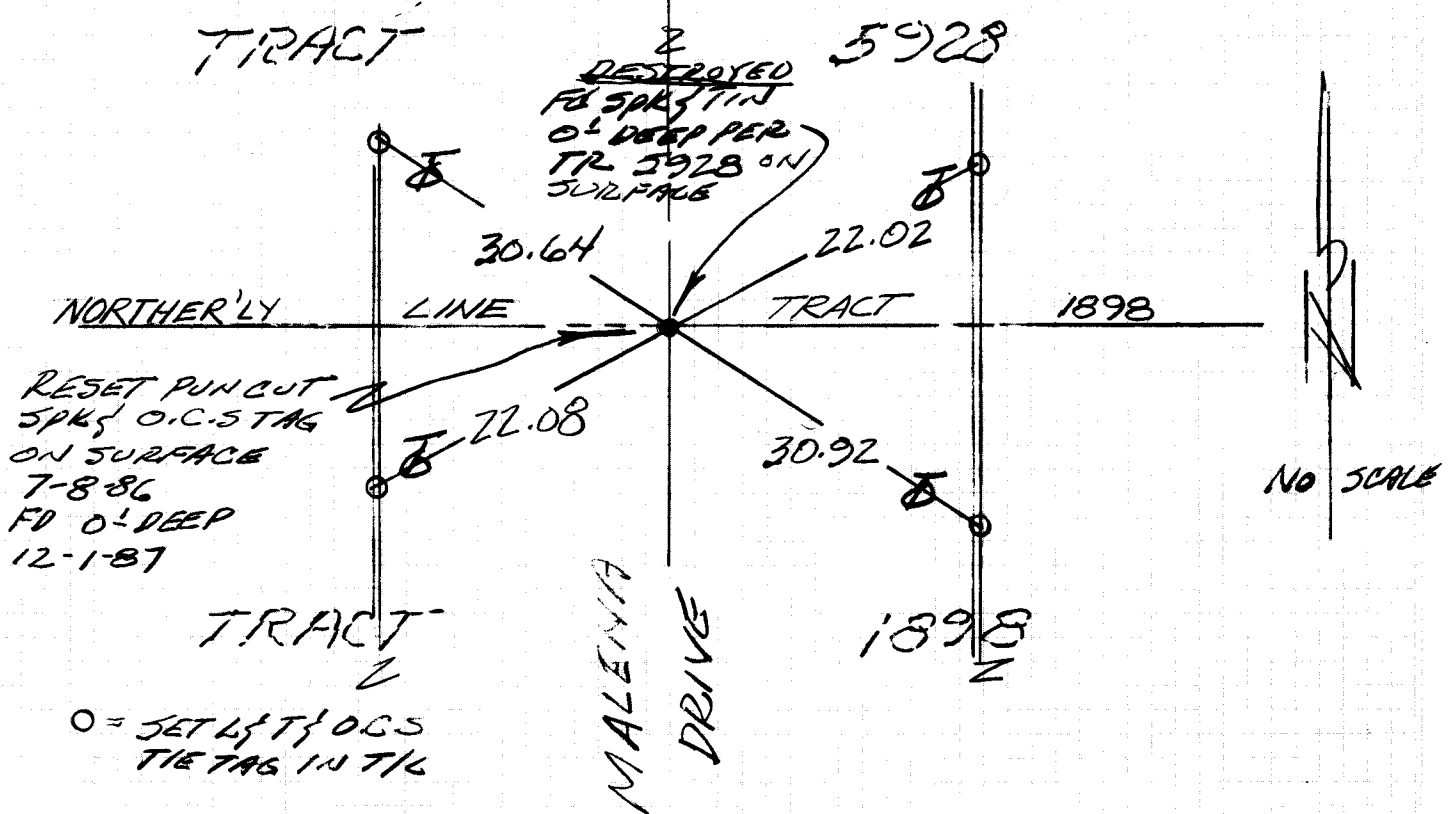


Q TIES VARIOUS STREETS

FLYNN

1-7-86


FAIRHAVEN AVENUE

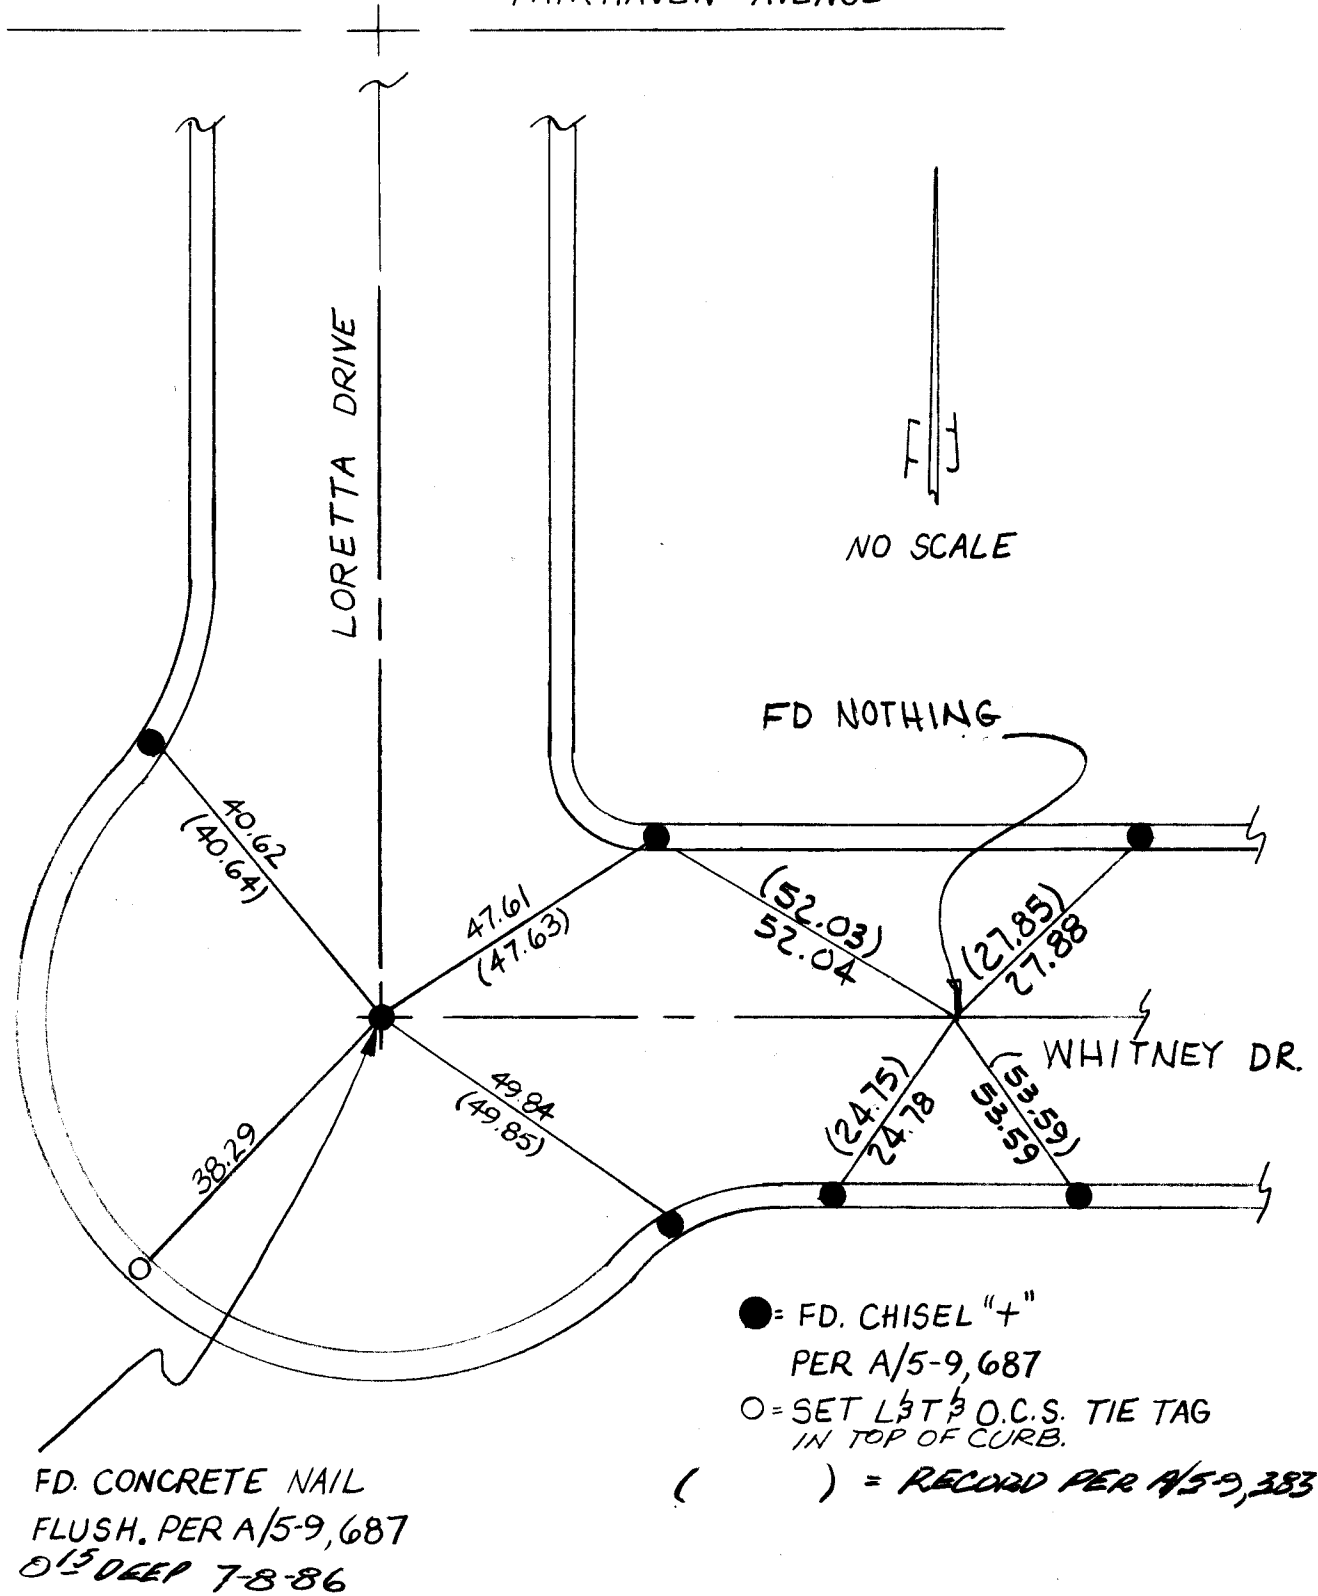

Q TIES VARIOUS STREETS

FLYNN

● = AD. CHISEL "+" PER A/5-9, 383 IN T.C.
 () = DISTANCE PER A/5-9, 383

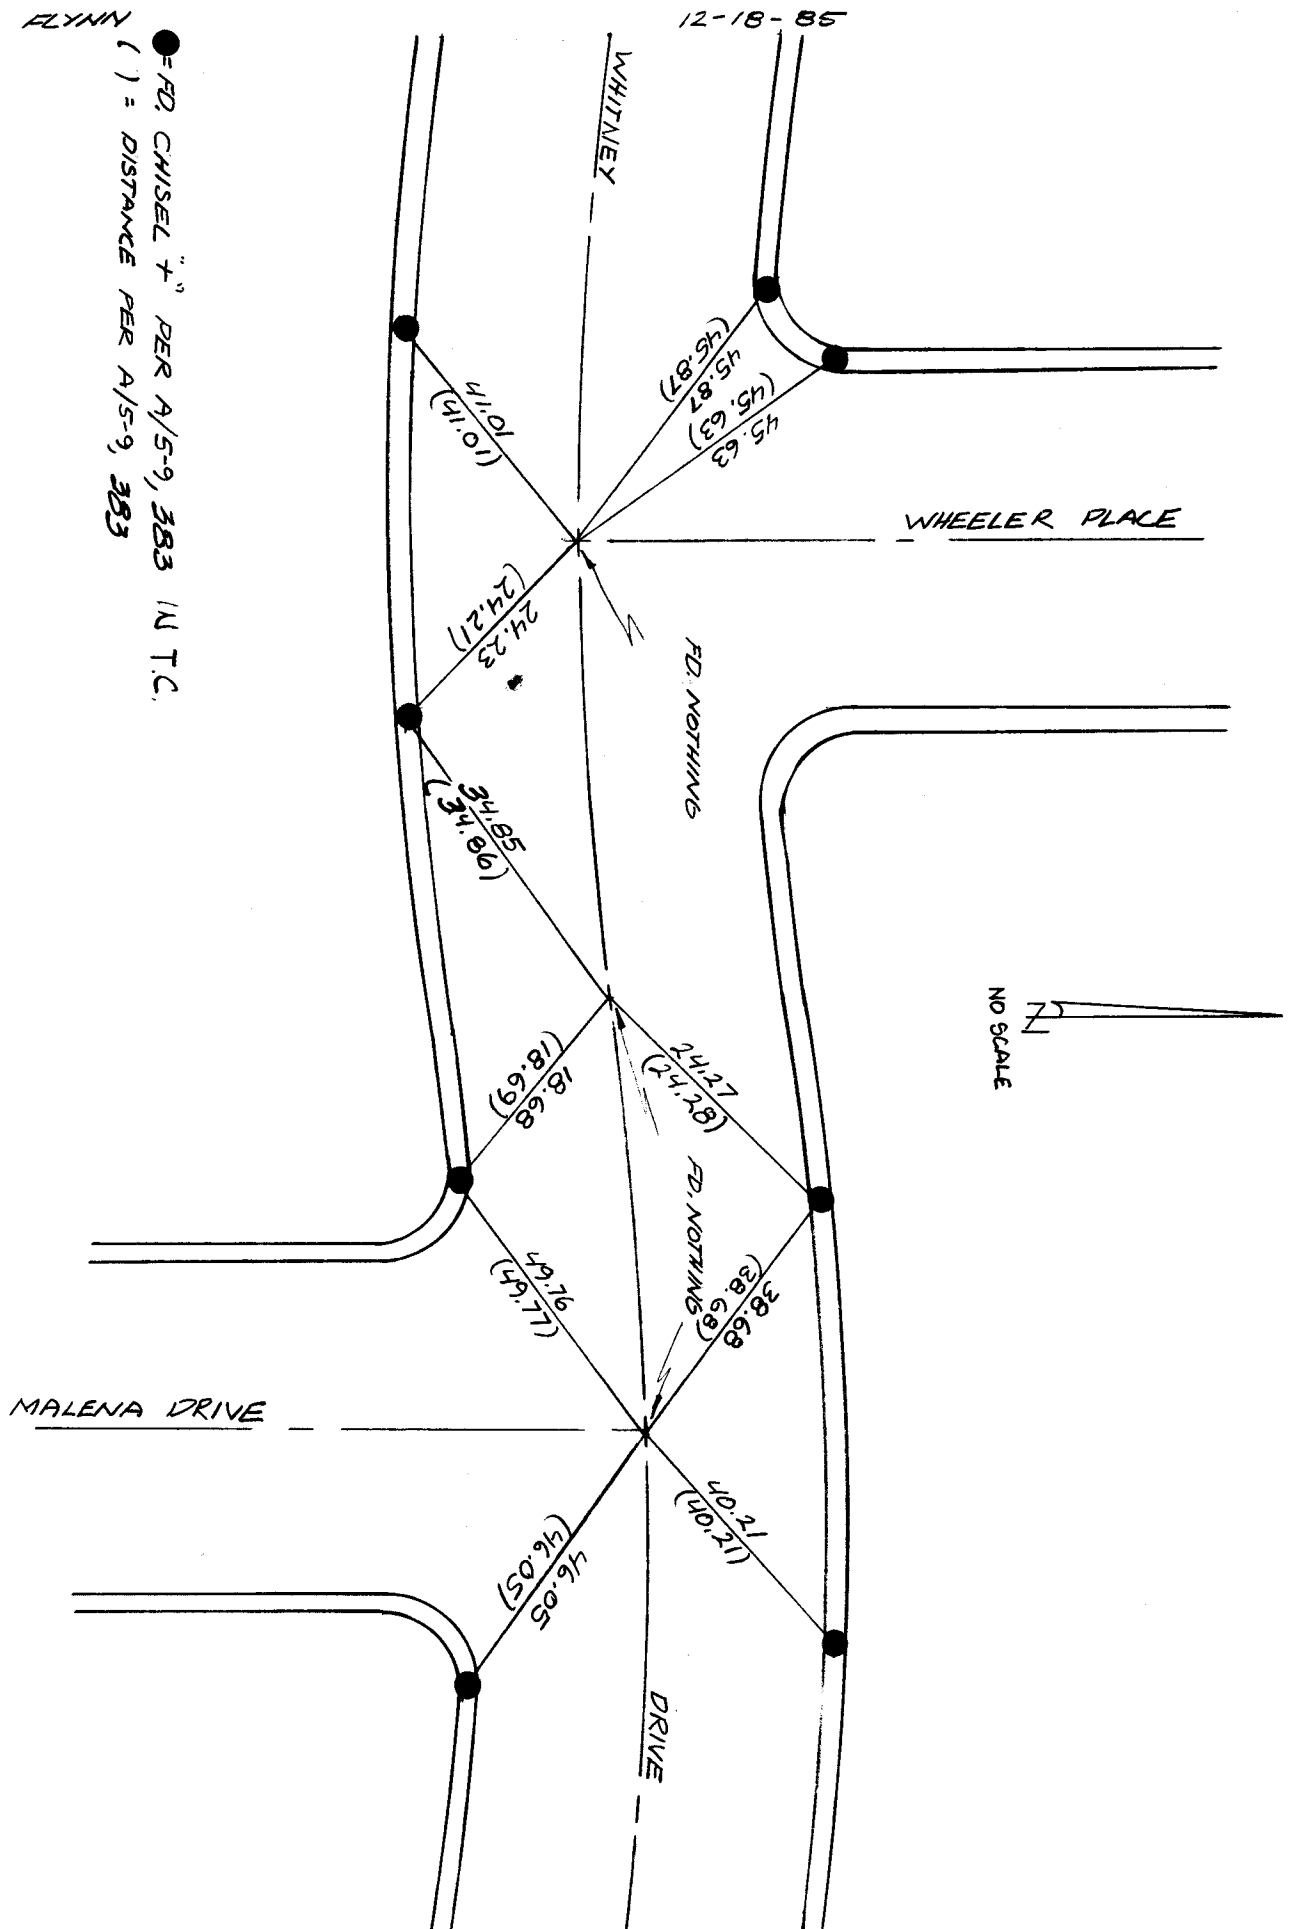


See Deputy County Surveyor's Note on page 1

TIES VARIOUS STREETS

FLYNN & PARTY

12-18-85

● = F.D. CHISEL + PER. A/5-9, 383, 385 IN T.C.
 () = DISTANCE PER. A/5-9, 383, 385

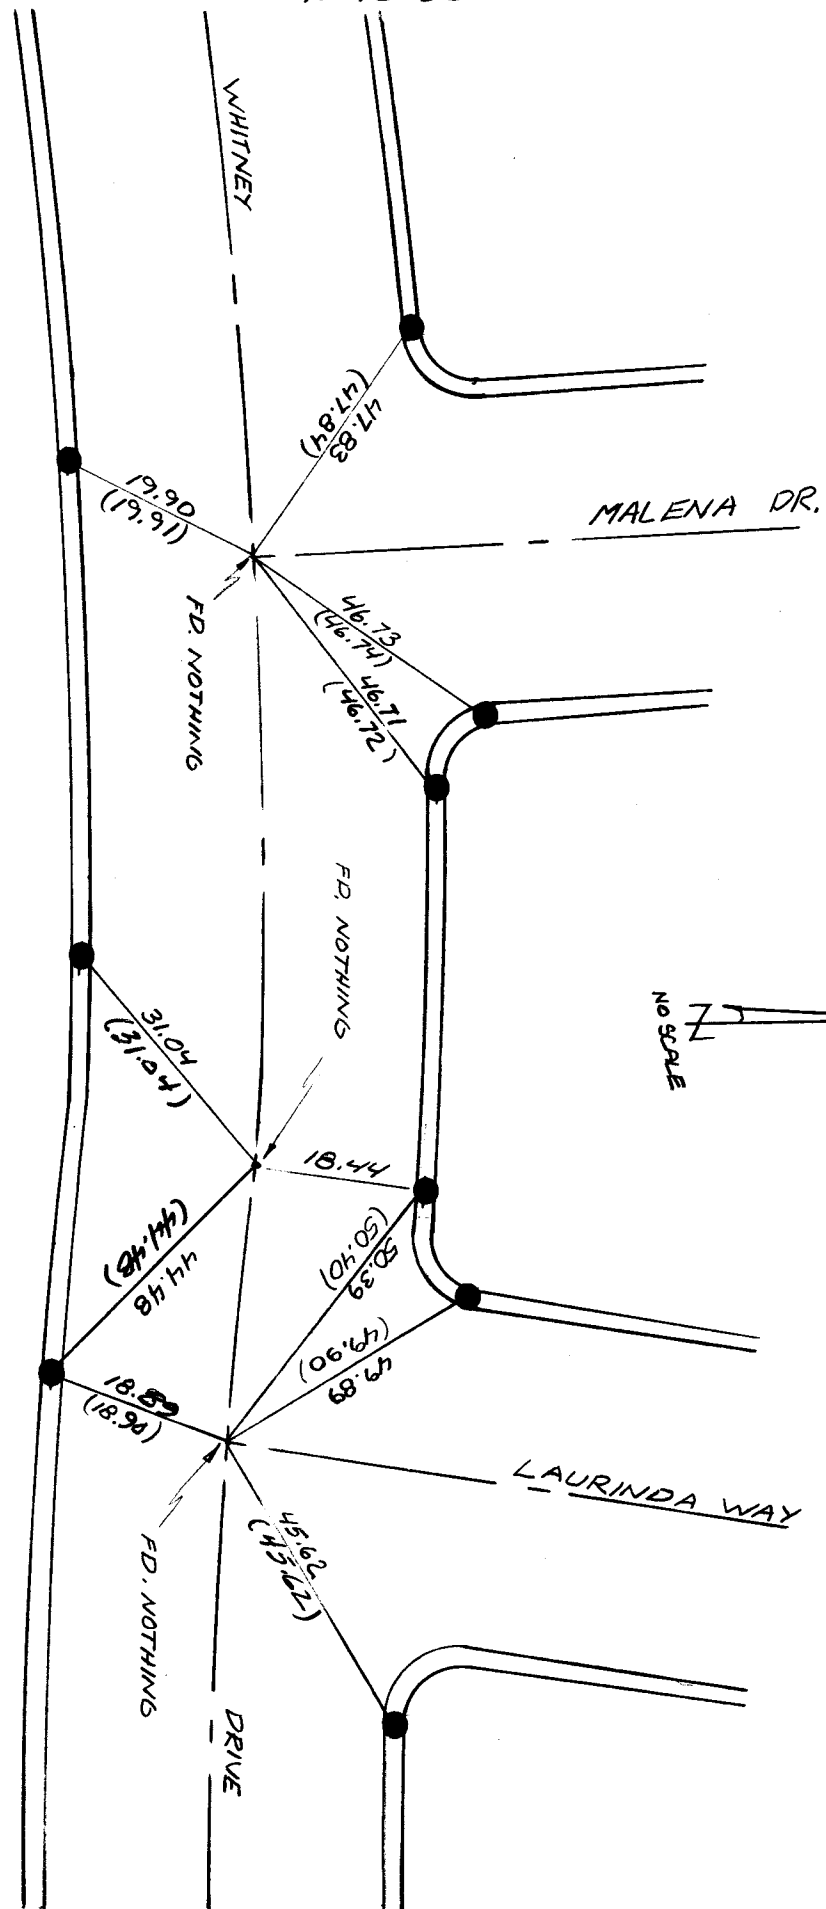


NO SCALE

Q TIES VARIOUS STREETS
FLYNN & PARTY

A/5-9 984

17 OF 21

12-18-85

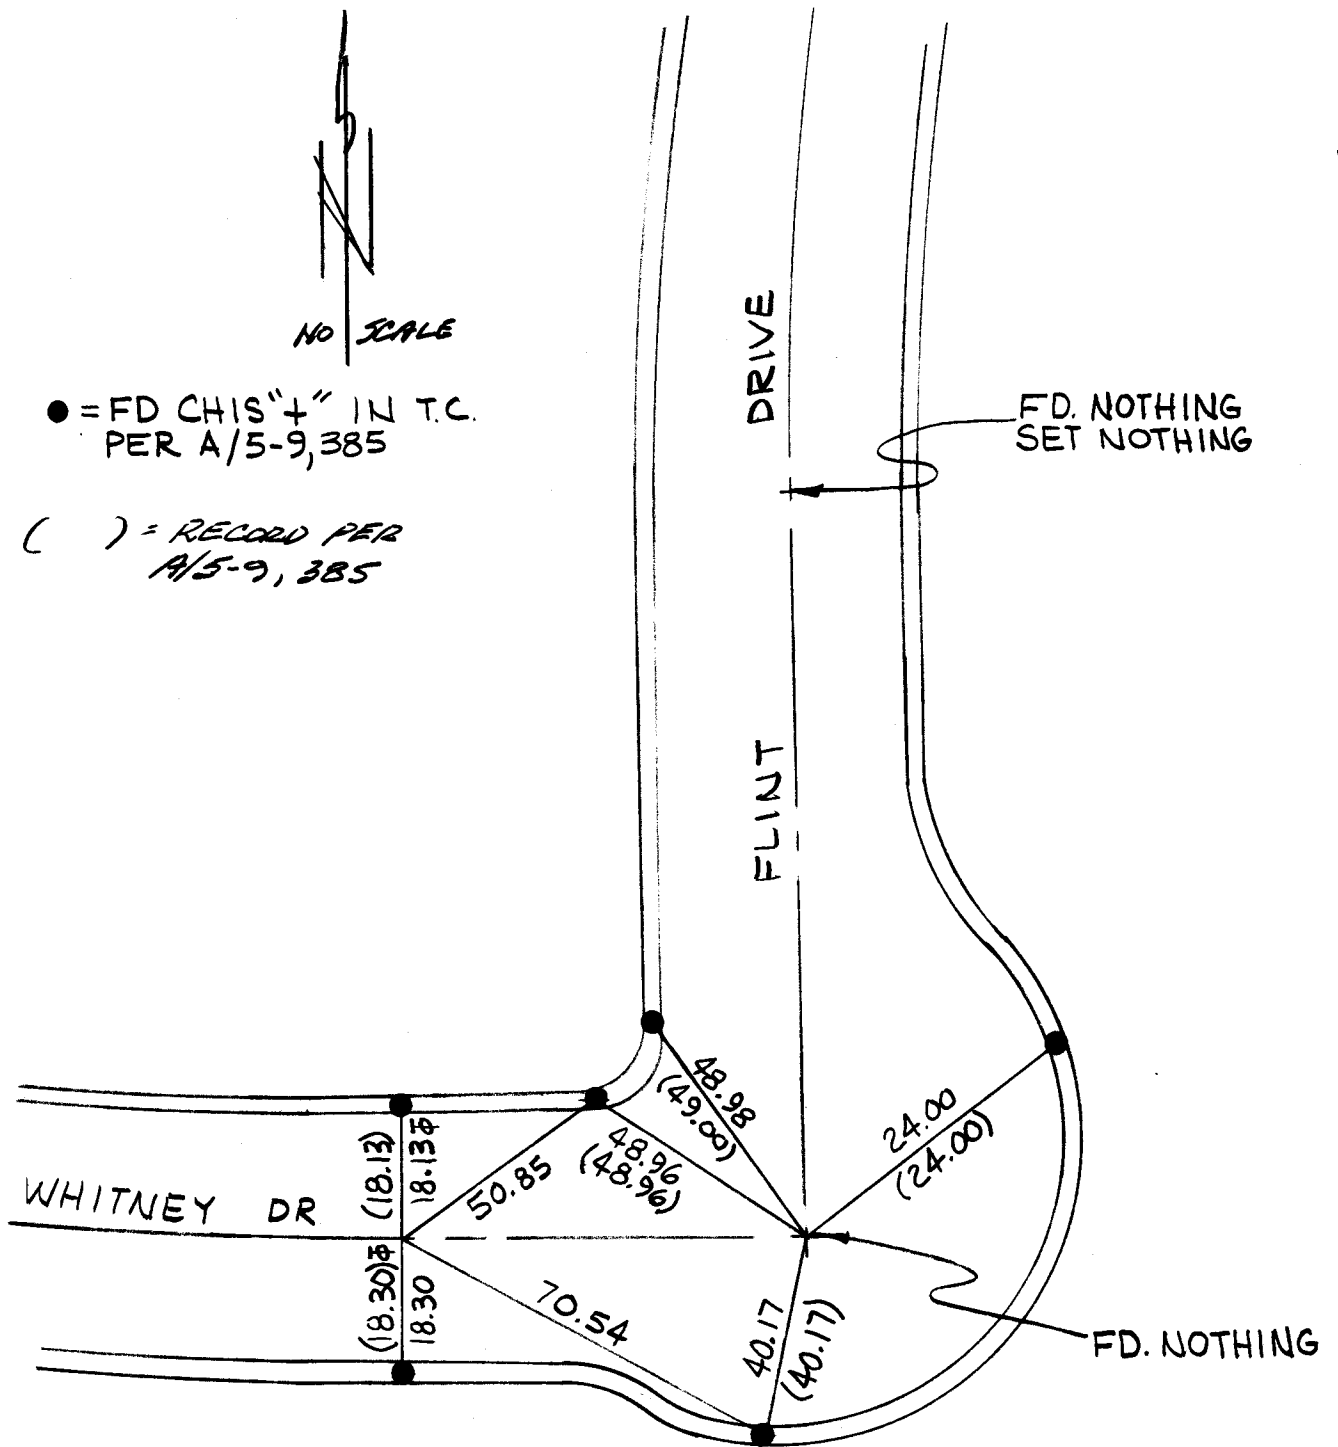


TIES VARIOUS STREETS

18 OF 21

FLYNN

12-18-85

FAIRHAVEN AVENUE

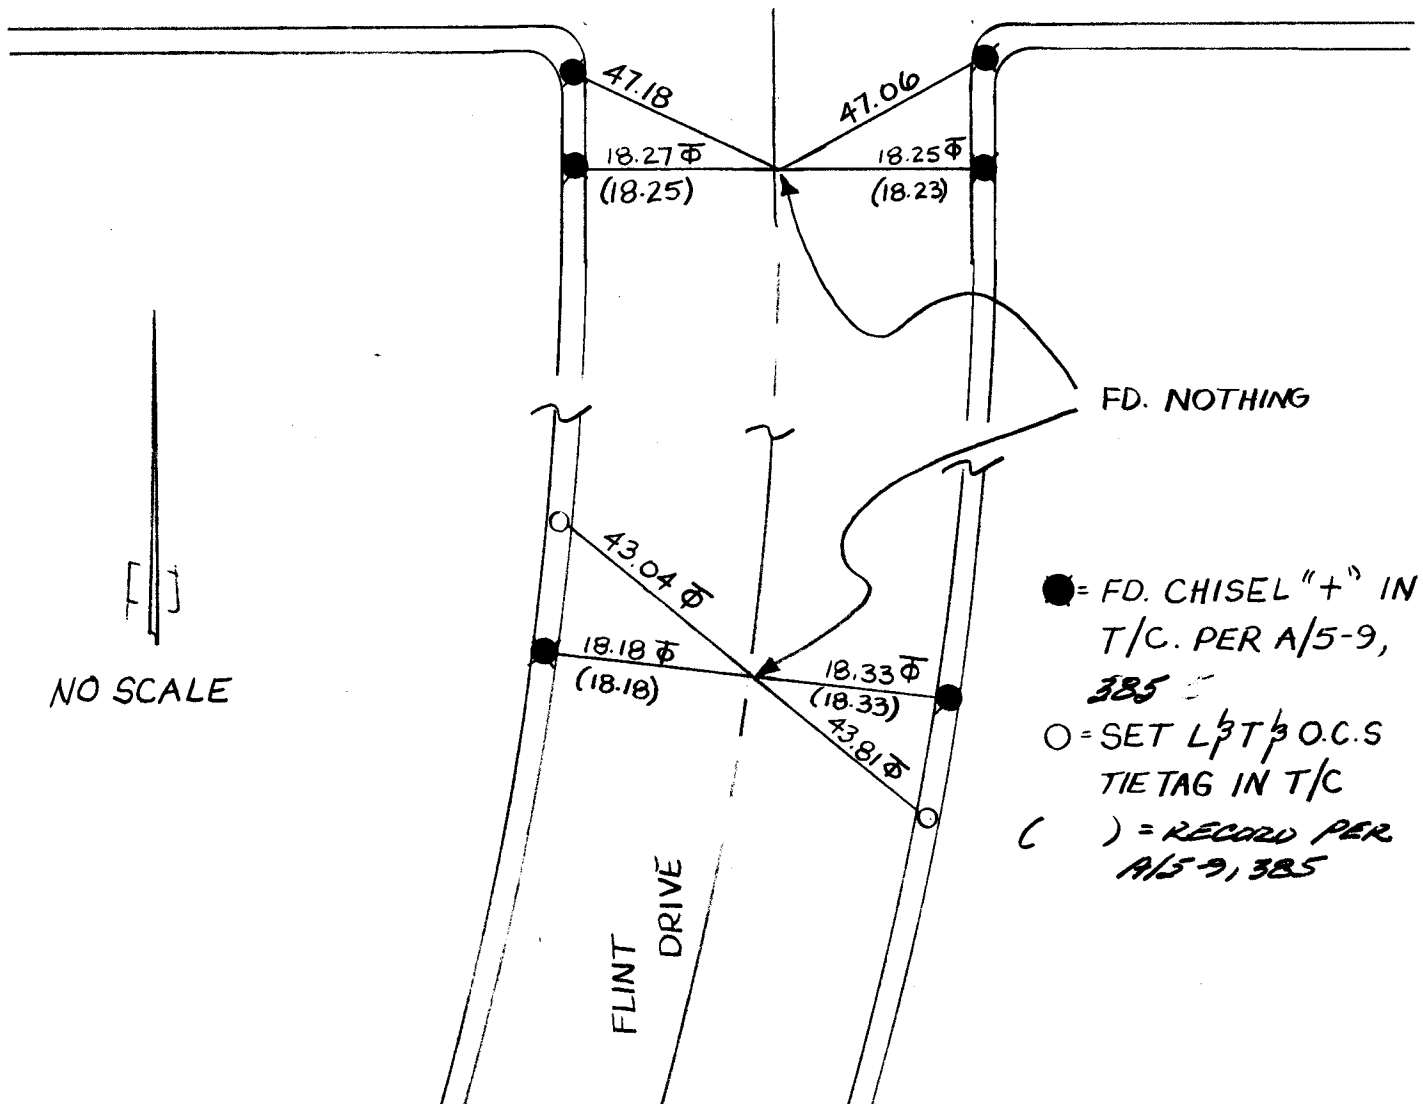


ETIES VARIOUS STREETS
FLYNN & PARTY

A/5-9 986

19 OF 21

12-19-85

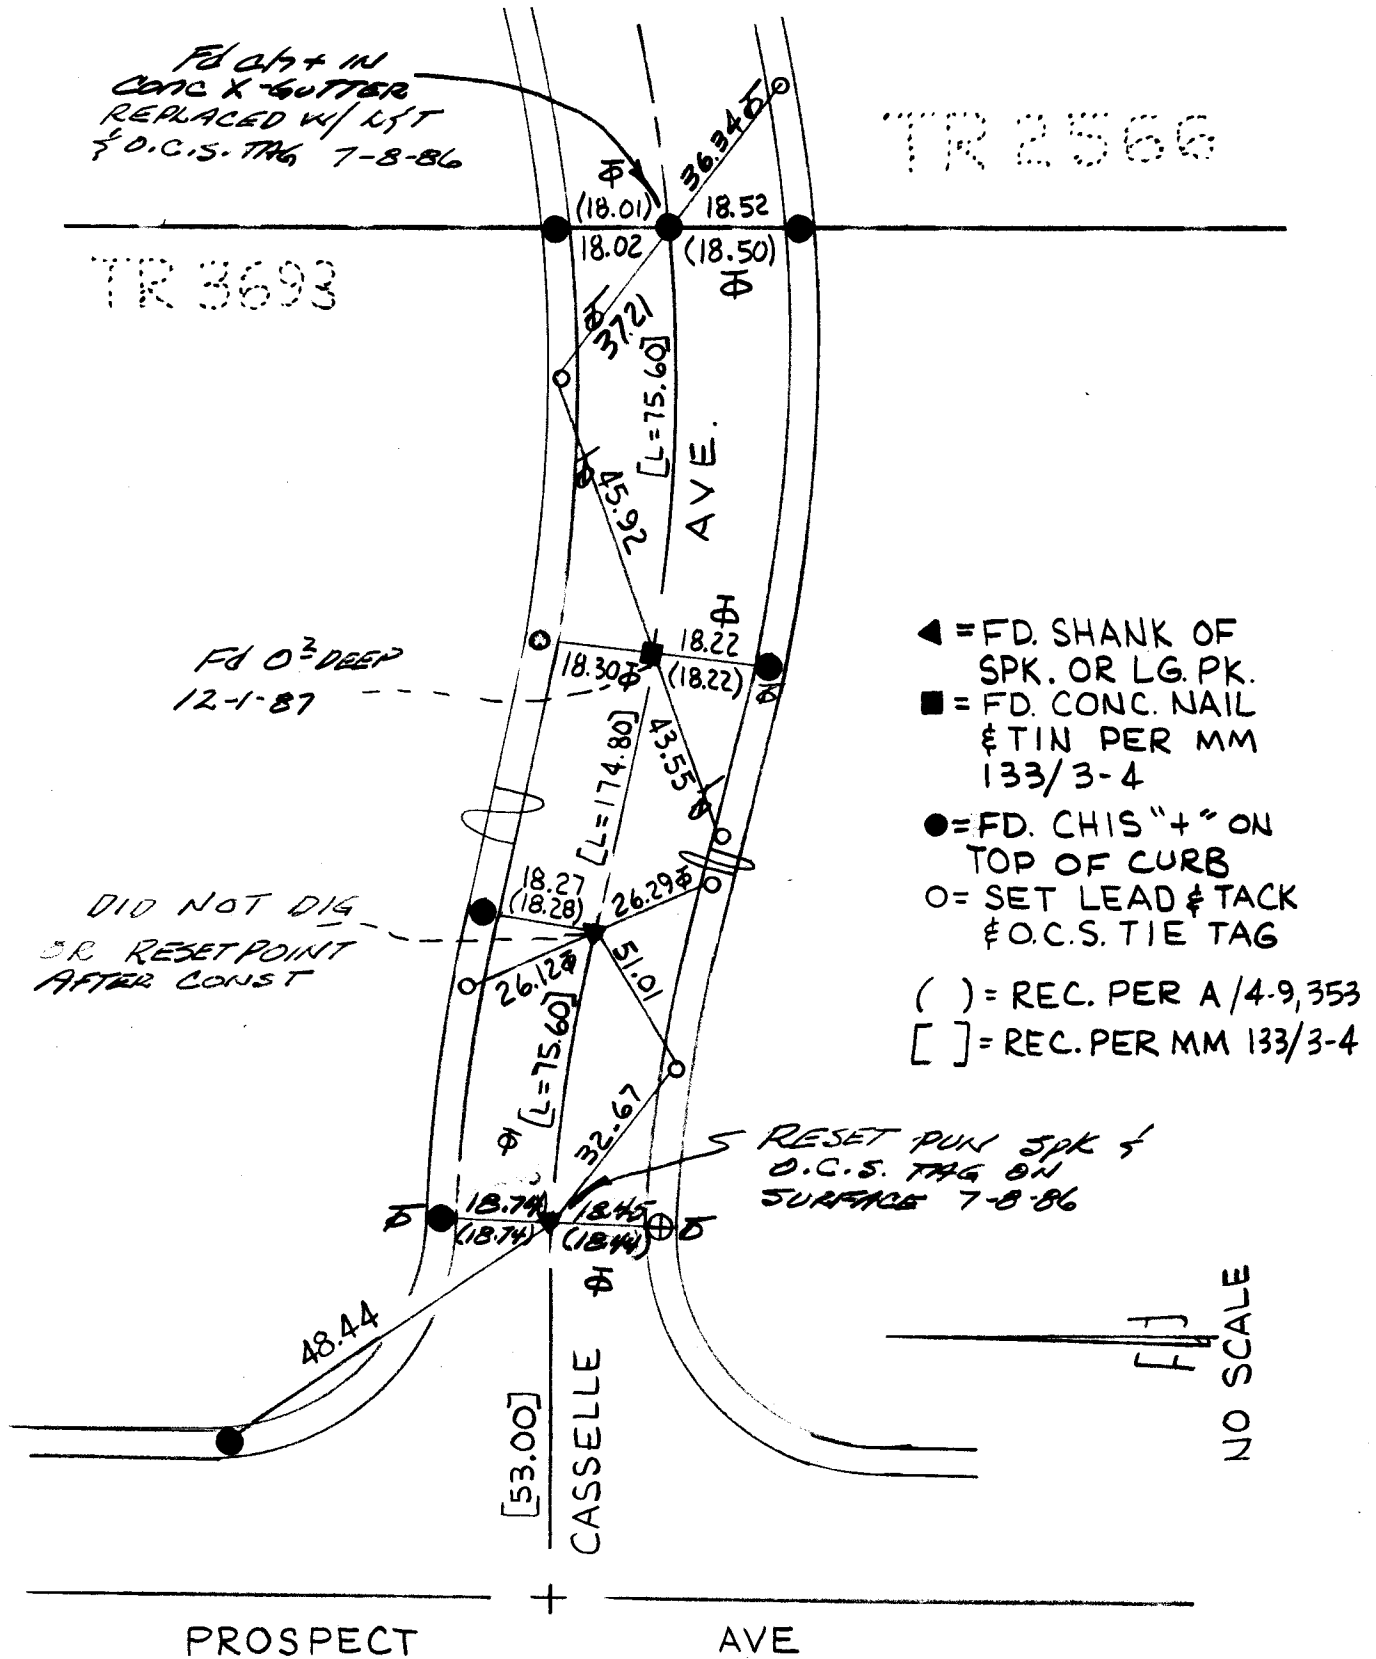

12-30-85

SWIDLER PL.

ROMELLE AVE.

DUNAS RD.

CASSELLE AVE.

● = FD, CHIS + TOP OF CURB
(NO REF)
○ = SET L&T & O.C.S. THE TAG. IN
TOP OF CURB.

FD. NOTHING
SET, NOTHING

FD. NOTHING
SET. NOTHING

6-1-61 03-0
FD. SPK.
NO REF.

FD. WAFFLE HEAD
SPIKE. NO. REF.

FD 02 DEEP
12-1-87

see Deputy County Surveyor's Note on page

Flynn

12-30-85

NO SCALE

