

ORANGE COUNTY SURVEYOR
CENTERLINE SURVEY

A/5-9 1074

PAGE 1 OF 7

PROJECT

PROSPECT

AVE.

LIMITS OR LOCATION

17TH ST. TO FAIRHAVEN

SURVEY NUMBER

DATE FILED

DATE COMPLETED

9-8-80

REMARKS

SOME OF THE INTERSECTIONS ALONG PROSPECT WERE DESTROYED DURING PRIOR CONSTRUCTION PROJECTS. THIS SURVEY WAS FOR THE RESETTling OF THESE POINTS.

DEPUTY COUNTY SURVEYOR'S NOTE:

The purpose of these notes is to show the relationship of the points and/or lines shown hereon to either lines of record, control lines, or to each other. The Deputy County Surveyor does not claim at this time, that the points or lines shown hereon are true centerline, boundary, deed, or control points or lines. Without further analysis, the interpretation of these notes is left to the discretion of the user.

John Canas
Deputy County Surveyor

By:

Loren Toomey
Supervising Land Surveyor

EQUIPMENT

T2 (WILD)

68712

E.D.M. 3800A (H.P.)

3337

PERSONNEL


SEHER

LEAT

OBESTER

WITHERSPOON

SEPT. 1980

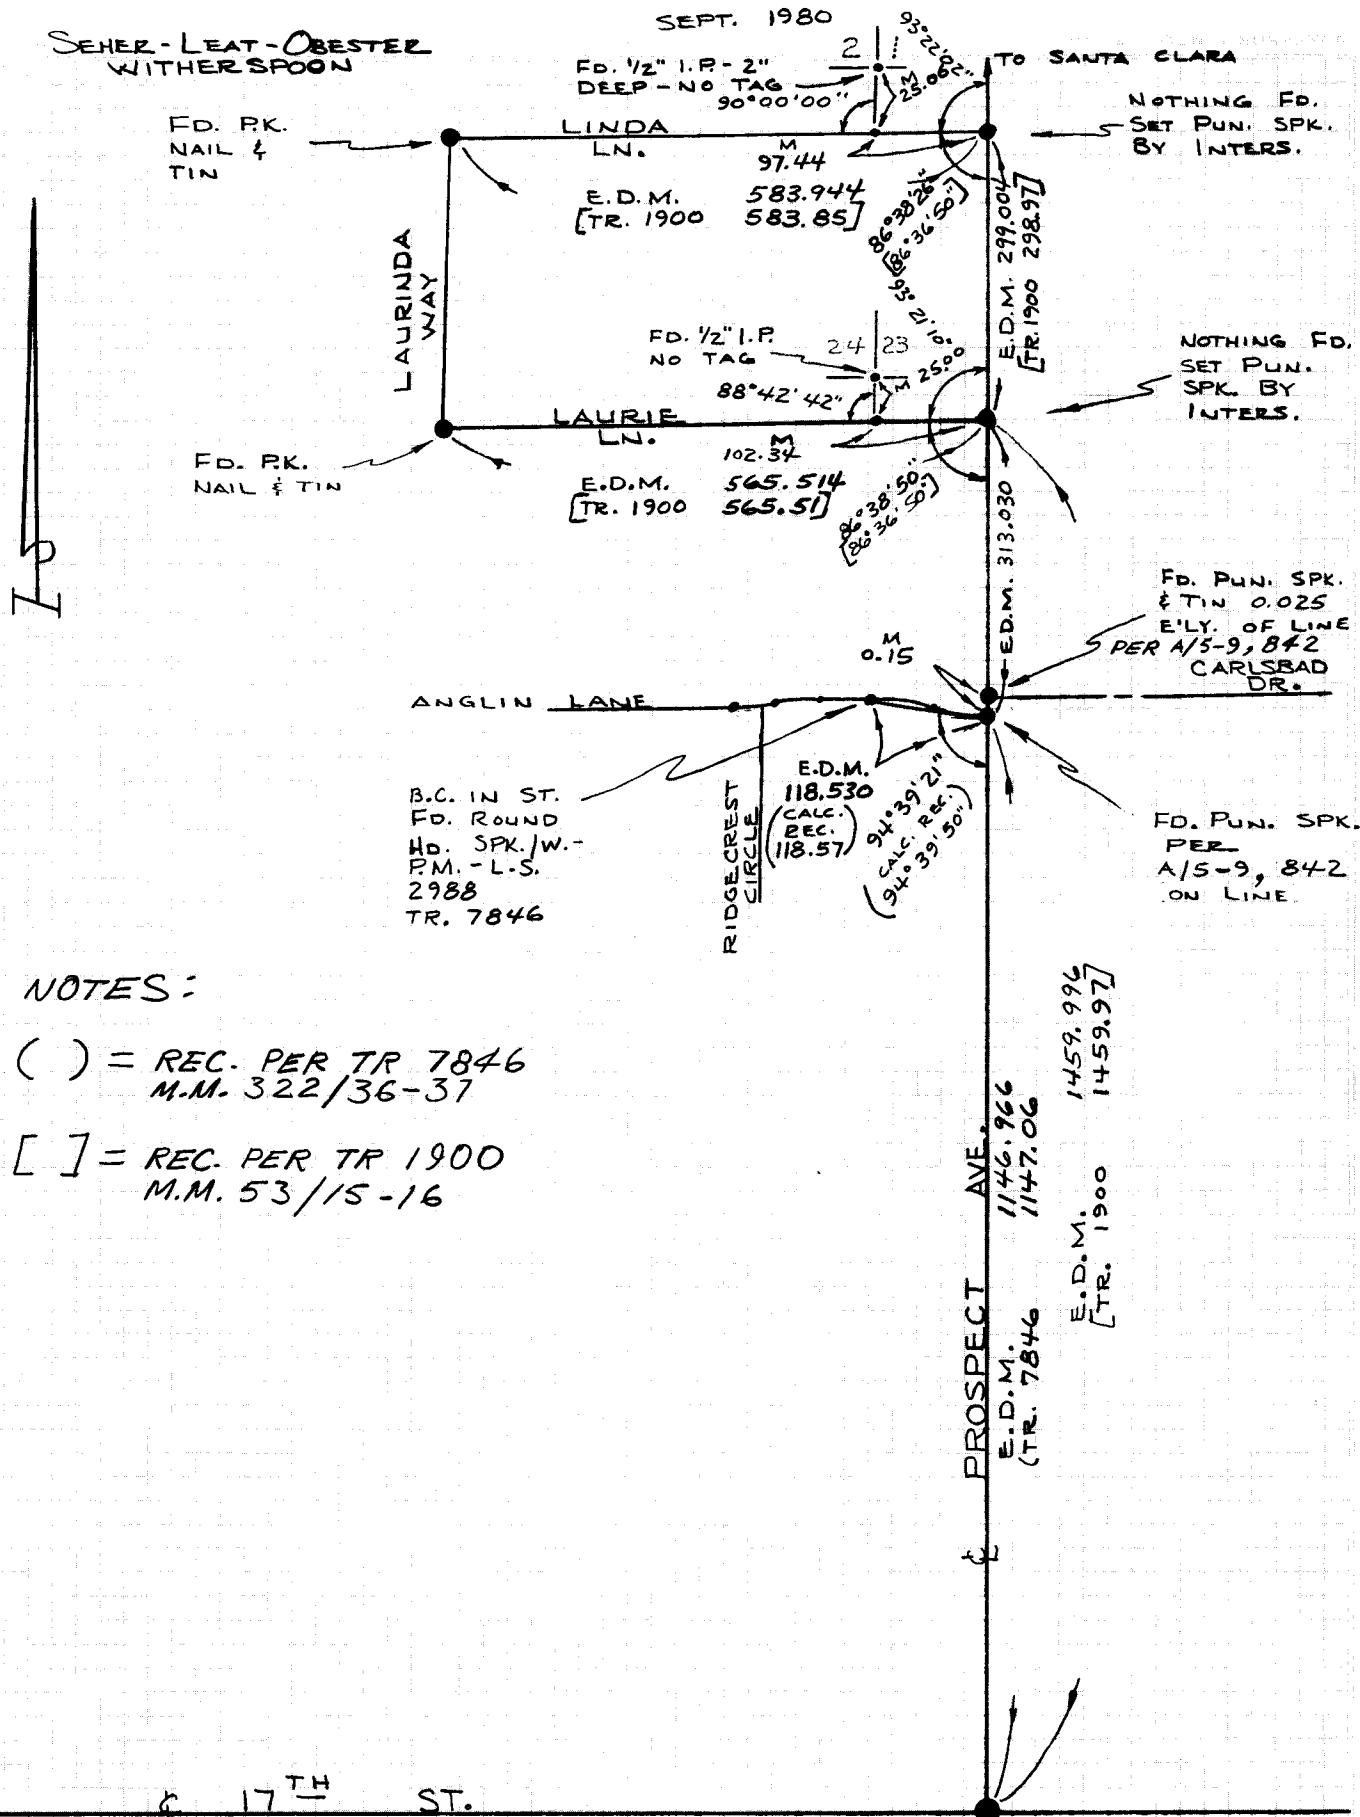

NOTES:-


() = REC. PER TR 7846
M.M. 322/36-37

[] = REC. PER TR 1900
M.M. 53/15-16

See Deputy County Surveyor's Note on page 1

FD. O.C.S. WELL MON.
W/ HEX BAR PER A/4-9, 1023

ORANGE COUNTY SURVEYOR

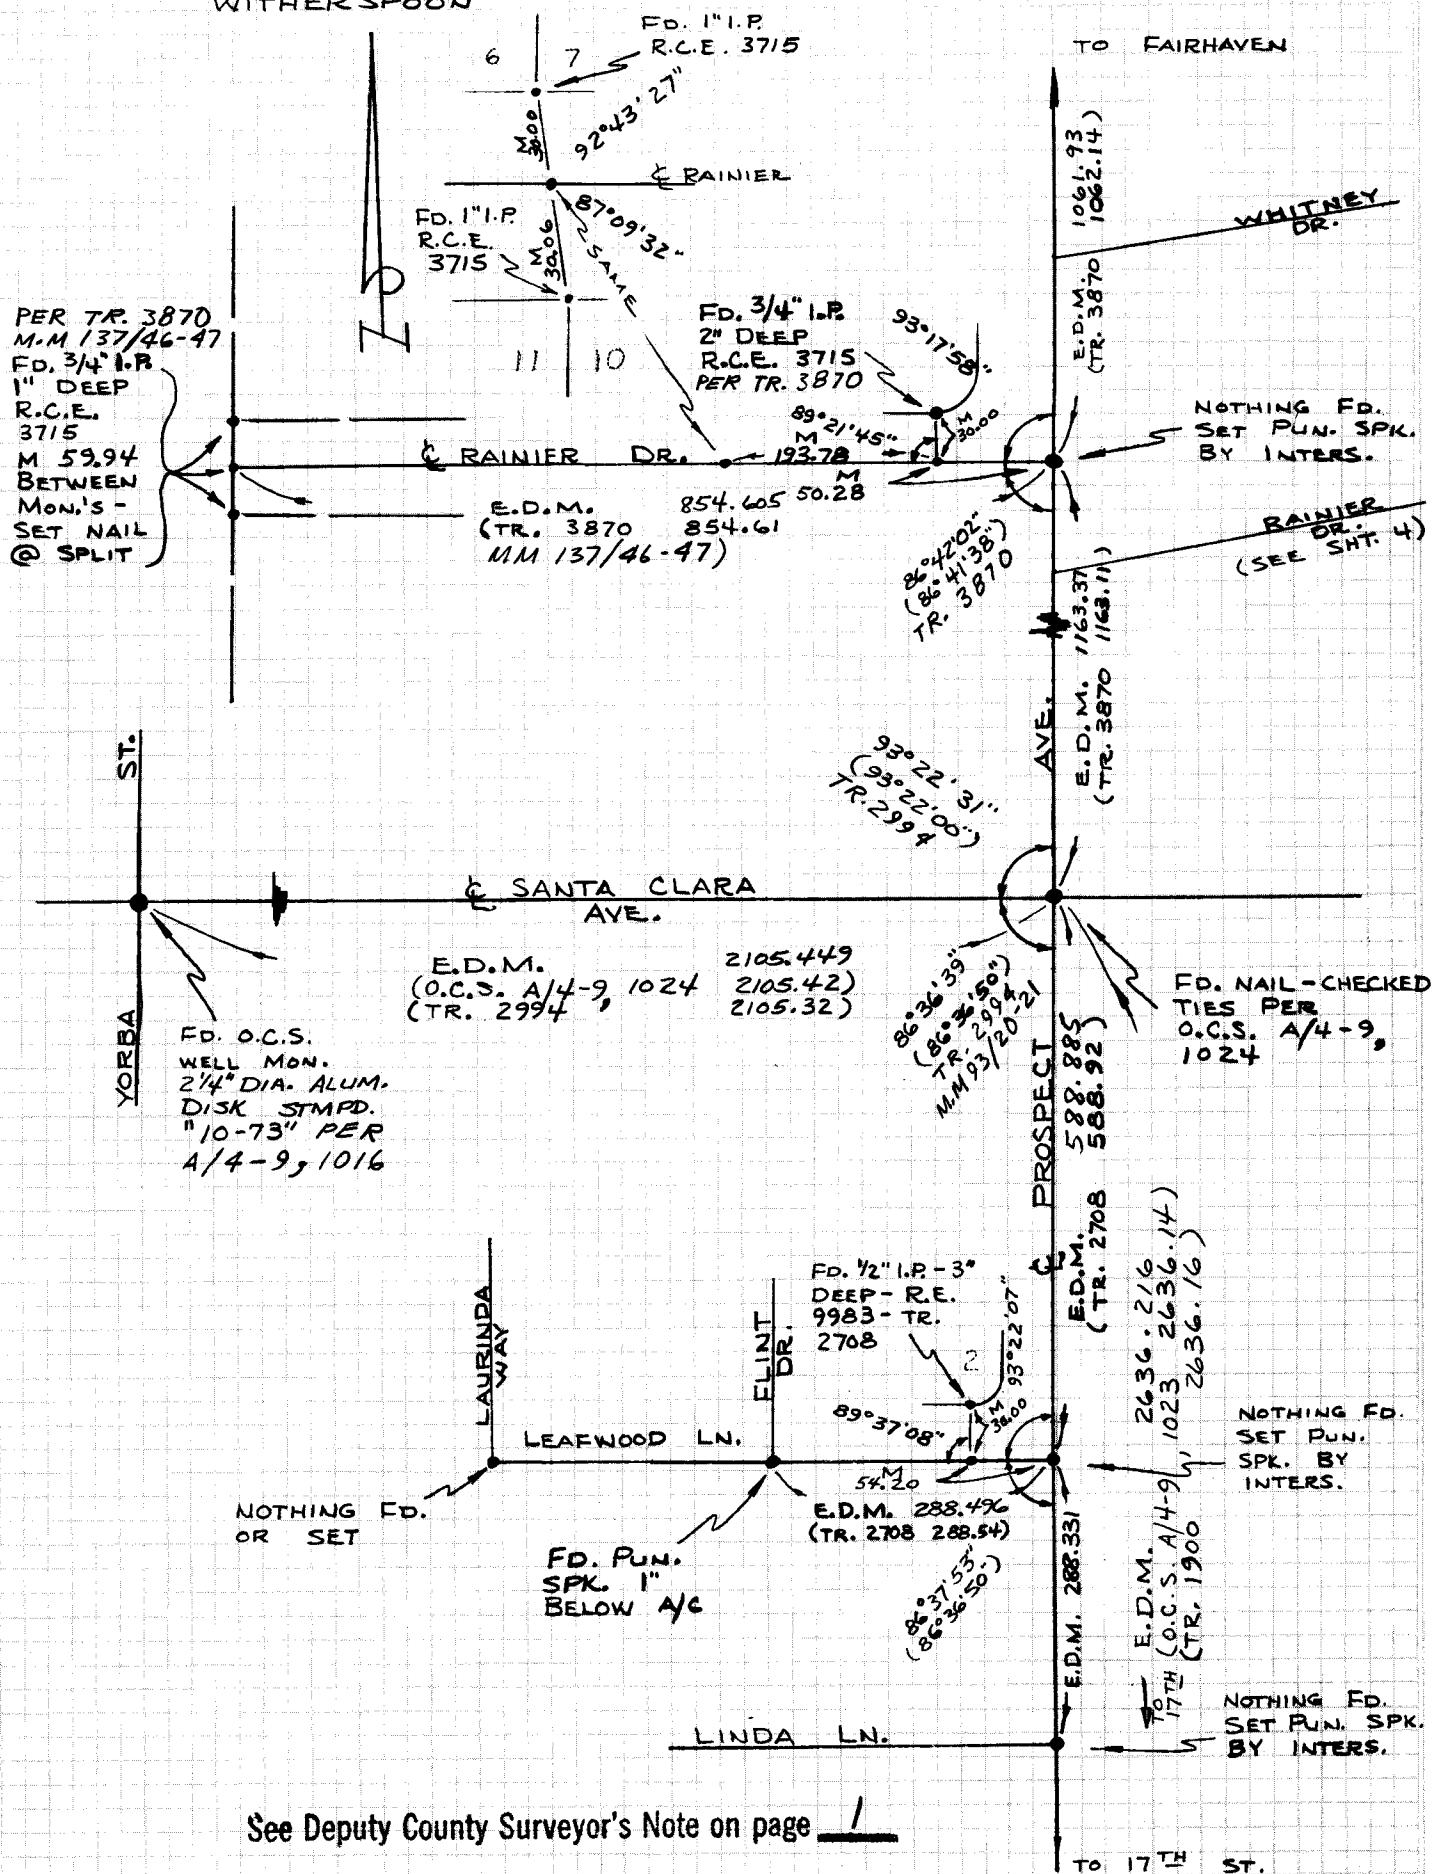


See Deputy County Surveyor's Note on page 1


SURVEYED BY SEHER - LEAT - OBESTER
WITHERSPOON

DATE SEPT. 1980


ORANGE COUNTY SURVEYOR

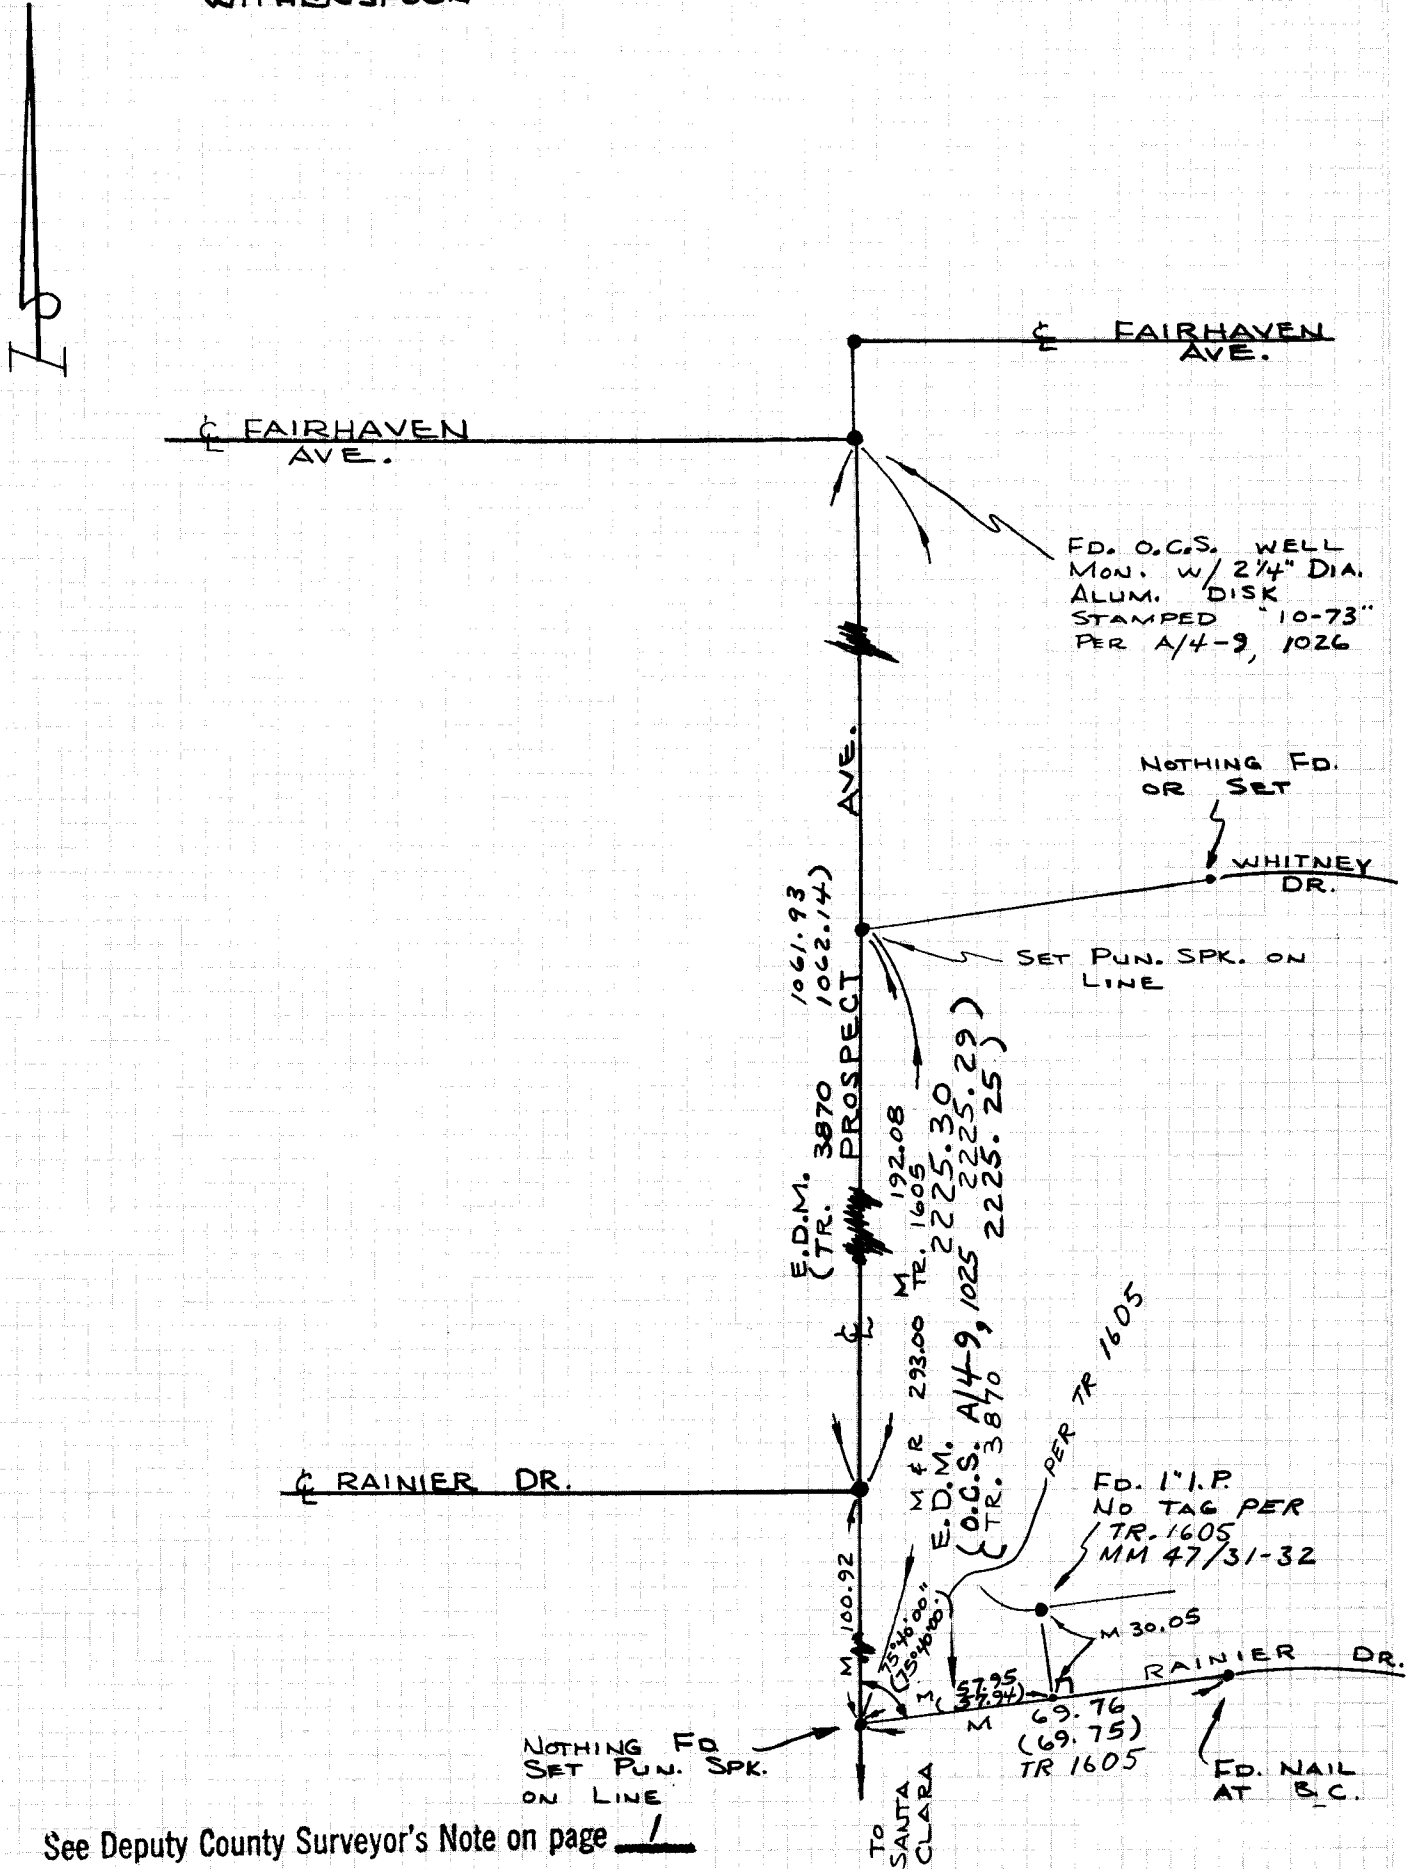

See Deputy County Surveyor's Note on page 1

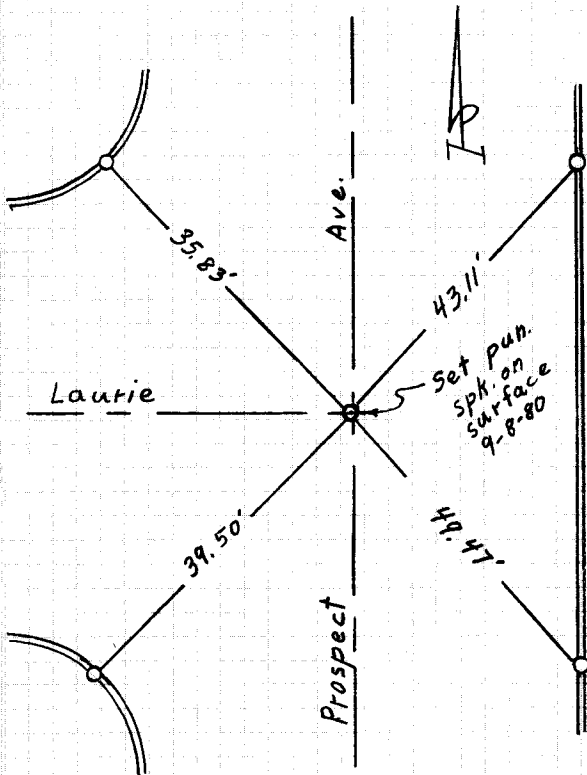


O = Set L+T with O.C.S. Tie Tags
9-8-80

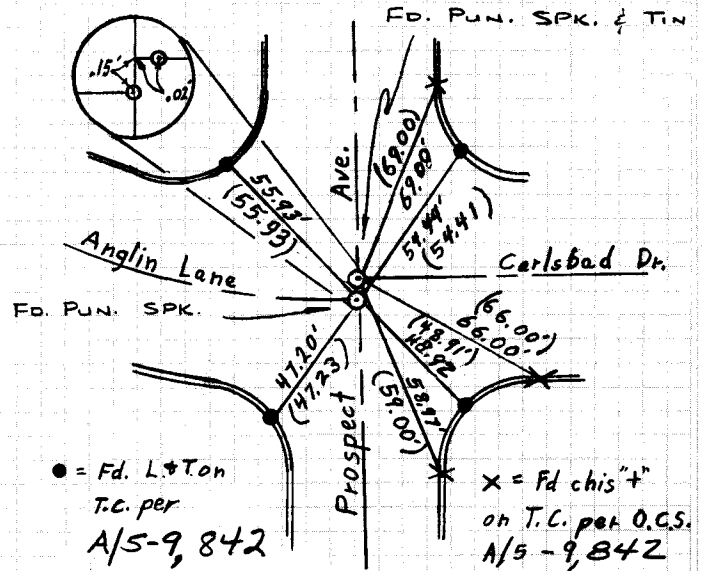


• = Fd. L+Ton
T.C. per
A/5-9,842

x = Fd chis "t"
on T.C. per O.C.S.
A/5-9,842

O = Set L+T with O.C.S. Tie Tags
9-8-80

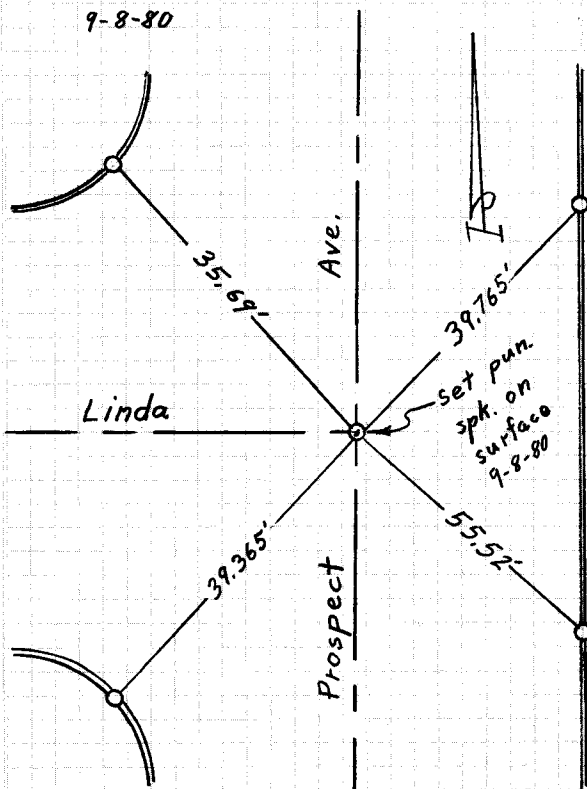



O = Set L+T with O.C.S. Tie Tags
9-8-80

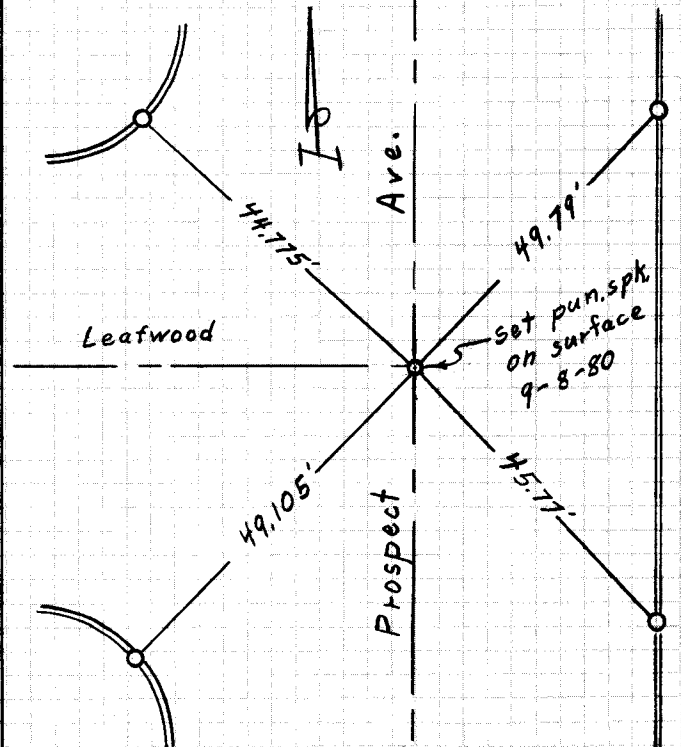


SURVEYED BY SEHER

DATE SEPT. 1980


ORANGE COUNTY SURVEYOR

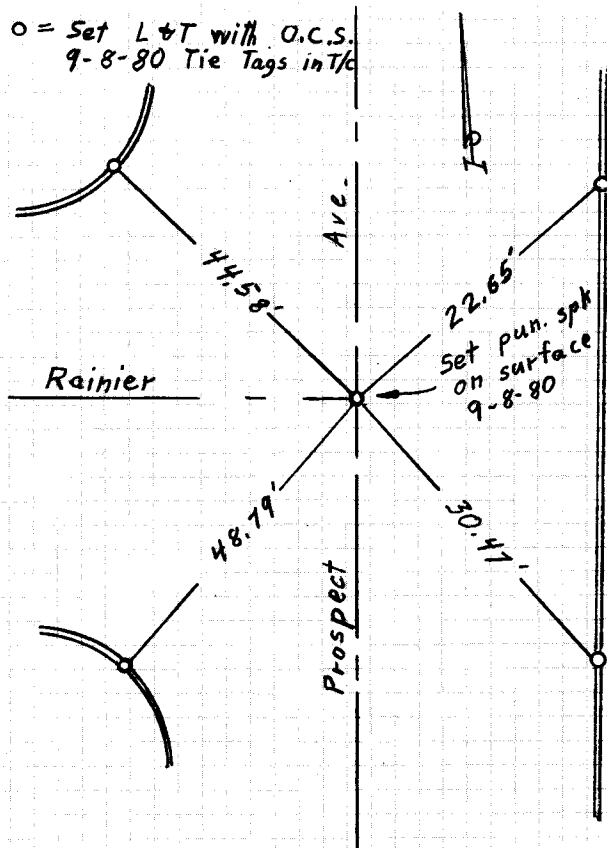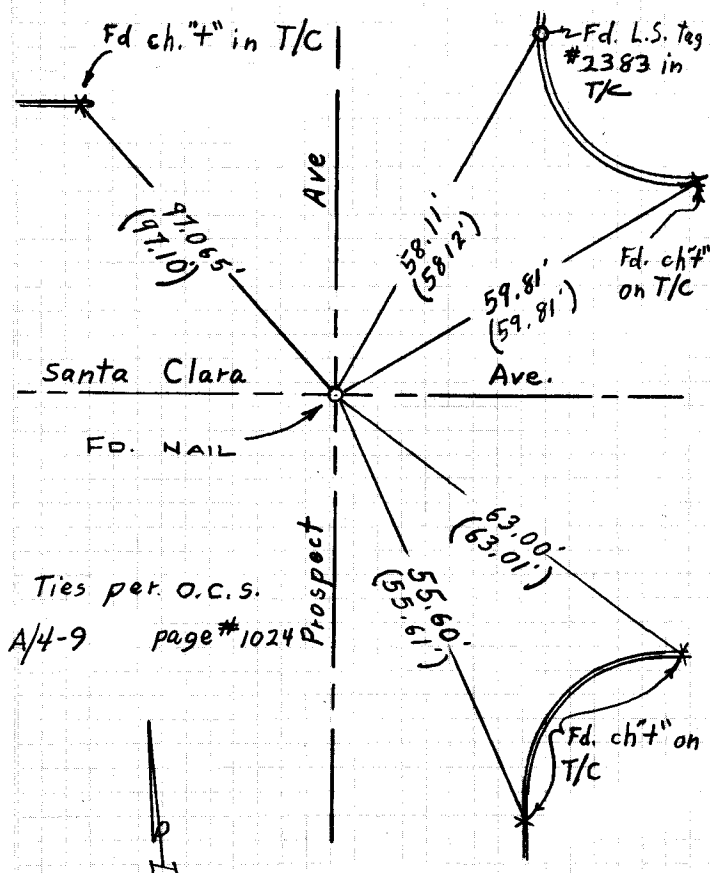

O = Set L & T with O.C.S. 9-8-80 Tie Tags in T/C

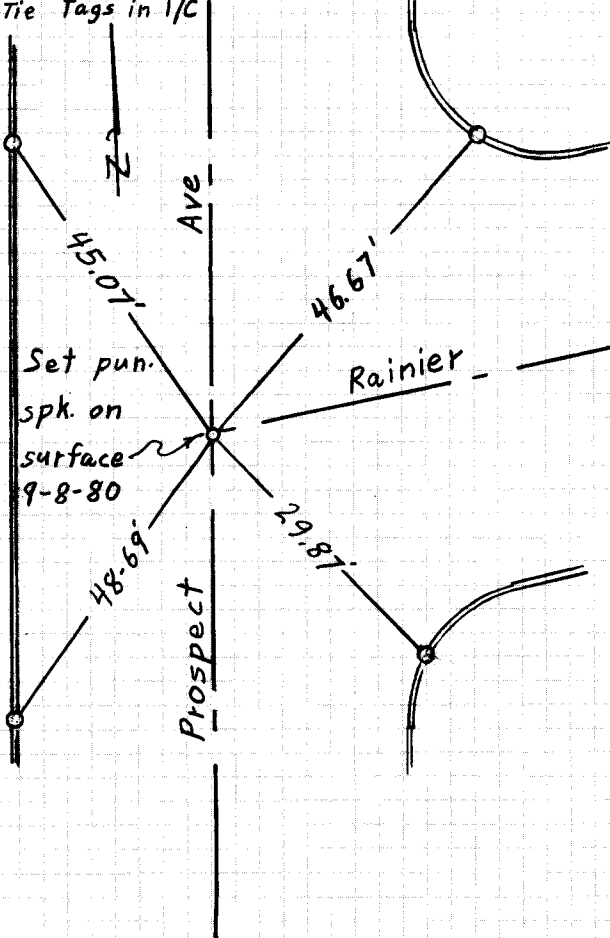


O = Set L & T with O.C.S. 9-8-80 Tie Tags in T/C

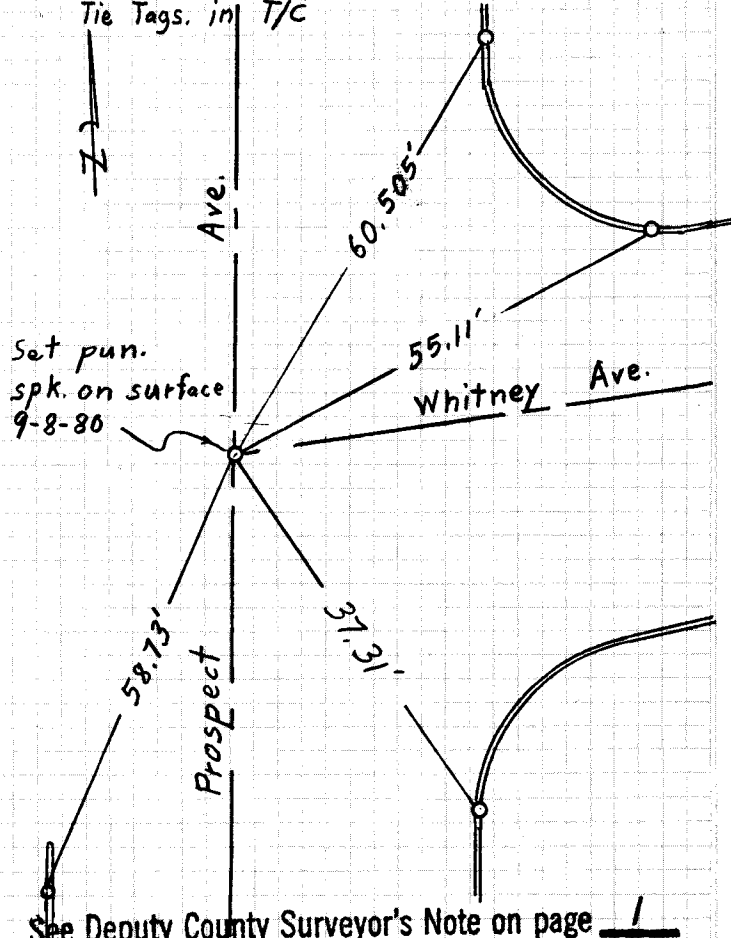

See Deputy County Surveyor's Note on page 1

SURVEYED BY SEHERDATE SEPT. 1980

ORANGE COUNTY SURVEYOR

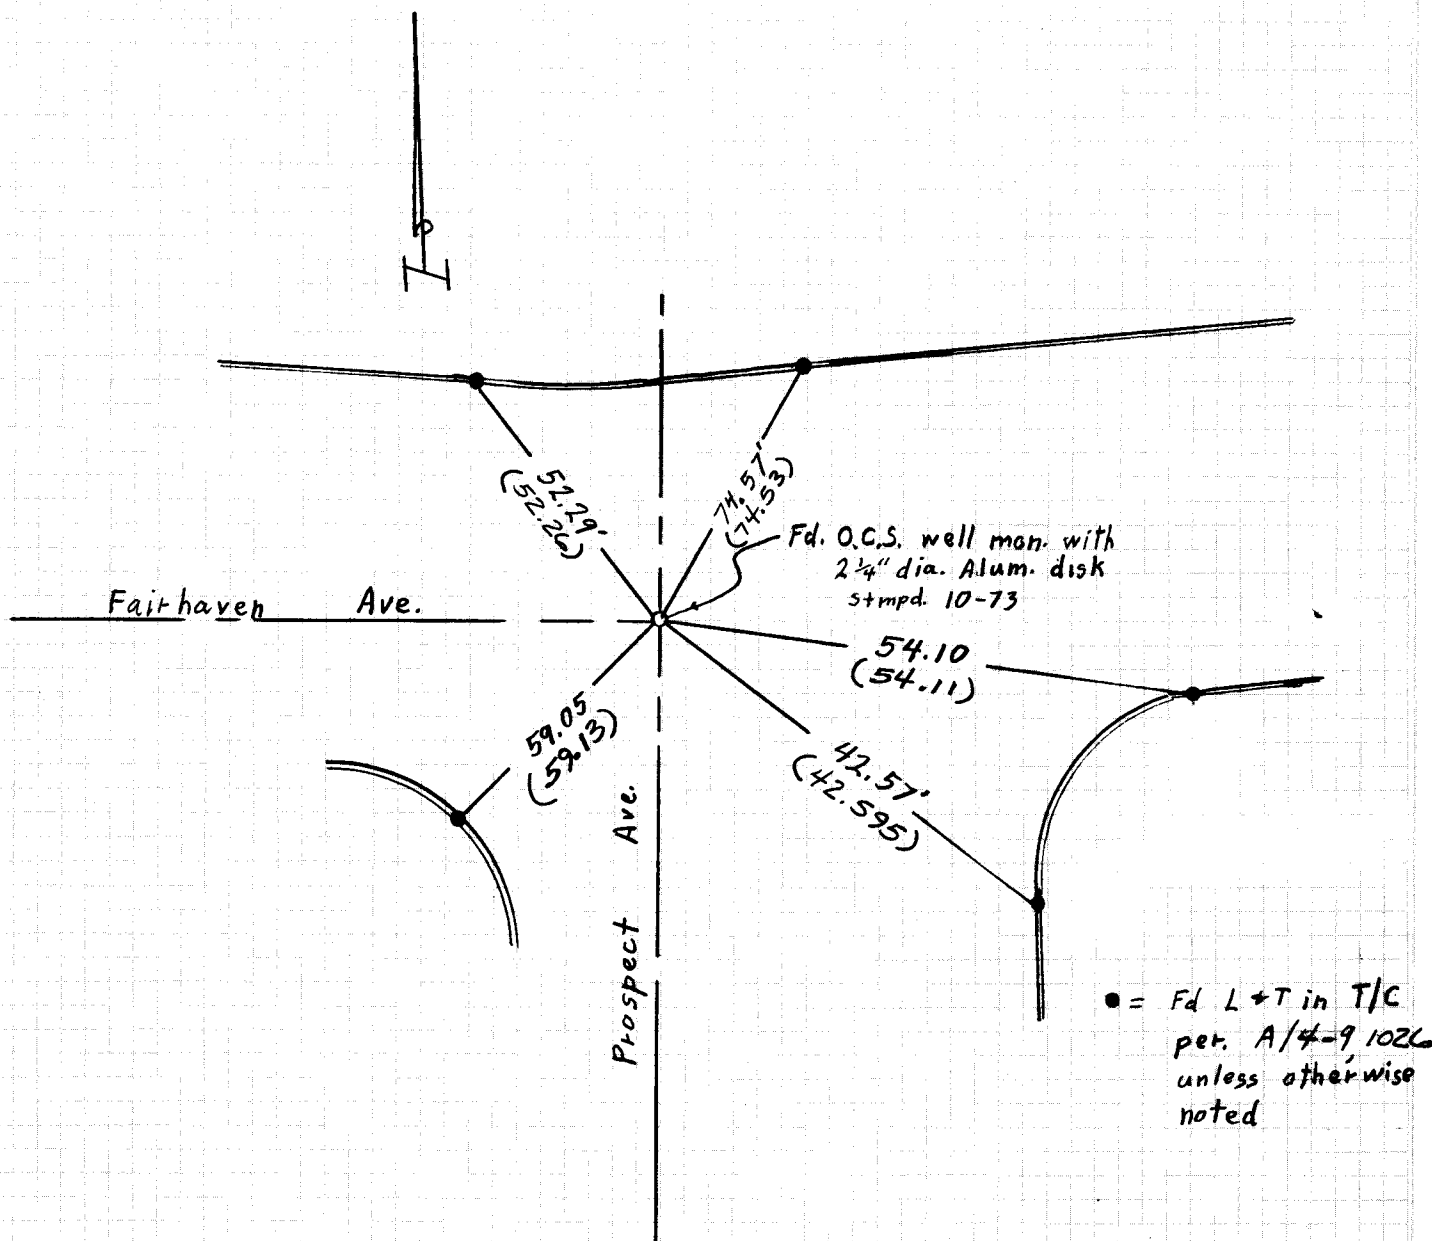See Deputy County Surveyor's Note on page 1