

ORANGE COUNTY SURVEYOR
SURVEY NOTES

A/5-9 920

ALIGNMENT INDEX BOOK AND PAGE

ALIGNMENT NOTES PG. 1 OF 12

PPB _____ WORK ORDER NUMBER R38001434

SURVEY NOTES PAGE _____ OF _____

SURVEY COMPLETION DATE JAN 1986 F.D. / JUNE 86 UNCOVERED SURVEY FILE NUMBER R85-52"D"

PROJECT NAME RESURFACING OF VARIOUS STREETS 1985-1986 CONTRACT #1 (8586-10)

SURVEY LIMITS AREA D SEE PAGE 2

PURPOSE OF SURVEY LOCATE & TIE OUT & MONUMENTS BEFORE STREET RESURFACING.

THOMAS BROS.:

18, 6-A & B

BLOCK AND MODULES:

BLOCK 5852

MODULES 3-6, 4-6, 37, 4-7, 5-7, 3-8, 4-8

SURVEY NOTE PAGE INDEX:

EQUIPMENT:

PERSONNEL:


DEPUTY COUNTY SURVEYOR'S NOTE:

The purpose of these notes is to show the relationship of the points and/or lines shown hereon to either lines of record, control lines, or to each other. The Deputy County Surveyor does not claim at this time, that the points or lines shown hereon are true centerline, boundary, deed, or control points or lines. Without further analysis, the interpretation of these notes is left to the discretion of the user.

G.K. Shelton

Deputy County Surveyor

By:

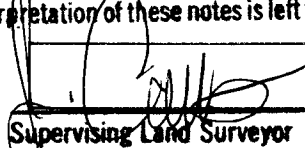
Supervising Land Surveyor

MINICH

RAYMOND

SCHUH

SUTTER


REFERENCES / REMARKS :

POINTS FOUND IN JAN '86 WERE TIED OUT; AFTER RESURFACING, POINTS WERE UNCOVERED IN JUNE '86.

MINICH

AREA D


JAN. 86

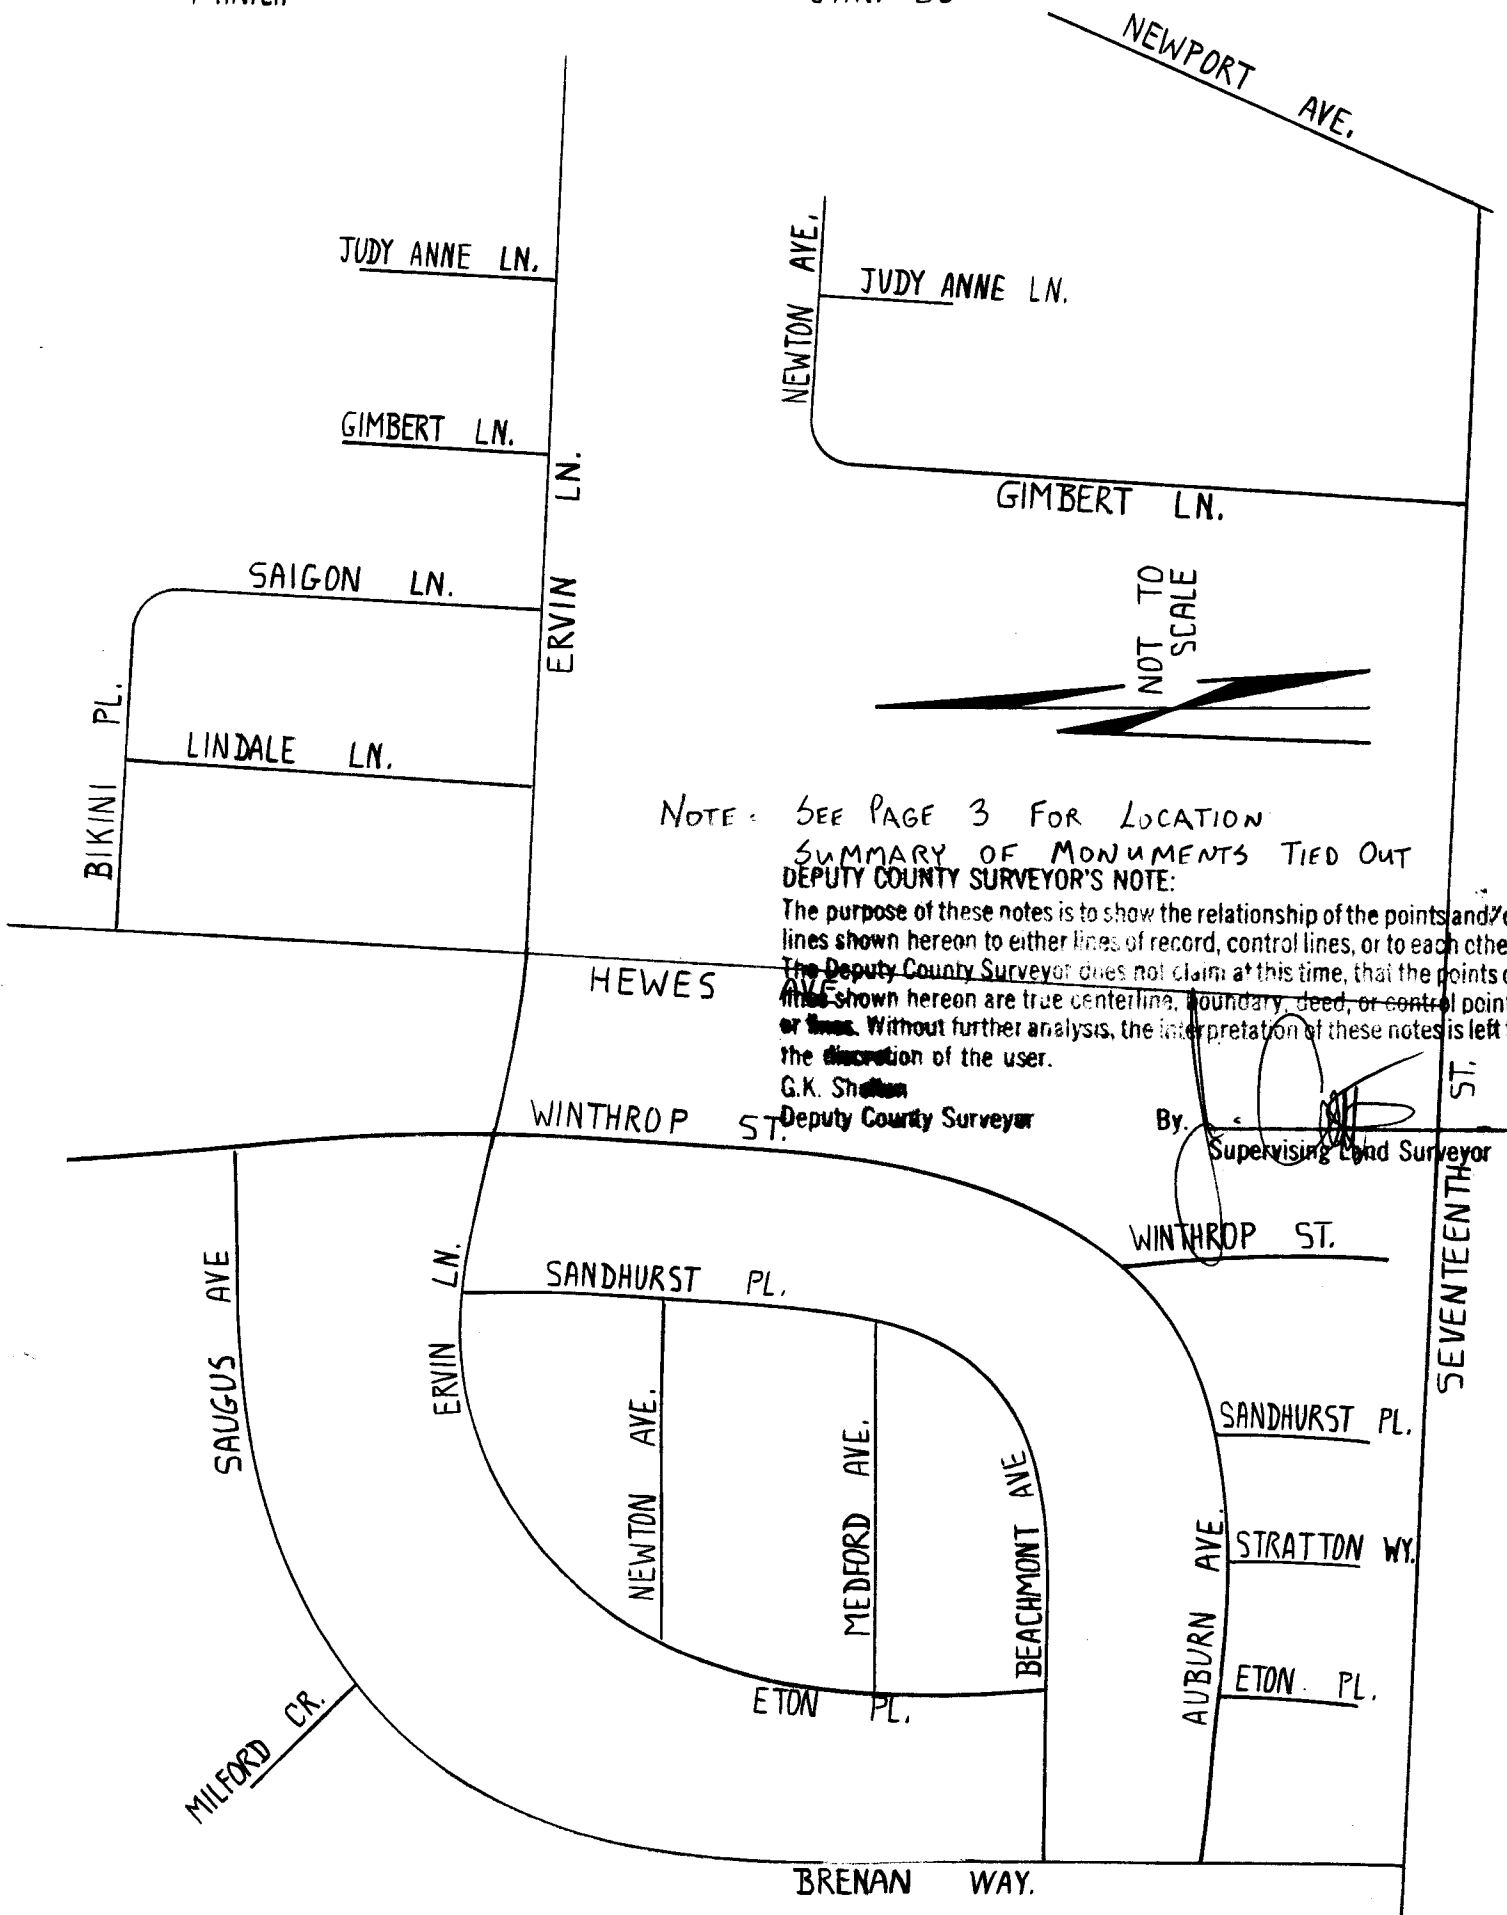

SURVEYED BY MINICH



DATE JAN. 86

ORANGE COUNTY SURVEYOR

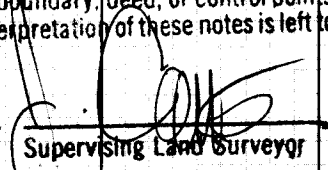CONTROL POINT	FOUND POINT	SET POINT	PAGE #
INT. OF ETON & BEACHMONT	FD. P.K. NAIL	UNCOVERED ORIGINAL PT.	4
INT. OF MILFORD & SAUGUS, BRENNAN	FD. P.K. NAIL	↑	4
B.C. ON AUBURN W'LY OF STRATON	FD. P.K. NAIL		5
INT. OF AUBURN & SANDHURST	FD. P.K. NAIL		5
CUL-DE-SAC ON WINTHROP	•		6
B.C. ON WINTHROP	•		6
BC ON GIMBERT N'LY OF 17TH	⊙		7
PRC ON GIMBERT N'LY OF 17TH	⊙		7
EC ON GIMBERT S'LY OF NEWTON	⊙		8
PRC ON GIMBERT S'LY OF NEWTON	⊙	6.13.86	8
INT OF GIMBERT & NEWTON	⊙		8
CUL-DE-SAC ON JUDY ANNE	⊙		9
TRACT LINE ON LINDALE	•		9
TRACT LINE ON SAIGON	•		10
INT OF LINDALE & BIKINI	•		10
CUL-DE-SAC ON WINTHROP	⊙	↓	11
INT. OF WINTHROP & SAUGUS	FD. P.K. NAIL	UNCOVERED ORIGINAL PT.	11
INT. OF WINTHROP & ERYIN	FD. P.K. NAIL	BUG - FD NOTHING SET NOTHING	12
BC ON WINTHROP S'LY OF ERYIN	FD. P.K. NAIL	UNCOVERED ORIGINAL PT.	12
• FD. SPK. ⊙ FD. SPK. & W DEPUTY COUNTY SURVEYOR'S NOTE: The purpose of these notes is to show the relationship of the points and/or lines shown hereon to either lines of record, control lines, or to each other. The Deputy County Surveyor does not claim at this time, that the points or lines shown hereon are true centerline, boundary, deed, or control points or lines. Without further analysis, the interpretation of these notes is left to the discretion of the user. G.K. Shelton Deputy County Surveyor By:  Supervising Land Surveyor			

STREET RESURFACING "D"
MINICH NOTES RAYMOND

JAN. 86

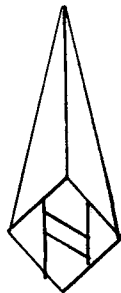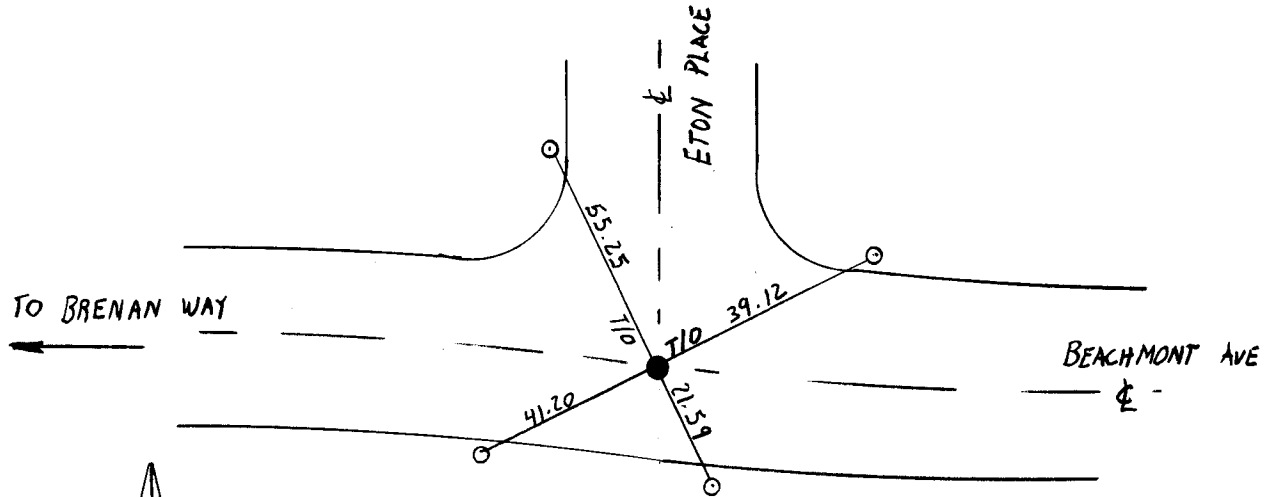

NO SCALE



- = Fd PK NAIL & TIN No PUN
FLUSH PER TRACT 2580,
M.M. 81/38-42
- = SET L & O.C.S. TIE TAG

DEPUTY COUNTY SURVEYOR'S NOTE:

The purpose of these notes is to show the relationship of the points and/or lines shown hereon to either lines of record, control lines, or to each other. The Deputy County Surveyor does not claim at this time, that the points or lines shown hereon are true centerline, boundary, deed, or control points or lines. Without further analysis, the interpretation of these notes is left to the discretion of the user.

G.K. Shelton
Deputy County Surveyor


By:
Supervising Land Surveyor

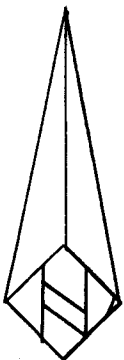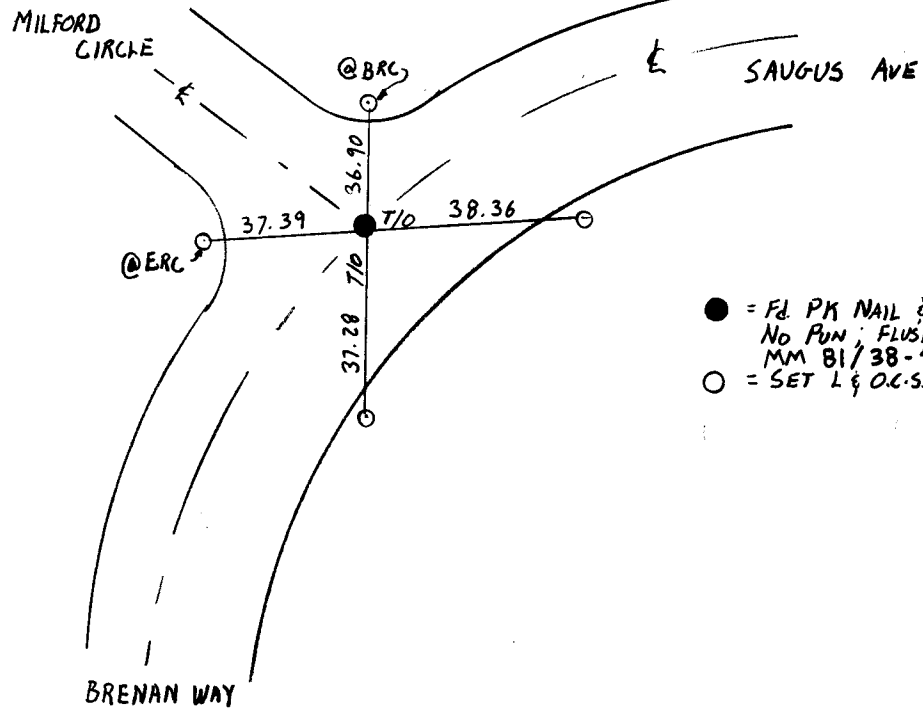


NO SCALE

- = Fd PK NAIL & TIN
No PUN; FLUSH PER TRACT 2580,
M.M. 81/38-42
- = SET L & O.C.S. TIE TAG

JAN. 86

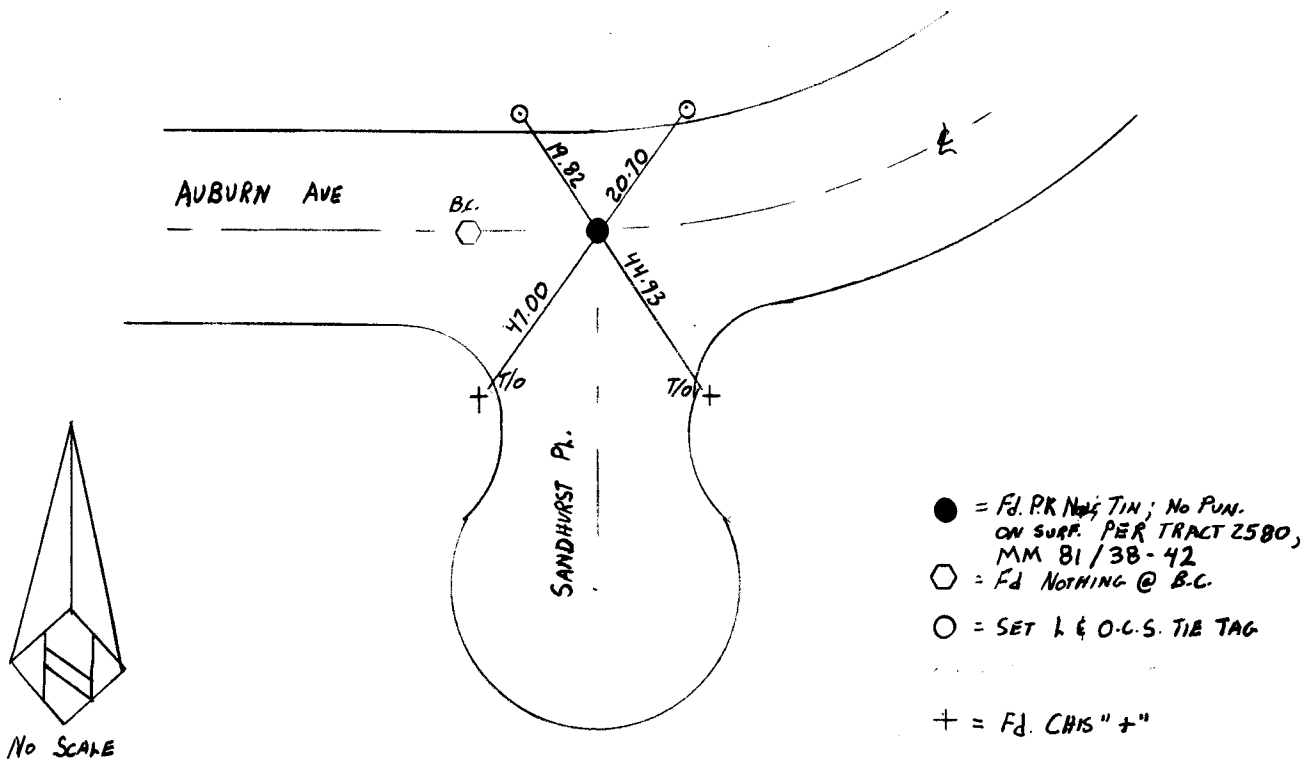

- = Fd. PK NAIL & TIN
No PUN. ON SURF. TRACT 2580,
MM 81/38-42
- = SET L & O.C.S. TIE TAG

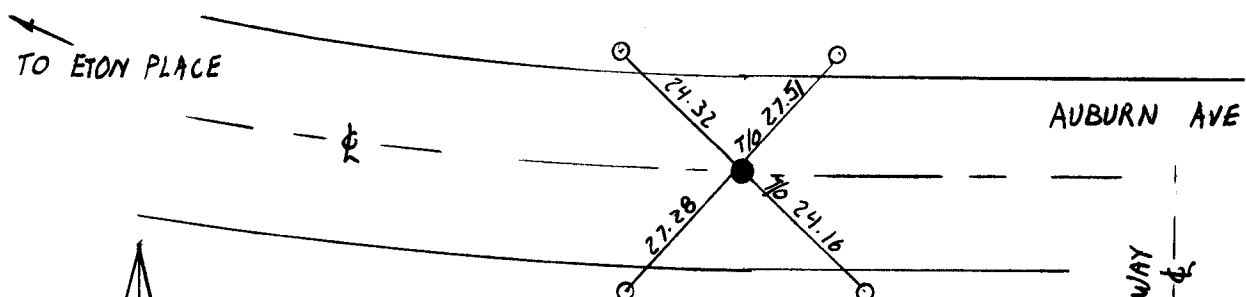

DEPUTY COUNTY SURVEYOR'S NOTE:



The purpose of these notes is to show the relationship of the points and/or lines shown hereon to either lines of record, control lines, or to each other. The Deputy County Surveyor does not claim at this time, that the points or lines shown hereon are true centerline, boundary, deed, or control points or lines. Without further analysis, the interpretation of these notes is left to the discretion of the user.

G.K. Shelton
Deputy County Surveyor

By.
Supervising Land Surveyor

STREET RESURFACING "D"
MINICH NOTES RAYMOND

JAN. 86

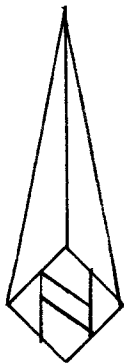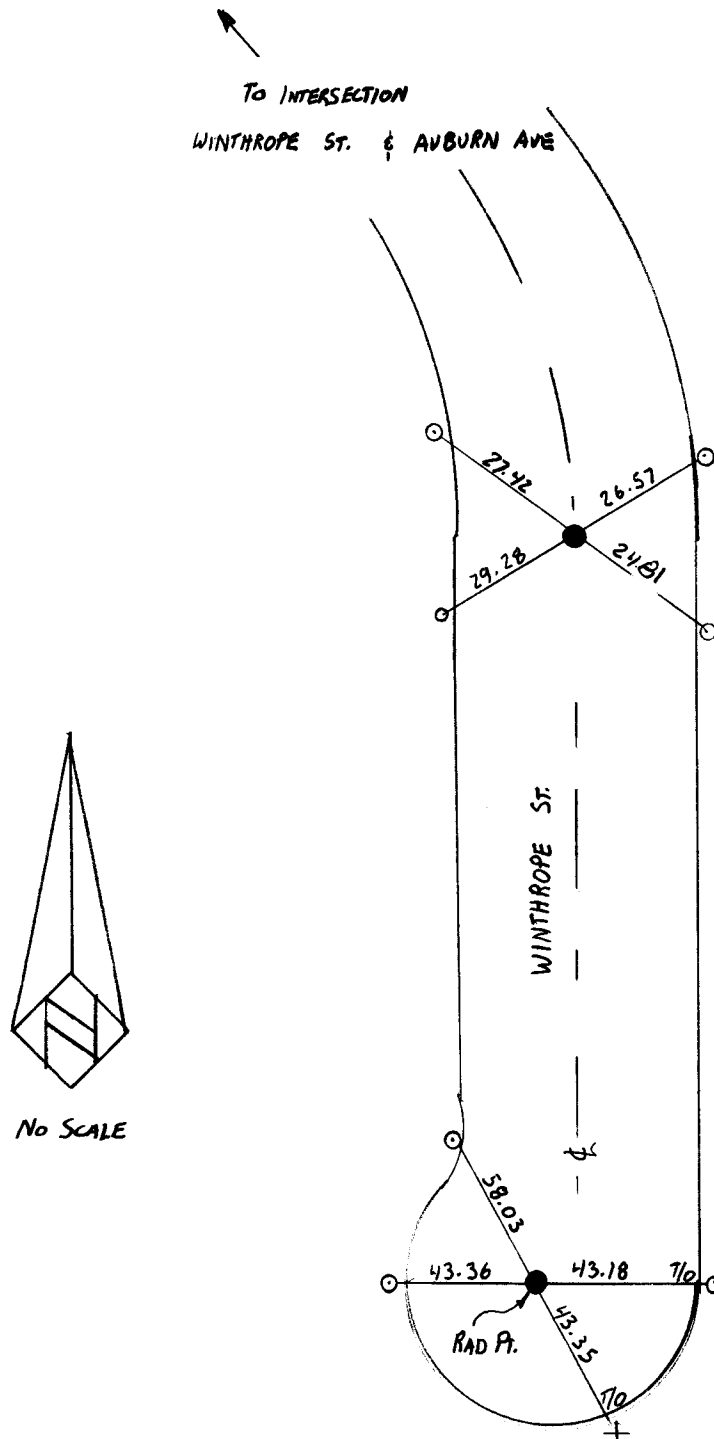


NO SCALE

DEPUTY COUNTY SURVEYOR'S NOTE:

The purpose of these notes is to show the relationship of the points and/or lines shown hereon to either lines of record, control lines, or to each other. The Deputy County Surveyor does not claim at this time, that the points or lines shown hereon are true centerline, boundary, deed, or control points or lines. Without further analysis, the interpretation of these notes is left to the discretion of the user.

G.K. Shelton
Deputy County Surveyor

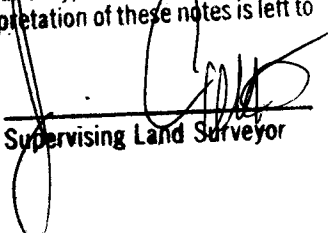By. 
Supervising Land Surveyor

● = Fd. SPK & TIN No. PUN
FLUSH @ RAD PT.
TRACT 2580, MM 81/38-42



○ = SET L & O.C.S. TIE TAG

+ = Fd. CHIS "+"



STREET RESURFACING "D"
MINICH

NOTES RAYMOND

JAN. 86

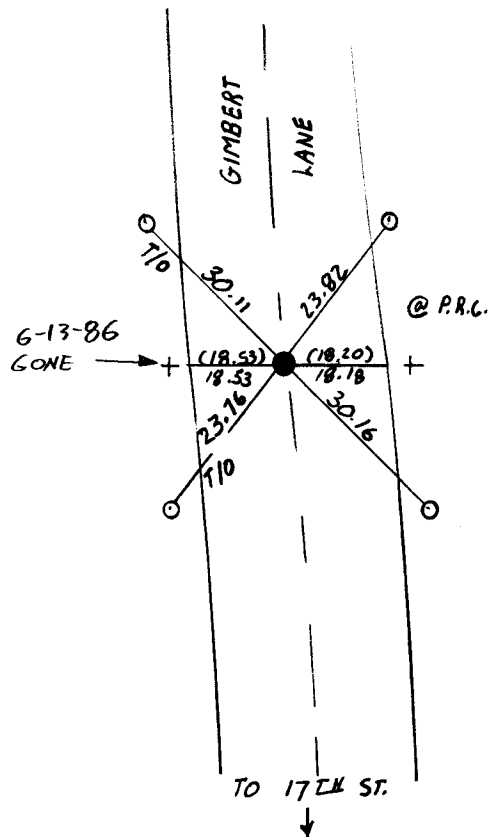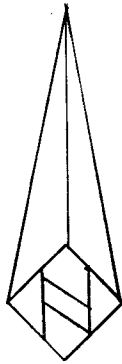

- = Fd. SPK. & WASHER No PUN. ON SURF. PER TR. 4155
MM 147/9-11
- = SET L & O.C.S. TIE TAG
- () = RECORD DIST PER A/5-9 Pg. 337
- + = Fd. CHIS "+"

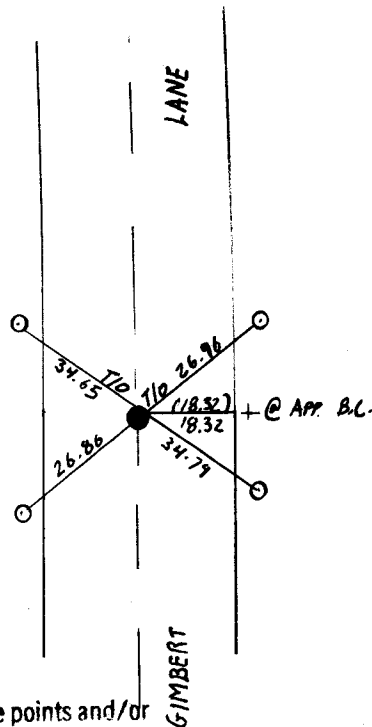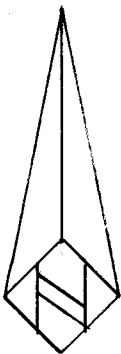

- = Fd. SPK. & WASHER No PUN. ON SURF. PER TR. 4155
MM 147/9-11
- = SET L & O.C.S. TIE TAG
- () = RECORD DIST PER A/5-9 Pg. 337
- + = Fd. CHIS "+"

DEPUTY COUNTY SURVEYOR'S NOTE:


The purpose of these notes is to show the relationship of the points and/or lines shown hereon to either lines of record, control lines, or to each other. The Deputy County Surveyor does not claim, at this time, that the points or lines shown hereon are true centerline, boundary, deed, or control points or lines. Without further analysis, the interpretation of these notes is left to the discretion of the user.

G.K. Shelton
Deputy County Surveyor


By:
Supervising Land Surveyor

17TH STREET

JAN. 86

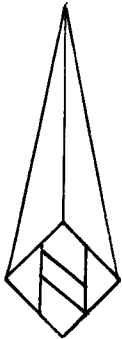

6-13-86
FD SHANK -
SET SPK &
O.C.S. TAG
ON SURFACE

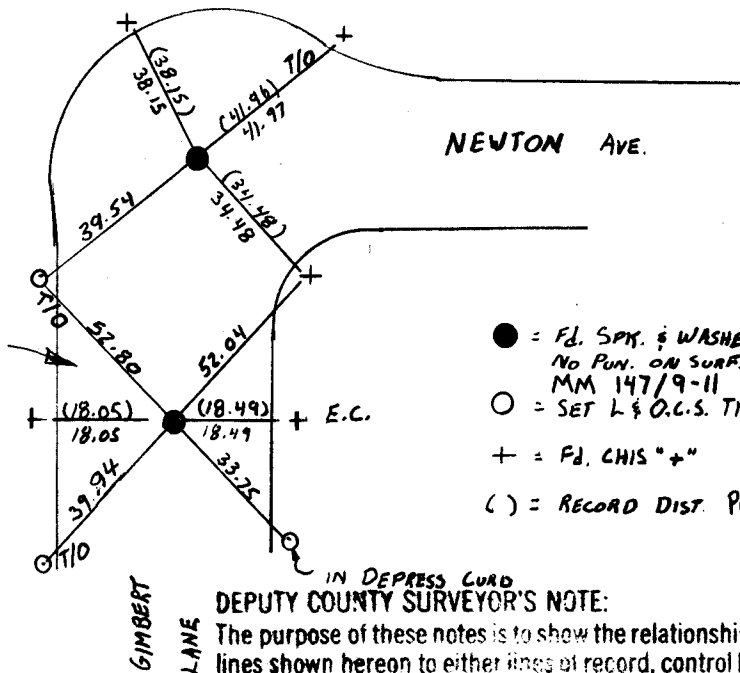

- = Fd. SPK. & WASHER
NO PUN. ON SURF., PER TR 4155
MM 147/9-11
- = SET L & O.C.S. TIE TAG
- + = Fd. CHIS "+"
- () = RECORD DIST. PER A/5-9 Pg. 337



DEPUTY COUNTY SURVEYOR'S NOTE:

The purpose of these notes is to show the relationship of the points and/or lines shown hereon to either lines of record, control lines, or to each other. The Deputy County Surveyor does not claim at this time, that the points or lines shown hereon are true centerline, boundary, deed, or control points or lines. Without further analysis, the interpretation of these notes is left to the discretion of the user.

G.K. Shelton
Deputy County Surveyor

By:
Supervising Land Surveyor

- = Fd. SPK. & WASHER
NO PUN. ON SURF. PER TR 4155
MM 147/9-11
- = SET L & O.C.S. TIE TAG
- + = Fd. CHIS "+"
- () = RECORD DIST. PER A/5-9 Pg. 337

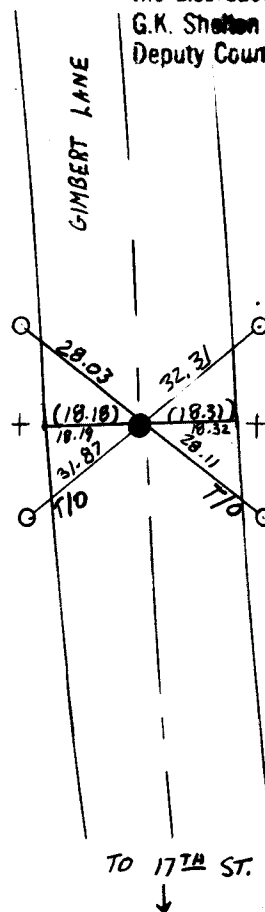
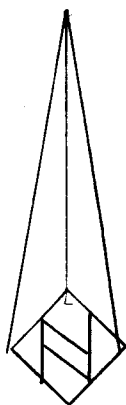


@ 2ND P.R.C.

STREET RESURFACING "D"
MINICH

NOTES RAYMOND

JAN. 86

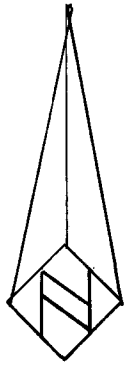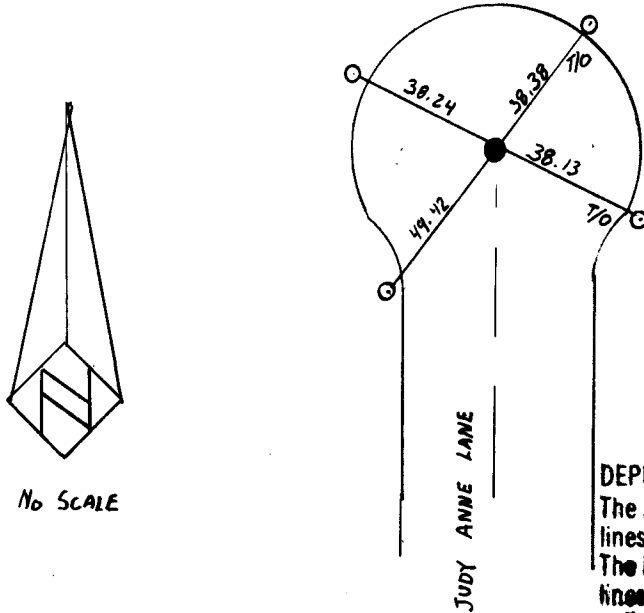

NO SCALE



- = Fd. SPK & WASHER
NO PUN. ON SURF PER TR 2680
MM 80/26
- = SET L & O.C.S. TIE TAG

DEPUTY COUNTY SURVEYOR'S NOTE:

The purpose of these notes is to show the relationship of the points and lines shown hereon to either lines of record, control lines, or to each other. The Deputy County Surveyor does not claim at this time, that the point lines shown hereon are true centerline, boundary, deed, or control point lines. Without further analysis, the interpretation of these notes is left to the discretion of the user.

G.K. Shuman
Deputy County Surveyor

By:
Supervising Land Surveyor

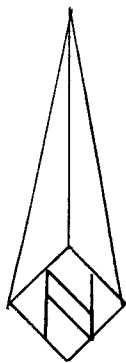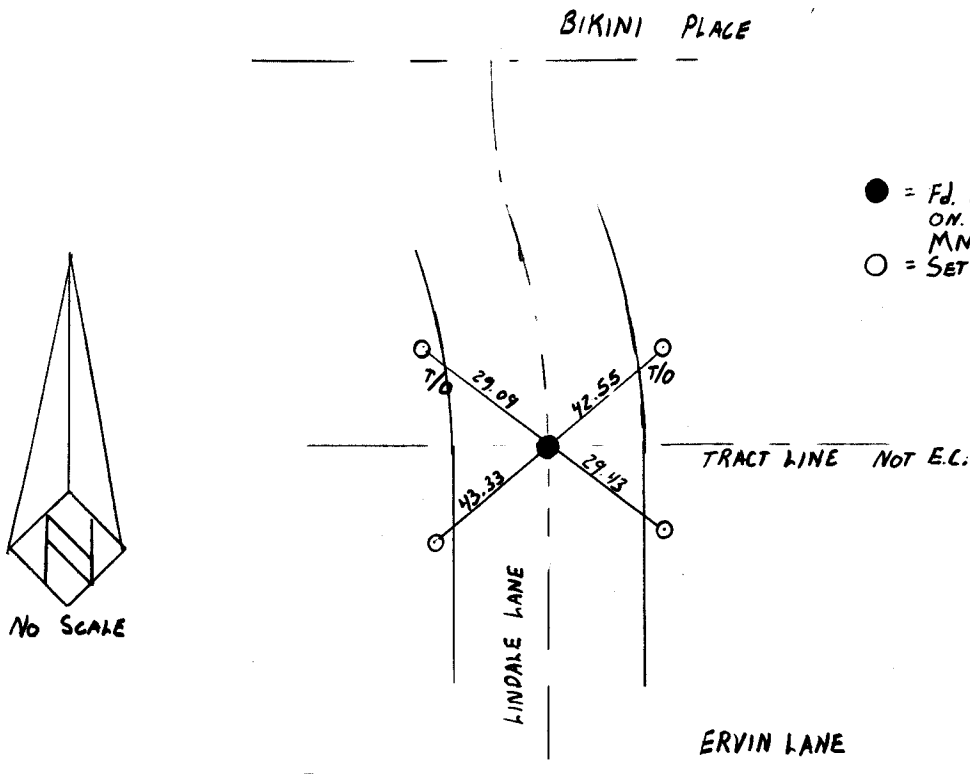

NO SCALE


- = Fd. SPK & TIN NO PUN.
ON SURF. PER TRACT 2214
MM 69/25
- = SET L & O.C.S. TIE TAG

STREET RESURFACING "D"
MINICH


NOTES RAYMOND

JAN. 86

PAGE 10 OF 12

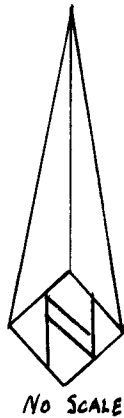

BIKINI PLACE

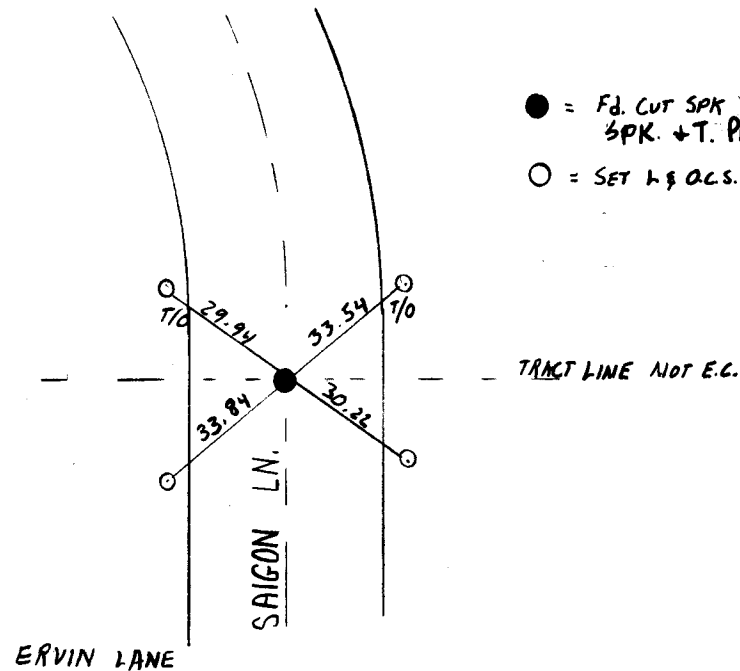



- = Fd. CUT SPK DN 0.1 IN LIEU OF SPK. + T. PER TR 2214 MM 69/25
- = SET L & Q.C.S. TIE TAG

~~DEPUTY COUNTY SURVEYOR'S NOTE:~~

The purpose of these notes is to show the relationship of the points and/or lines shown hereon to either lines of record, control lines, or to each other. The Deputy County Surveyor does not claim at this time, that the points or lines shown hereon are true centerline, boundary, deed, or control points or lines. Without further analysis, the interpretation of these notes is left to the discretion of the user.

G.K. Shelton
Deputy County Surveyor

By.
Supervising Land Surveyor

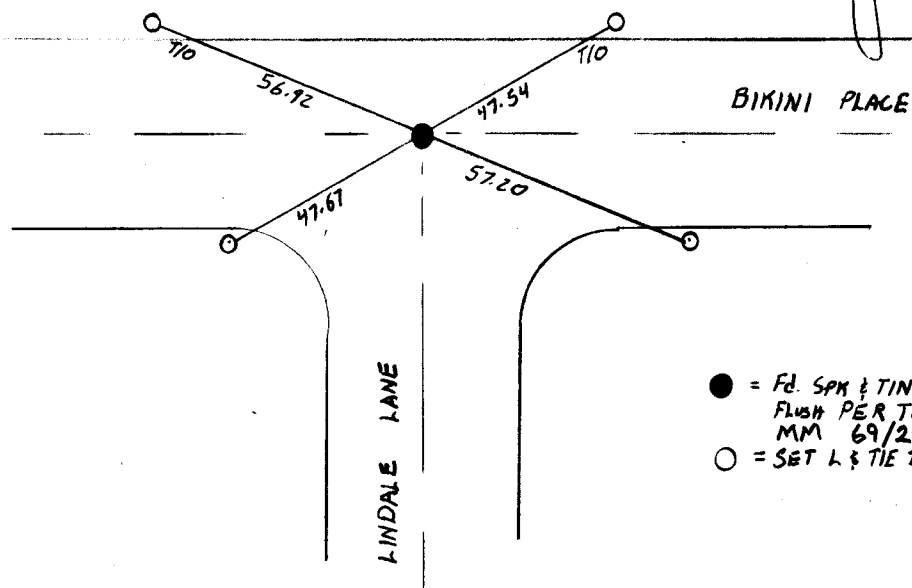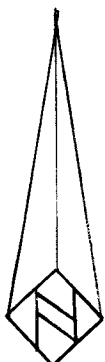

- = Fd. SPK & TIN No Pun Flush PER TRACT 2214 MM 69/25
- = SET L & TIE TAG


STREET RESURFACING "D"

PAGE 11 OF 12


MINICH

NOTES RAYMOND

JAN, 86

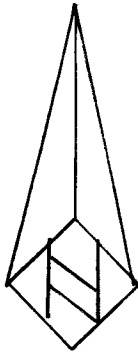

NO SCALE

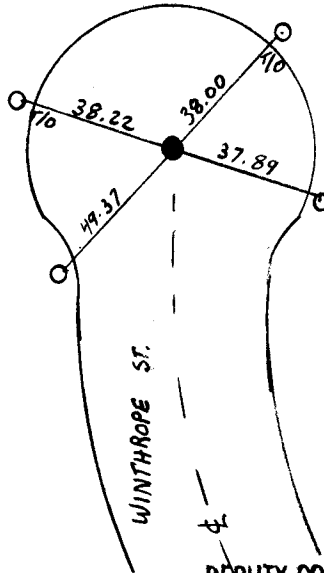

● = Fd. SPK & WASHER
NO PUN, FLUSH
PER TRACT 2580


○ = SET L & O.C.S. TIE TAG

DEPUTY COUNTY SURVEYOR'S NOTE:


The purpose of these notes is to show the relationship of the points and/or lines shown hereon to either lines of record, control lines, or to each other. The Deputy County Surveyor does not claim at this time, that the points or lines shown hereon are true centerline, boundary, deed, or control points or lines. Without further analysis, the interpretation of these notes is left to the discretion of the user.

G.K. Shelton
Deputy County Surveyor

By.
Supervising Land Surveyor

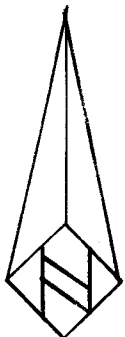

NO SCALE


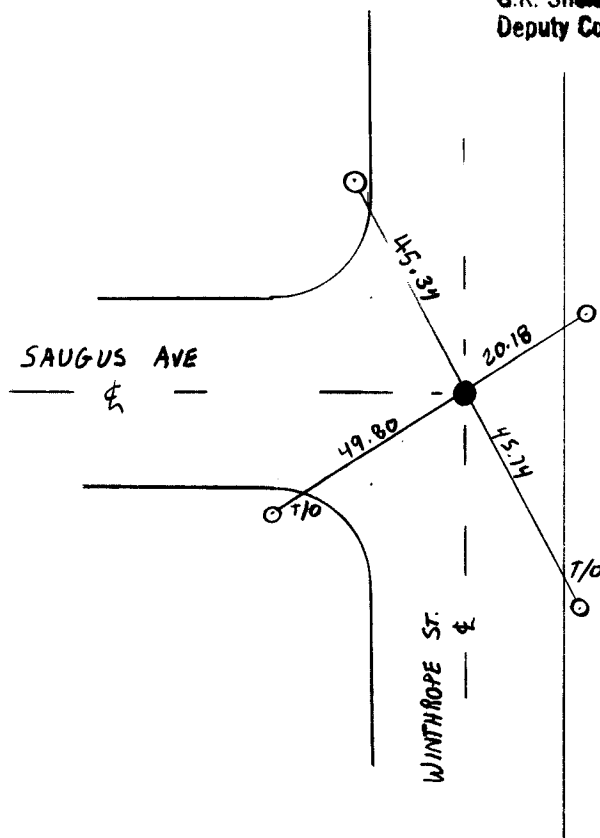


● = Fd. P.K. NAIL ON SURF.
NO WASHER NO REF.

○ = SET L & O.C.S. TIE TAG

6-13-86

DUG - FD BROKEN
SHANK - SET NOTHING

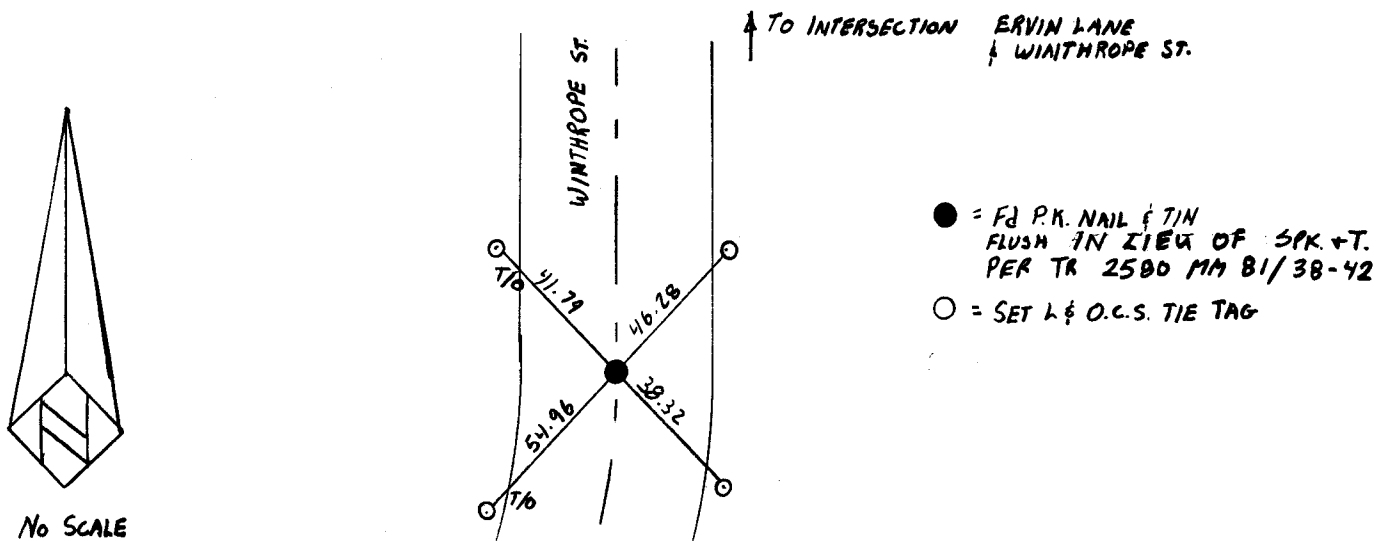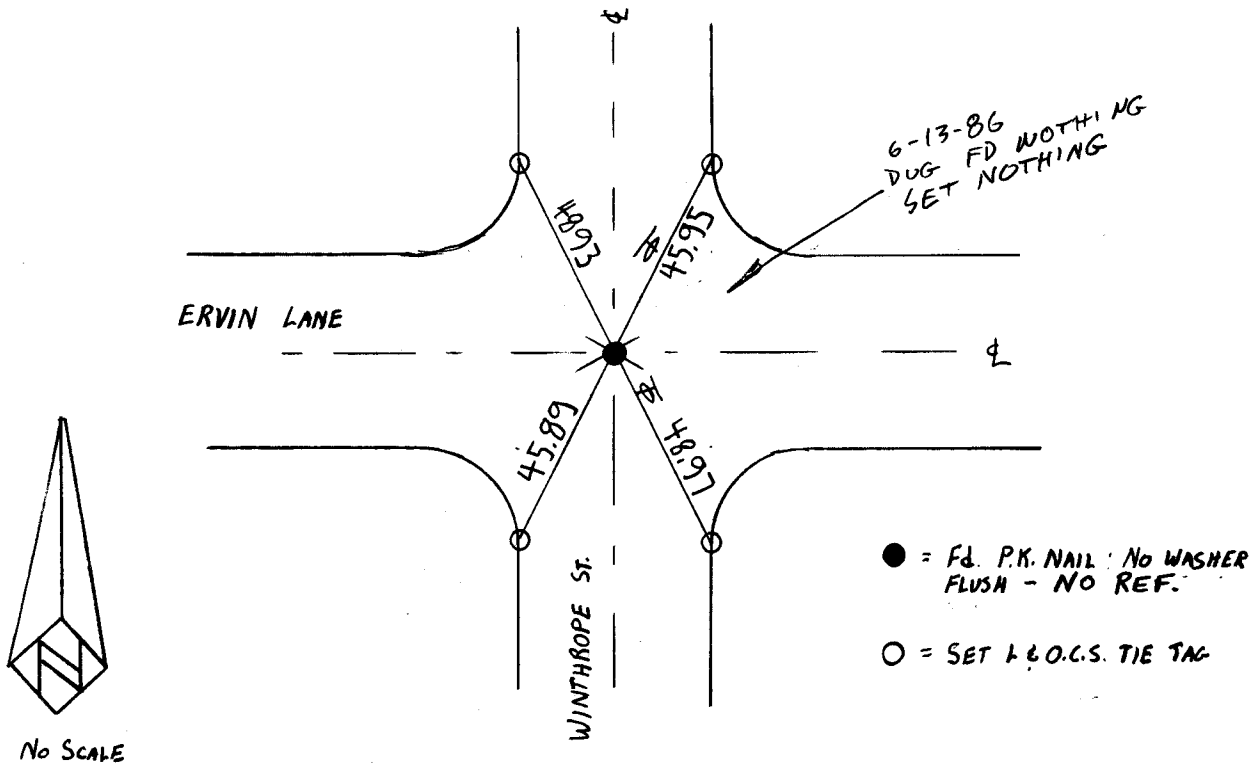

DEPUTY COUNTY SURVEYOR'S NOTE

The purpose of these notes is to show the relationship of the points and/or lines shown hereon to either lines of record, control lines, or to each other. The Deputy County Surveyor does not claim at this time, that the points or lines shown hereon are true centerline, boundary, deed, or control points or lines. Without further analysis, the interpretation of these notes is left to the discretion of the user.

G.K. Shallen
Deputy County Surveyor

By:
Supervising Land Surveyor