

ORANGE COUNTY SURVEYOR
SURVEY NOTES

A/5-9 910

ALIGNMENT INDEX BOOK AND PAGE

ALIGNMENT NOTES PG. ____ OF ____

PPB _____ WORK ORDER NUMBER R38001434

SURVEY NOTES PAGE 1 OF 10

SURVEY COMPLETION DATE _____

SURVEY FILE NUMBER R85-52"C"

PROJECT NAME STREET RESURFACING & TIES

SURVEY LIMITS AREA 'C'

PURPOSE OF SURVEY TO TIE OUT & POINTS BEFORE PAVING
AND SET SURFACE POINTS AFTER OVERLAY

THOMAS BROS.:

BLOCK AND MODULES:

PG18-AS

CH

BLOCK 5852

MOD 76,77,66,56,55

5853

92

5953

03

SURVEY NOTE PAGE INDEX:

EQUIPMENT:

PERSONNEL:

DEPUTY COUNTY SURVEYOR'S NOTE:

The purpose of these notes is to show the relationship of the points and/or lines shown hereon to either lines of record, control lines, or to each other. The Deputy County Surveyor does not claim at this time, that the points or lines shown hereon are true centerline, boundary, deed, or control points or lines. Without further analysis, the interpretation of these notes is left to the discretion of the user.

G.K. Shelton

Deputy County Surveyor

By.

Supervising Land Surveyor

WILD T-1

100' STEEL CHAIN

T. SANDEFER - P.C.

L. WADE - T

D. ECKEL - S

H. ROGERS - EAT

REFERENCES / REMARKS :

TRACT 3039, MM 100/45-48

TRACT 3215, MM 112/24-26


& POINTS TIE OUT AND LOCATED 12-31-85

& POINTS SET ON NEW SURFACE

WITH PUN. CUT SPK. AND O.C.S. TAG 1 JULY, 1986

RESURFACING AREA 'C'
SANDEFER E PTY

12-31-85

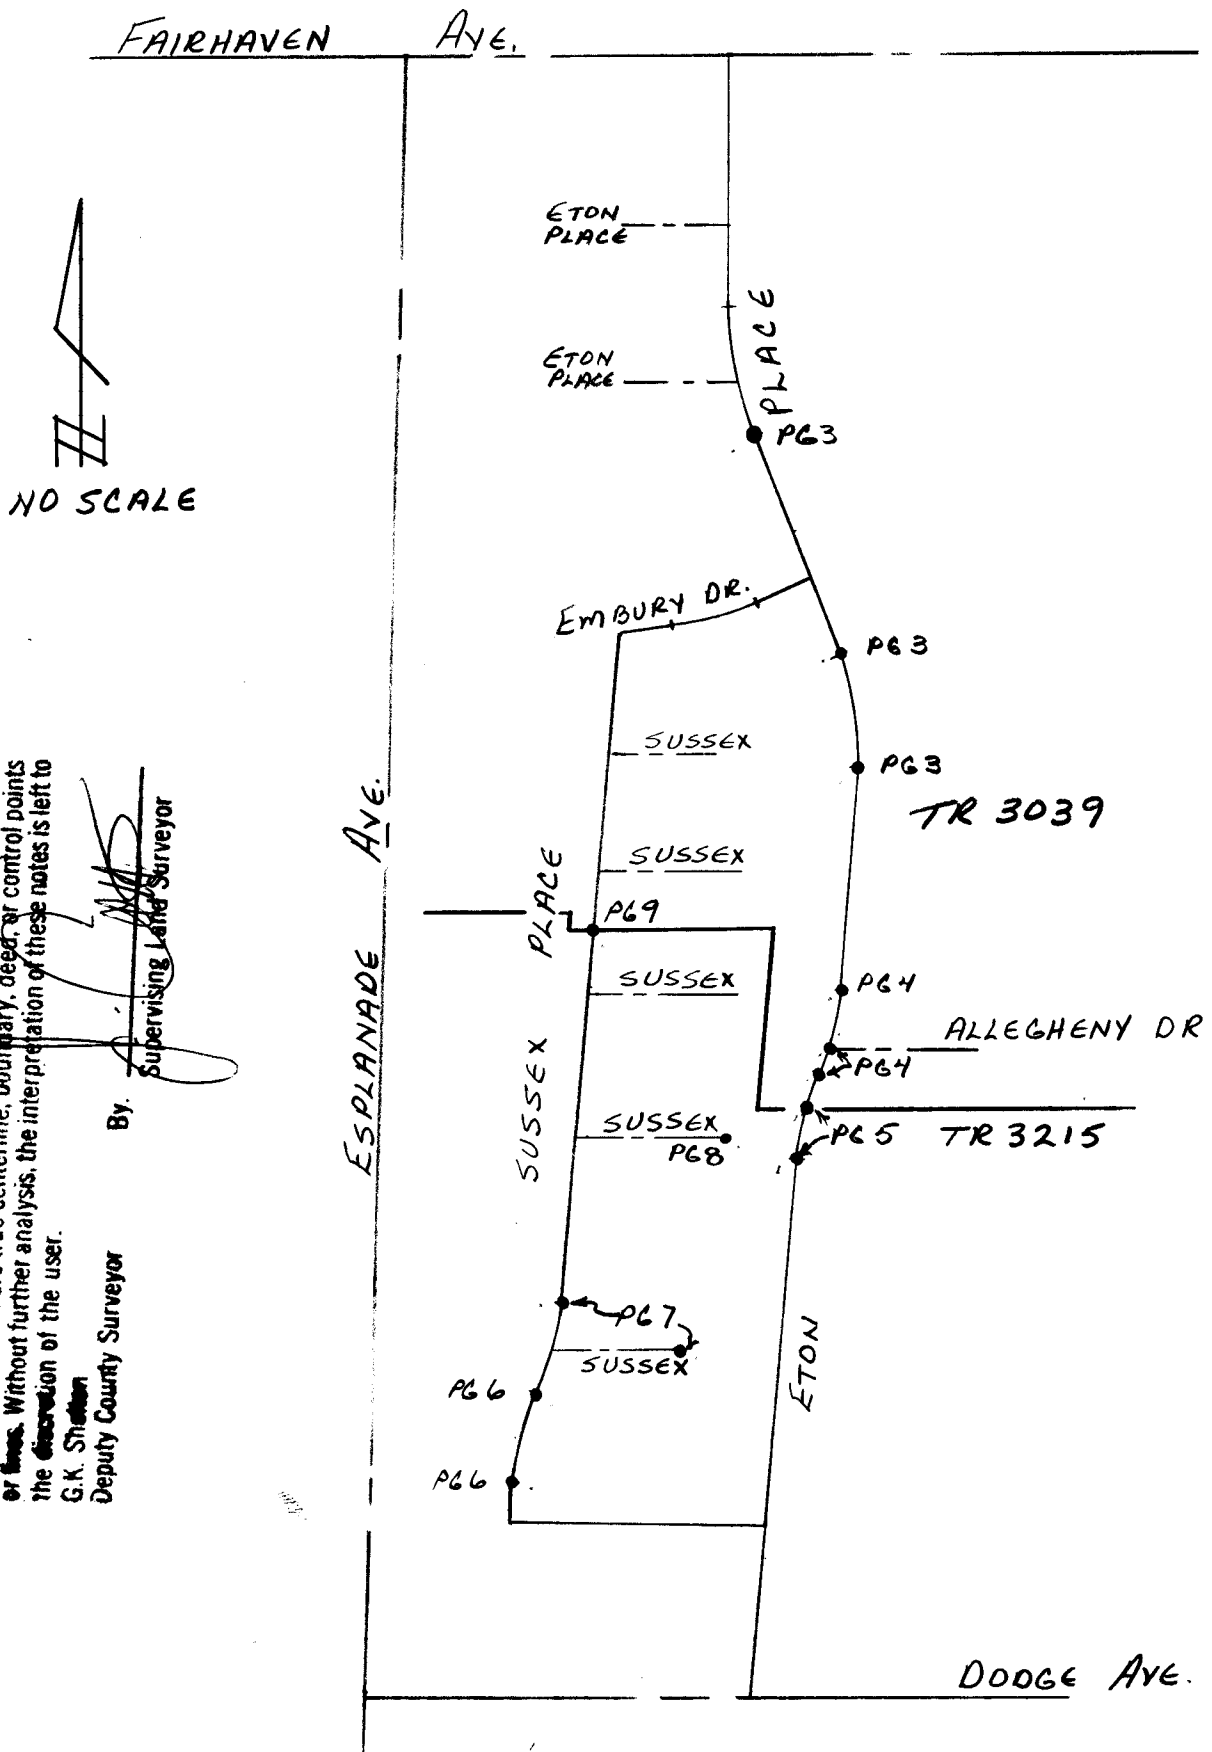

DEPUTY COUNTY SURVEYOR'S NOTE:

The purpose of these notes is to show the relationship of the points and/or lines shown hereon to either lines of record, control lines, or to each other. The Deputy County Surveyor does not claim at this time, that the points or lines shown hereon are true centerline, boundary, deed, or control points or lines. Without further analysis, the interpretation of these notes is left to the discretion of the user.

G.K. Shelton

Deputy County Surveyor


By:

Supervising Land Surveyor

TIES - RESURFACING AREA "C"

SANDEFER & PARTY

12-31-85

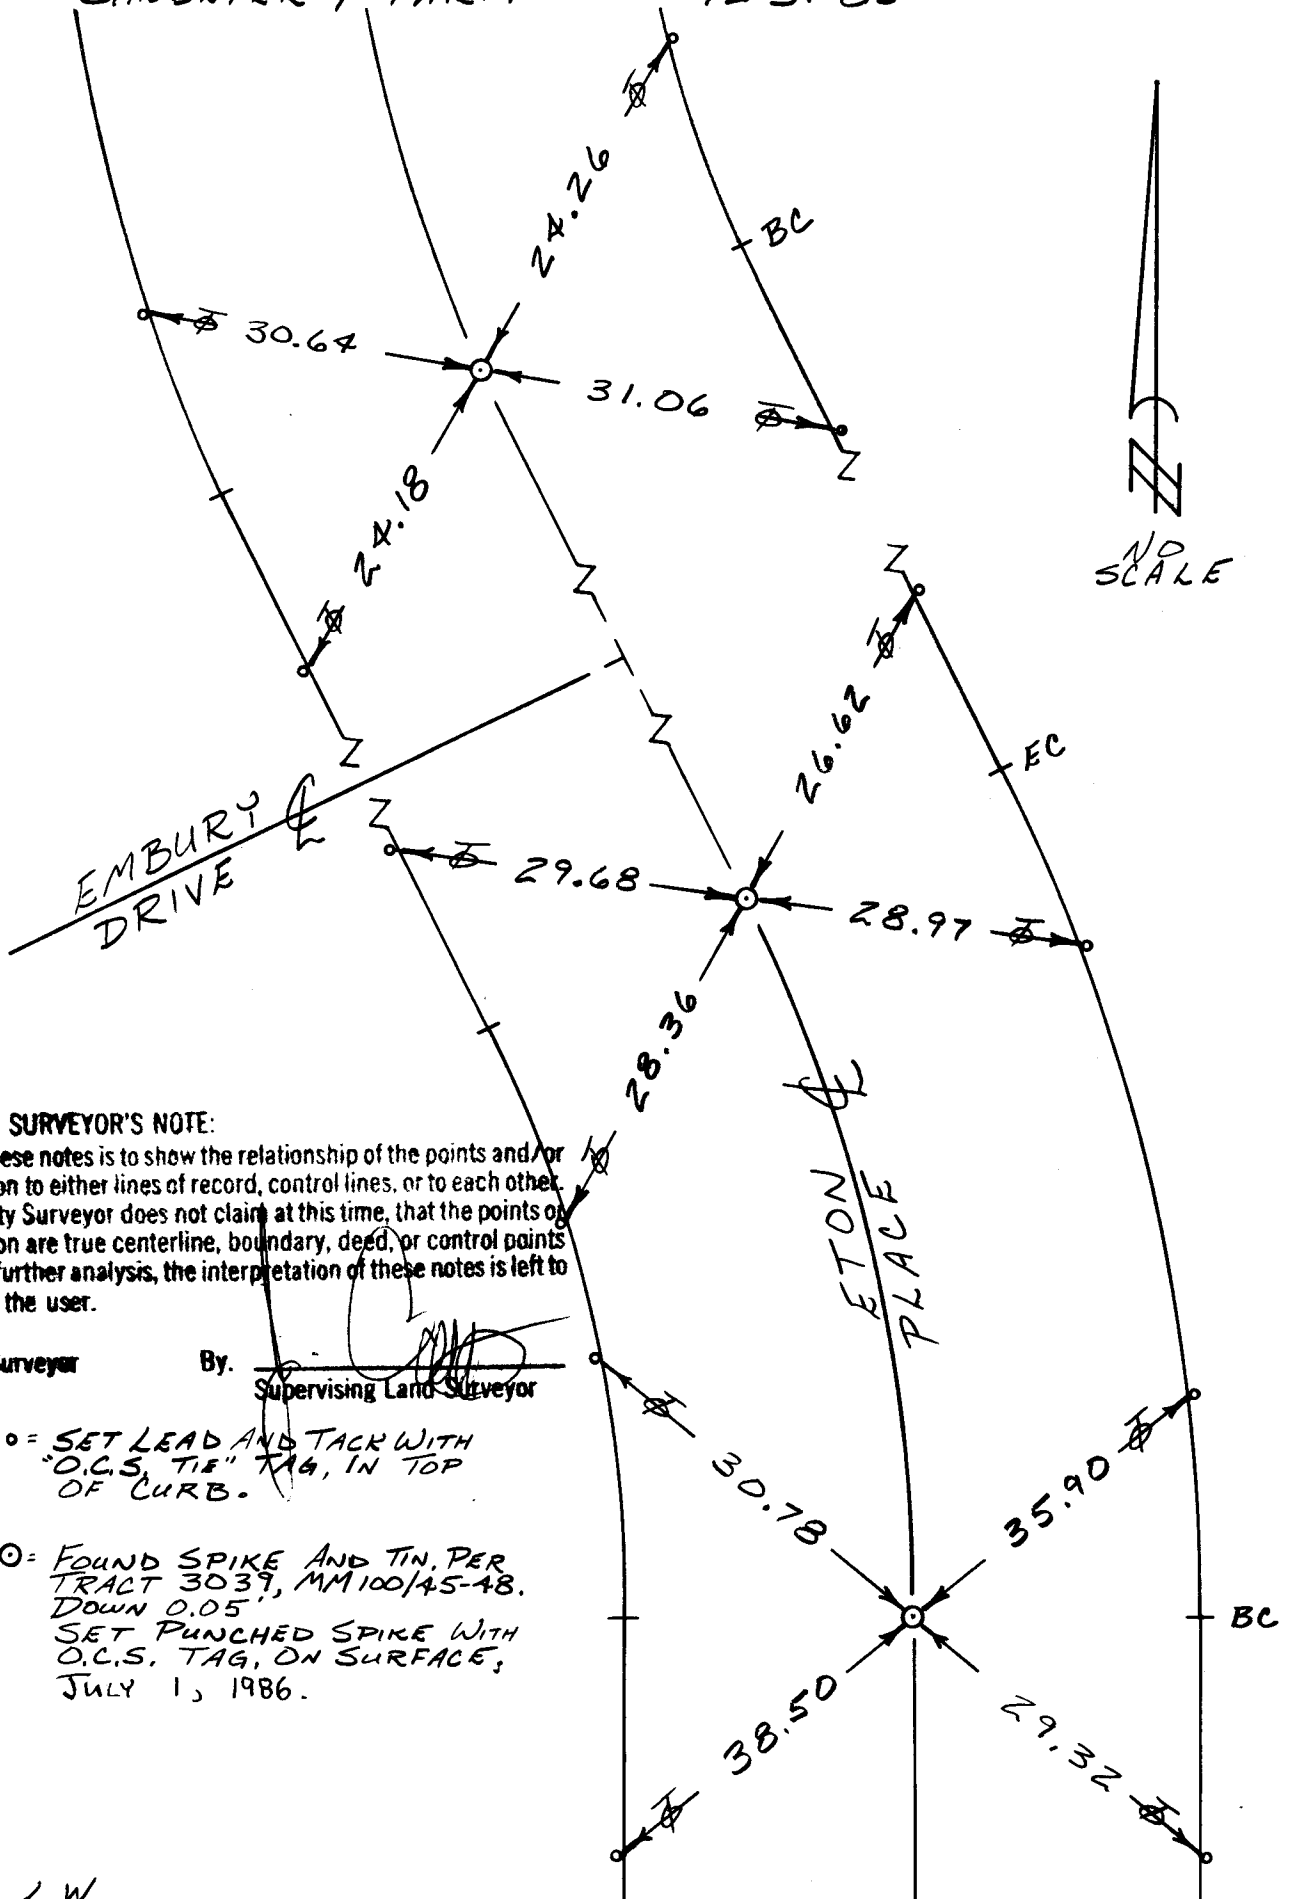

DEPUTY COUNTY SURVEYOR'S NOTE:

The purpose of these notes is to show the relationship of the points and/or lines shown hereon to either lines of record, control lines, or to each other. The Deputy County Surveyor does not claim at this time, that the points of lines shown hereon are true centerline, boundary, deed, or control points or lines. Without further analysis, the interpretation of these notes is left to the discretion of the user.

G.K. Shallen
Deputy County Surveyor

By.
Supervising Land Surveyor

○ = SET LEAD AND TACK WITH
"O.C.S. TIE" TAG, IN TOP
OF CURB.

○ = FOUND SPIKE AND TIN, PER
TRACT 3039, MM100/45-48.
DOWN 0.05'.
SET PUNCHED SPIKE WITH
O.C.S. TAG, ON SURFACE;
JULY 1, 1986.

L.W.

TIES - RESURFACING AREA "C"

4 OF 10

SANDEFER & PARTY

12-31-85

DEPUTY COUNTY SURVEYOR'S NOTE:


The purpose of these notes is to show the relationship of the points and/or lines shown hereon to either lines of record, control lines, or to each other. The Deputy County Surveyor does not claim at this time, that the points or lines shown hereon are true centerline, boundary, deed, or control points or lines. Without further analysis, the interpretation of these notes is left to the discretion of the user.

G.K. Shelton

Deputy County Surveyor

By.

Supervising Land Surveyor

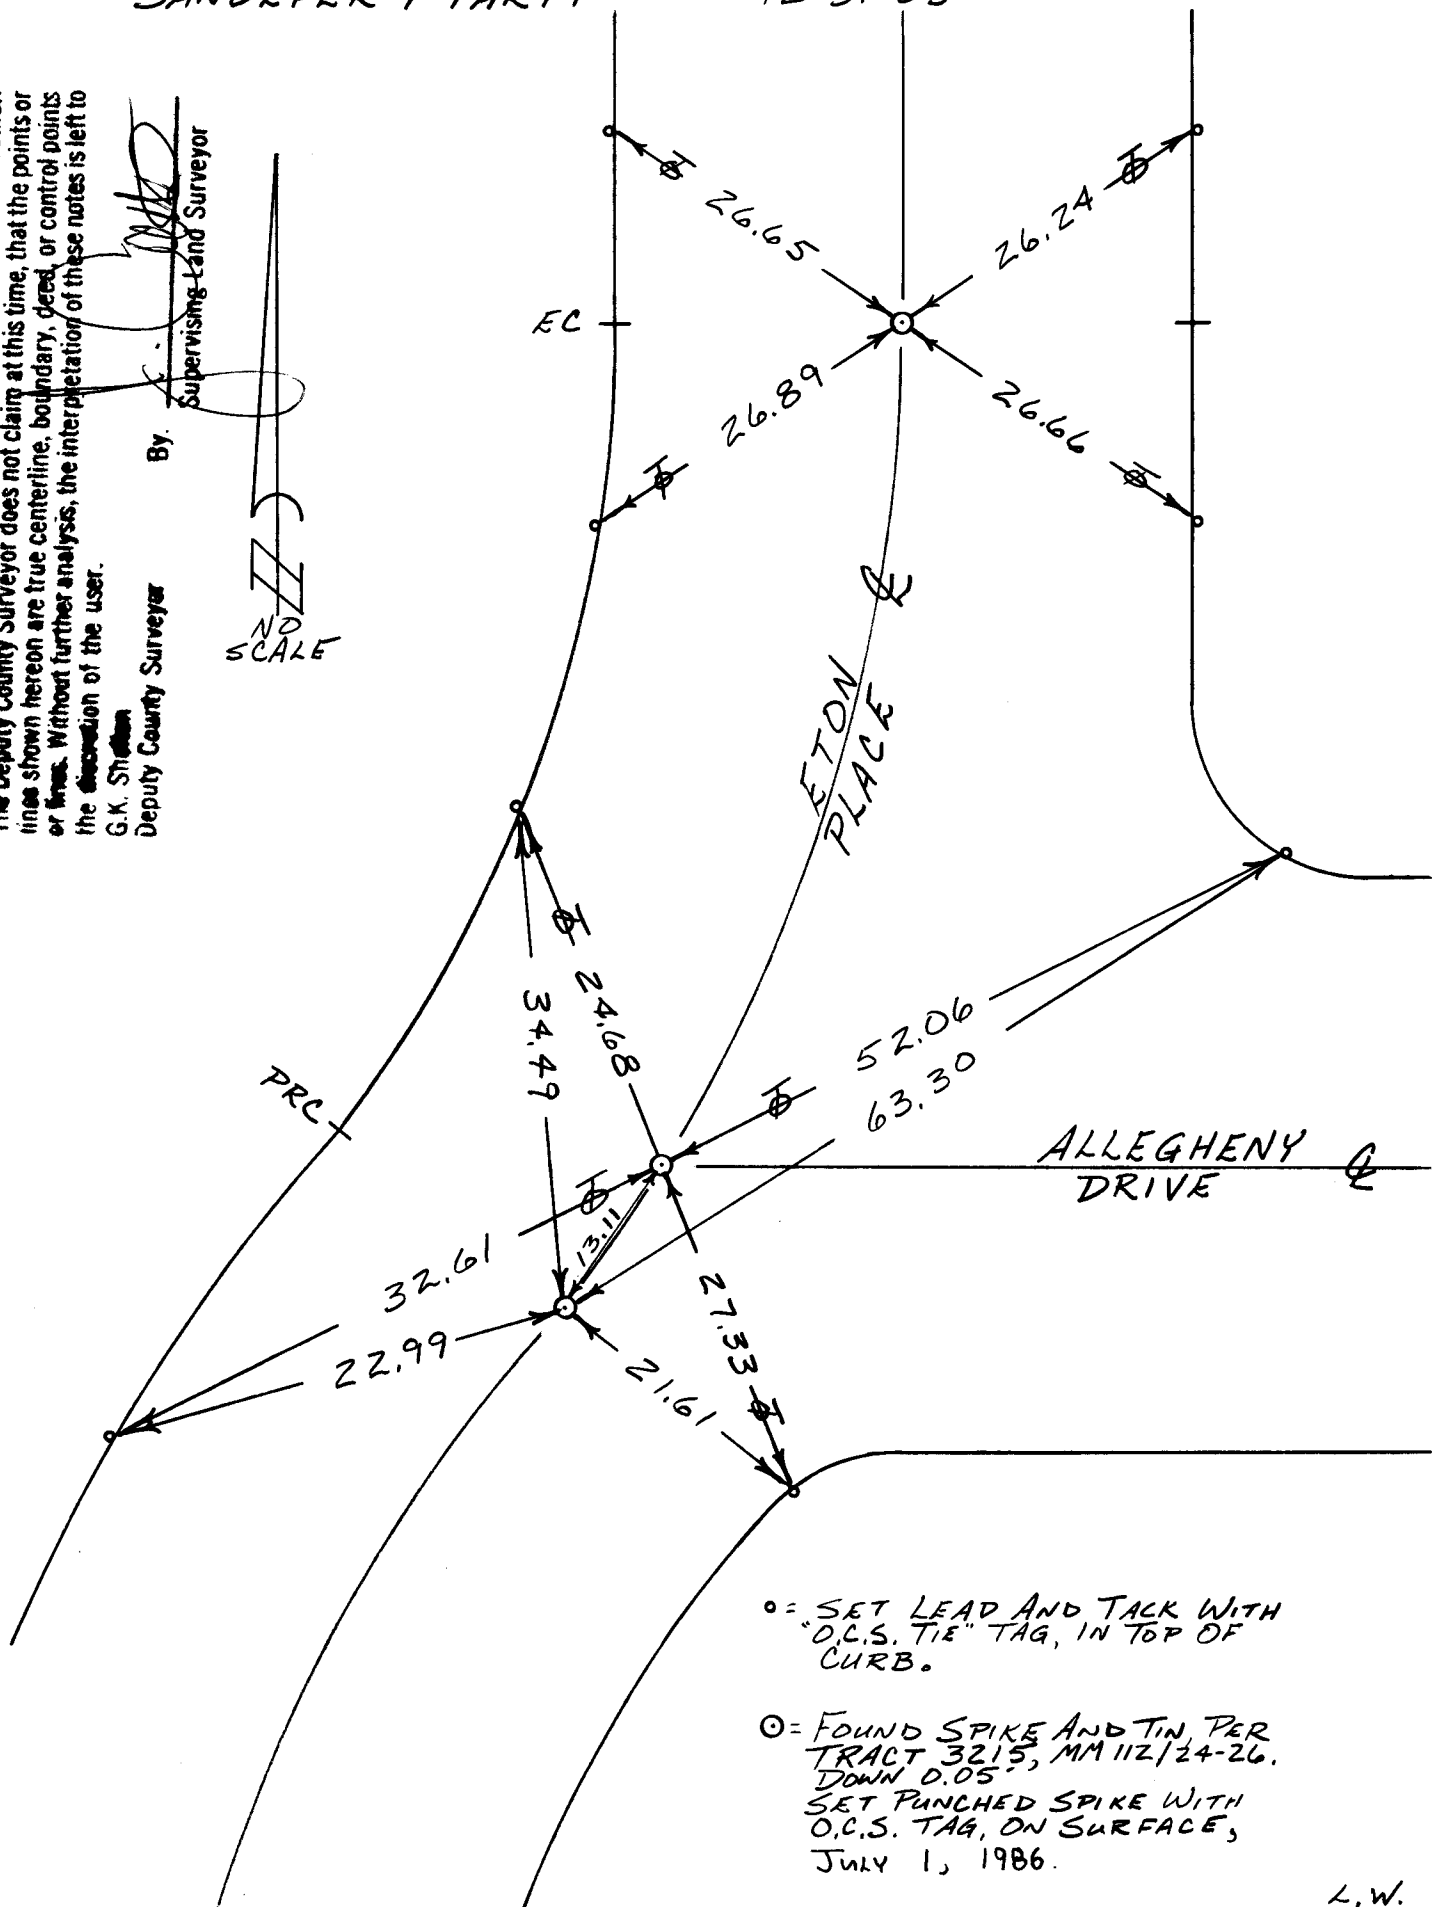NO
SCALE


TIES - RESURFACING, AREA C

A/5-9 914

5 OF 10

SANDEFER 3 PARTY

12-31-85

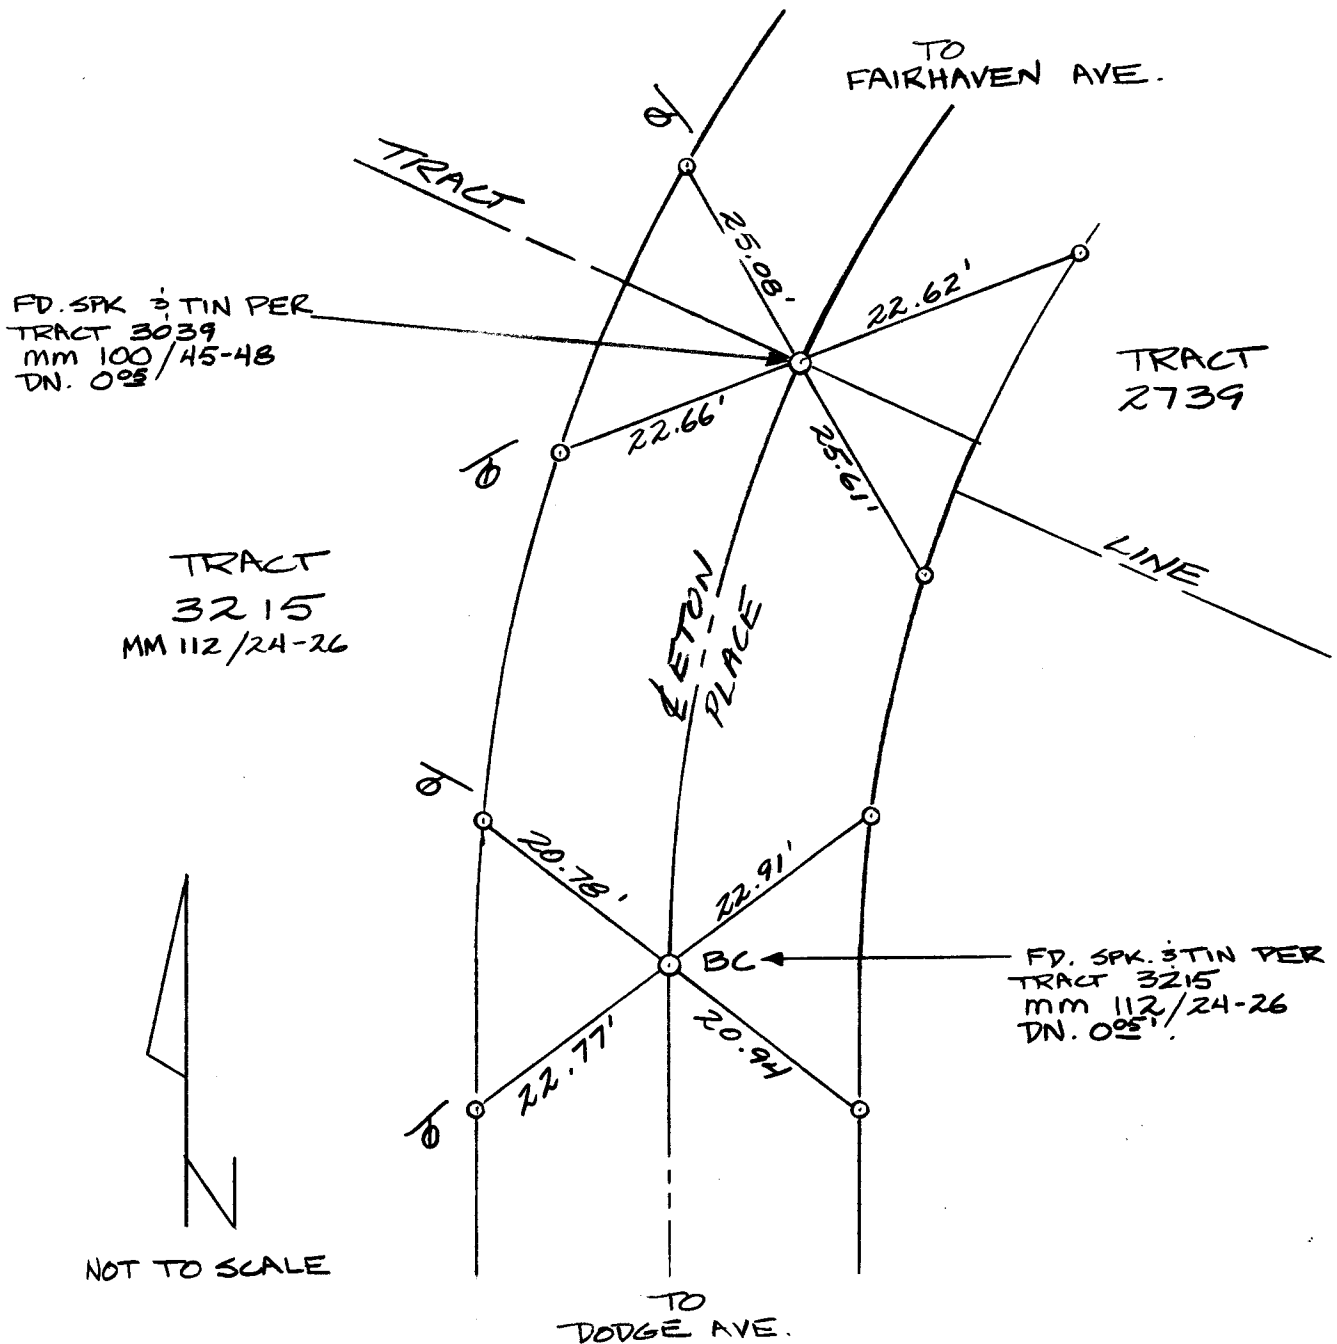

0 SET LEAD 3 TACK W/OCS TIE TAG
IN TOP OF CURB.

0 SET RUN. SPK. W/OCS TAG ON SURF,
JULY 1, 1986.

DEPUTY COUNTY SURVEYOR'S NOTE:

The purpose of these notes is to show the relationship of the points and/or lines shown hereon to either lines of record, control lines, or to each other. The Deputy County Surveyor does not claim at this time, that the points or lines shown hereon are true centerline, boundary, deed, or control points or lines. Without further analysis, the interpretation of these notes is left to the discretion of the user.


G.K. Shelton
Deputy County Surveyor

By Supervising Land Surveyor

HR


TIES - RESURFACING, AREA C

SANDEFER & PARTY

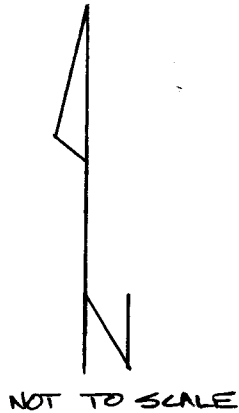

① SET LEAD AND TACK
W/OCS TIE TAG
IN TOP OF CURB

① FD. SPK. & TIN PER
TRACT 3215
MM 112/24-26
DN. 0.65', SET
PUN. SPK. W/OCS TAG
ON SURF, JULY 1, 1986.

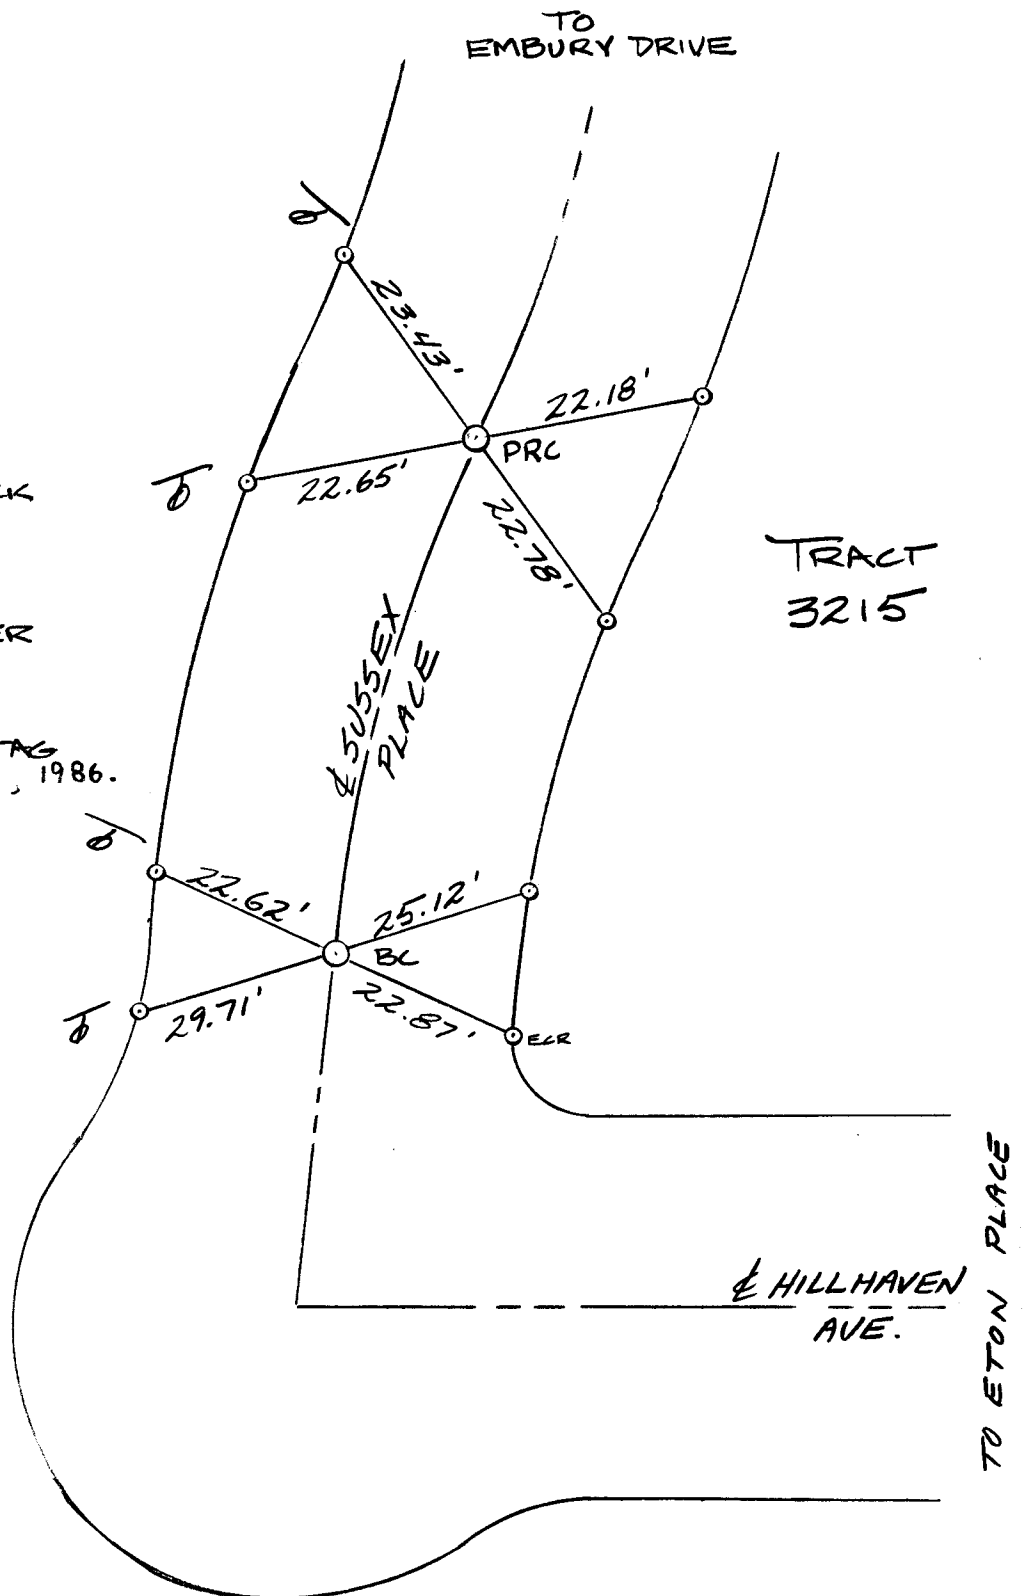

DEPUTY COUNTY SURVEYOR'S NOTE:

The purpose of these notes is to show the relationship of the points and/or lines shown hereon to either lines of record, control lines, or to each other. The Deputy County Surveyor does not claim at this time, that the points or lines shown hereon are true centerline, boundary, deed, or control points or lines. Without further analysis, the interpretation of these notes is left to the discretion of the user.

G.K. Shelton

Deputy County Surveyor

By.

Supervising Land Surveyor

TIES - RESURFACING AREA 'C'


SANDEFER & PARTY

12-31-85

DEPUTY COUNTY SURVEYOR'S NOTE:

The purpose of these notes is to show the relationship of the points and/or lines shown hereon to either lines of record, control lines, or to each other. The Deputy County Surveyor does not claim at this time, that the points or lines shown hereon are true centerline, boundary, deed, or control points or lines. Without further analysis, the interpretation of these notes is left to the discretion of the user.

G.K. Shelton
Deputy County Surveyor

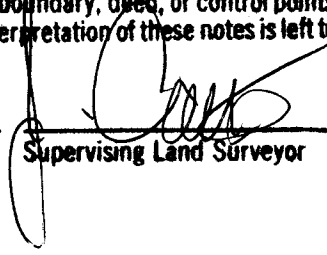
By: 
Supervising Land Surveyor



NO SCALE

- Set Lead & Tack with O.C.S. Tie Tag, in top of Curb.

- FD. Spk & Tin per Tract 3215, M.M. 112/23-25. Down 0.05'. Set Punched Spk w/ O.C.S. Tag on surface, July 1, 1986.

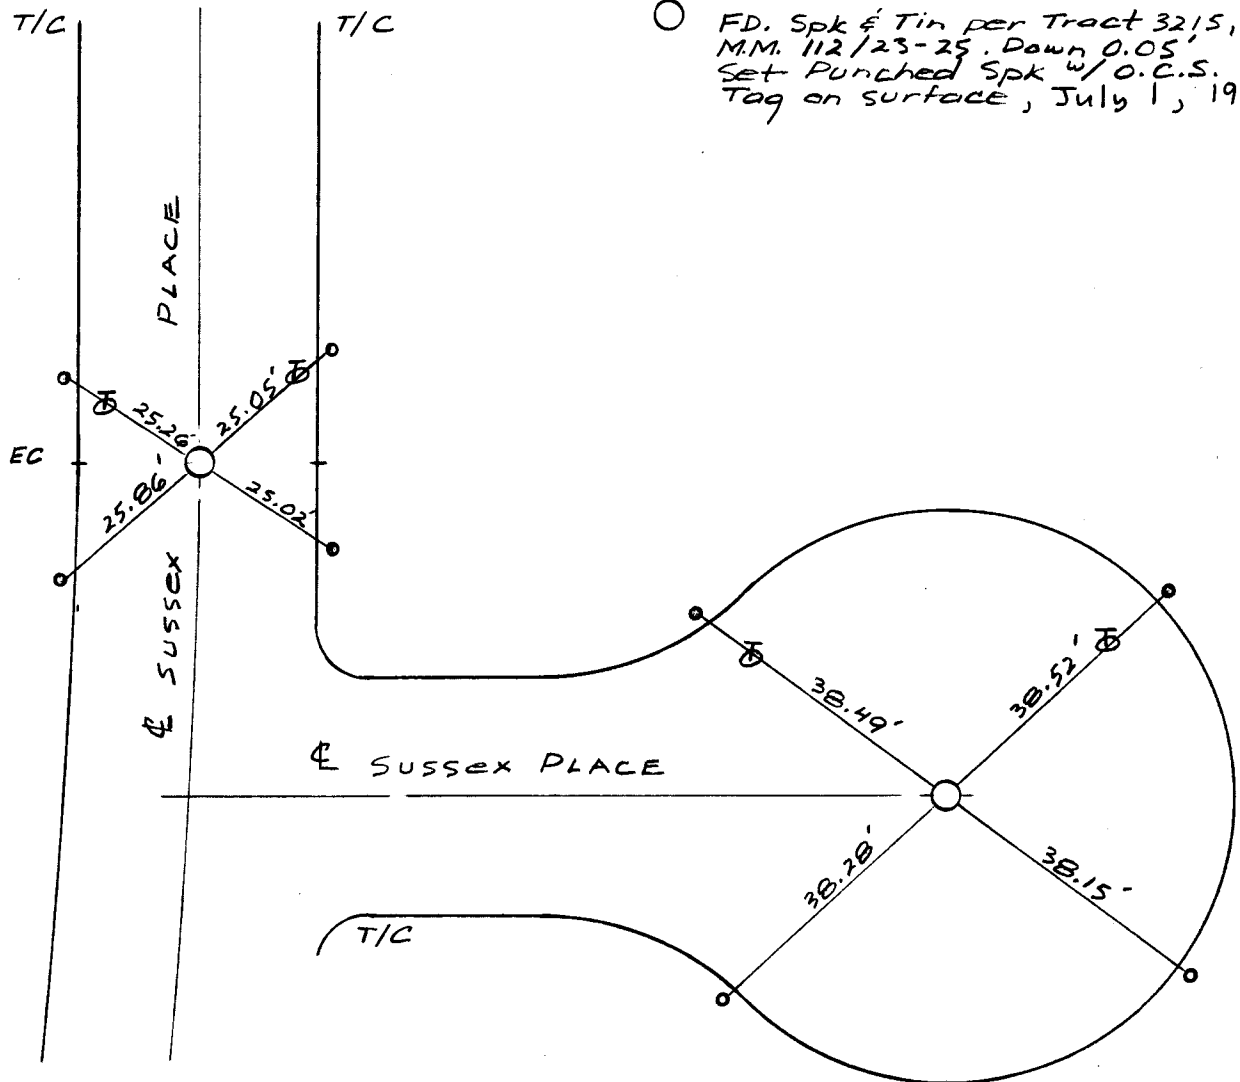

TIES - RESURFACING AREA 'C'


SANDEFER & PARTY

12-31-85

DEPUTY COUNTY SURVEYOR'S NOTE:


The purpose of these notes is to show the relationship of the points and/or lines shown hereon to either lines of record, control lines, or to each other. The Deputy County Surveyor does not claim at this time, that the points and lines shown hereon are true centerline, boundary, deed, or control point or lines. Without further analysis, the interpretation of these notes is left to the discretion of the user.

G.K. Shelton
Deputy County Surveyor

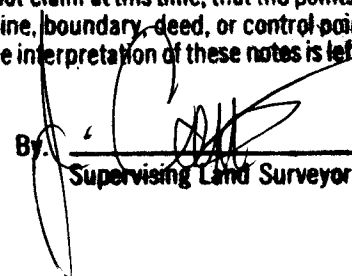By: 
Supervising Land Surveyor



NO SCALE

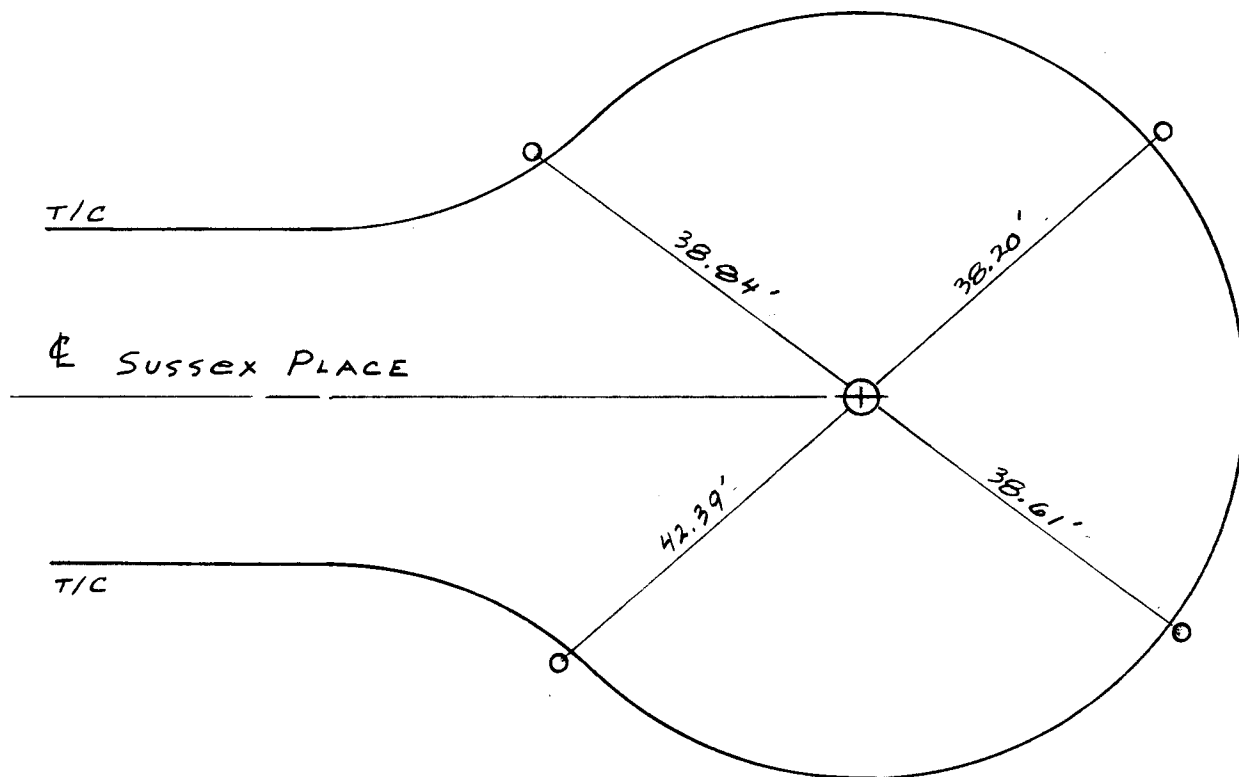

○ Set Lead & Tack with O.C.S. Tie Tag, in top of Curb.

○ F.D. Spk & Tin per Tract 3215, M.M. 112/24-20, Down 0.05'. Set Punched Spk. w/ O.C.S. Tag, on surface, July 1, 1986.

TIES - RESURFACING AREA 'C'


SANDEFER & PARTY

12-31-85

DEPUTY COUNTY SURVEYOR'S NOTE:

The purpose of these notes is to show the relationship of the points and/or lines shown hereon to either lines of record, control lines, or to each other. The Deputy County Surveyor does not claim at this time, that the points or lines shown hereon are true centerline, boundary, deed, or control points or lines. Without further analysis, the interpretation of these notes is left to the discretion of the user.


G.K. Shelton
Deputy County Surveyor

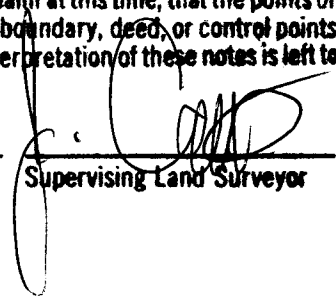By: 
Supervising Land Surveyor



NO SCALE

TRACT 3039

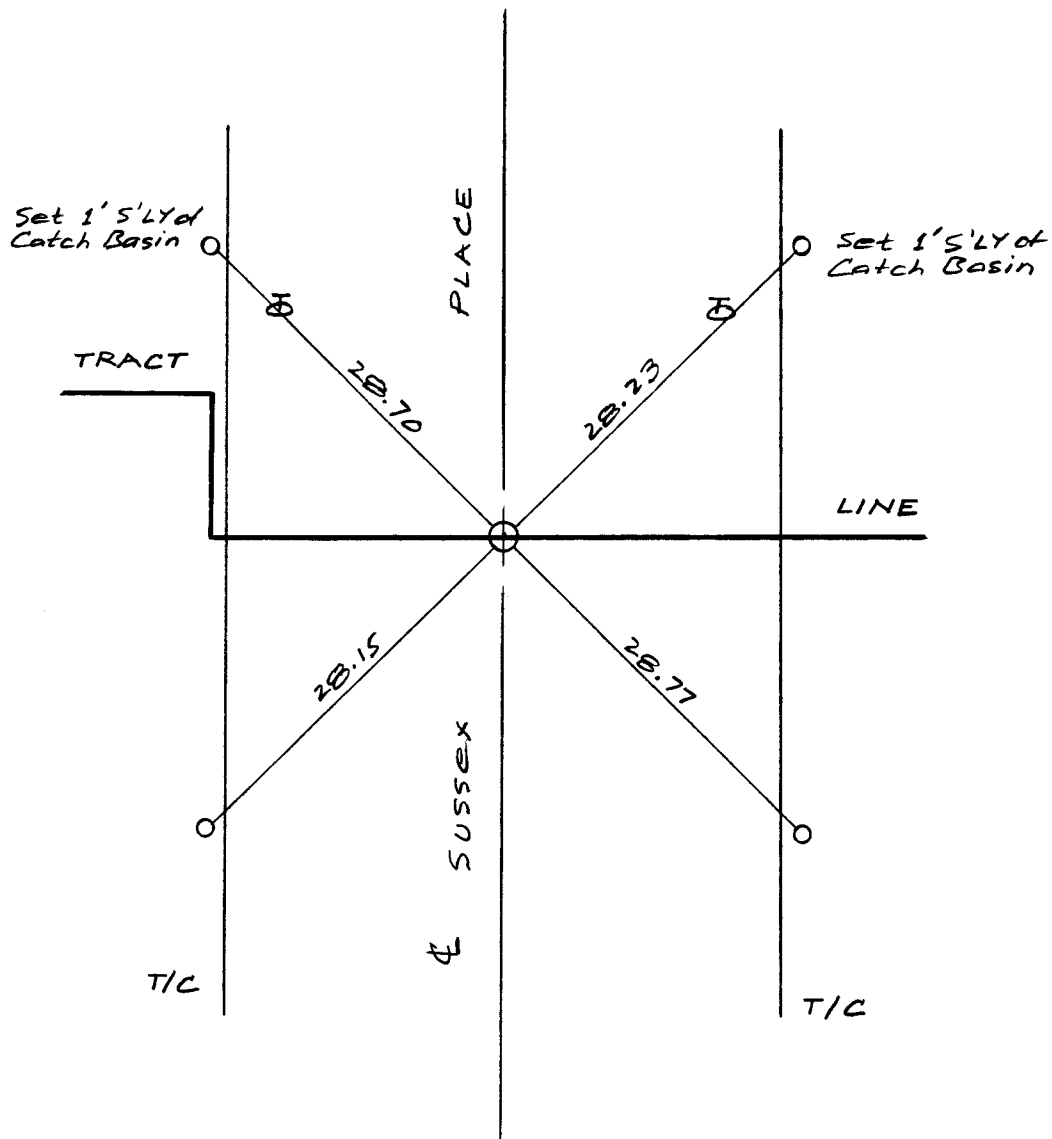

TRACT 3215


- Set Lead & Tack with O.C.S. Tie Tag, in top of curb.
- Fd. Spk & Tin per Tract 3039, M.M. 100/45-48, Down 0.05'. Set punched spk w/ O.C.S. Tag on surface, July 1, 1986.

RESURFACING AREA 'C'

SANDEFER & PTY

A/5-9 919
10 OF 10


12-31-85

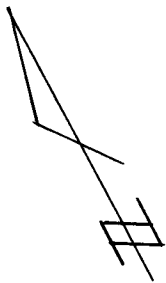

NO SCALE

● = F.D. O.C.S. WELL
110N. W/PUN.
2" DIA. ALUM.
DISC. RCE
20106' ON
12' NO REF.

• = F.D. LEAD &
TACK IN
T/C. O.S.
BEFORE
CURB RETURN
UNLESS
NOTED

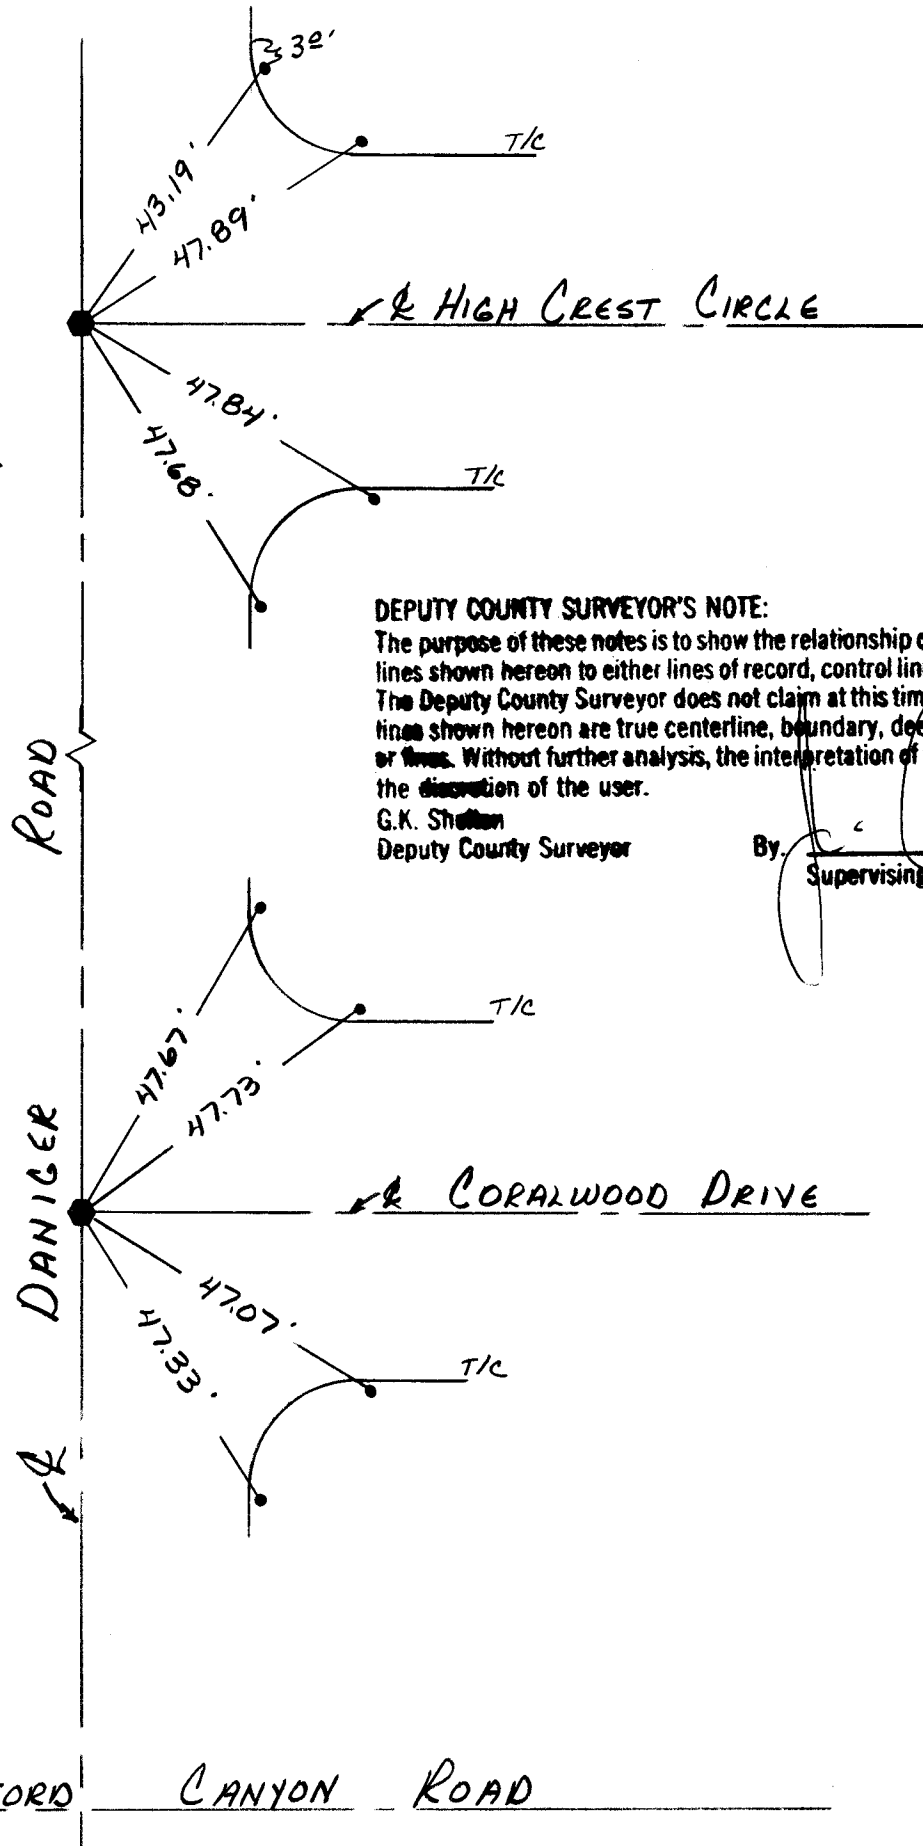

DEPUTY COUNTY SURVEYOR'S NOTE:

The purpose of these notes is to show the relationship of the points and/or lines shown hereon to either lines of record, control lines, or to each other. The Deputy County Surveyor does not claim at this time, that the points or lines shown hereon are true centerline, boundary, deed, or control points or lines. Without further analysis, the interpretation of these notes is left to the discretion of the user.

G.K. Shelton
Deputy County Surveyor

By:
Supervising Land Surveyor