

ETIES - TR-9669


A/5-9

877
10F2

WILLIAM E. BLAKELY L.S. 4279

11-27-78

JN 502-0101

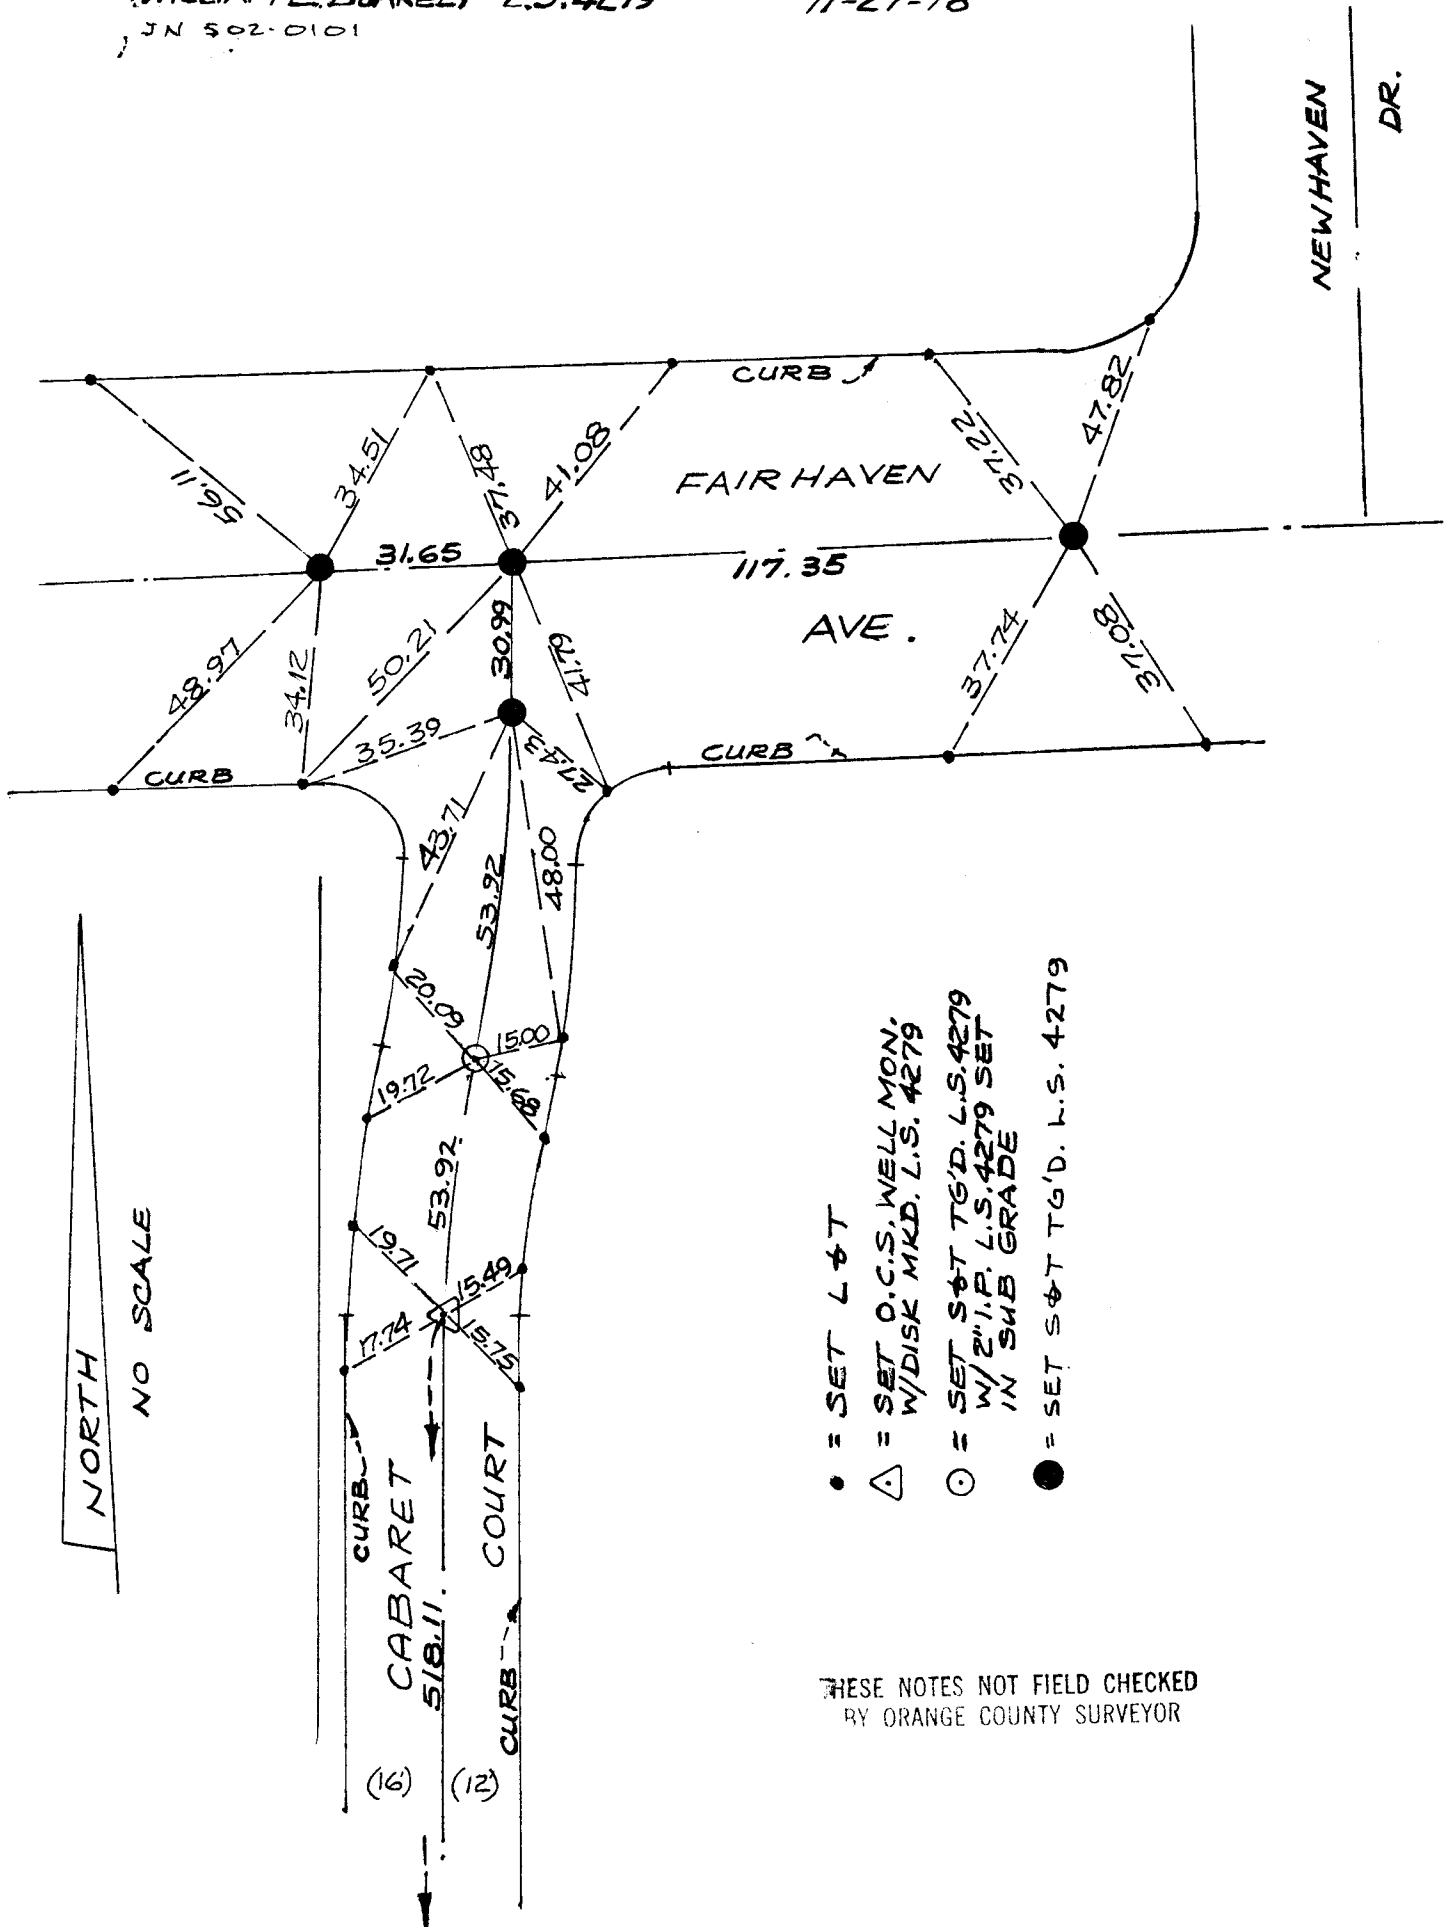

THESE NOTES NOT FIELD CHECKED
BY ORANGE COUNTY SURVEYOR

ETIES - TR. 9669


A/5-9

878
2 OF 2

WILLIAM.E. BLAKELY, L.S. 4279

11-27-78

JN 502-0101

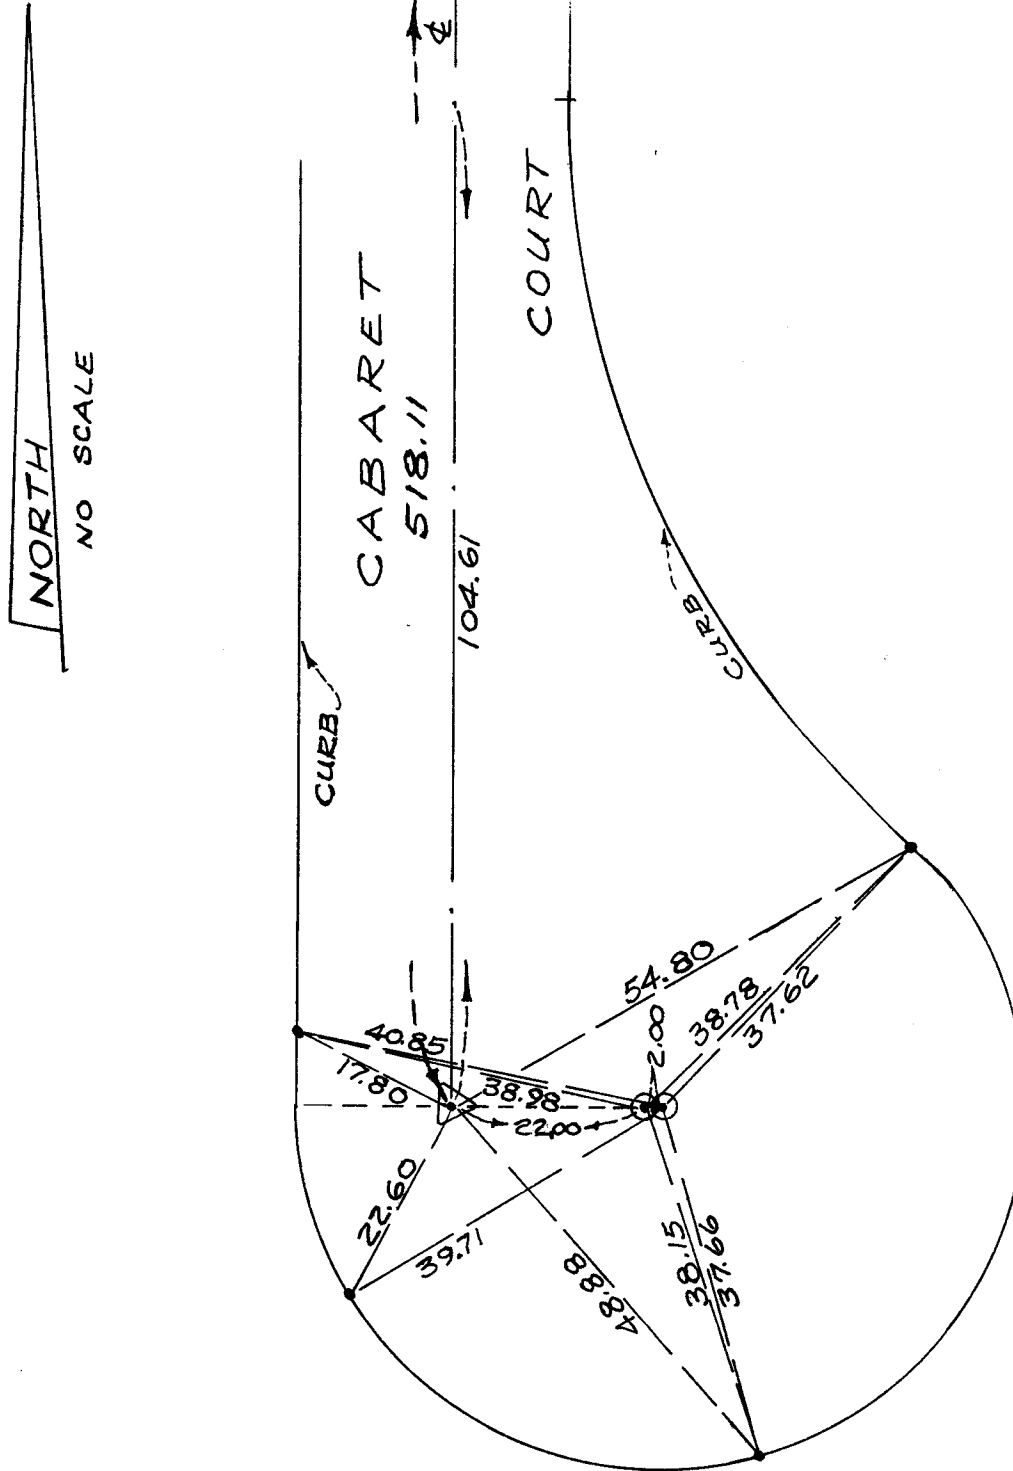

- = SET L&T
- ▽ = SET O.C.S. WELL MON. w/DISK MKD, L.S. 4279
- ⊙ = SET SET TGT T.G'D, L.S. 4279 w/2" I.P., L.S. 4279, SET IN SUBGRADE

THESE NOTES NOT FIELD CHECKED
BY ORANGE COUNTY SURVEYOR