

THESE NOTES NOT FIELD CHECKED
BY ORANGE COUNTY SURVEYOR

THESE NOTES NOT FIELD CHECKED
BY ORANGE COUNTY SURVEYOR


SEE BOOK A15-9 PAGE 219-230
DATE 4-21-61 BY L.E.

ORANGE COUNTY SURVEYOR

DATE_

CHECKED BY:

2M 3.57

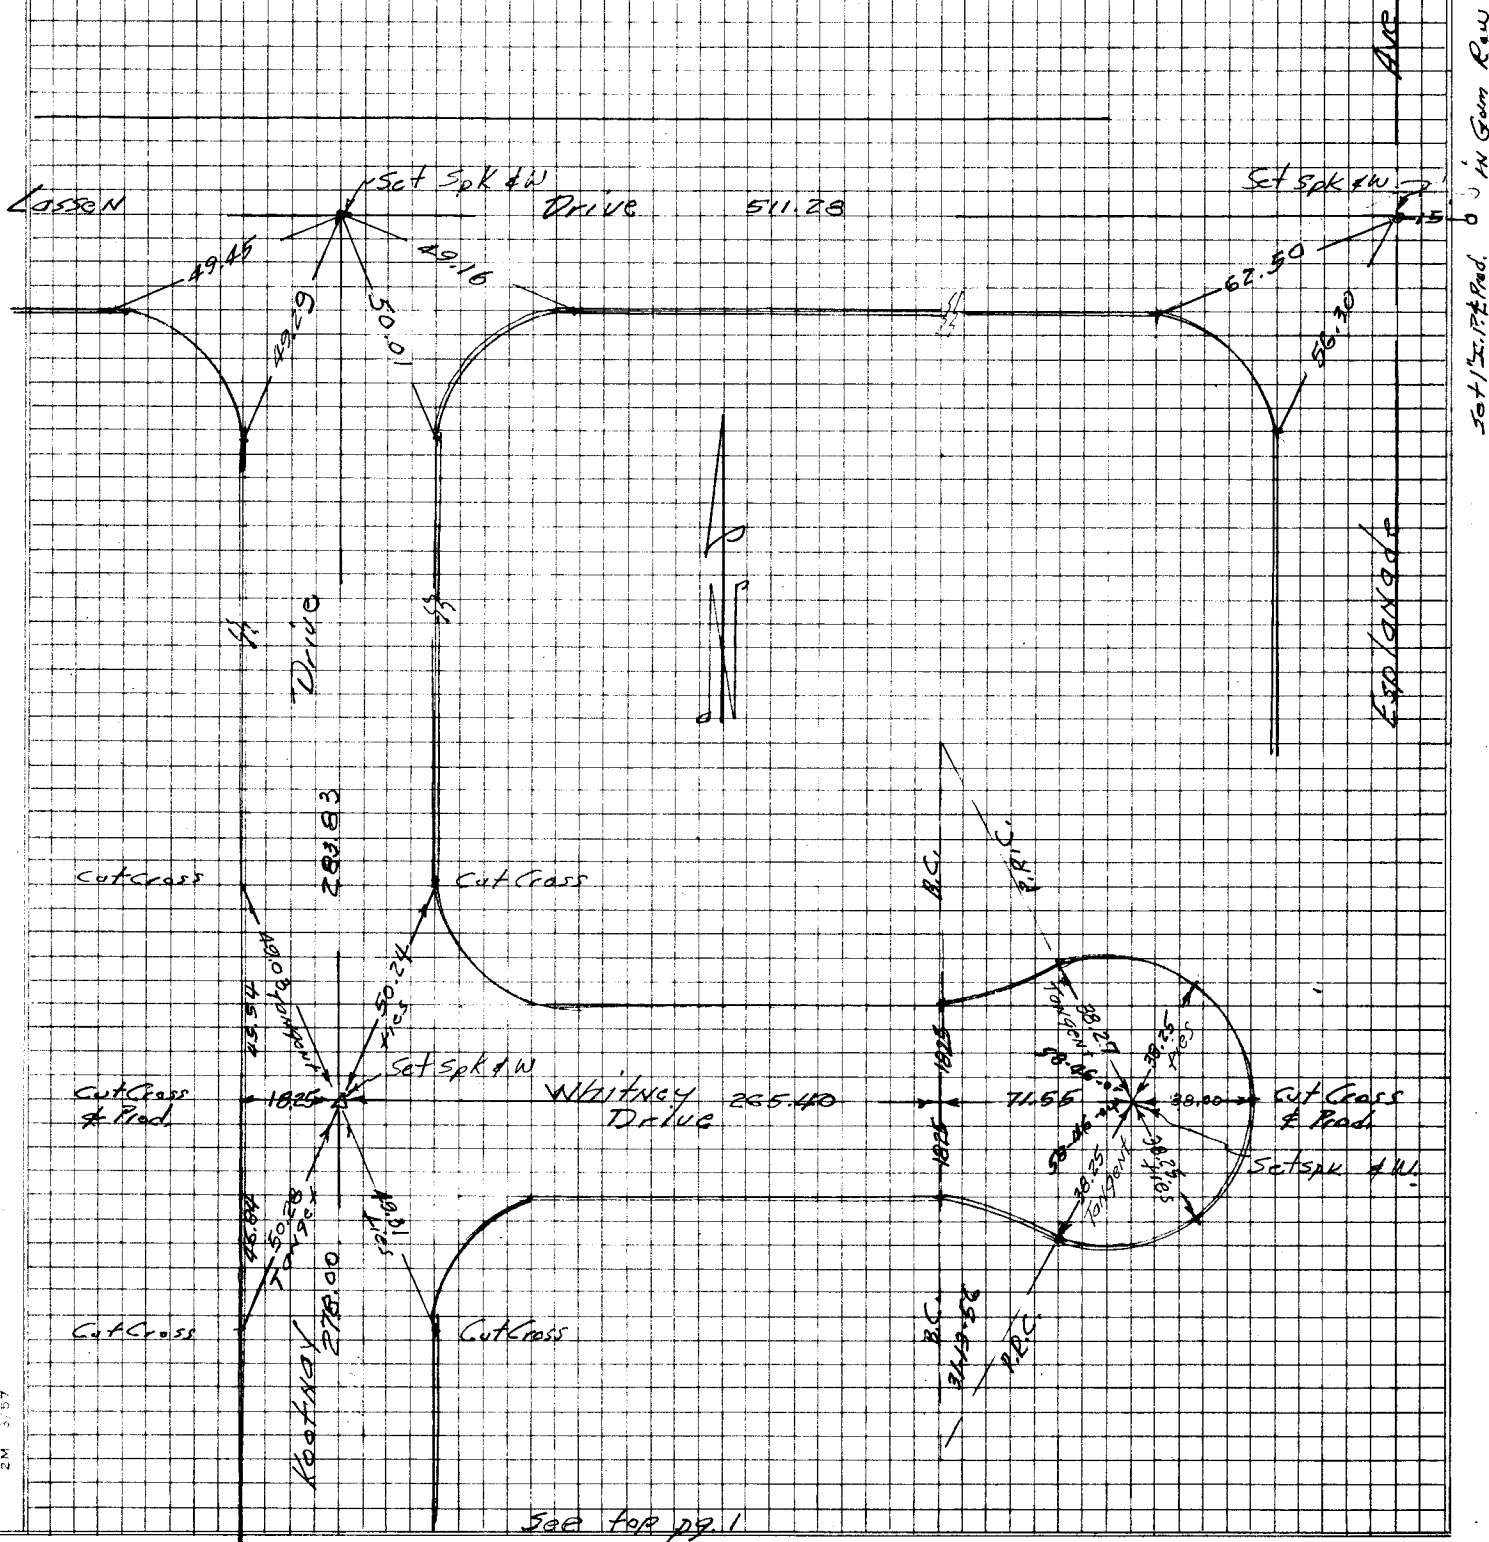

RECEIVED FROM D.D. HILLYARD 9/60


THESE NOTES NOT FIELD CHECKED
BY ORANGE COUNTY SURVEYORTHESE NOTES NOT FIELD CHECKED
BY ORANGE COUNTY SURVEYOR

ORANGE COUNTY SURVEYOR

DATE

CHECKED BY

2M 3.57

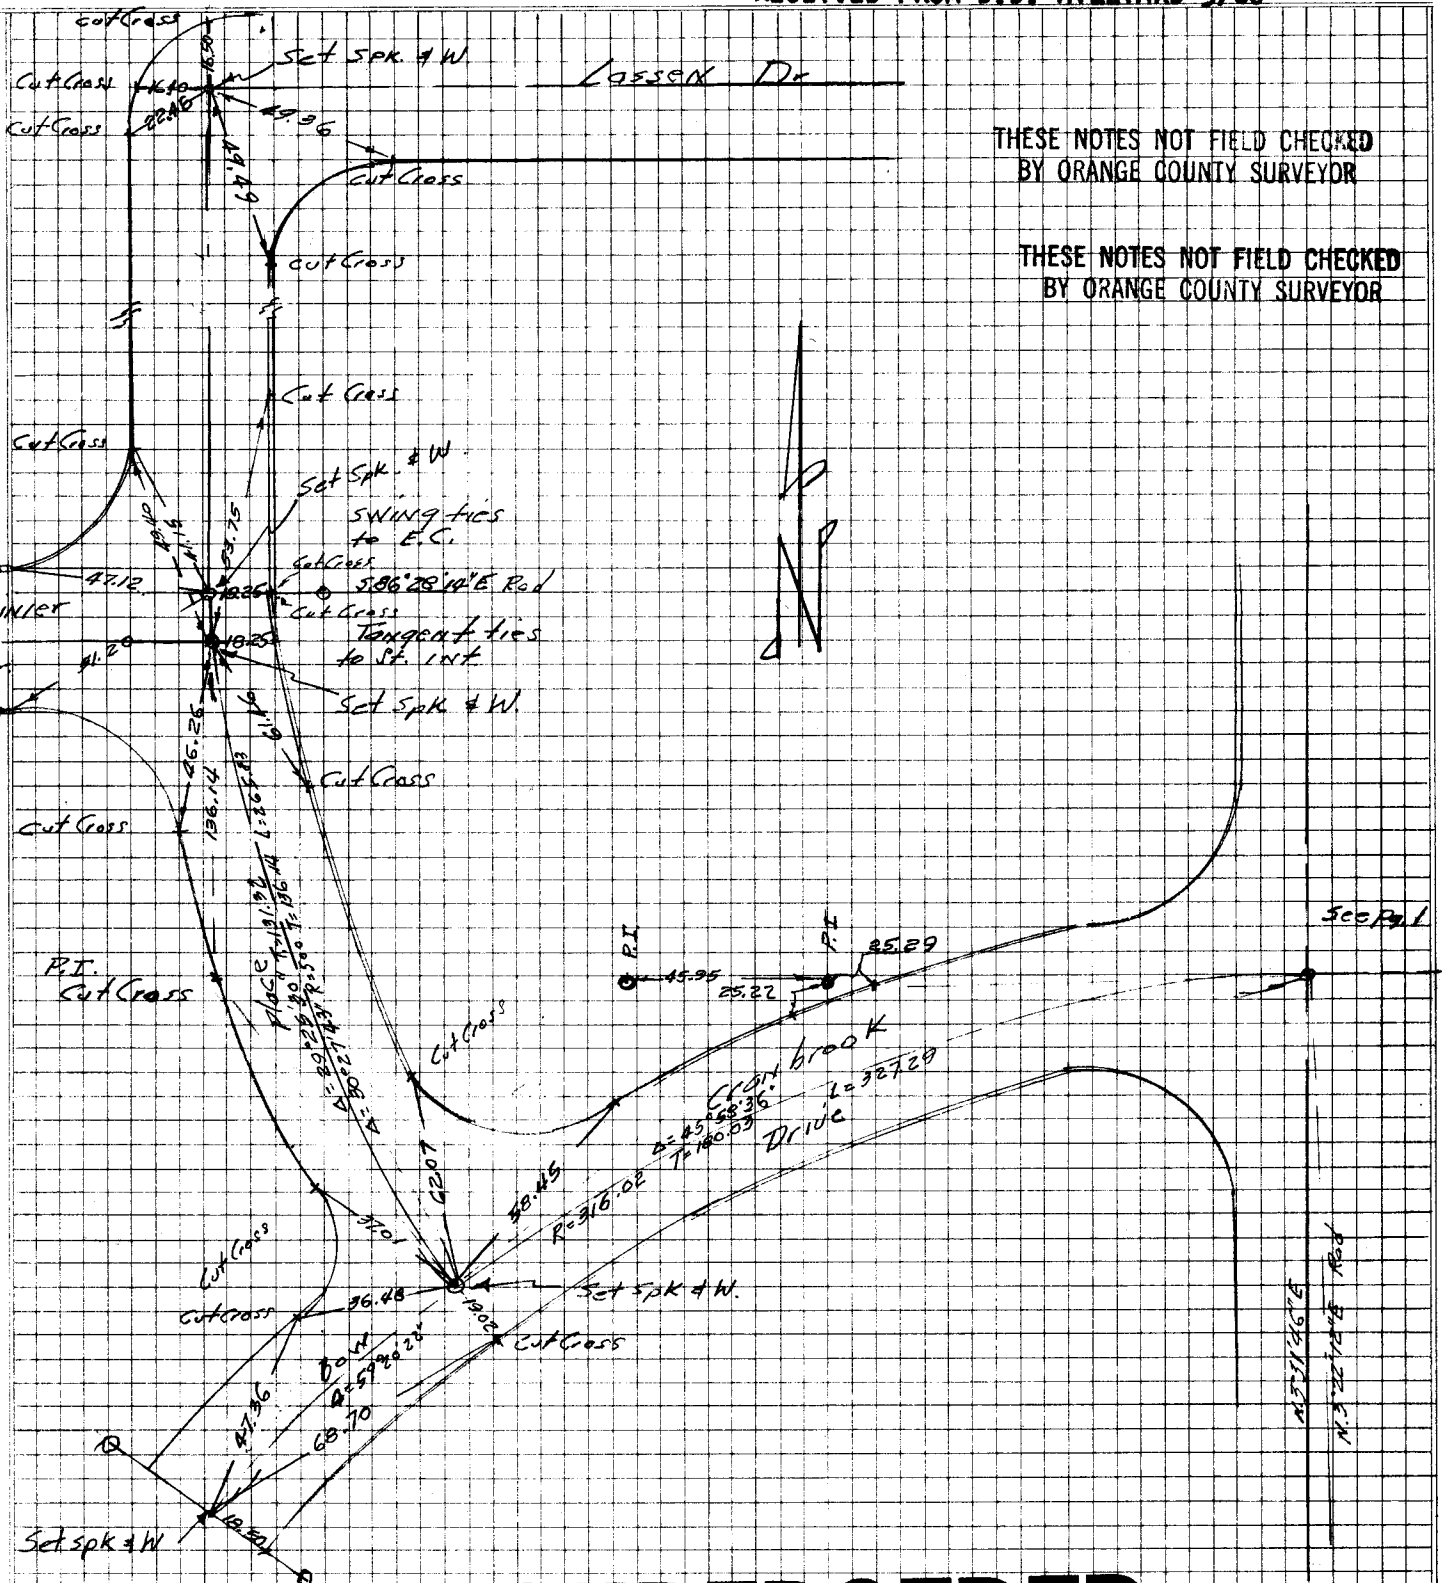**SUPERSEDED**SEE BOOK A/5-9PAGE 219-230DATE 4-21-61BY L.E.

RECEIVED FROM D.D. HILLYARD 9/60

THESE NOTES NOT FIELD CHECKED
BY ORANGE COUNTY SURVEYOR


**THESE NOTES NOT FIELD CHECKED
BY ORANGE COUNTY SURVEYOR**

ORANGE COUNTY SURVEYOR

DATE...

CHECKED BY:

2M 3.57

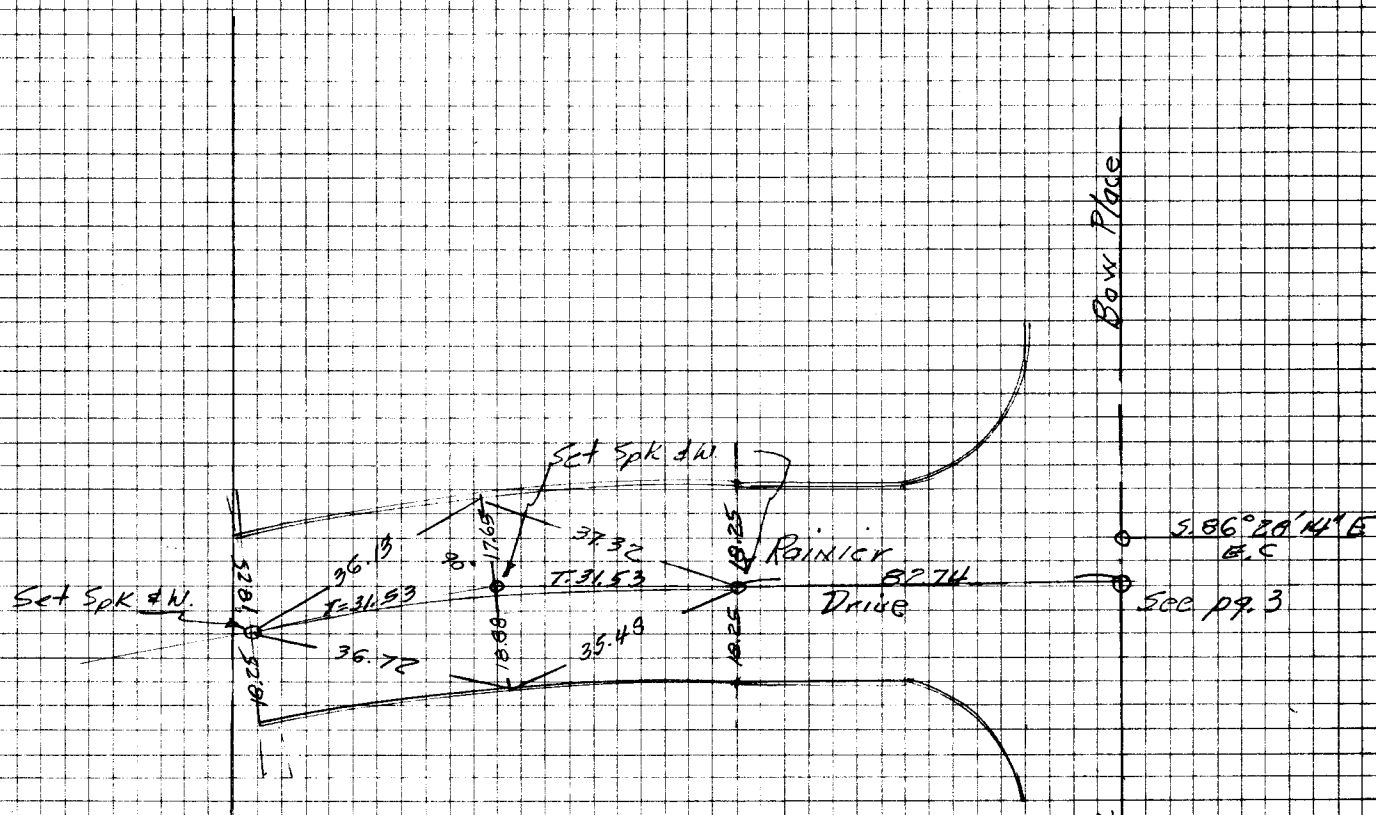

SUPERSEDED

SEE BOOK A/5-9 PAGE 219-230
DATE 7-21-61 BY SS.