
COR	NF	RRE	CO	RN	Agency I	ndex				
					Documer	nt Nur	nber	_CR 20	22-0385	
ity of UN	INCORI	PORATED TER	RITORY		County o	of _	ORANG	GE		, California
rief Legal Des	scription	ALONG LA AT THE E'I	Y COR OF COR	<u>' THE NW'L</u> NER TYPE	Y 1/2 OF		332, BL		<u>'HE IRVII</u> IATES (Op	NE SUB otional)
		Governme	nt Corner	☐ Control ☐ Property	, ι	Units		_		ırvey Foot 🔀
		Rancho Date of Survey_	01-19-2	⊠ Other 2022	2	Zone		Epoch	Date	
						Compli	es with P	ublic Resou	ırces Code	§§8801-8819 §§8890-8902
LS Act Ref:	□ 876	5(d)	X 8771		□ 8773	3			Other:	
Corner/ Monument:		as found nd and tagged	☐ Estab		☐ Reb		ed		Pre-Cons Post-Con	
SECTION 8771. RIGHT OF WAY, FOR GRAPHICAL BEARINGS SHOW MEASURED DISTRIBUTION OR GROUND, A This Corn the Profes	NO CLAI , PARCEL L REPRES WN HERE TANCES S NCES SHO IS PER S DIET RECOI	SURV rd was prepared and Surveyors' **Roy Maci	TO THE RELATION AND ARE ARE GRID DE AS THEY EYOR'S STEED BY THE ARE OR LEAS THEY Act on	ATIONSHIP OITHER DATA F DISPLAYED ISTANCES. TO APPEAR ON TATEMENT under my dir	F THE POIL RELATED T FOR ANGLE O OBTAIN THE DOCL ection in C -2022 or R.C.E	NTS S O DEL JLAR F A GRO JMENT	HOWN HINEATION RELATION OUND DIS OF REC	EREON TO N OF PROP ISHIP ONLY STANCE, MI	TRUE BOUI ERTY RIGHT	STAND SUPLOS OF CALIFOR
This Corn	ier Reco	rd was received			17, 202	22			/AS	LIN R. HILL
n 1 (1)					MENT h 17, 2022 23, 2022 S.)or R.C.E. No. 6617					NIN R. HILLO
Title	C	OUNTY SURVEY	OR		,				(STAN	NO. 6617 OF CALIFORN
County Su	urveyor's	Comment								

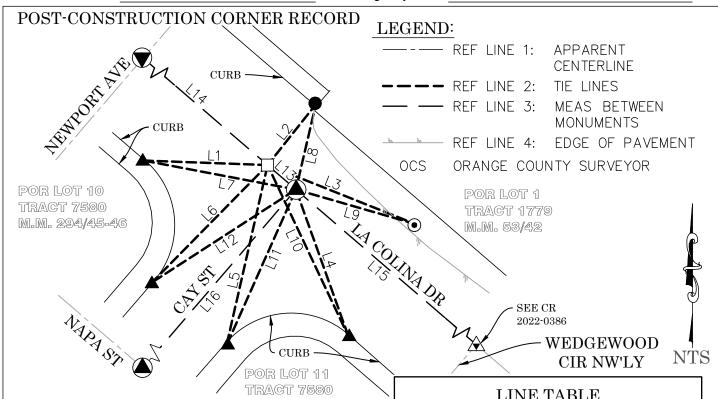

M.M. 294/45-46

RECORD REFERENCES:

R1 CORNER RECORD 2021-1724

R2 TRACT 7580, MM 294/45-46

R3 OCS A/NE-IRV/1179-1183 (PG 1181)

R4 OCS A/5-9/541-587 (PG 579)

MONUMENT NOTES:

- ALTHOUGH A MAGNETIC SOUND WAS DETECTED, THE MON FOUND DN 0.45' PER R1 WAS NOT EXPOSED AND VERIFIED; SET SPIKE & 1-1/2" SS WSHR STMPD "OCS", FLUSH IN AC, PER TIES SHOWN HEREON
-) FD MON WELL WITH BR NAIL & 3/4" BR TAG STMPD "LS 3419" SET IN CONC, PER R2, DN 1.6
- (T) FD MON WELL WITH PUN HEX BAR, PER R4, DN 2.0'
- FD RAMSET NAIL ON TOP OF CONC CURB, PER R3; REPLACED WITH 3/4" BR TAG STMPD "OCS TIE"
- FD LEAD & 3/4" BR TAG STMPD "OCS TIE" ON TOP OF CONC CURB, PER R1
- FD 1" IP WITH CONC PLUG & 3/4" BR TAG STMPD "OCS TIE", PER R1, DN 0.3' IN DIRT
- A FD MON AS DESCRIBED ON ADJACENT CORNER RECORD

	LINE TABLE							
LINE #	MEAS & REC BEARING	MEAS & REC DISTANCE	REF					
L1	N87°55'06"W	51.72'	R1					
L2	N38°27'54"E	32.28'	R1					
L3	N68°14'29"W	66.26	R1					
L4	N19°41'13"W	65.23'	R1					
L5	N12°50'55"E	77.02'	R1					
L6	N44°34'51"E	68.66'	R1					
L7	N79°13'59"W	64.62'	R1					
L8	N13°08'52"E	36.42'	R1					
L9	N73°53'16"W	51.78'	R1					
L10	N25°14'49"W	79.17'	R1					
L11	N24°01'08"E	71.06'	R1					
L12	N57°09'57"E	71.39'	R1					
L13	N49°09'51"W	15.59'	R1					
L14	N49°18'52"W	660.90'	R1					
L15	N49°18'29"W	153.48'	R1					
L16	N40°38'53"E	181.99'	R1					