

ORANGE COUNTY SURVEYOR SURVEY NOTES

A/5-9 1099

ALIGNMENT INDEX BOOK AND PAGE

ALIGNMENT NOTES PG. 1 OF 3

PPB _____ WORK ORDER NUMBER R38001410

SURVEY NOTES PAGE _____ OF _____

SURVEY COMPLETION DATE 10-19-89

SURVEY FILE NUMBER R 89-56

PROJECT NAME PROSPECT AVE.

SURVEY LIMITS WHITNEY DR. NORTH TO FAIRHAVEN

PURPOSE OF SURVEY TO FLAG R/W ON PROSPECT AVE.

THOMAS BROS.:

BLOCK AND MODULES:

PG 17 F5

BLOCK 5852

MOD 73 & 83

SURVEY NOTE PAGE INDEX:

EQUIPMENT:

PERSONNEL:

ALIGNMENT PG. 2

TOPCON

ET 1

SCHUMAKER P.C.

McCONNELLEE INST.

ELGEUSON R.C.

DEPUTY COUNTY SURVEYOR'S NOTE:

The purpose of these notes is to show the relationship of the points and/or lines shown hereon to either lines of record, control lines, or to each other. The Deputy County Surveyor does not claim at this time, that the points or lines shown hereon are true centerline, boundary, deed, or control points or lines. Without further analysis, the interpretation of these notes is left to the discretion of the user.

John Canas

Deputy County Surveyor

By: Sean Toomey

Supervising Land Surveyor

REFERENCES/REMARKS:


TR# 5913 MM 241/35

TR# 1605 MM 47/31 & 32

TR# 3574 M.M. 138 43 44 45

TR# 3873 MM 139-33.34

A/5-9, 1074-1080 (R80-53)

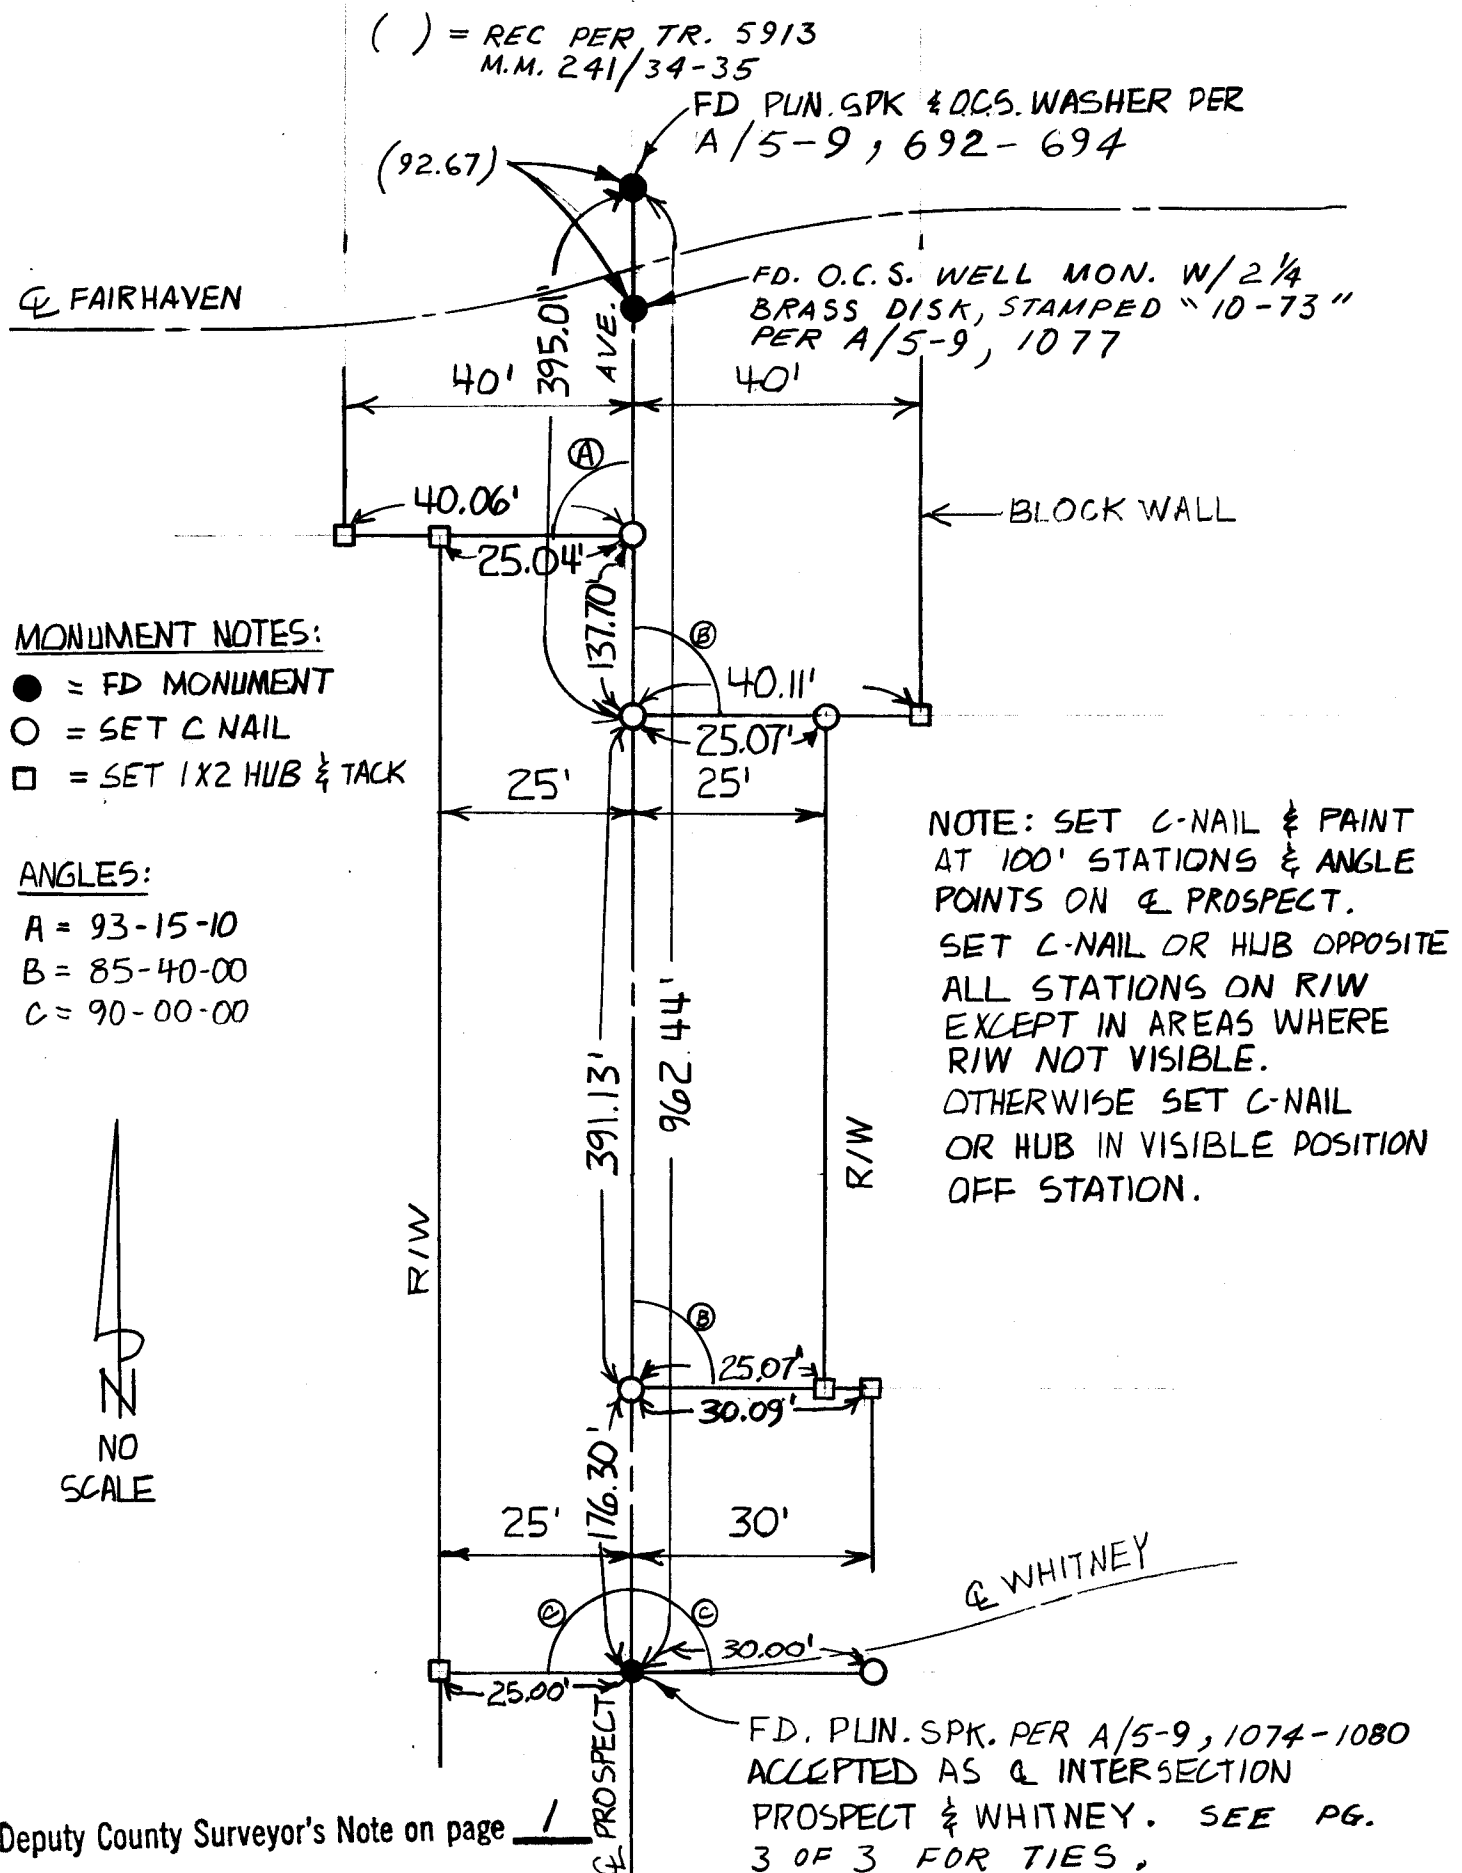

SCHUMAKER

10-19-89

() = REC. PER O.C.S.
A/5-9, 1079

