

ORANGE COUNTY SURVEYOR SURVEY NOTES

A/5-9 1081

ALIGNMENT INDEX BOOK AND PAGE

ALIGNMENT NOTES PG. ____ OF ____

PPB ____ WORK ORDER NUMBER R20300434

SURVEY NOTES PAGE 1 OF 13

SURVEY COMPLETION DATE AUGUST 1989

SURVEY FILE NUMBER R89-25 "G"

PROJECT NAME RESURFACING CONTRACT # 3 (88-89)

SURVEY LIMITS (SEE INDEX SHEET)

PURPOSE OF SURVEY TIES TO VARIOUS STREET CONTROL
PRIOR TO RESURFACING

THOMAS BROS.:

BLOCK AND MODULES:

PG. 18 A 5

5852: 53, 55, 56, 57, 63, 65, 66, 67, 68, 75, 76

SURVEY NOTE PAGE INDEX:

EQUIPMENT:

PERSONNEL:

INDEX SHT. 2

TOPCON ET 2

SEHER P.C.

TIE SHTS. 3-13

100' TAPE

LOMICKA R

DOWLEY R.C.

DEPUTY COUNTY SURVEYOR'S NOTE:

The purpose of these notes is to show the relationship of the points and/or lines shown hereon to either lines of record, control lines, or to each other. The Deputy County Surveyor does not claim at this time, that the points or lines shown hereon are true centerline, boundary, deed, or control points or lines. Without further analysis, the interpretation of these notes is left to the discretion of the user.


John Canas
Deputy County Surveyor

By: John Toomey
Supervising Land Surveyor

REFERENCES/REMARKS:

THE TIES SHOWN HEREIN ARE FOR THE PURPOSE OF PERPETUATING THE
MONUMENTATION CURRENTLY EXISTING. NO ATTEMPT WAS MADE TO
DETERMINE THE VALIDITY OF THE MONUMENTS OR THEIR PROPER
LOCATION IN RELATION TO LEGAL BOUNDARY LINES IN THE AREA.


INDEX SHEET

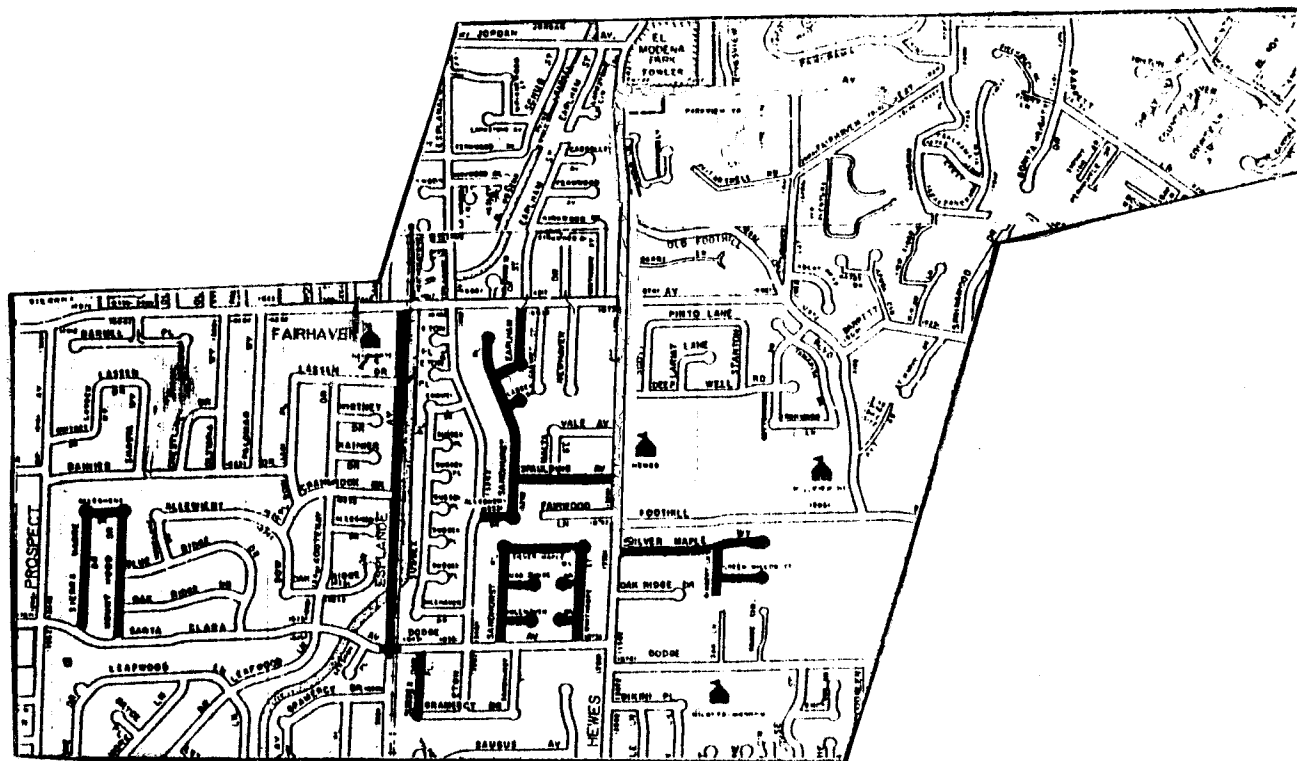

SURVEYED BY SEHER & PTY.


DATE AUG. 1989

ORANGE COUNTY SURVEYOR

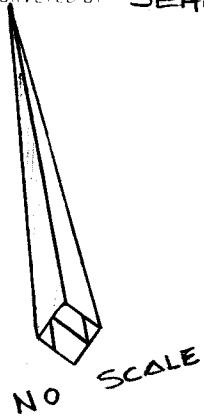


○ = SET LD./O.C.S. TIE TAG IN T/C

● = FD. PER TR. 1791
MM 74/13-14

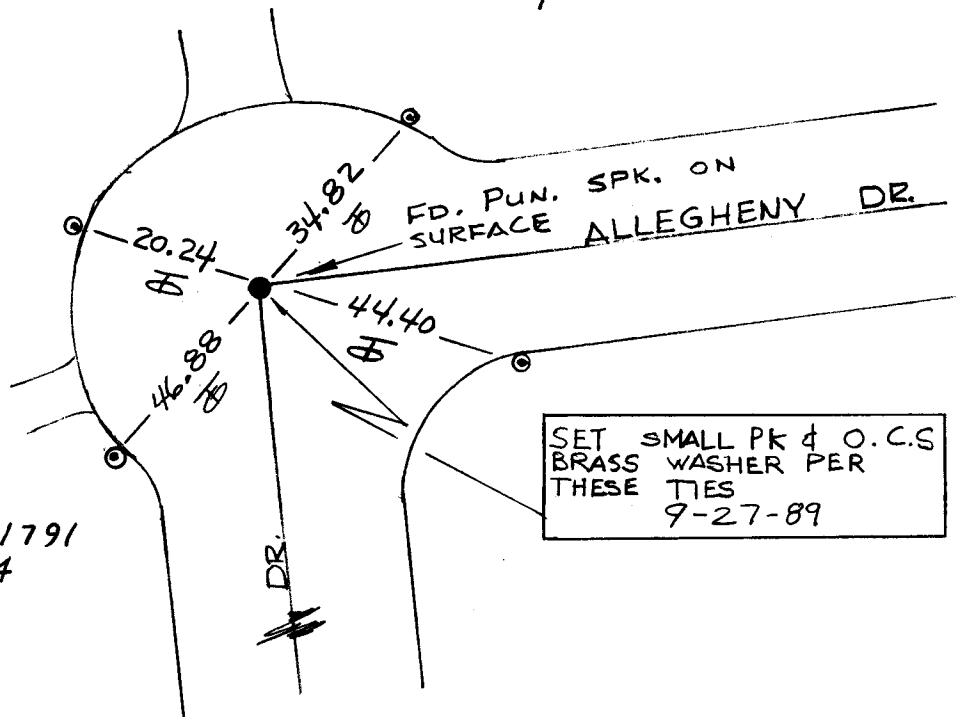

SET SMALL PK & O.C.S
BRASS WASHER PER
THESE TIES
9-27-89

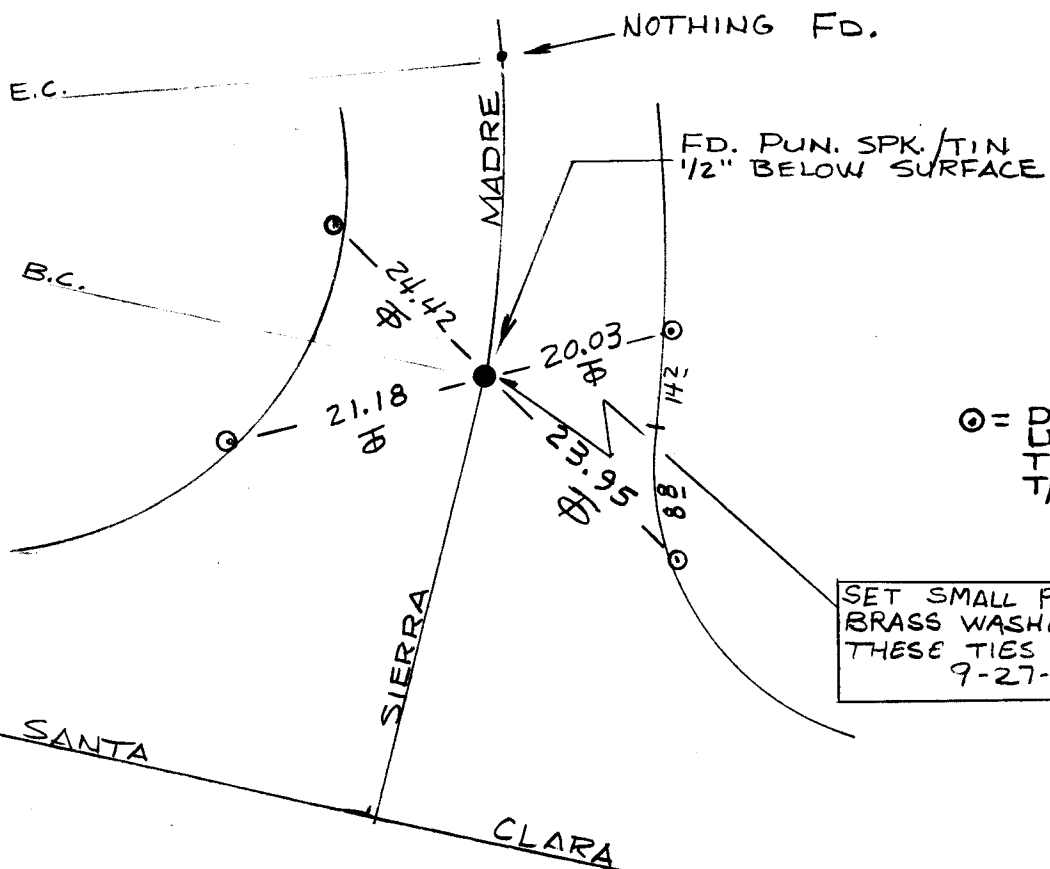


○ = DENOTES SET
LD./O.C.S.
TIE TAG IN
T/C


SET SMALL PK & O.C.S
BRASS WASHER PER
THESE TIES
9-27-89

THE TIES SHOWN HEREON ARE FOR THE PURPOSE OF
PERPETUATING THE MONUMENTATION CURRENTLY EXISTING.
NO ATTEMPT WAS MADE TO DETERMINE THE VALIDITY OF
THE MONUMENTS OR THEIR PROPER LOCATION IN RELATION
TO LEGAL BOUNDARY LINES IN THE AREA.

See Deputy County Surveyor's Note on page 1

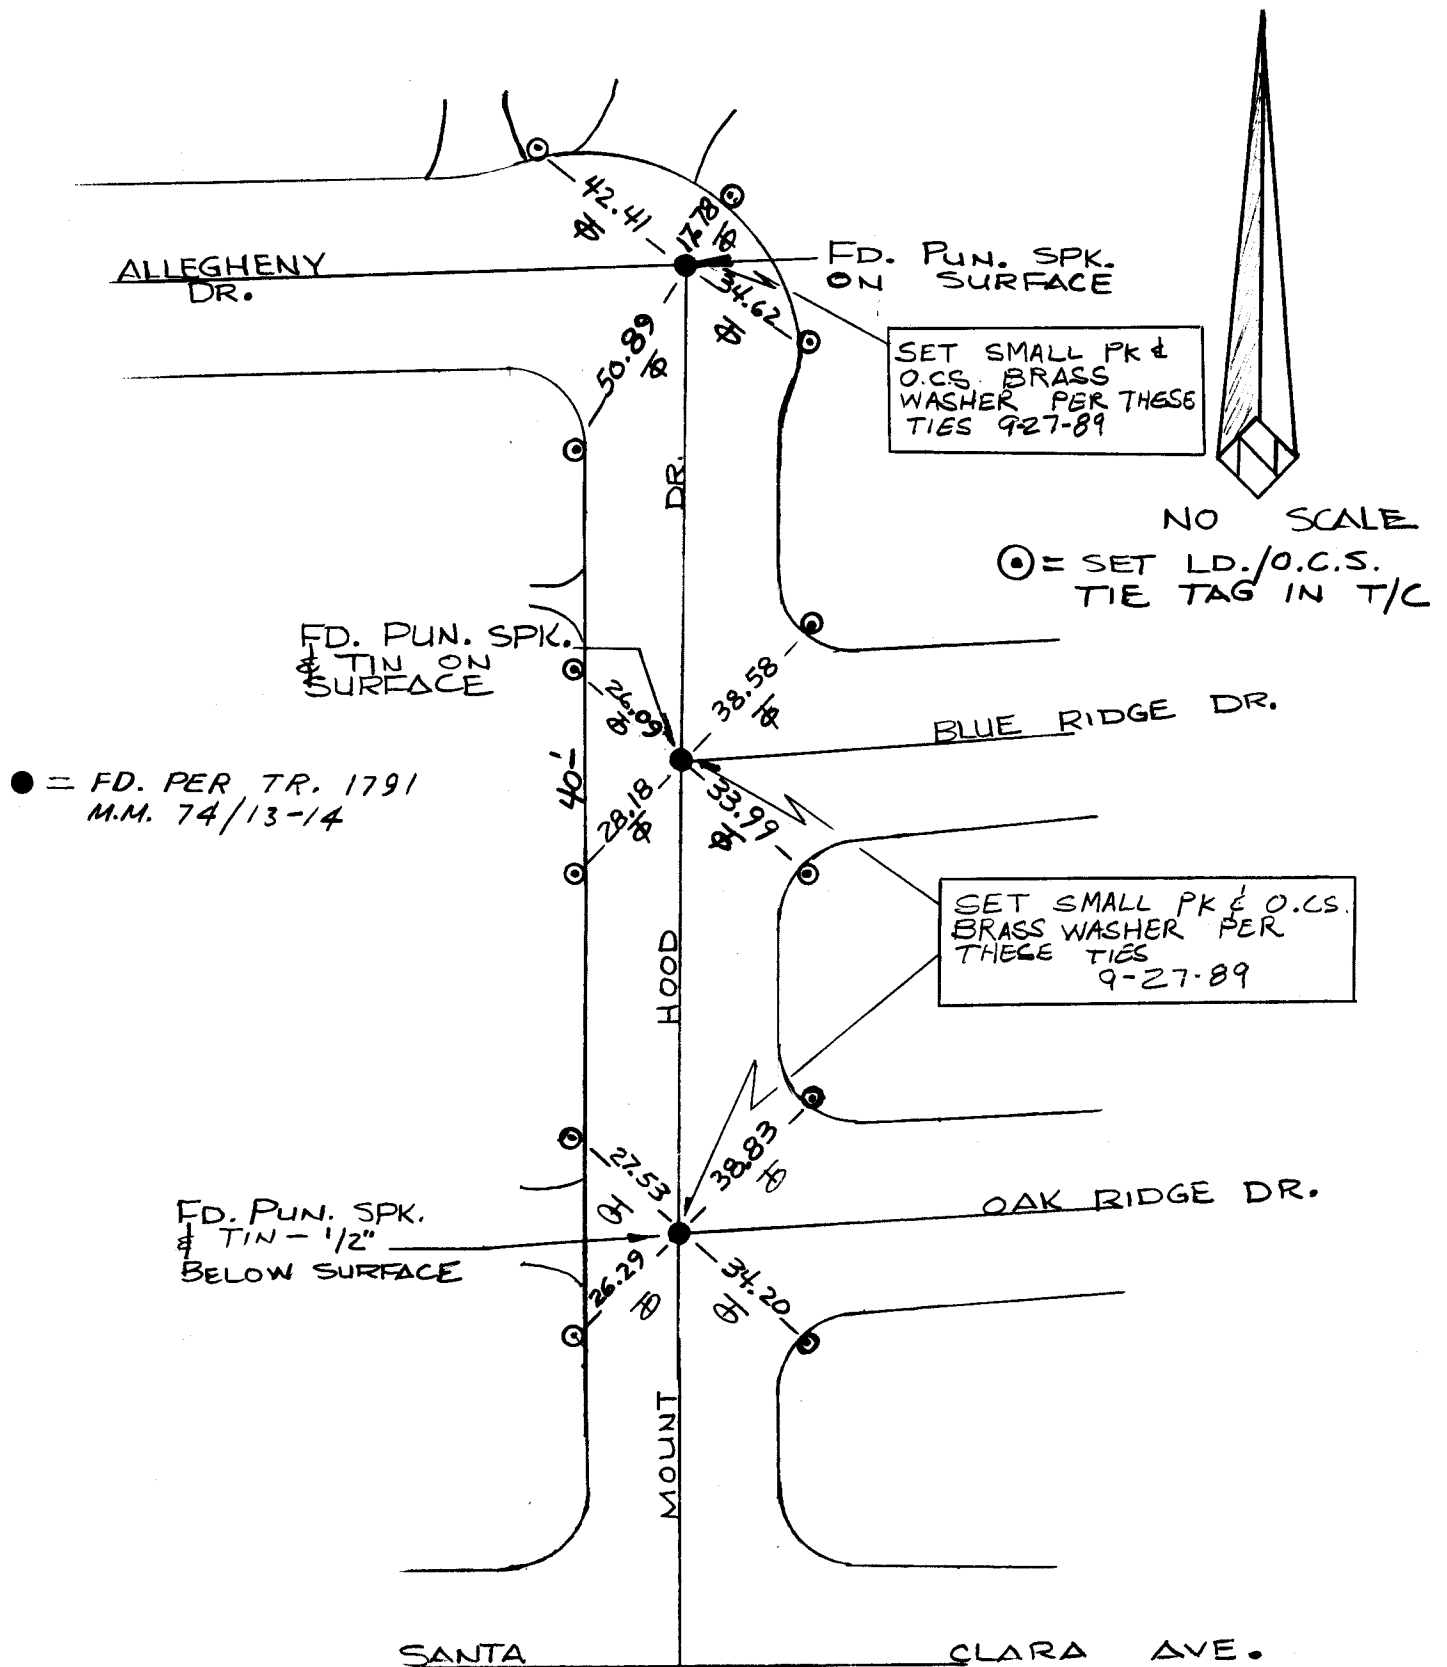


THE TIES SHOWN HEREON ARE FOR THE PURPOSE OF PERPETUATING THE MONUMENTATION CURRENTLY EXISTING. NO ATTEMPT WAS MADE TO DETERMINE THE VALIDITY OF THE MONUMENTS OR THEIR PROPER LOCATION IN RELATION TO LEGAL BOUNDARY LINES IN THE AREA.
 See Deputy County Surveyor's Note on page 1

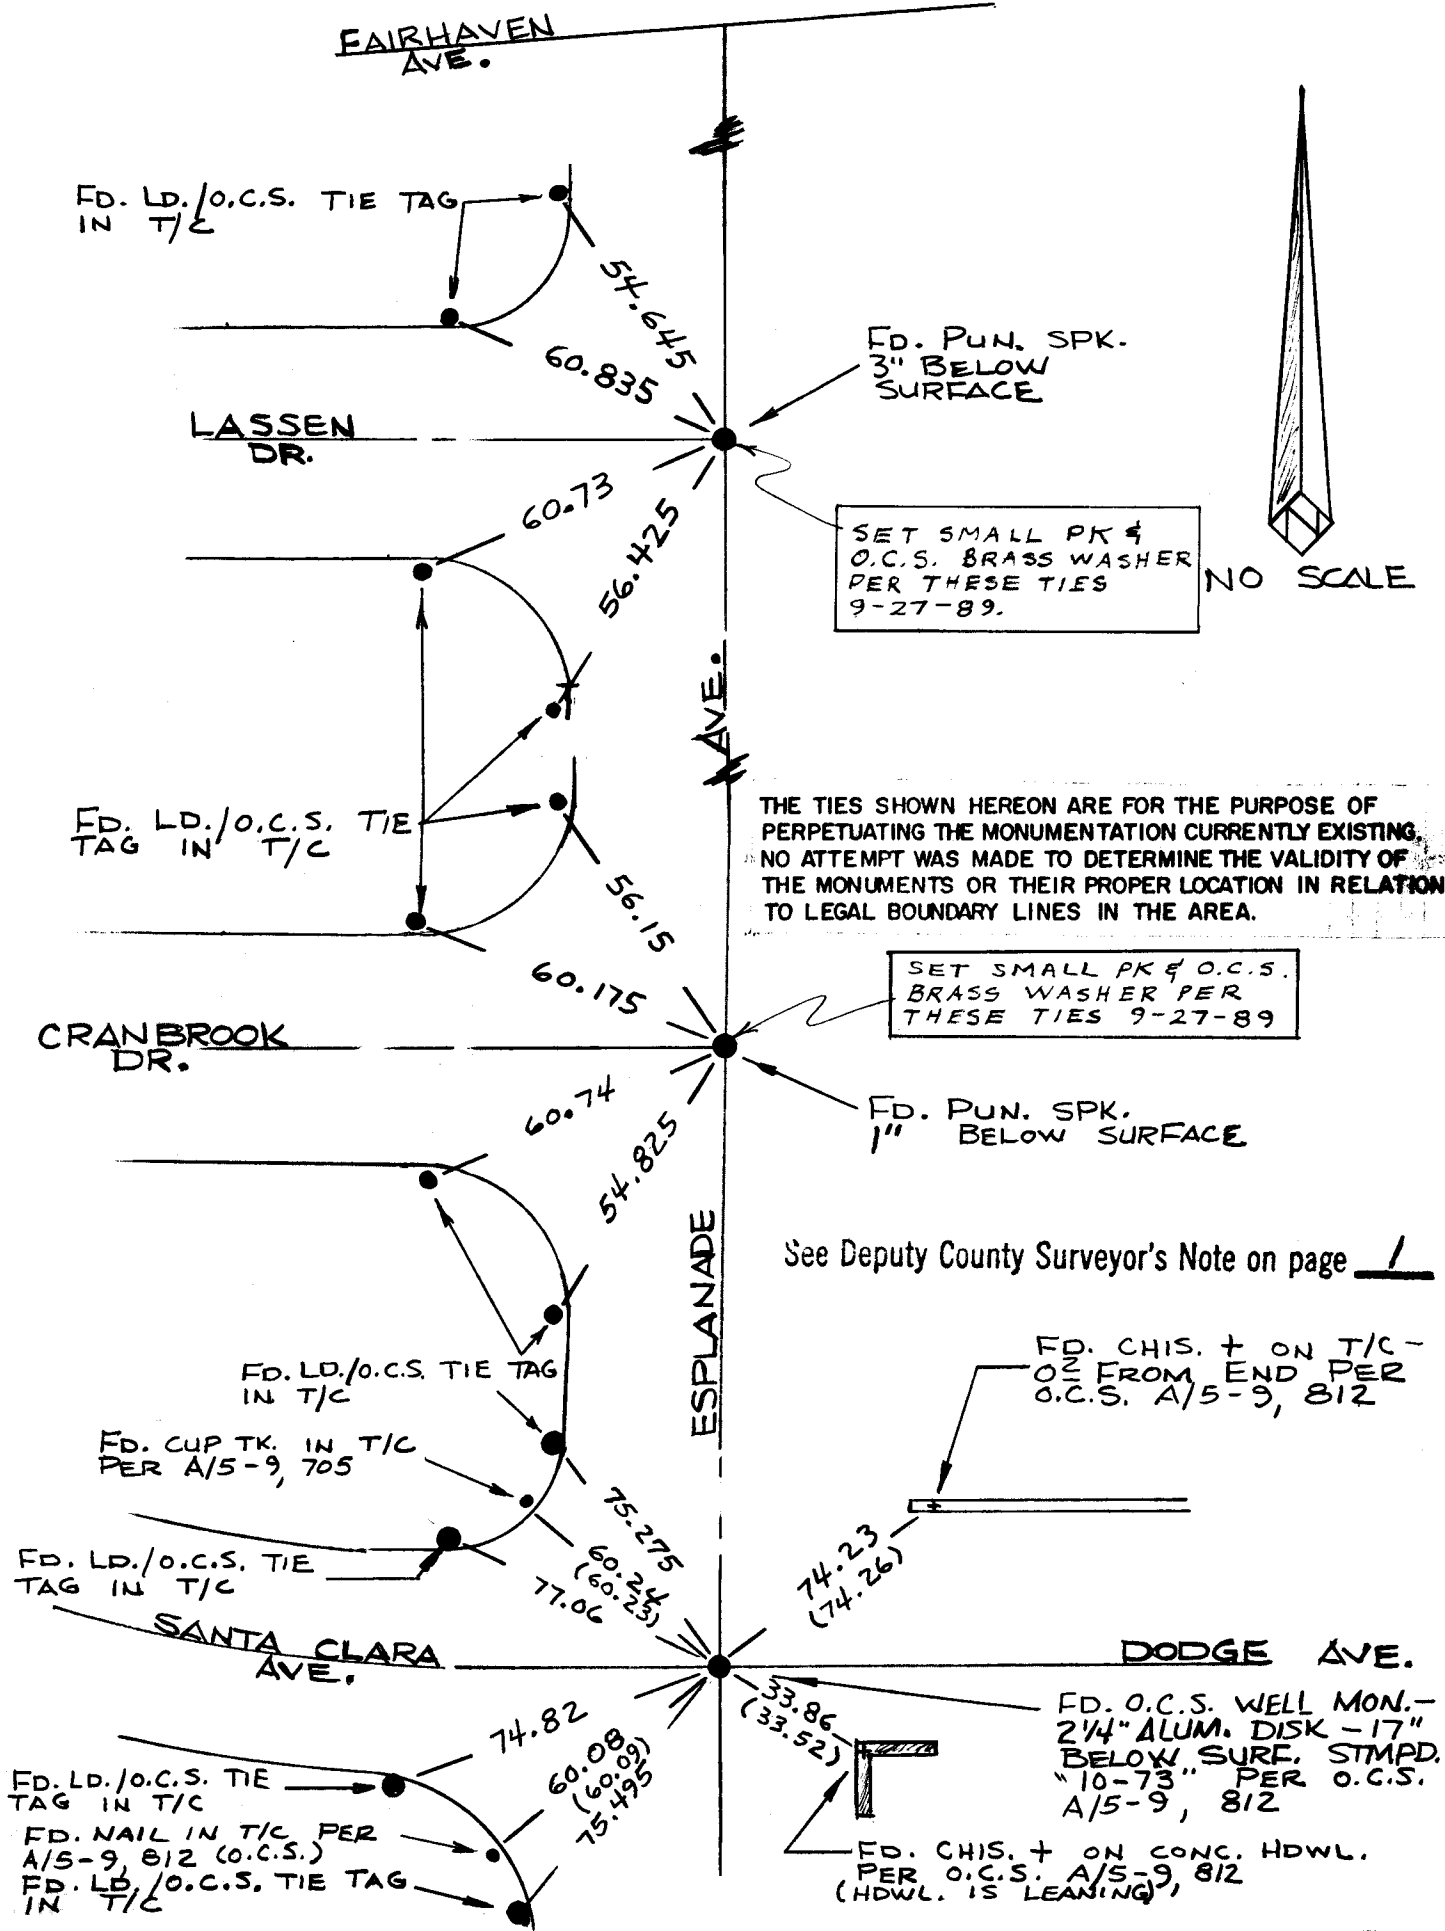




NO SCALE

⊙ = SET LD./O.C.S.
TIE TAG IN T/C

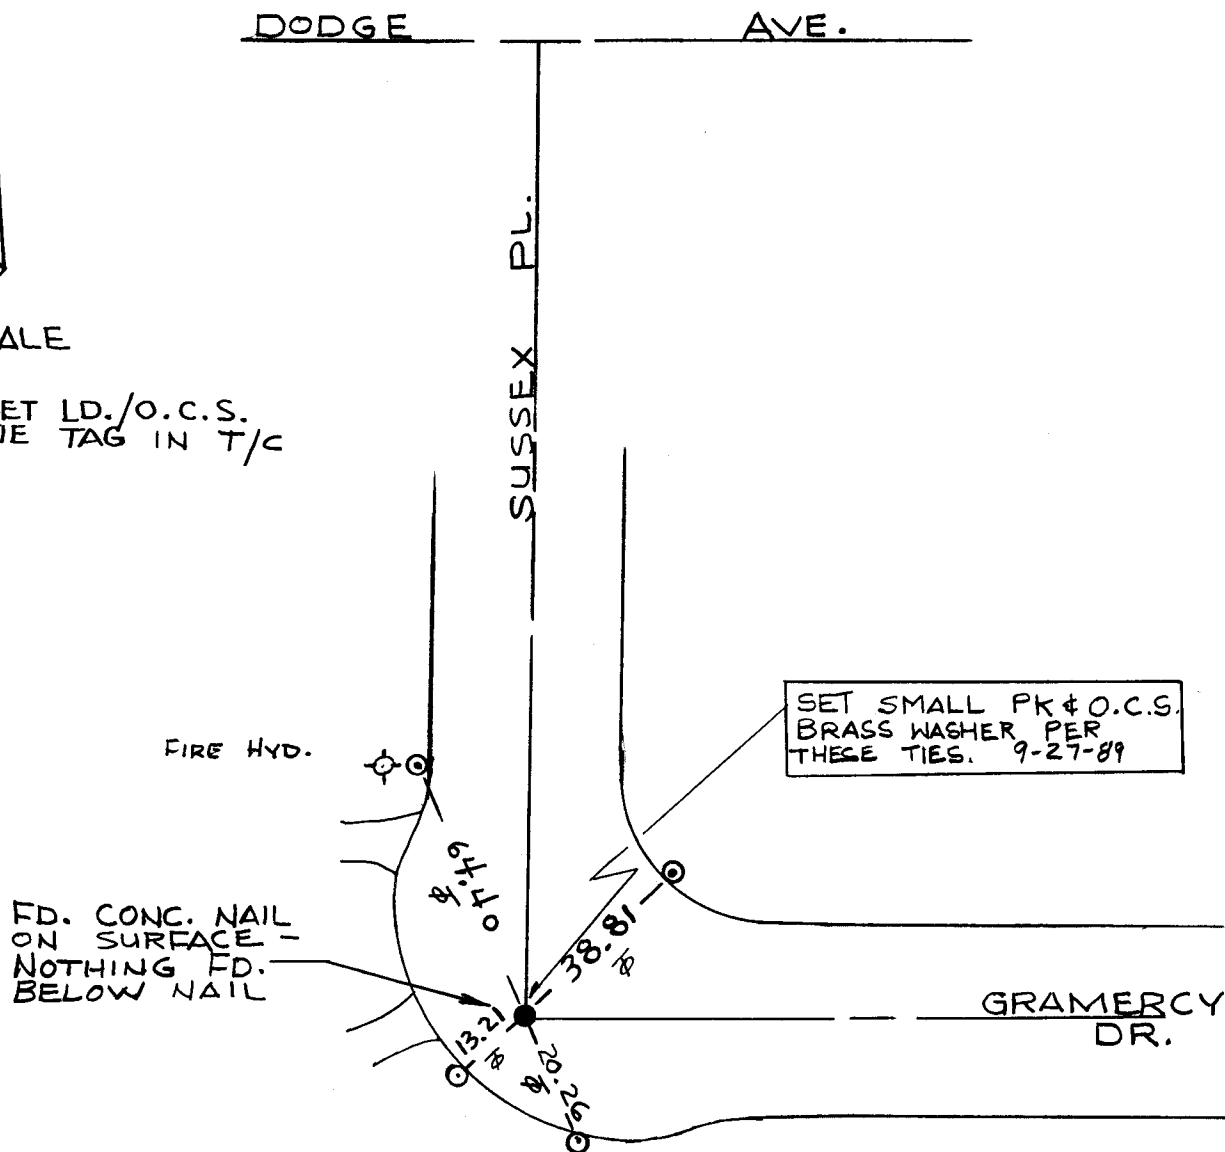

THE TIES SHOWN HEREON ARE FOR THE PURPOSE OF PERPETUATING THE MONUMENTATION CURRENTLY EXISTING. NO ATTEMPT WAS MADE TO DETERMINE THE VALIDITY OF THE MONUMENTS OR THEIR PROPER LOCATION IN RELATION TO LEGAL BOUNDARY LINES IN THE AREA.


See Deputy County Surveyor's Note on page 1

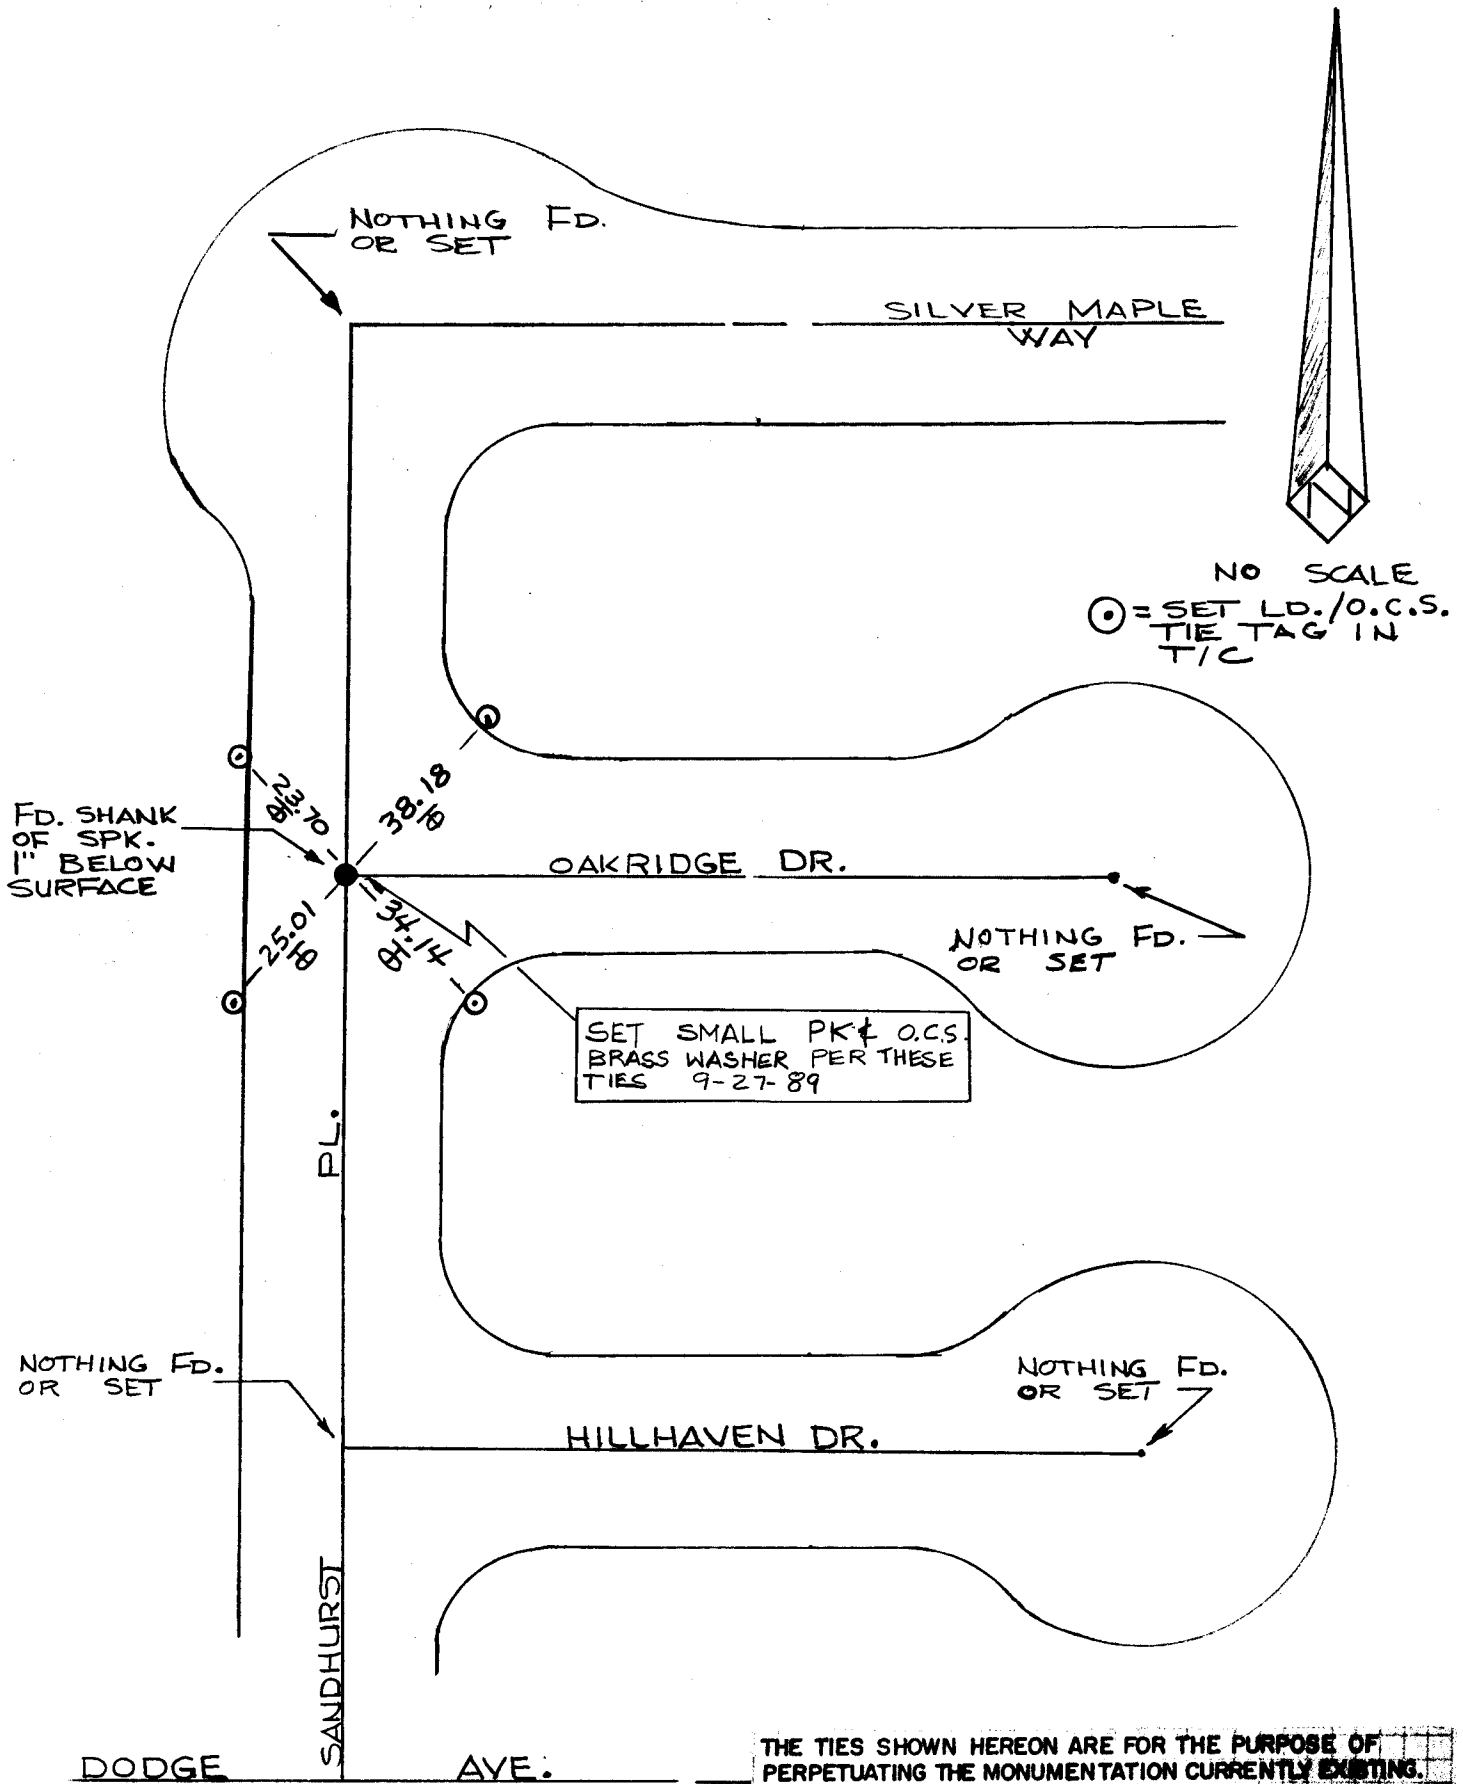


See Deputy County Surveyor's Note on page 1

THE TIES SHOWN HEREON ARE FOR THE PURPOSE OF PERPETUATING THE MONUMENTATION CURRENTLY EXISTING. NO ATTEMPT WAS MADE TO DETERMINE THE VALIDITY OF THE MONUMENTS OR THEIR PROPER LOCATION IN RELATION TO LEGAL BOUNDARY LINES IN THE AREA.


THE TIES SHOWN HEREON ARE FOR THE PURPOSE OF PERPETUATING THE MONUMENTATION CURRENTLY EXISTING. NO ATTEMPT WAS MADE TO DETERMINE THE VALIDITY OF THE MONUMENTS OR THEIR PROPER LOCATION IN RELATION TO LEGAL BOUNDARY LINES IN THE AREA.

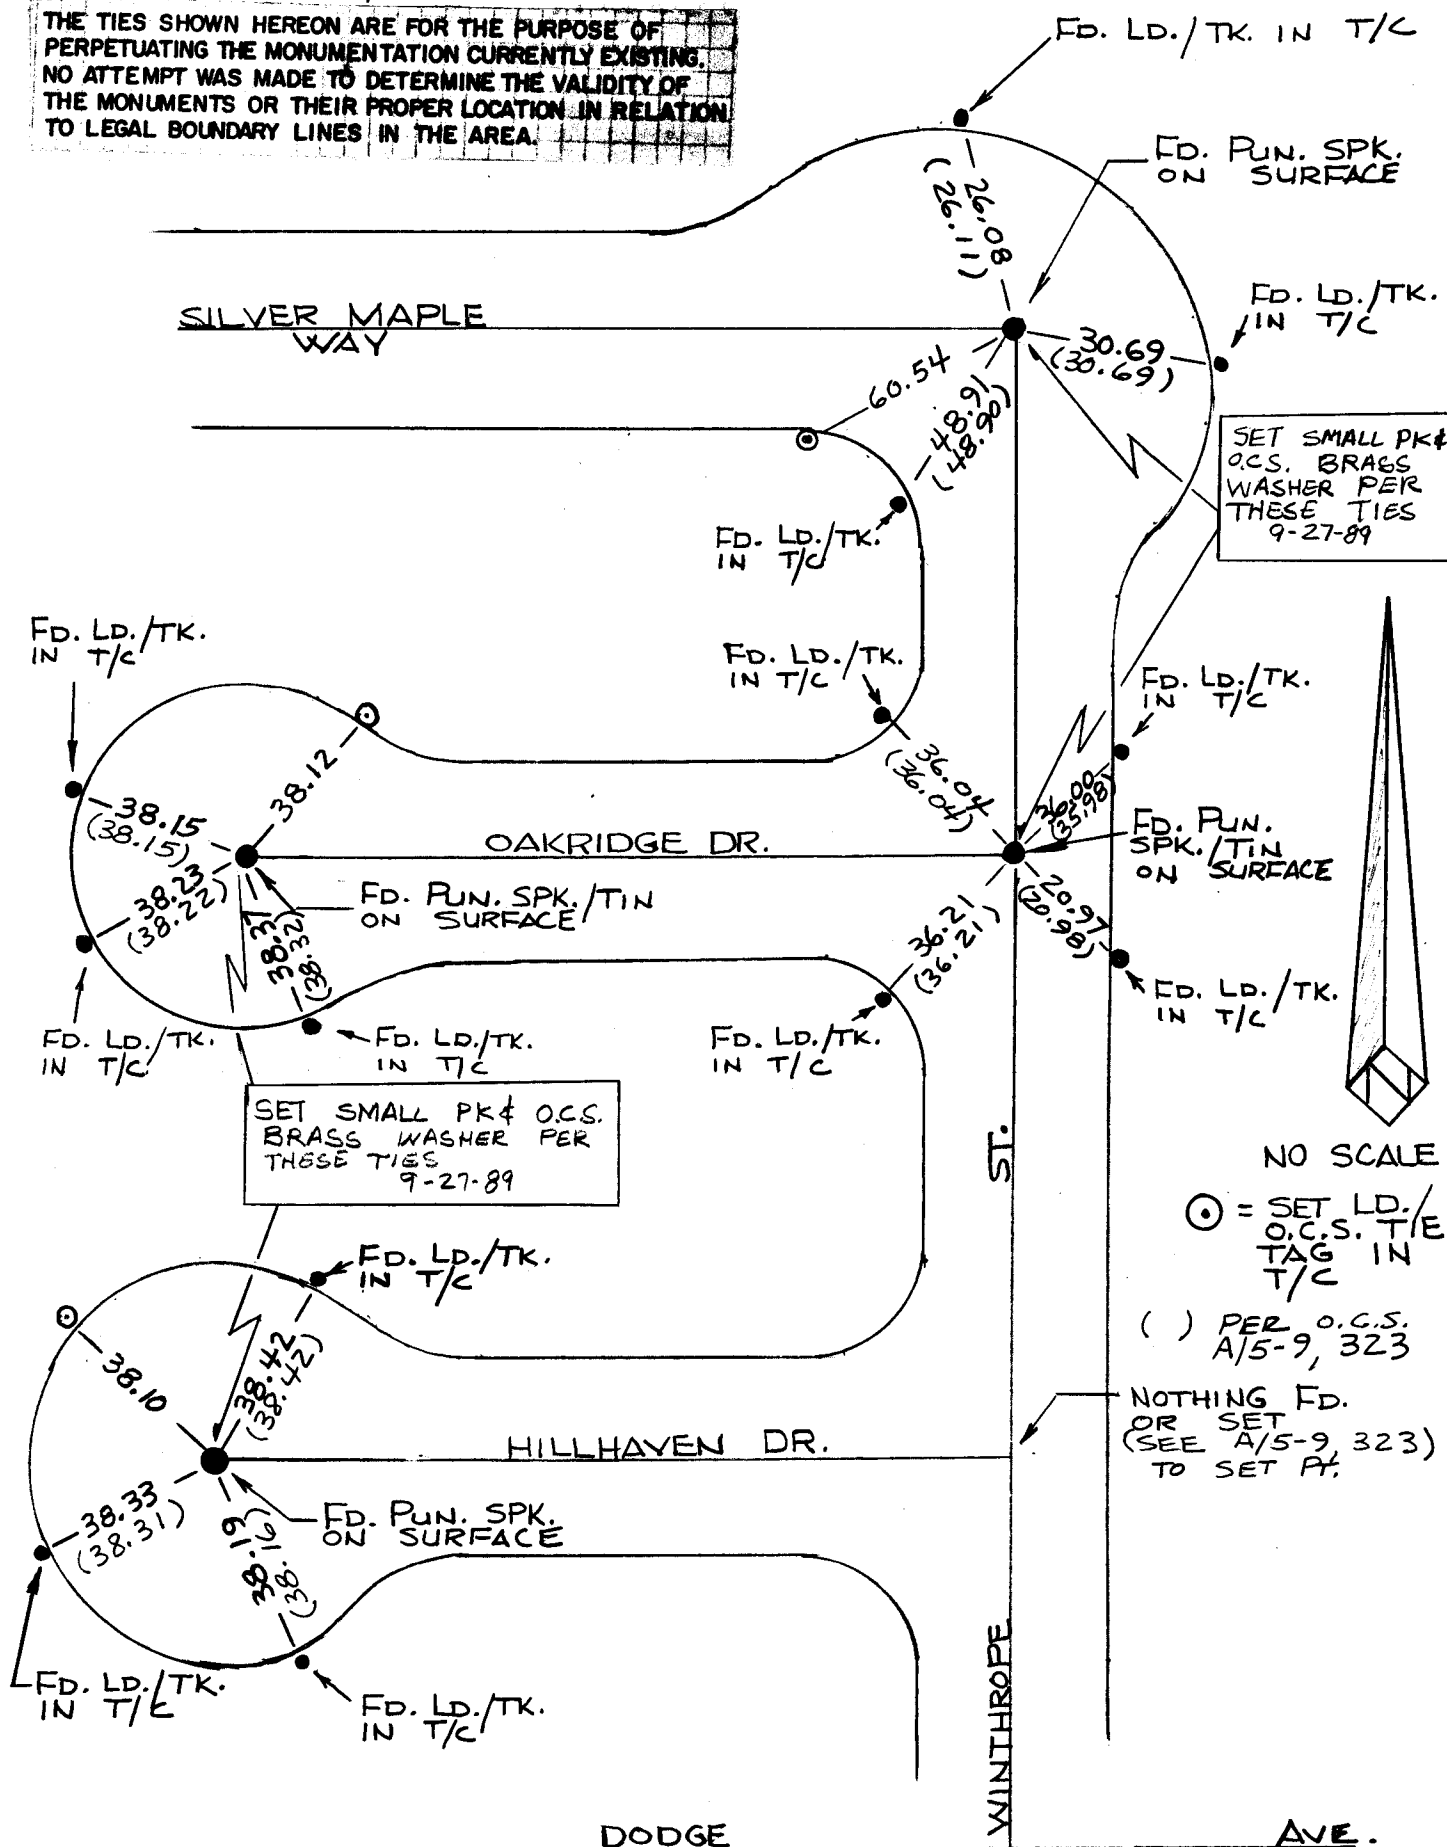

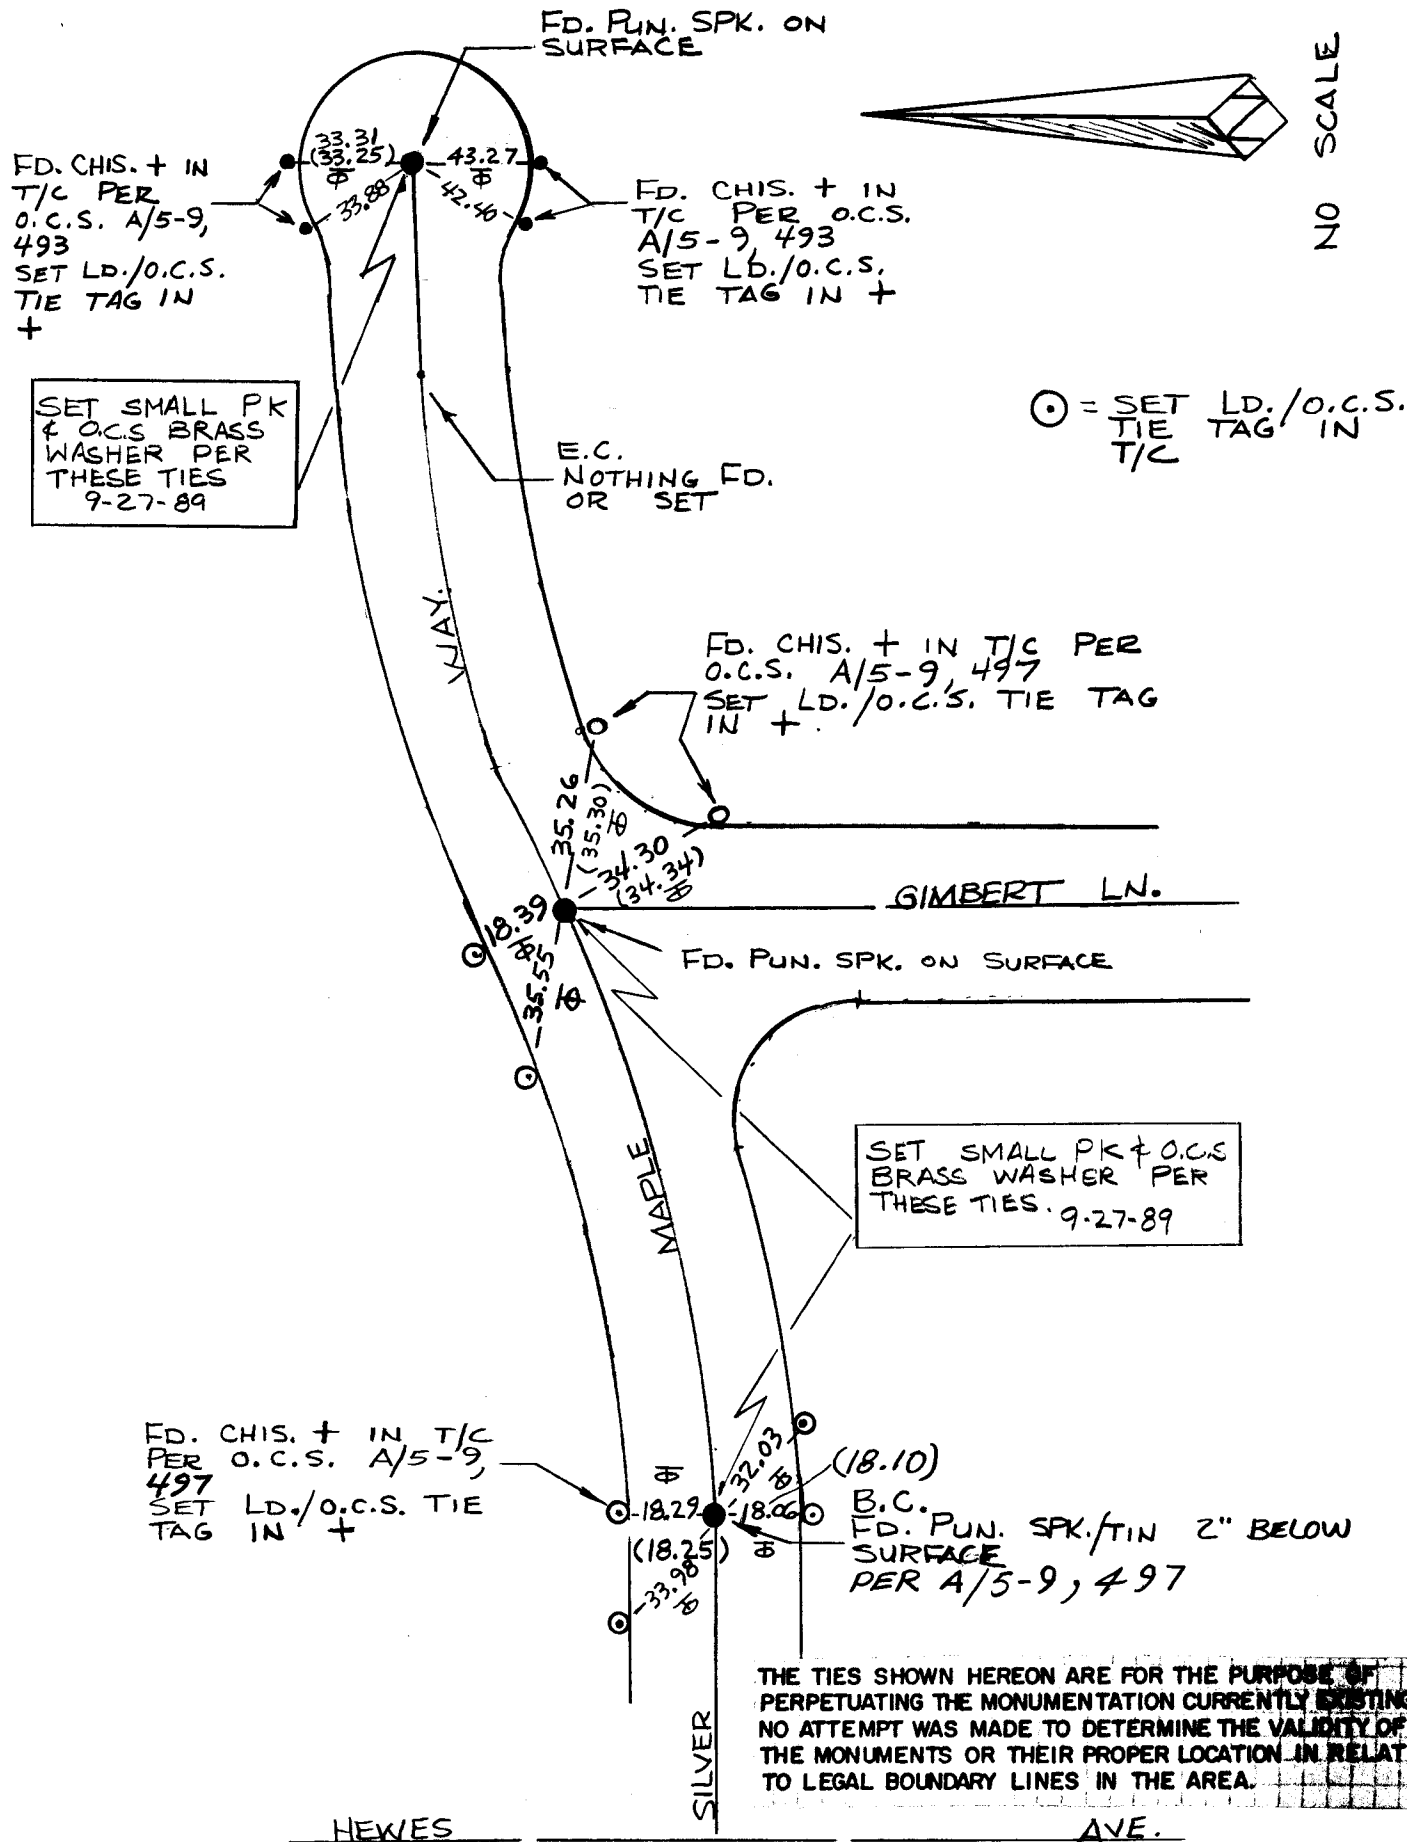



NO SCALE

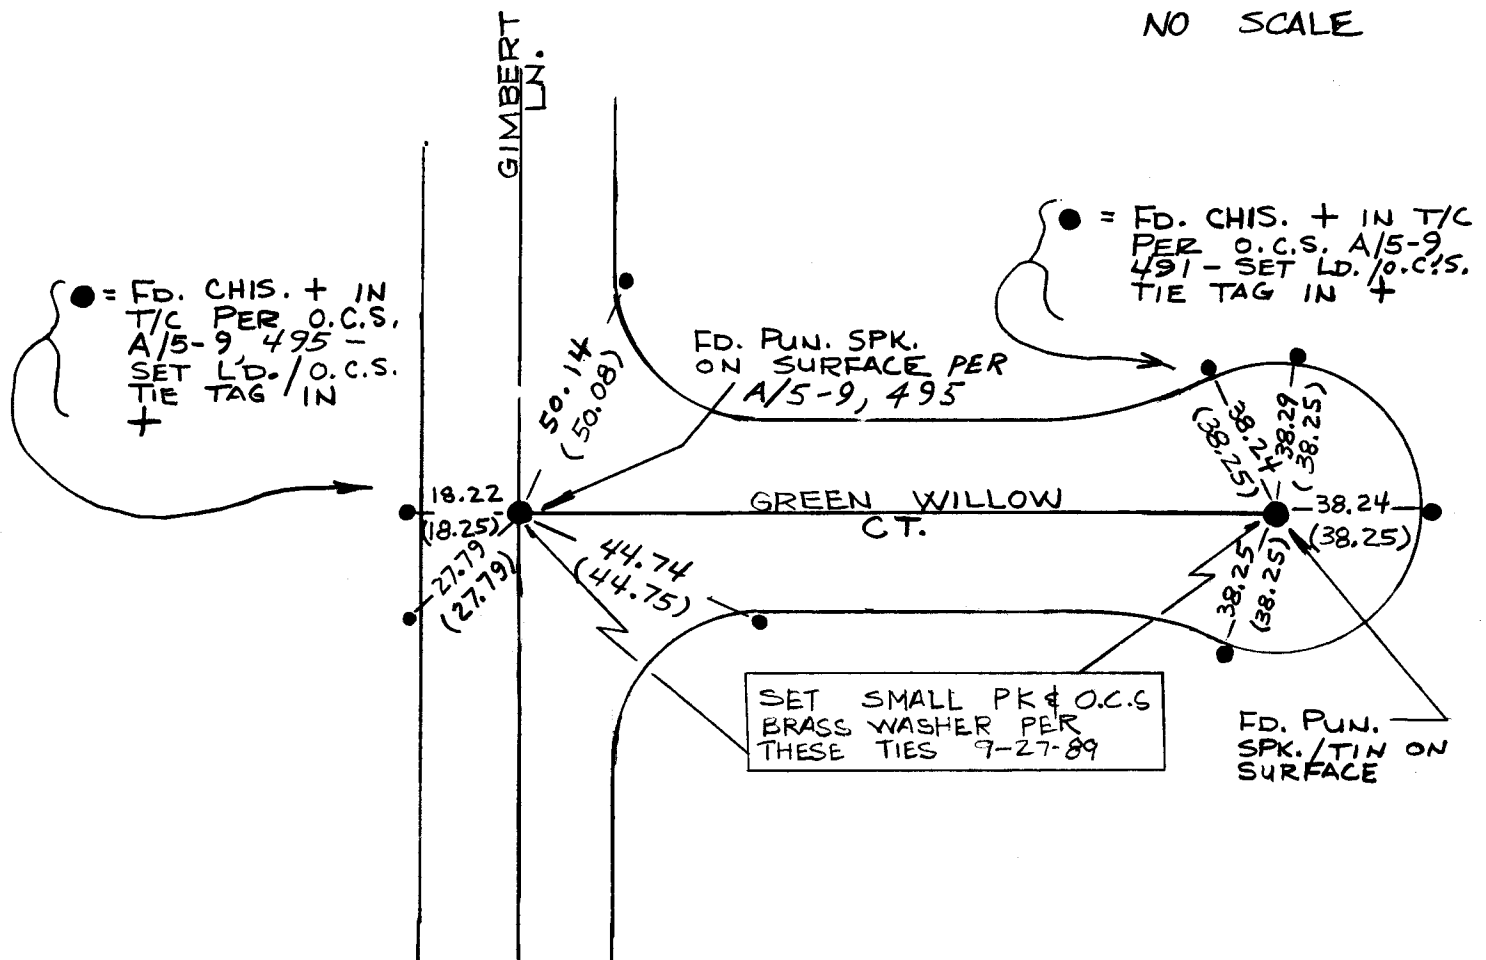

THE TIES SHOWN HEREON ARE FOR THE PURPOSE OF PERPETUATING THE MONUMENTATION CURRENTLY EXISTING. NO ATTEMPT WAS MADE TO DETERMINE THE VALIDITY OF THE MONUMENTS OR THEIR PROPER LOCATION IN RELATION TO LEGAL BOUNDARY LINES IN THE AREA.


See Deputy County Surveyor's Note on page 1



NO SCALE

⊙ = SET LD./O.C.S.
TIE TAG IN
T/C

NOTHING FD.
OR SET

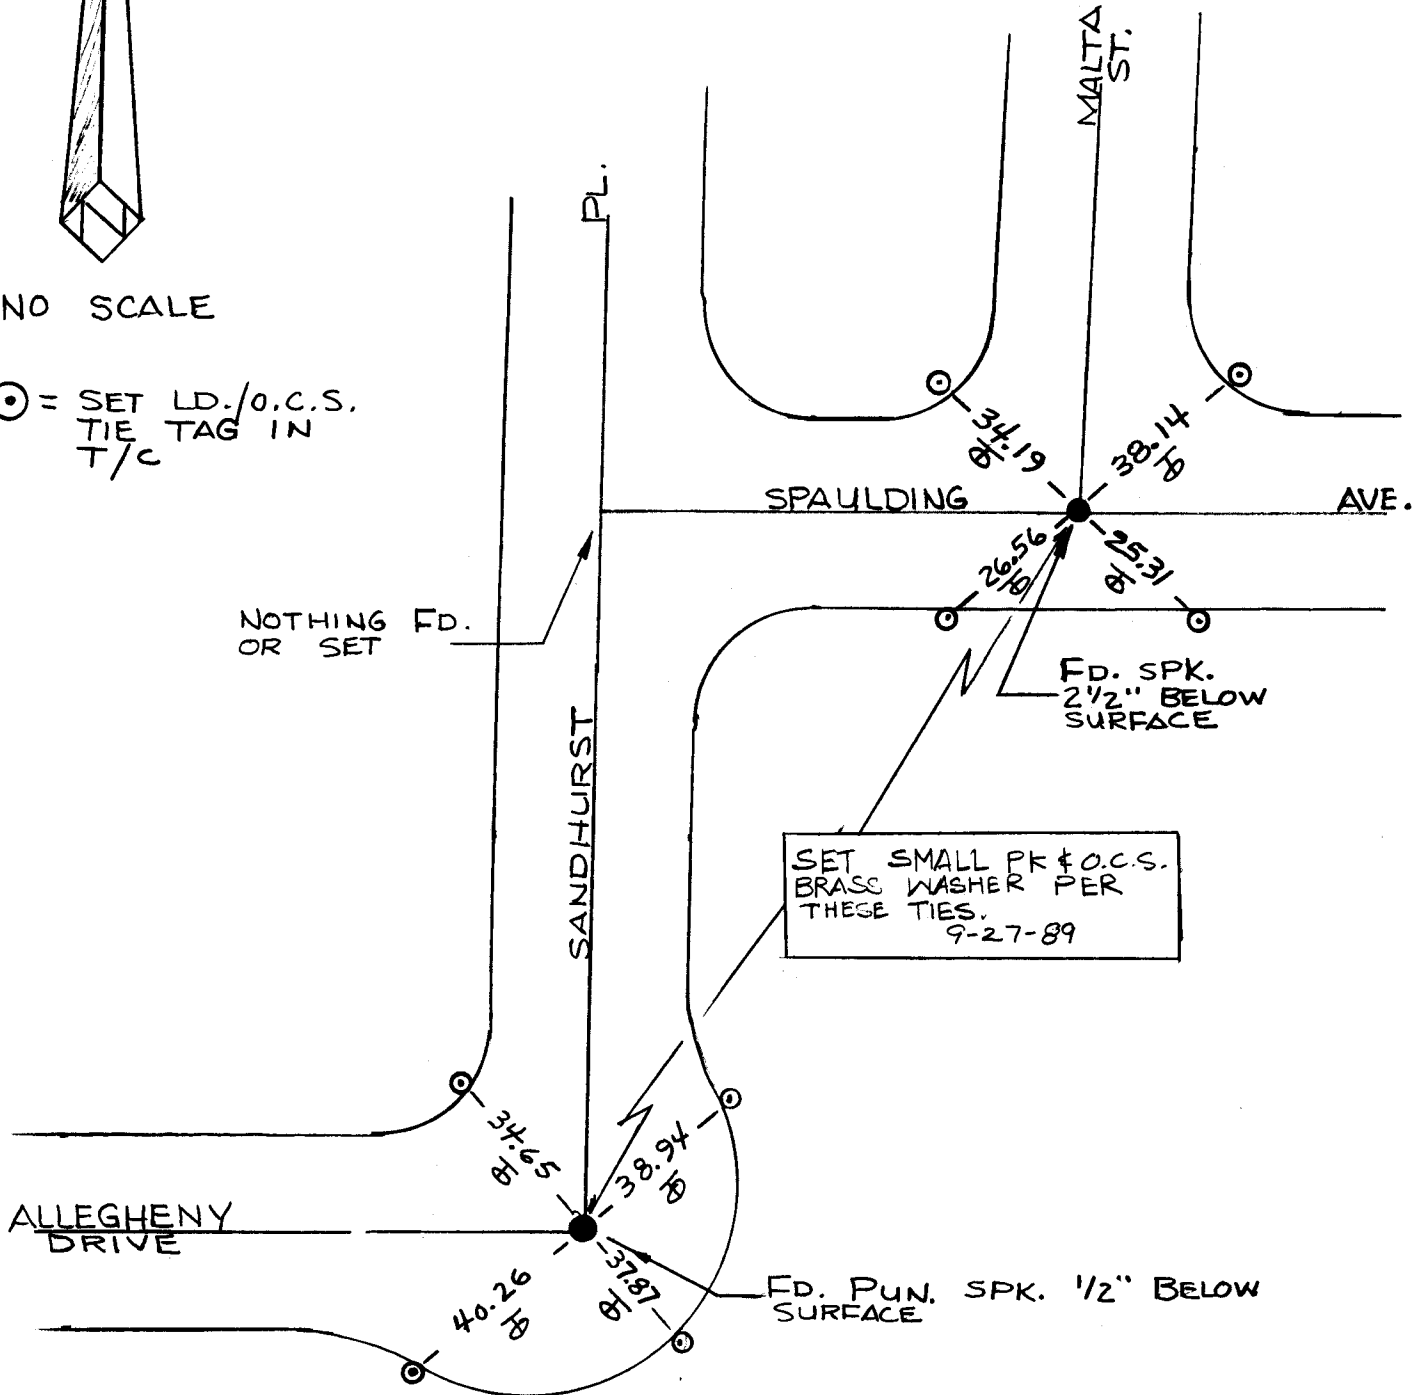

THE TIES SHOWN HEREON ARE FOR THE PURPOSE OF PERPETUATING THE MONUMENTATION CURRENTLY EXISTING. NO ATTEMPT WAS MADE TO DETERMINE THE VALIDITY OF THE MONUMENTS OR THEIR PROPER LOCATION IN RELATION TO LEGAL BOUNDARY LINES IN THE AREA.

See Deputy County Surveyor's Note on page 1



NO SCALE

⊙ = SET LD./O.C.S.
TIE TAG IN
T/C

FD. SPK.
1" BELOW
SURFACE

E.C.
FD. RUSTED
SPK. 1" BELOW
SURFACE

FD. SPK.
ON SURFACE

LASSEN
DR.

● = FD. CHIS. + IN
T/C - SET LD./O.C.S.
TIE TAG IN +

SET SMALL PK & O.C.S
BRASS WASHER PER
THESE TIES. 9-27-89


● = FD. CHIS. + IN T/C
SET LD./O.C.S. TIE
TAG IN +

● = FD. PER TR. 2739
MM 88/48-50

B.C. NOTHING FD.
OR SET

THE TIES SHOWN HEREON ARE FOR THE PURPOSE OF
PERPETUATING THE MONUMENTATION CURRENTLY EXISTING.
NO ATTEMPT WAS MADE TO DETERMINE THE VALIDITY OF
THE MONUMENTS OR THEIR PROPER LOCATION IN RELATION
TO LEGAL BOUNDARY LINES IN THE AREA.

See Deputy County Surveyor's Note on page 1

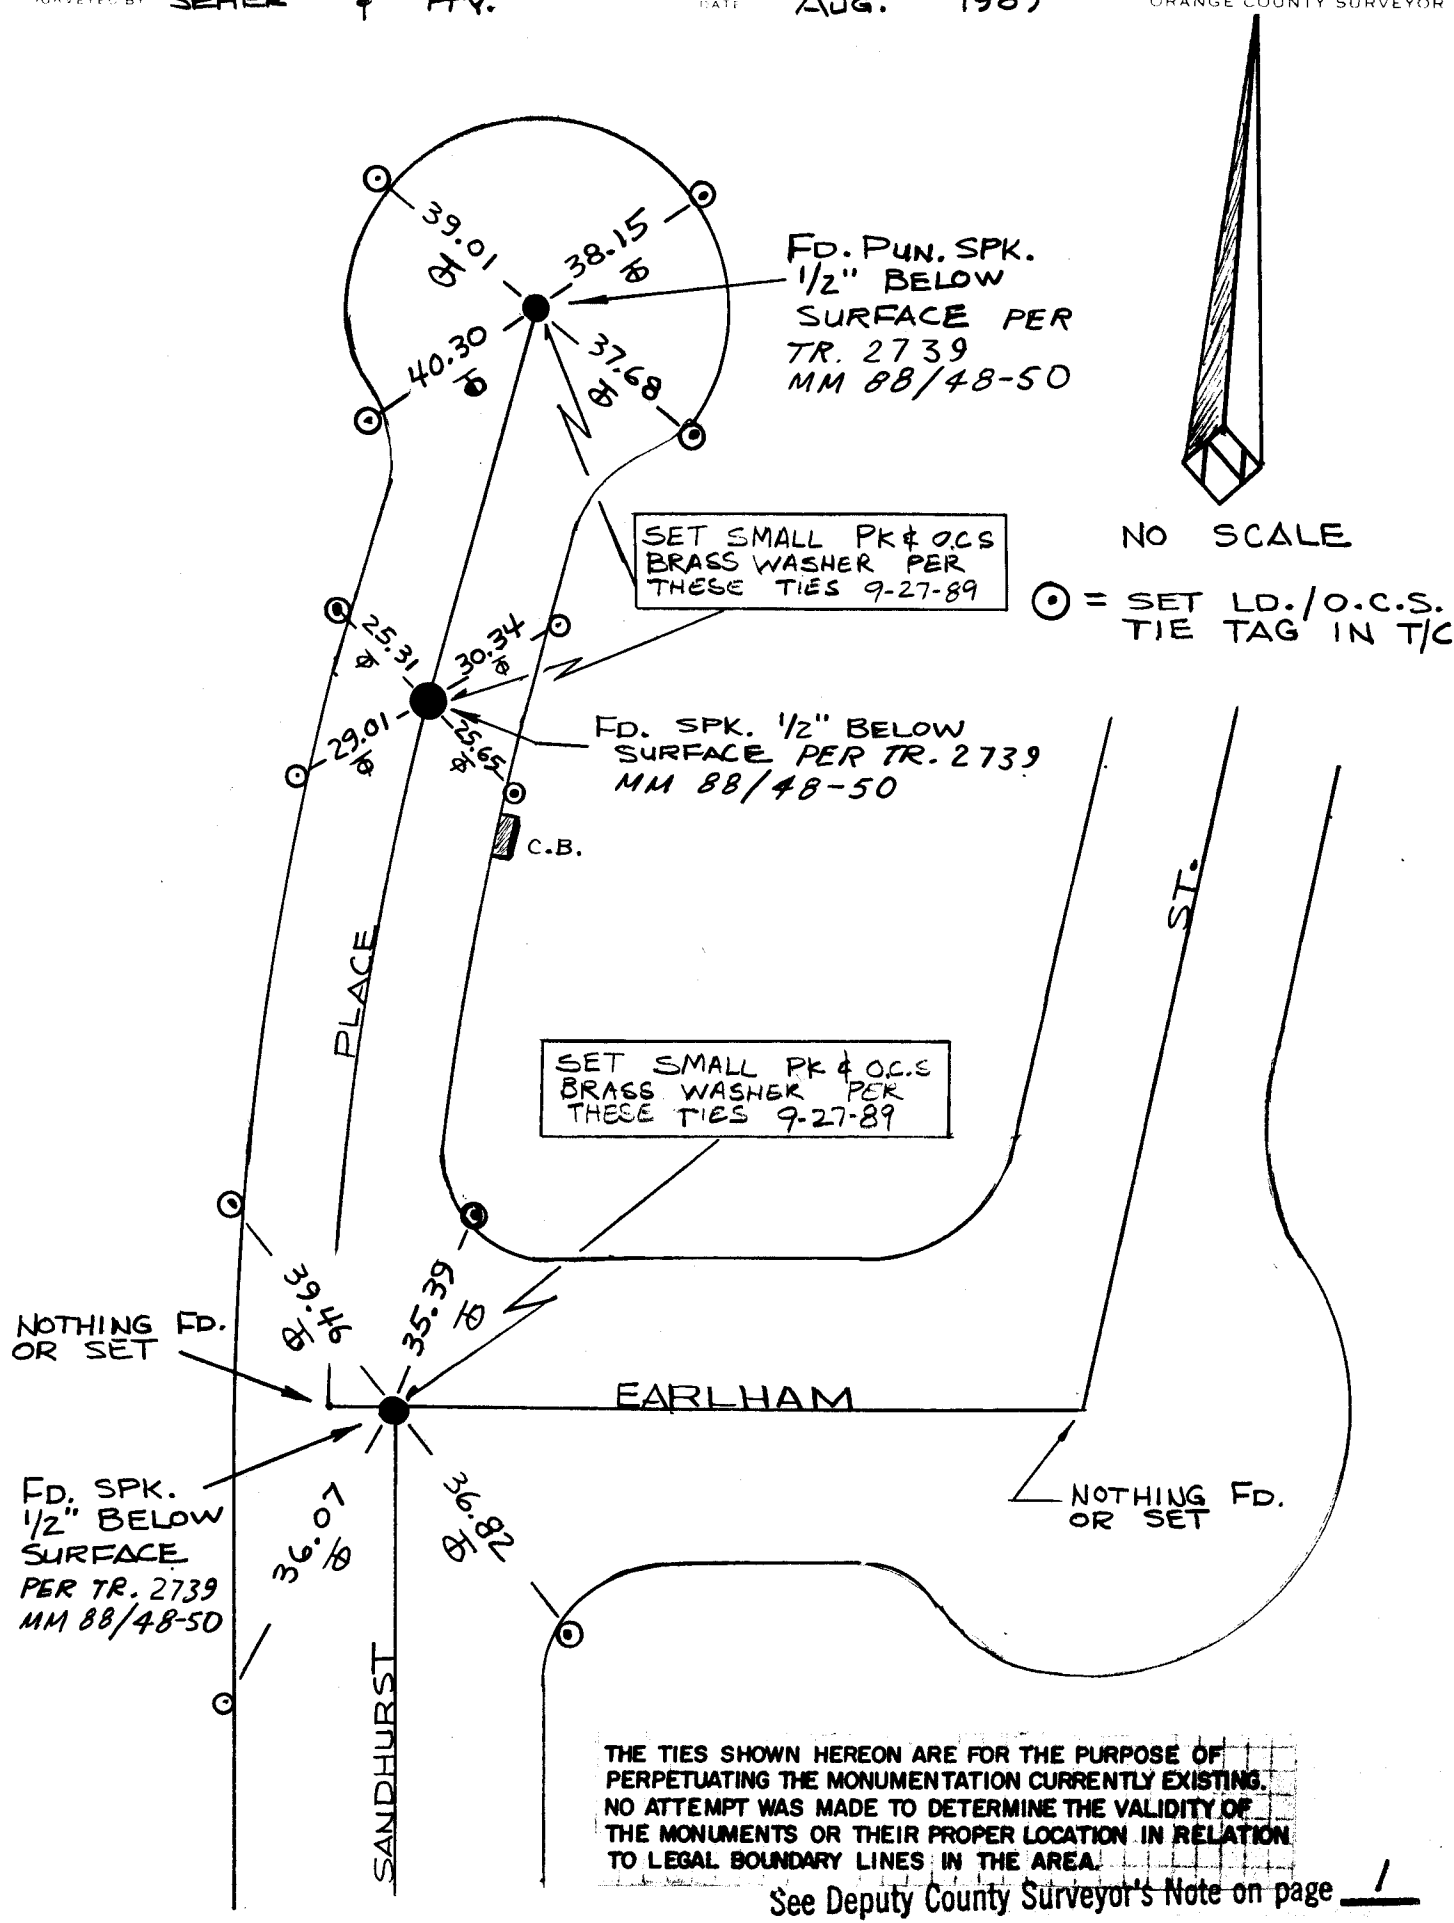

THE TIES SHOWN HEREON ARE FOR THE PURPOSE OF PERPETUATING THE MONUMENTATION CURRENTLY EXISTING. NO ATTEMPT WAS MADE TO DETERMINE THE VALIDITY OF THE MONUMENTS OR THEIR PROPER LOCATION IN RELATION TO LEGAL BOUNDARY LINES IN THE AREA.