

ORANGE COUNTY SURVEYOR
SURVEY NOTES

A/5-9 932

ALIGNMENT INDEX BOOK AND PAGE

ALIGNMENT NOTES PG. ____ OF ____

PPB _____ WORK ORDER NUMBER R38001434

SURVEY NOTES PAGE 1 OF 13

SURVEY COMPLETION DATE DEC. 85

SURVEY FILE NUMBER R85-52B

PROJECT NAME RESURFACING OF VARIOUS STREETS 1985-1986 CONTRACT #1 (8586-10)

SURVEY LIMITS AREA B SEE PAGE 2

PURPOSE OF SURVEY LOCATE & TIE OUT & MONUMENTS BEFORE STREET RESURFACING.

THOMAS BROS.:

18, A-5

BLOCK AND MODULES:

BLOCK 5852 MODULES 5.3, 6.3, 5.4, 6.4, 5.5, 6.5, 7.5

SURVEY NOTE PAGE INDEX:

EQUIPMENT:

PERSONNEL:

DEPUTY COUNTY SURVEYOR'S NOTE:

The purpose of these notes is to show the relationship of the points and/or lines shown hereon to either lines of record, control lines, or to each other. The Deputy County Surveyor does not claim at this time, that the points or lines shown hereon are true centerline, boundary, deed, or control points or lines. Without further analysis, the interpretation of these notes is left to the discretion of the user.

G.K. Shelton

Deputy County Surveyor

By

Supervising Land Surveyor

MINICH

RAYMOND

SMYTHE

SUTTER

REFERENCES / REMARKS :

POINTS FOUND IN DEC "85" WERE TIED OUT; AFTER RESURFACING, POINTS WERE UNCOVERED OR RESET IF MISSING IN JUNE "86".

MINICH AREA B

DEC. 85

NOTE: SEE PAGE 3 FOR
SUMMARY OF MONUMENTS
TIED OUT

LASSEN DR.

WHITNEY DR.

RAINIER DR.

CRANBROOK DR.

ALLEGHENY DR.

OAK RIDGE DR.

RAINIER DR.

ALLEGHENY DR.

BLUE RIDGE DR.


OAK RIDGE DR.

SANTA CLARA AVE.

DEPUTY COUNTY SURVEYOR'S NOTE:

The purpose of these notes is to show the relationship of the points and/or lines shown hereon to either lines of record, control lines, or to each other. The Deputy County Surveyor does not claim at this time, that the points or lines shown hereon are true centerline, boundary, deed, or control points or lines. Without further analysis, the interpretation of these notes is left to the discretion of the user.

G.K. Shelton
Deputy County Surveyor

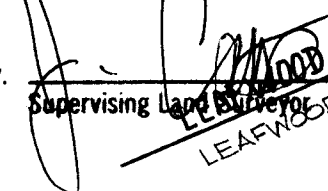By. 
Supervising Land Surveyor

LEAFWOOD

GERSHON PL.

17TH ST.

NOT TO
SCALE

NEWPORT AVE.

ESPLANADE AVE

BOW PL.

PL.

BOW

MOUNT HOOD DR.


MONTAGNE DR.

DEC. 85

CONTROL POINT	FOUND POINT	SET POINT	PAGE #
B.C. ON BLUE RIDGE BETWEEN MOUNT HOOD & MONTAGNE	•	⬡	4
E.C. ON BLUE RIDGE BETWEEN MOUNT HOOD & MONTAGNE	•	↑	4
INT. @ BLUE RIDGE & MONTAGNE	•	↓	4
B.C. ON BLUE RIDGE N'LY OF SANTA CLARA	⊙		5
INT. OF LASSEN & KOOTENAY	⊙	↓	5
CUL-DE-SAC ON ALLEGHENY	⊙	⬡	6
CUL-DE-SAC ON OAK RIDGE	⊙	△	6
INT. KOOTENAY & RAINIER	•	△	7
INT. KOOTENAY & CRANBROOK	⊙	△	7
E.C. W'LY OF OAK RIDGE & BLUE RIDGE	•	⬡	8
INT. OF OAK RIDGE & BLUE RIDGE	•	↑	8
BC. N'LY OF OAK RIDGE & BLUE RIDGE	•		8
EC. N'LY OF OAK RIDGE & BLUE RIDGE	•		8
BC. W'LY OF OAK RIDGE & BLUE RIDGE	•		9
BC N'LY OF ALLEGHENY & BOW	•		10
INT. OF BOW & CRANBROOK	•	↓	11
BC. S'LY OF BOW & CRANBROOK	•	⬡	11
INT. OF BOW & RAINIER	•	△	12
E.C. N'LY OF BOW & RAINIER	•	△	12
INT. OF BOW & LASSEN	FD. 1 1/4" O.D. I.P. & LS 2210 TAG	⬡	12
CUL-DE-SAC ON RAINIER	•	↑	13
CUL-DE-SAC ON WHITNEY	•	↓	13
INT. OF KOOTENAY & WHITNEY	FD. NOTHING, PULLED TIES SET O.C.S. TIE TAG	⬡	13
• = FD. SPK. ⊙ = FD. SPK. & W. △ ORIGINAL GONE - RESET WITH CUT SPK & O.C.S. TAG ⬡ UNCOVERED ORIGINAL PT.			

STREET RESURFACING "B"
MINICH NOTES RAYMOND

DEC. 85

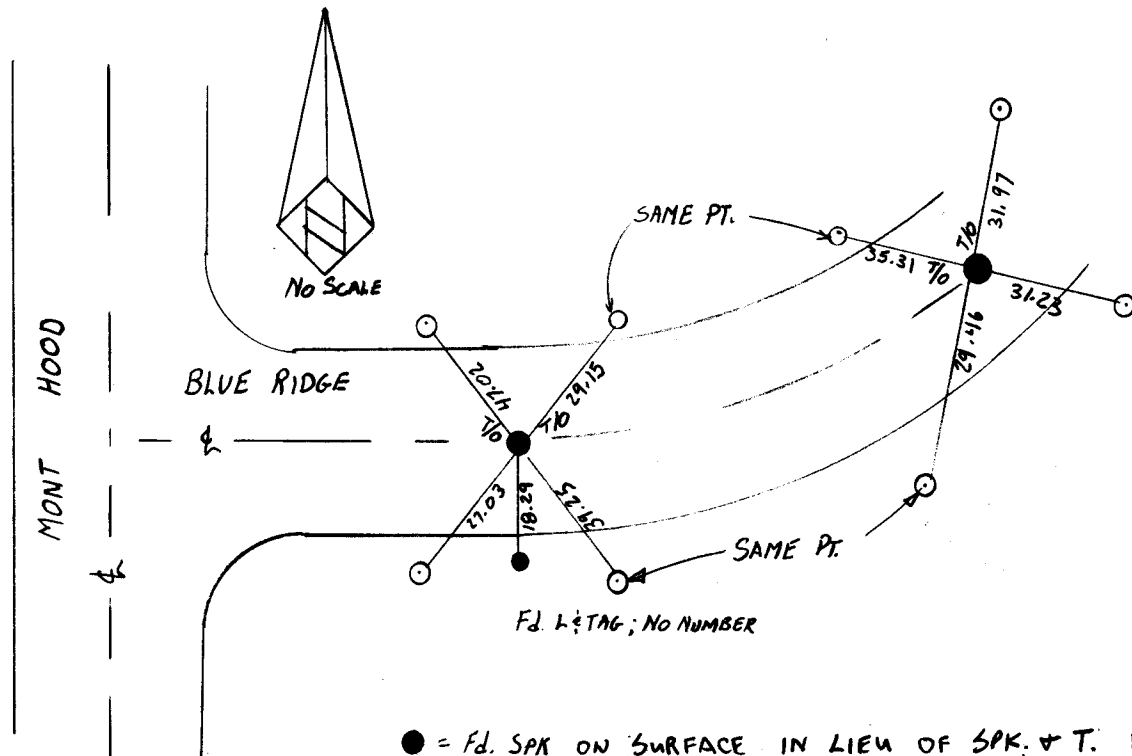



● = Fd. SPK. ON SURFACE IN LIEU OF SPK. & T. PER TR. 1791
M.M. 74/13-14
○ = SET L&T O.C.S. TIE TAG

DEPUTY COUNTY SURVEYOR'S NOTE:


The purpose of these notes is to show the relationship of the points and/or lines shown hereon to either lines of record, control lines, or to each other. The Deputy County Surveyor does not claim at this time, that the points or lines shown hereon are true centerline, boundary, deed, or control points or lines. Without further analysis, the interpretation of these notes is left to the discretion of the user.

G.K. Shelton
Deputy County Surveyor

By:
Supervising Land Surveyor

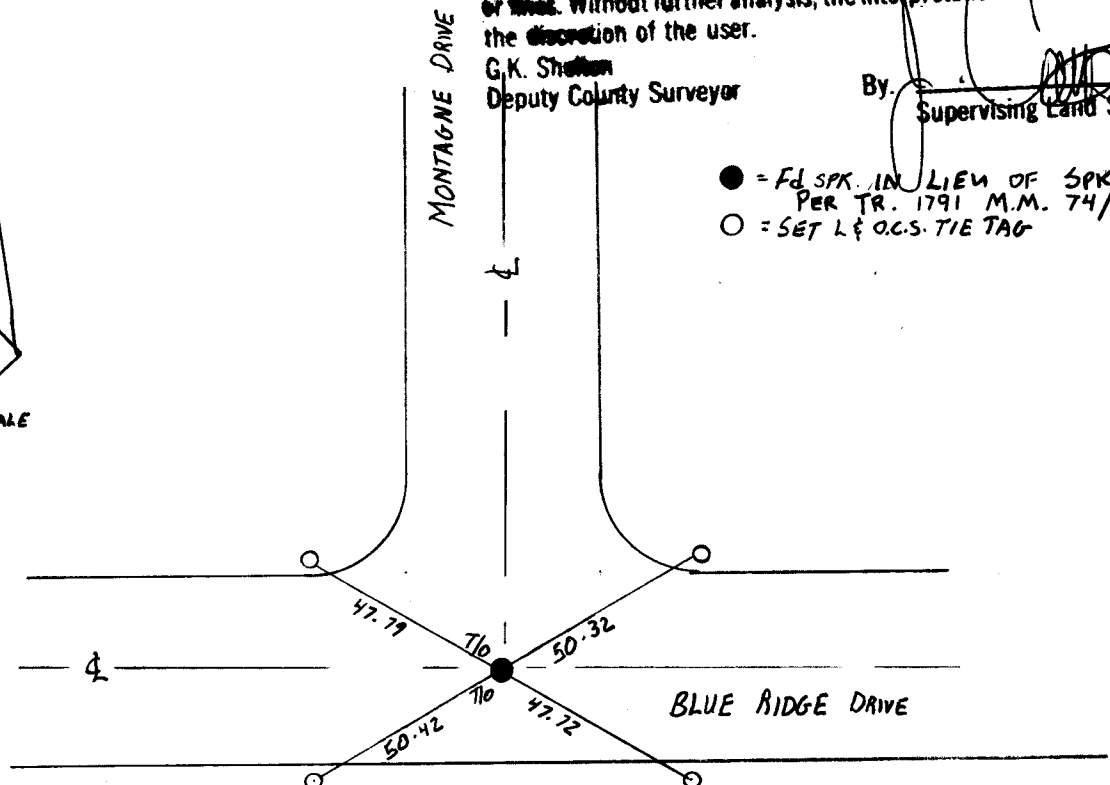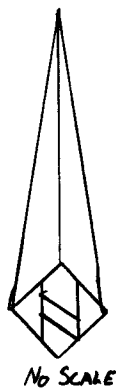

● = Fd. SPK. IN LIEU OF SPK. & T.
PER TR. 1791 M.M. 74/13-14
○ = SET L&T O.C.S. TIE TAG

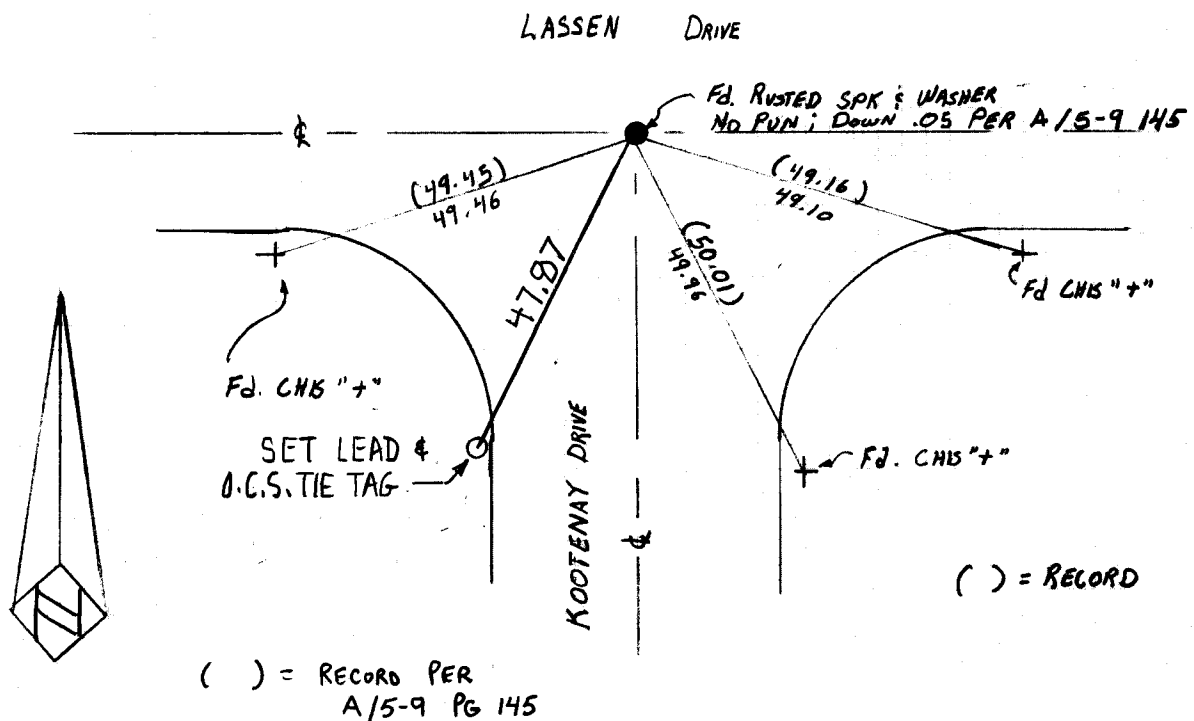


- = Fd. SPK U/TIN & WASHER
PER TRACT 1791 M.M. 74/13-14
- = SET L & O.C.S. TIE TAG

DEPUTY COUNTY SURVEYOR'S NOTE:

purpose of these notes is to show the relationship of the points and/or s shown hereon to either lines of record, control lines, or to each other. Deputy County Surveyor does not claim at this time, that the points or s shown hereon are true centerline, boundary, deed, or control points. Without further analysis, the interpretation of these notes is left to discretion of the user.

Sharon
Deputy County Surveyor

By:
Supervising Land Surveyor

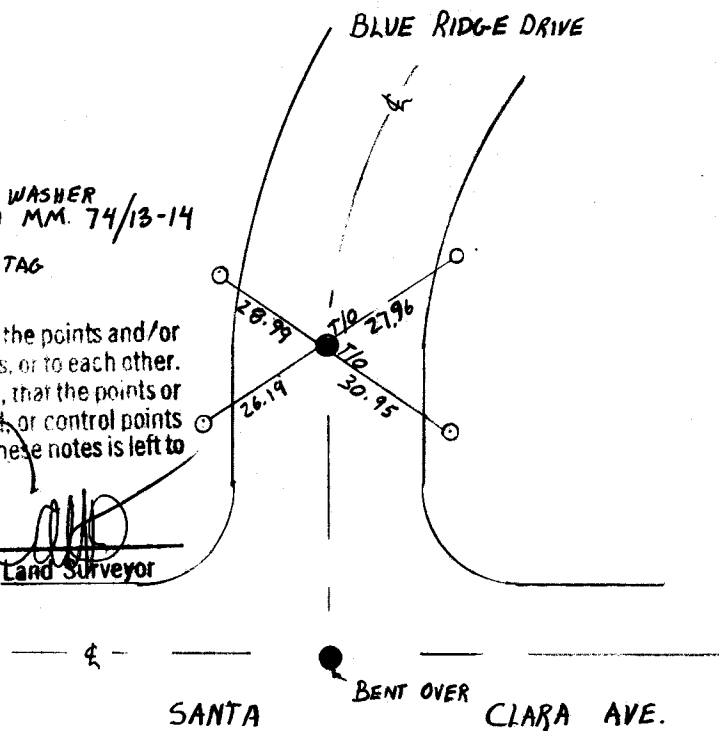

MINICH NOTES RAYMOND


DEPUTY COUNTY SURVEYOR'S NOTE:

The purpose of these notes is to show the relationship of the points and/or lines shown hereon to either lines of record, control lines, or to each other. The Deputy County Surveyor does not claim at this time, that the points or lines shown hereon are true centerline, boundary, dead, or control points or lines. Without further analysis, the interpretation of these notes is left to the discretion of the user.


G.K. Shelton
Deputy County Surveyor

By

Supervising Land Surveyor

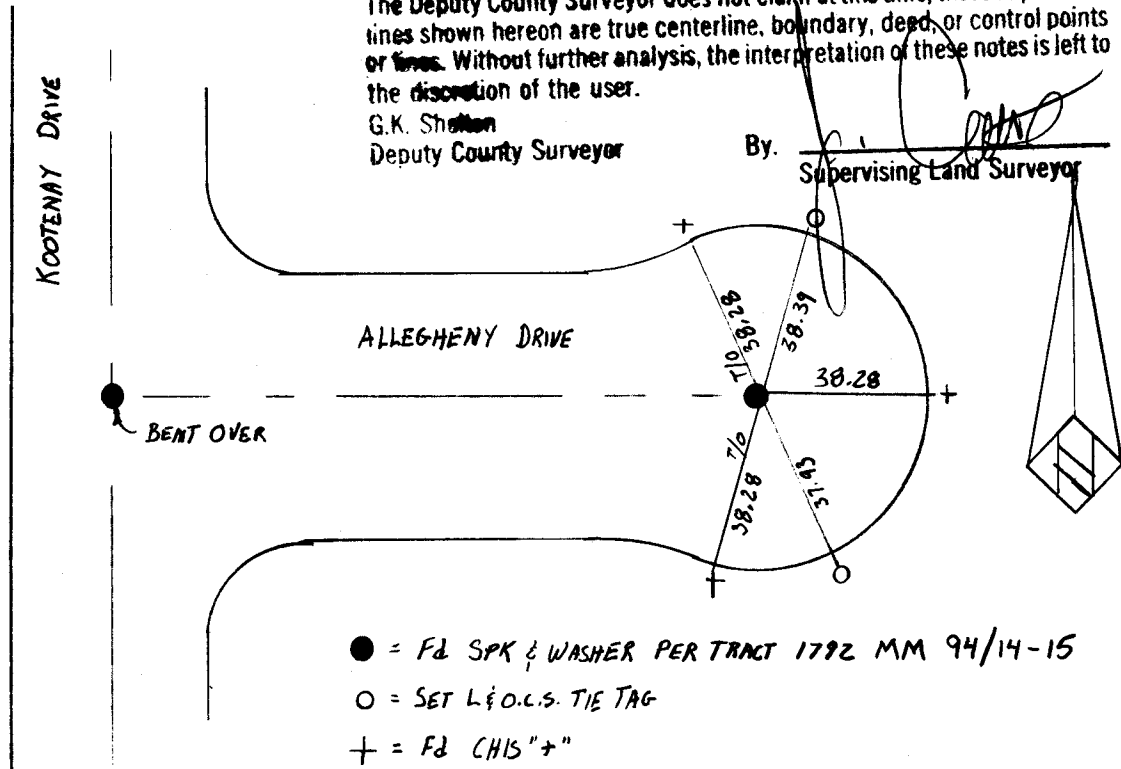

SET PUN CUT SPK &
- O.C.S. TAG ON A.C. SURF-
ACE, 6-13-86

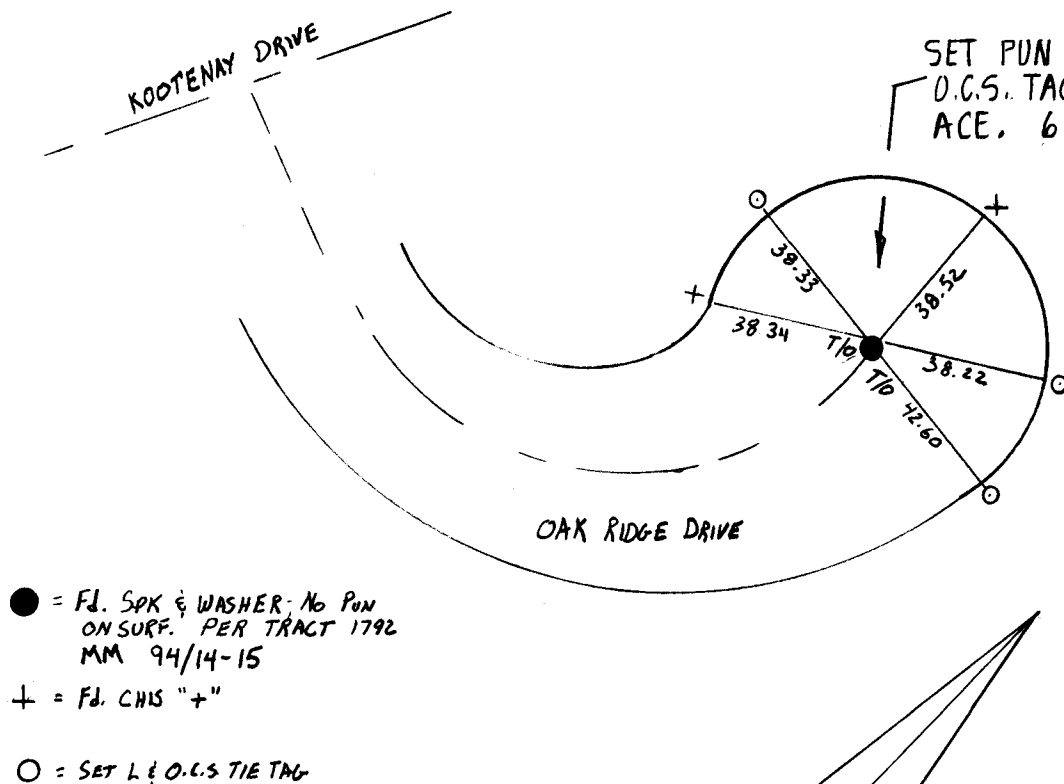

STREET RESURFACING "B"

PAGE 7 OF 13

SURVEY BY


MINICH

NOTES RAYMOND

DATE

DEC. 85

ORANGE COUNTY SURVEYOR


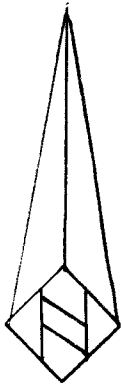


FD. PARTIAL SHANK,
SET SPK & O.C.S.
TAG ON SURFACE
PER TIES. 6-13-86.

● = Fd. SPK; NO PUN
PER A/5-9 143

+ = Fd. CHIS "+"

() = PER RECORD A/5-9
PG. 143

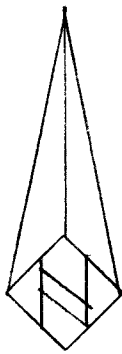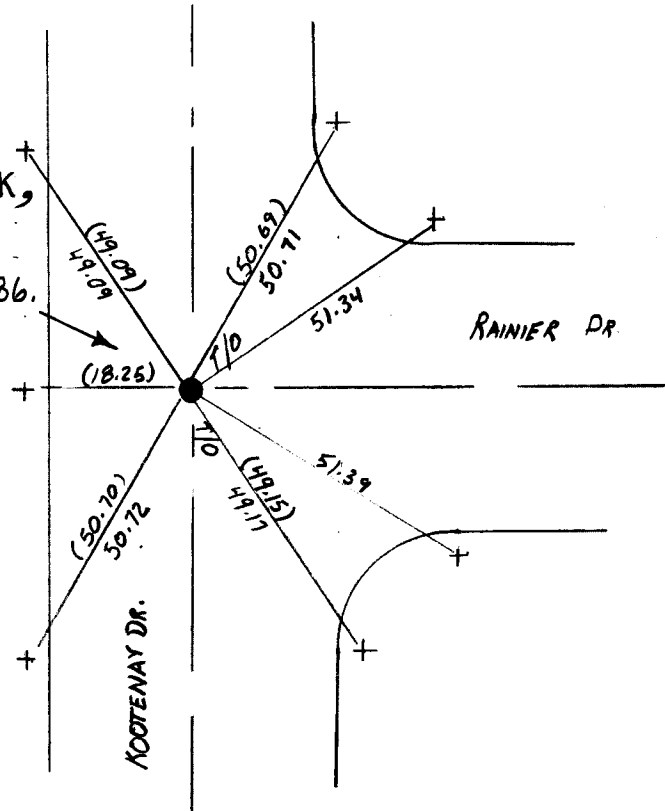


● = Fd. SPK & WASHER NO PUN.
PER A/5-9 143

+ = Fd. CHIS "+"

() = PER RECORD A/5-9
PG. 143

○ SET LEAD & O.C.S. TIE TAG
6-13-86

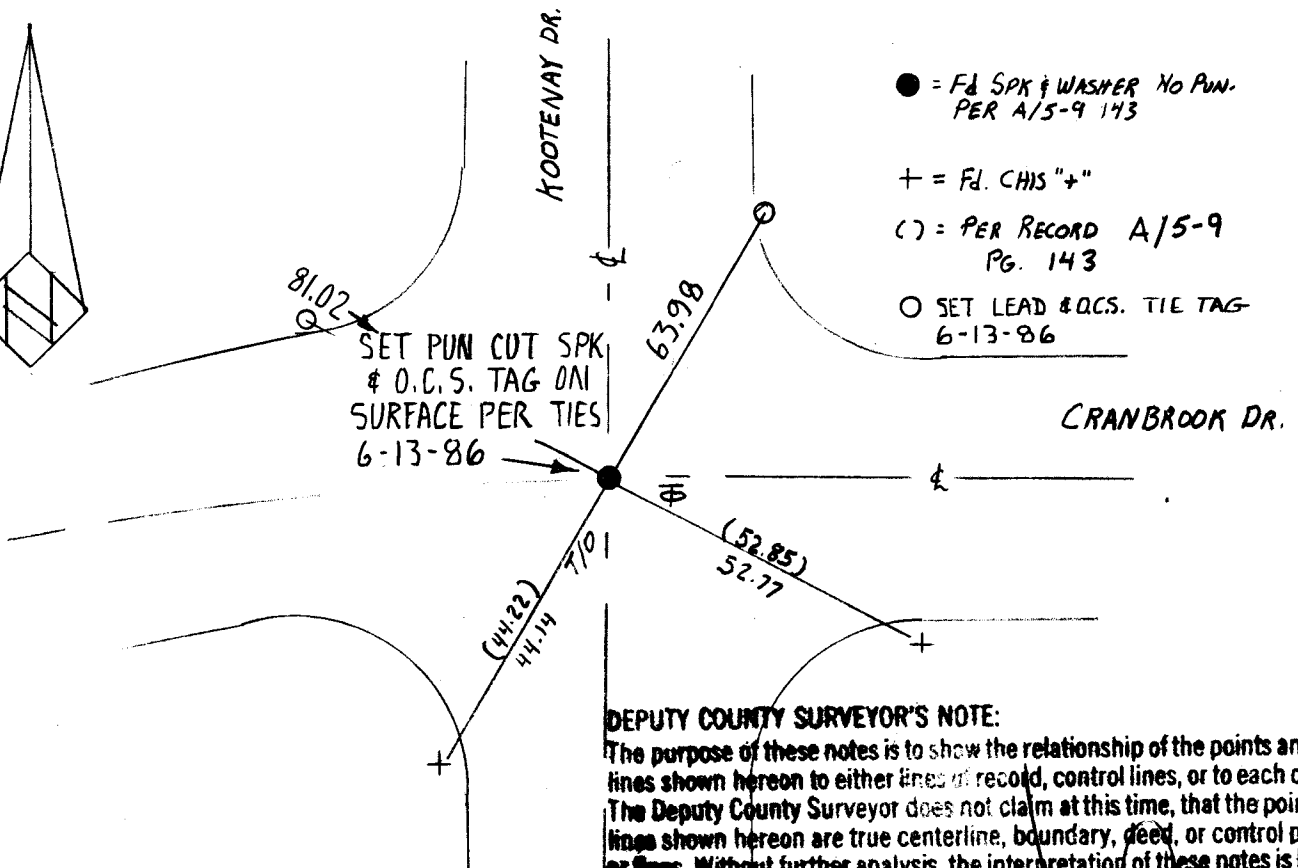

DEPUTY COUNTY SURVEYOR'S NOTE:

The purpose of these notes is to show the relationship of the points and/or lines shown hereon to either lines of record, control lines, or to each other. The Deputy County Surveyor does not claim at this time, that the points or lines shown hereon are true centerline, boundary, deed, or control points or lines. Without further analysis, the interpretation of these notes is left to the discretion of the user.

G.K. Shellen
Deputy County Surveyor


By.

Supervising Land Surveyor


MINICH NOTES RAYMOND

DATE DEC. 85

ORANGE COUNTY SURVEYOR

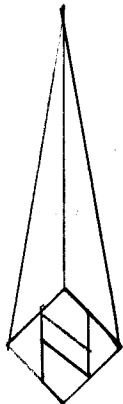

NO SCALE


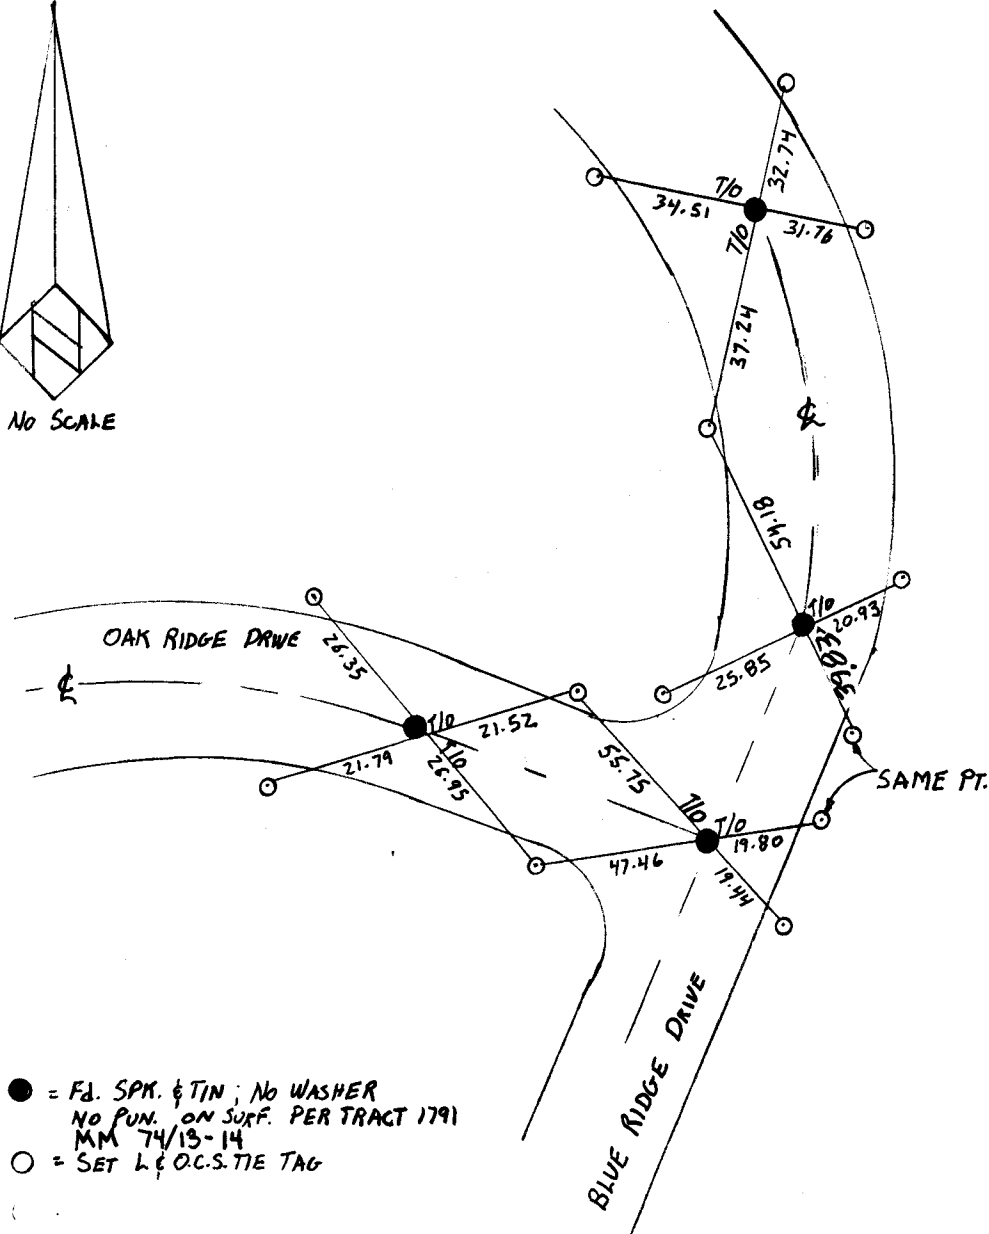


DEPUTY COUNTY SURVEYOR'S NOTE:

The purpose of these notes is to show the relationship of the points and/or lines shown hereon to either lines of record, control lines, or to each other. The Deputy County Surveyor does not claim at this time, that the points or lines shown hereon are true centerline, boundary, deed, or control points or lines. Without further analysis, the interpretation of these notes is left to the discretion of the user.

G.K. Shelton
Deputy County Surveyor

By.
Supervising Land Surveyor

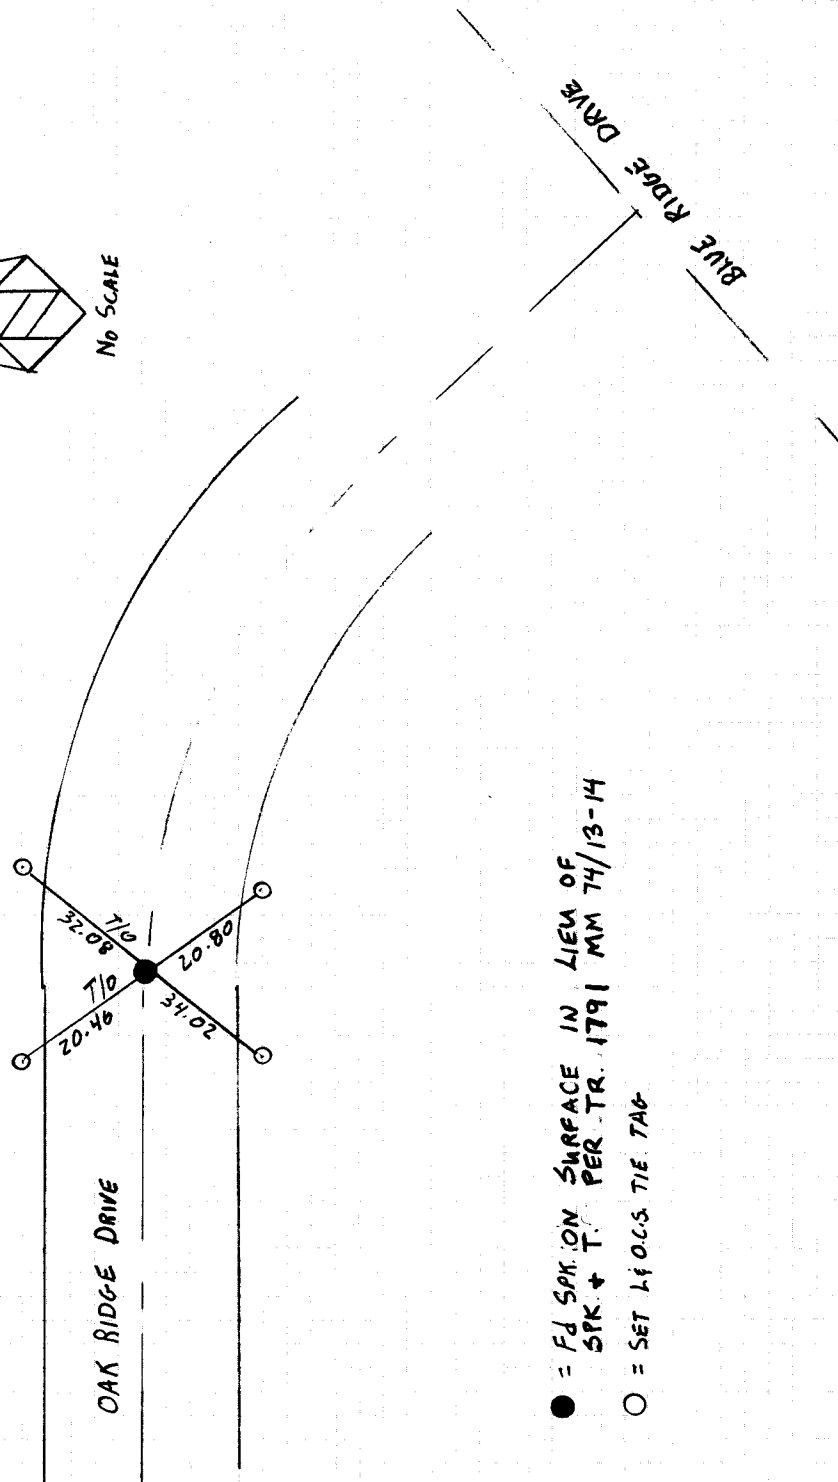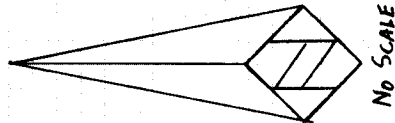**DEPUTY COUNTY SURVEYOR'S NOTE:**

The purpose of these notes is to show the relationship of the points and/or lines shown hereon to either lines of record, control lines, or to each other. The Deputy County Surveyor does not claim at this time, that the points or lines shown hereon are true centerline, boundary, deed, or control points or lines. Without further analysis, the interpretation of these notes is left to the discretion of the user.

G.K. Shelton
Deputy County Surveyor

By.

Supervising Land Surveyor

SURVEY OF STREET RESURFACING "B"



INDEX

PAGE 10 OF 13

SURVEYED BY MINICH NOTES RAYMOND


DATE DEC. 85

ORANGE COUNTY SURVEYOR

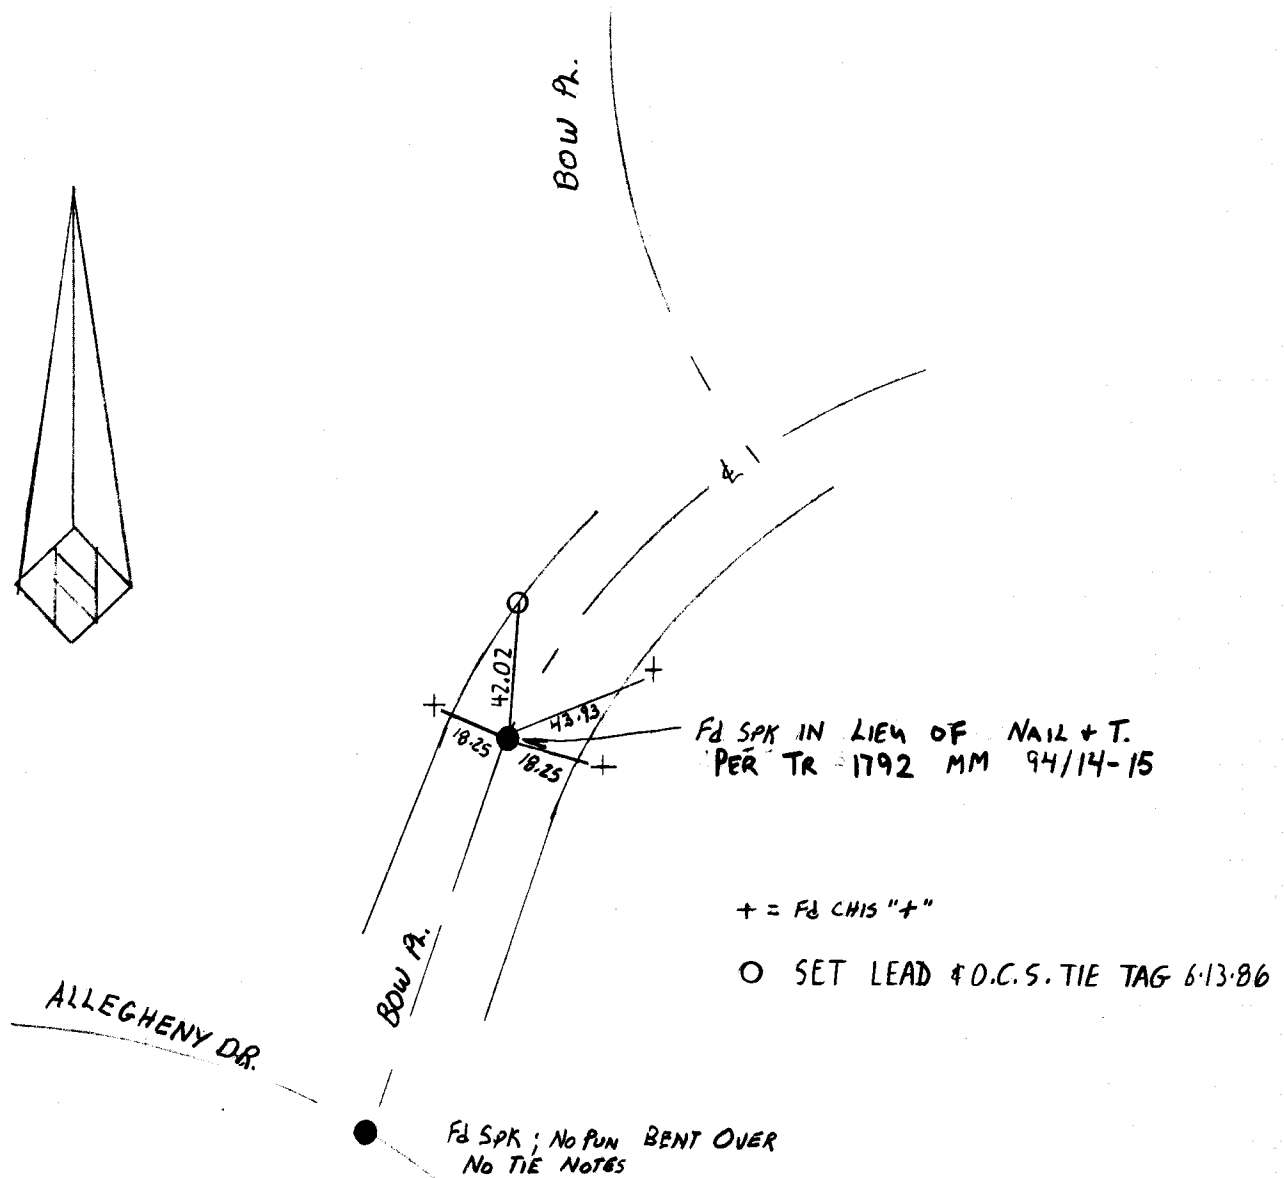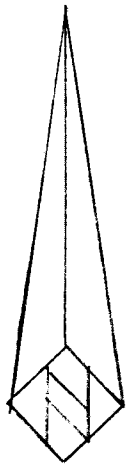**DEPUTY COUNTY SURVEYOR'S NOTE:**

The purpose of these notes is to show the relationship of the points and/or lines shown hereon to either lines of record, control lines, or to each other. The Deputy County Surveyor does not claim at this time, that the points or lines shown hereon are true centerline, boundary, deed, or control points or lines. Without further analysis, the interpretation of these notes is left to the discretion of the user.

G.K. Shotton
Deputy County Surveyor

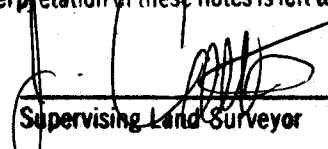
By. 
Supervising Land Surveyor





SURVEY OF STREET RESURFACING "B"

MINICH NOTES RAYMOND

DATE DEC. 85

ORANGE COUNTY SURVEYOR

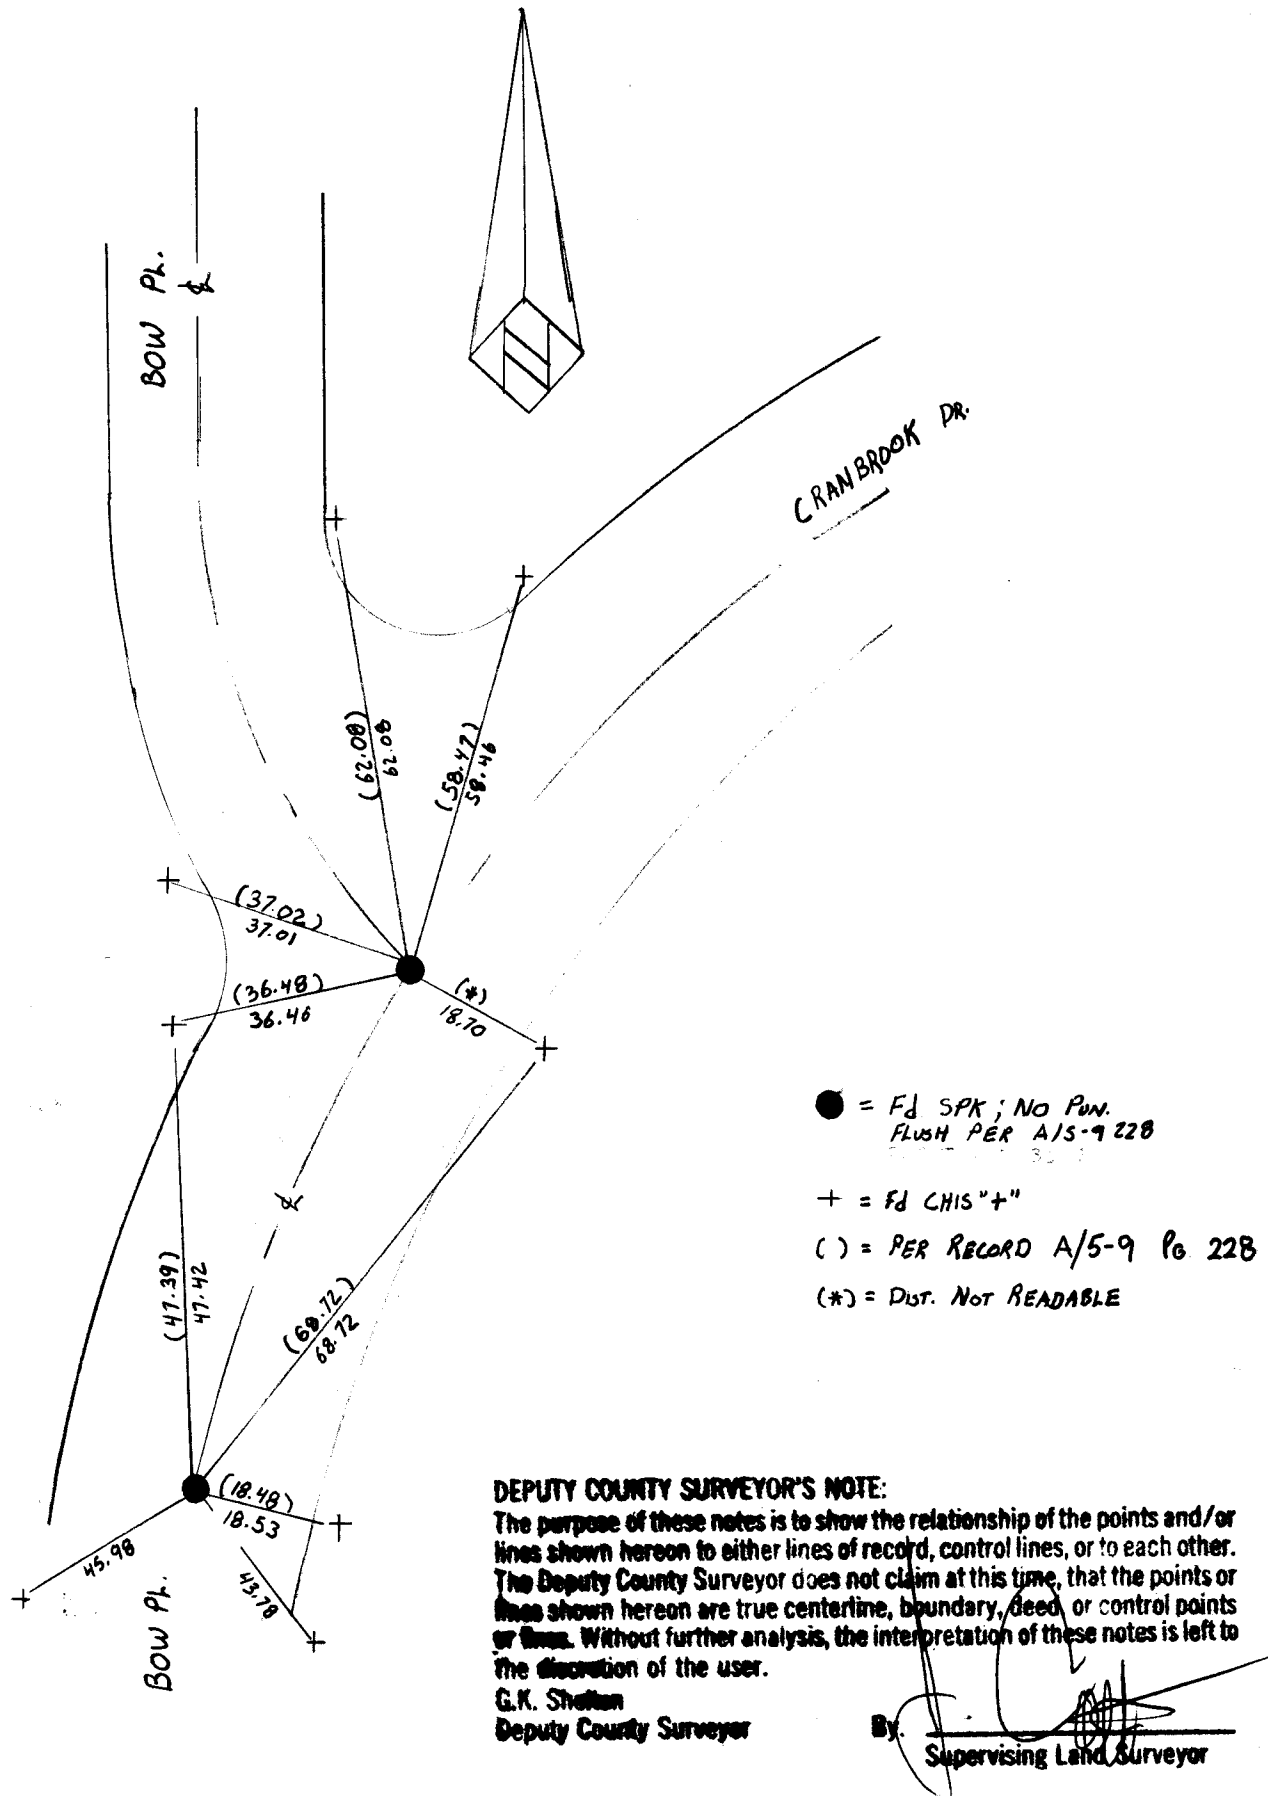

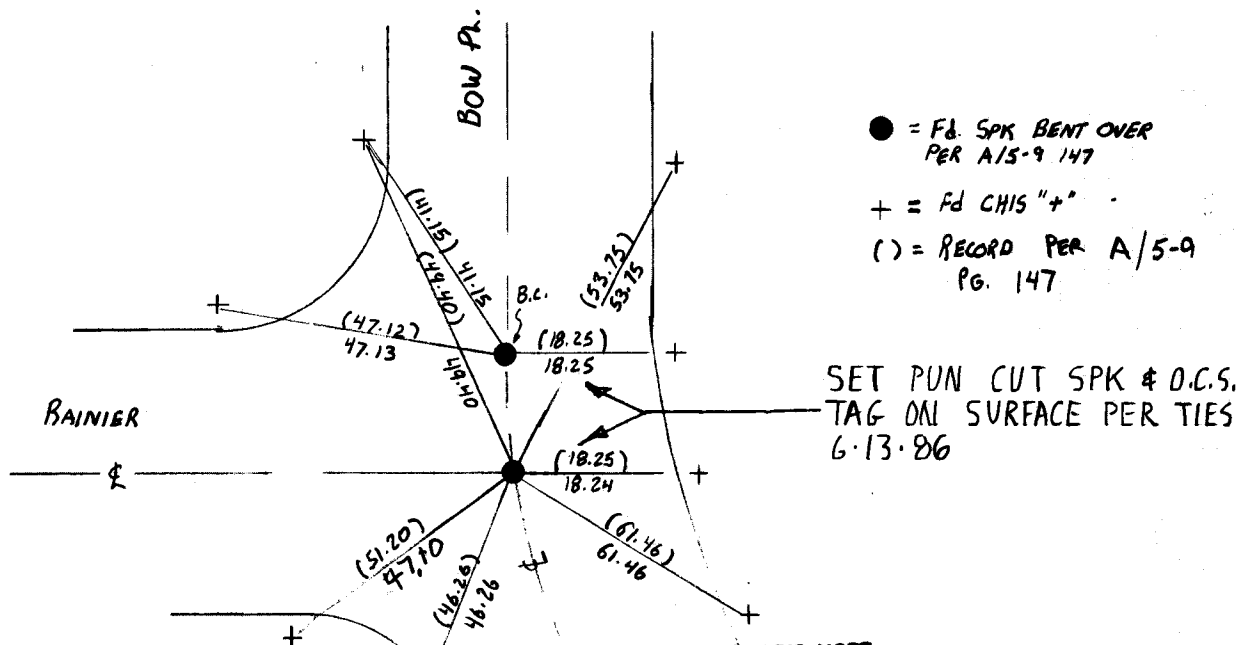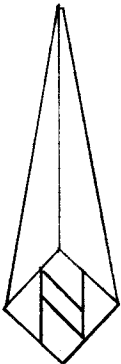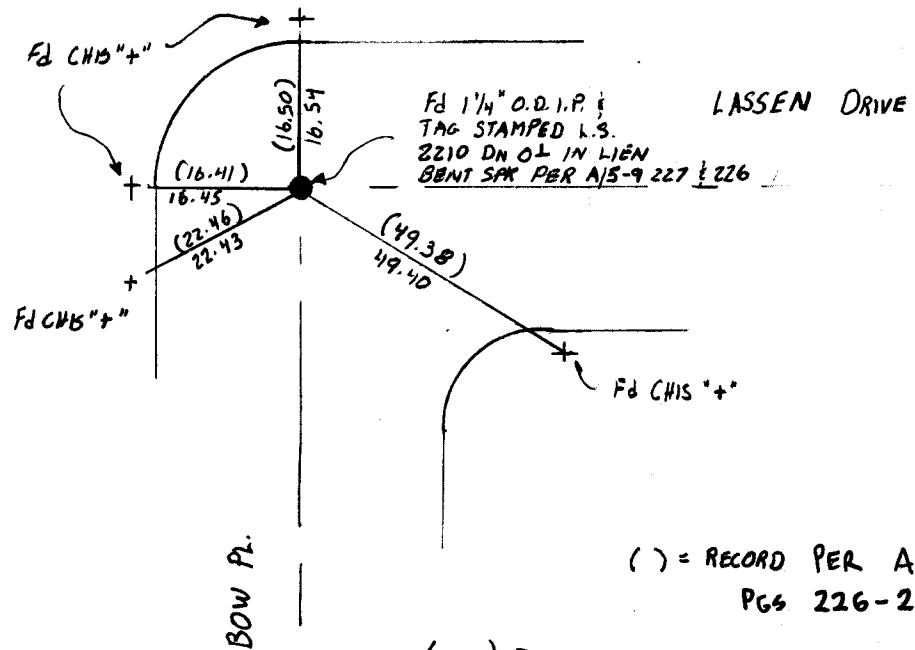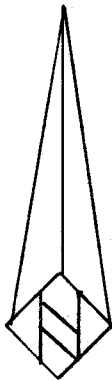


DEPUTY COUNTY SURVEYOR'S NOTE:

The purpose of these notes is to show the relationship of the points and/or lines shown hereon to either lines of record, control lines, or to each other. The Deputy County Surveyor does not claim at this time, that the points or lines shown hereon are true centerline, boundary, deed, or control points or lines. Without further analysis, the interpretation of these notes is left to the discretion of the user.

G.K. Shelton
 Deputy County Surveyor

By
 Supervising Land Surveyor

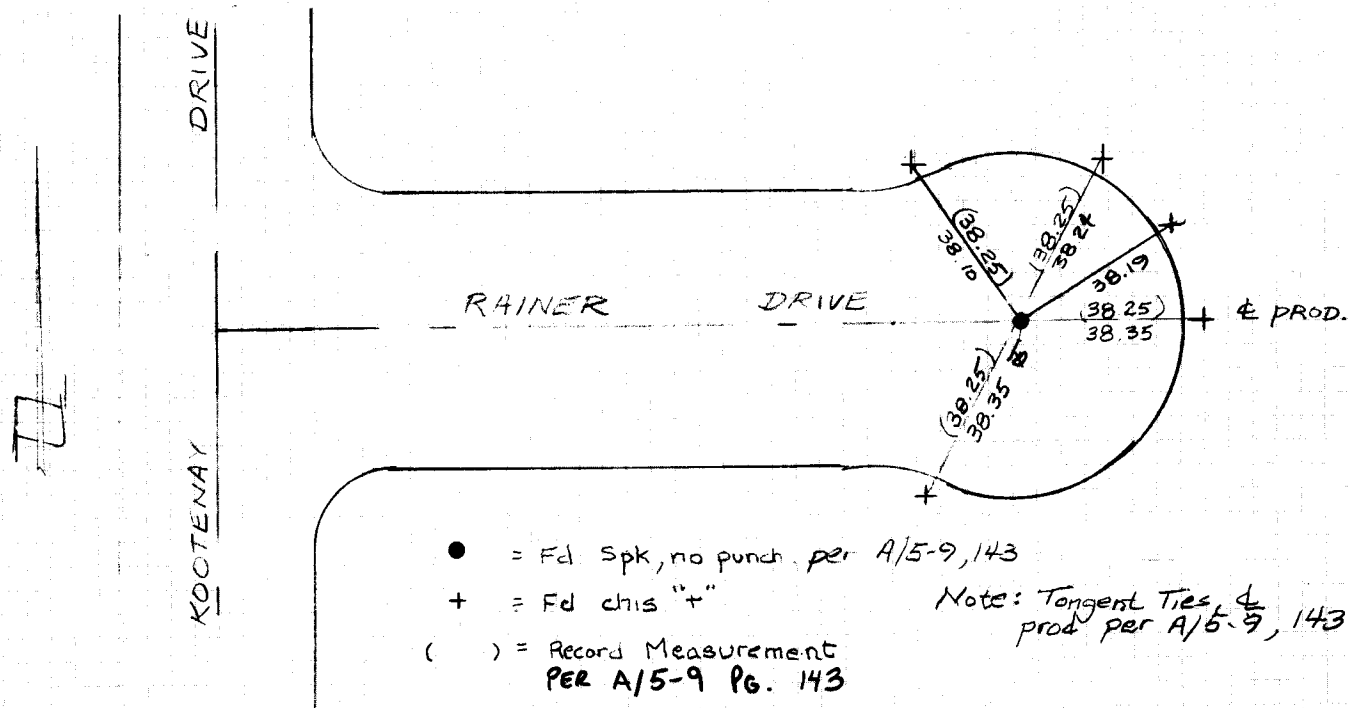**DEPUTY COUNTY SURVEYOR'S NOTE:**

The purpose of these notes is to show the relationship of the points and/or lines shown hereon to either lines of record, control lines, or to each other. The Deputy County Surveyor does not claim at this time, that the points or lines shown hereon are true centerline, boundary, deed, or control points or lines. Without further analysis, the interpretation of these notes is left to the discretion of the user.

G.K. Shelton
 Deputy County Surveyor

By:
 Supervising Land Surveyor

