


SURVEYED BY **Boyle Engineering** DATE **11-27-63** ORANGE COUNTY SURVEYOR

THESE NOTES NOT FIELD CHECKED
 BY ORANGE COUNTY SURVEYOR

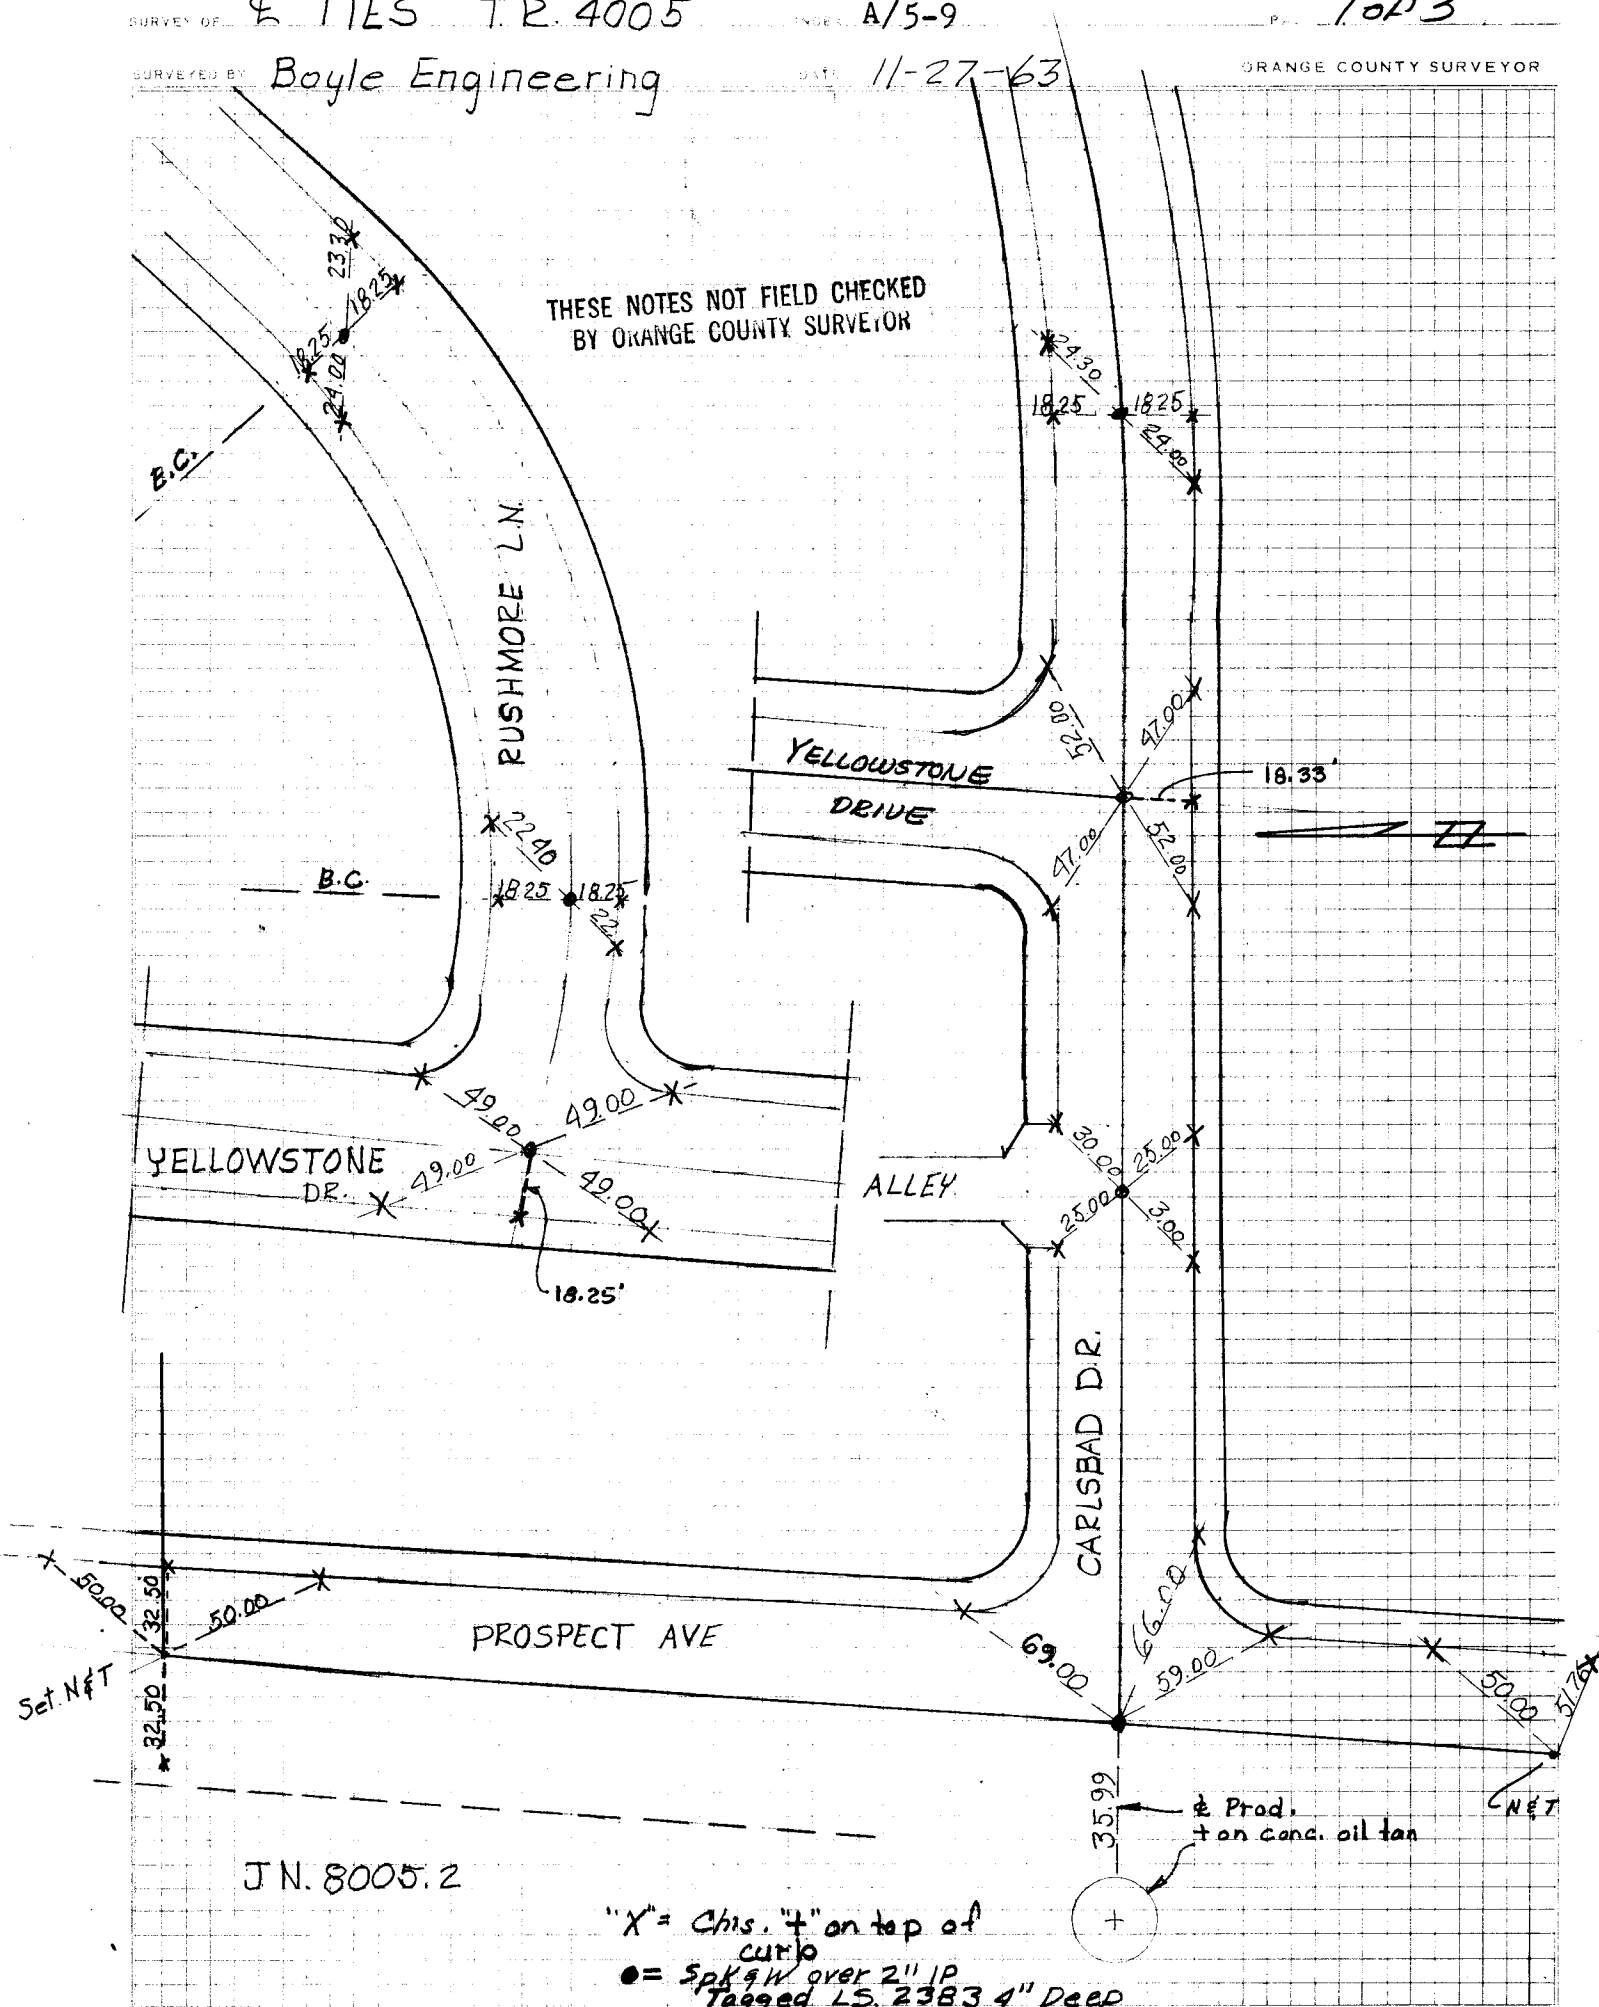


"X" = Chis. "t" on top of curb
 • = Spk #11 over 2" IP
 Tagged L.S. 2383 4" Deep

SURVEY OF **4 TIES T.R. 4005**
County of Orange
SURVEYED BY **Boyle Engineering**

INDEX
DATE **11-27-63**

443
PAGE **2 of 3**
ORANGE COUNTY SURVEYOR


THESE NOTES NOT FIELD CHECKED
BY ORANGE COUNTY SURVEYOR

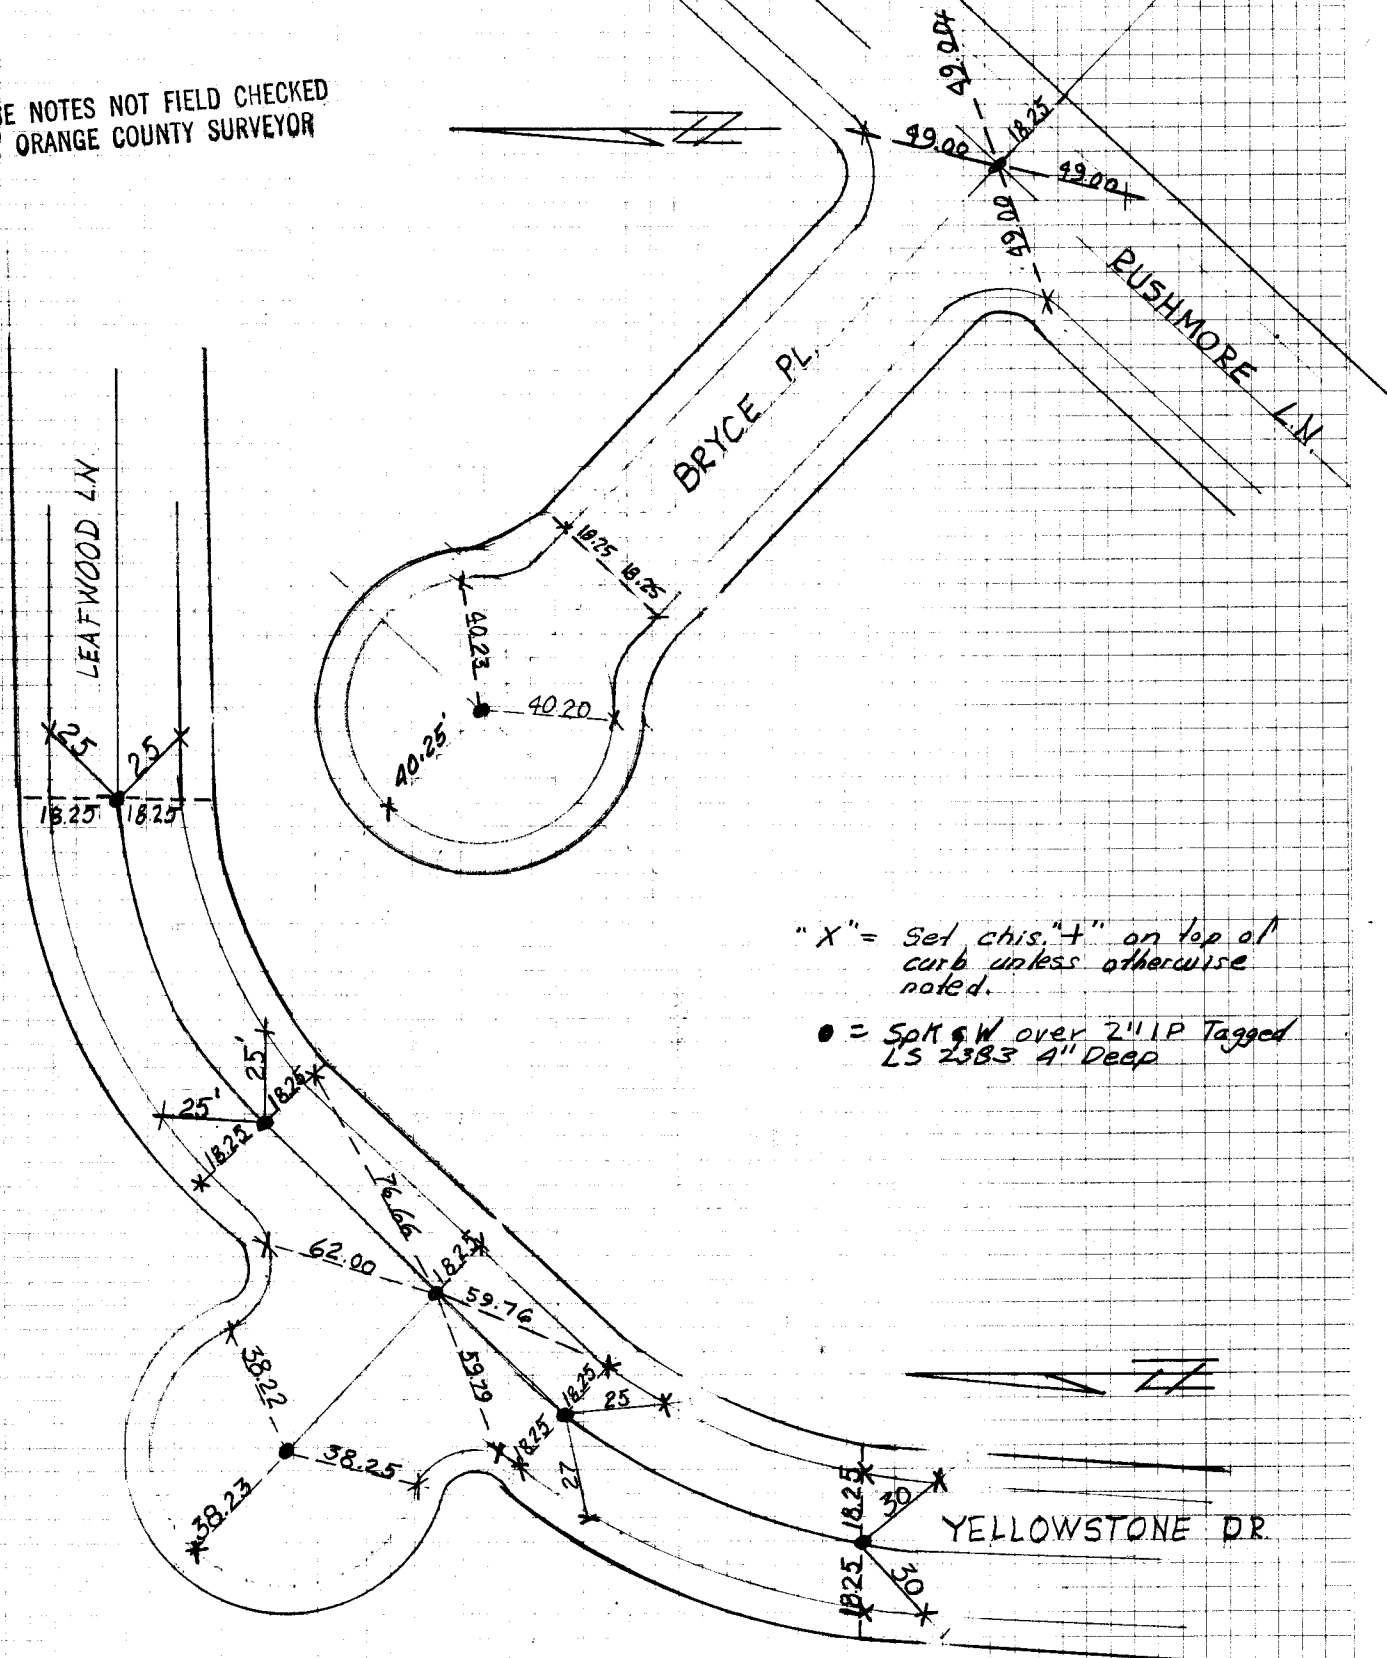

"X" = Set chis. "t" on top of curb unless otherwise noted.
• = Spk & W over 2" IP Tagged LS 2383 4" Deep

J.N. 8005.2

ORANGE COUNTY SURVEYOR

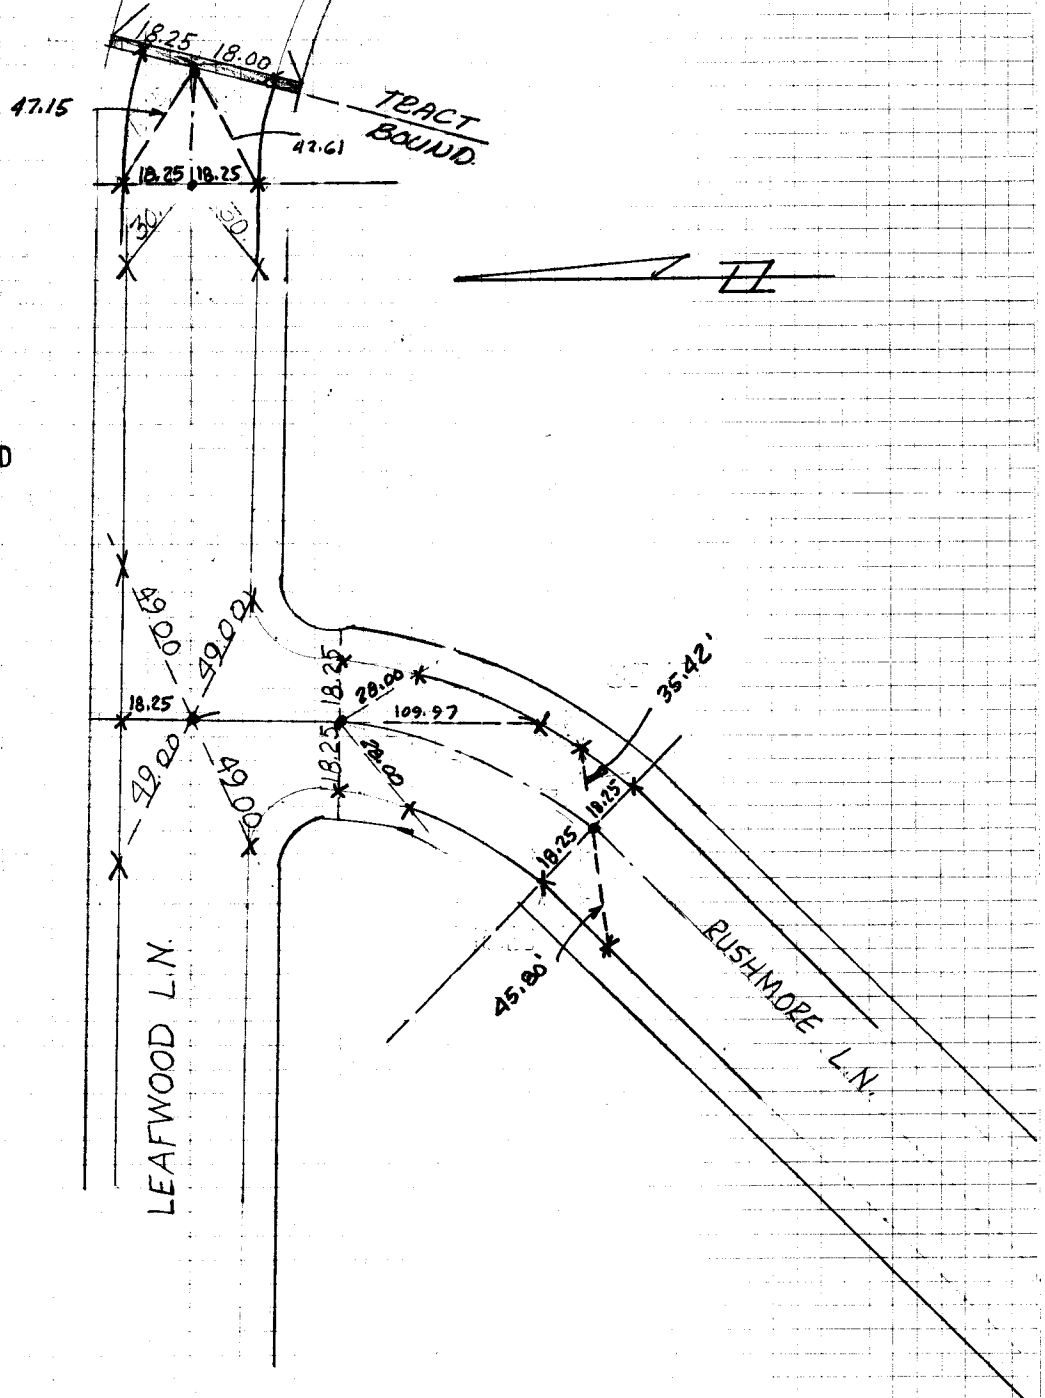

J.N. 8005.2