



Received from

SURVEYED BY Boyle Engineering


DATE Oct. 17, 1962

ORANGE COUNTY SURVEYOR

THESE NOTES NOT FIELD CHECKED
BY ORANGE COUNTY SURVEYOR

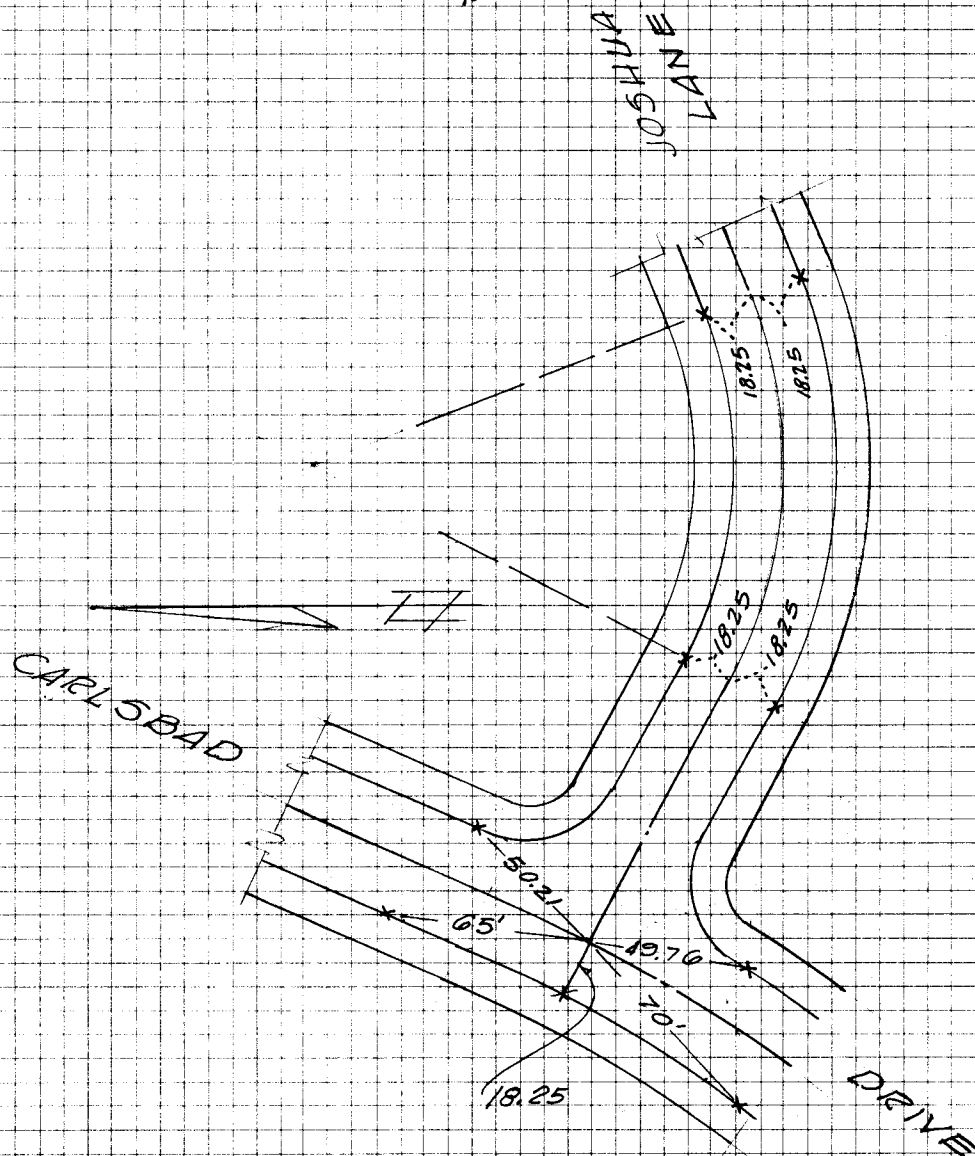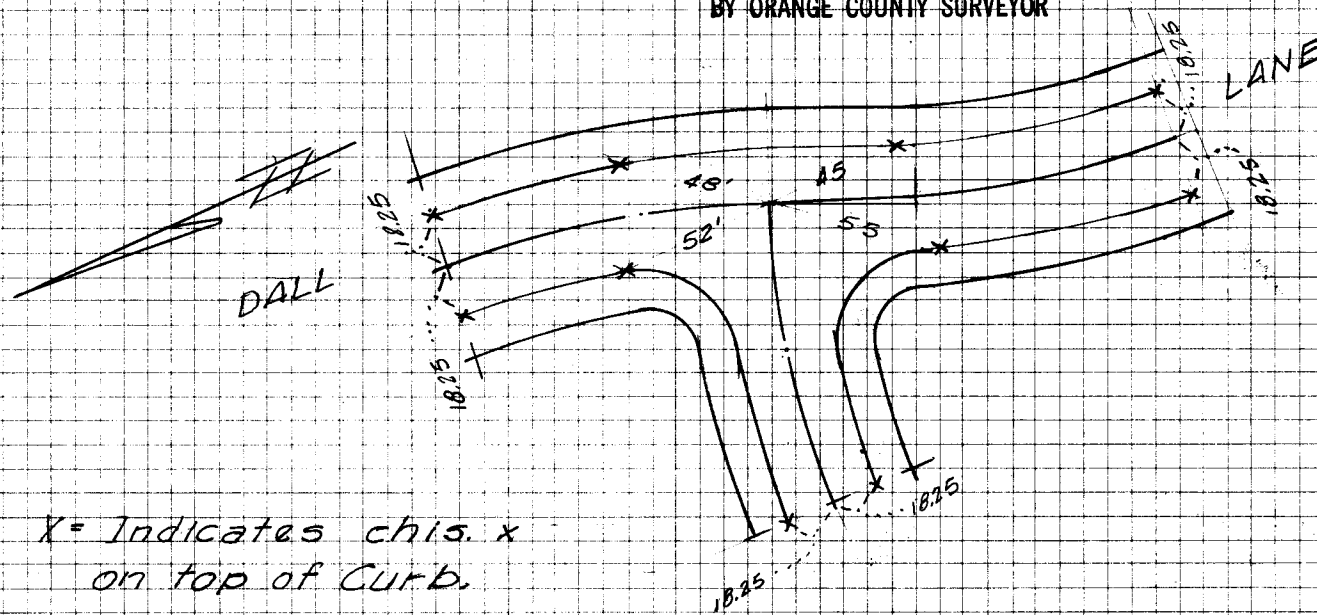

X = Indicates chis. x
on top of Curb.

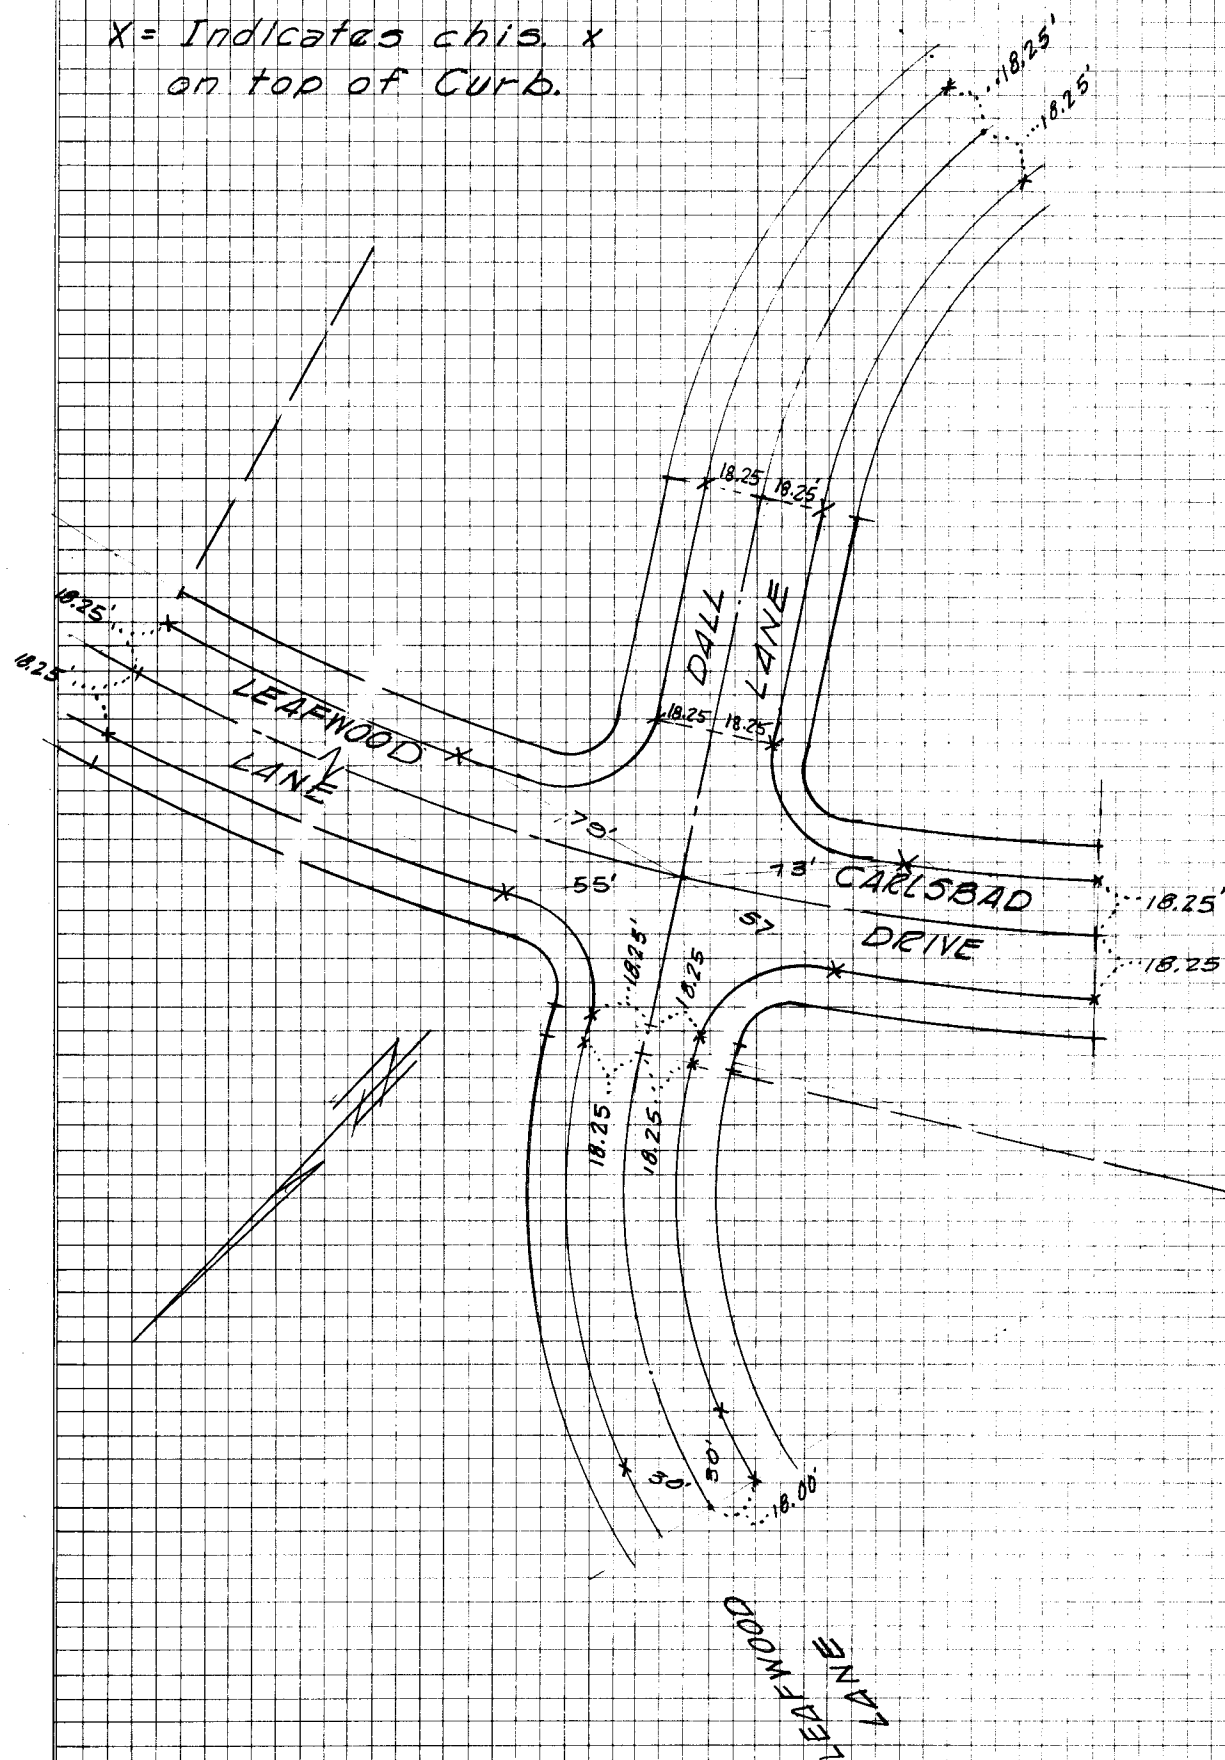

THESE NOTES NOT FIELD CHECKED
BY ORANGE COUNTY SURVEYOR

*x=Indicates chis x
on top of Curb.*

