



Submitted By: C.J. Queyrel LS 2988
12/11/64

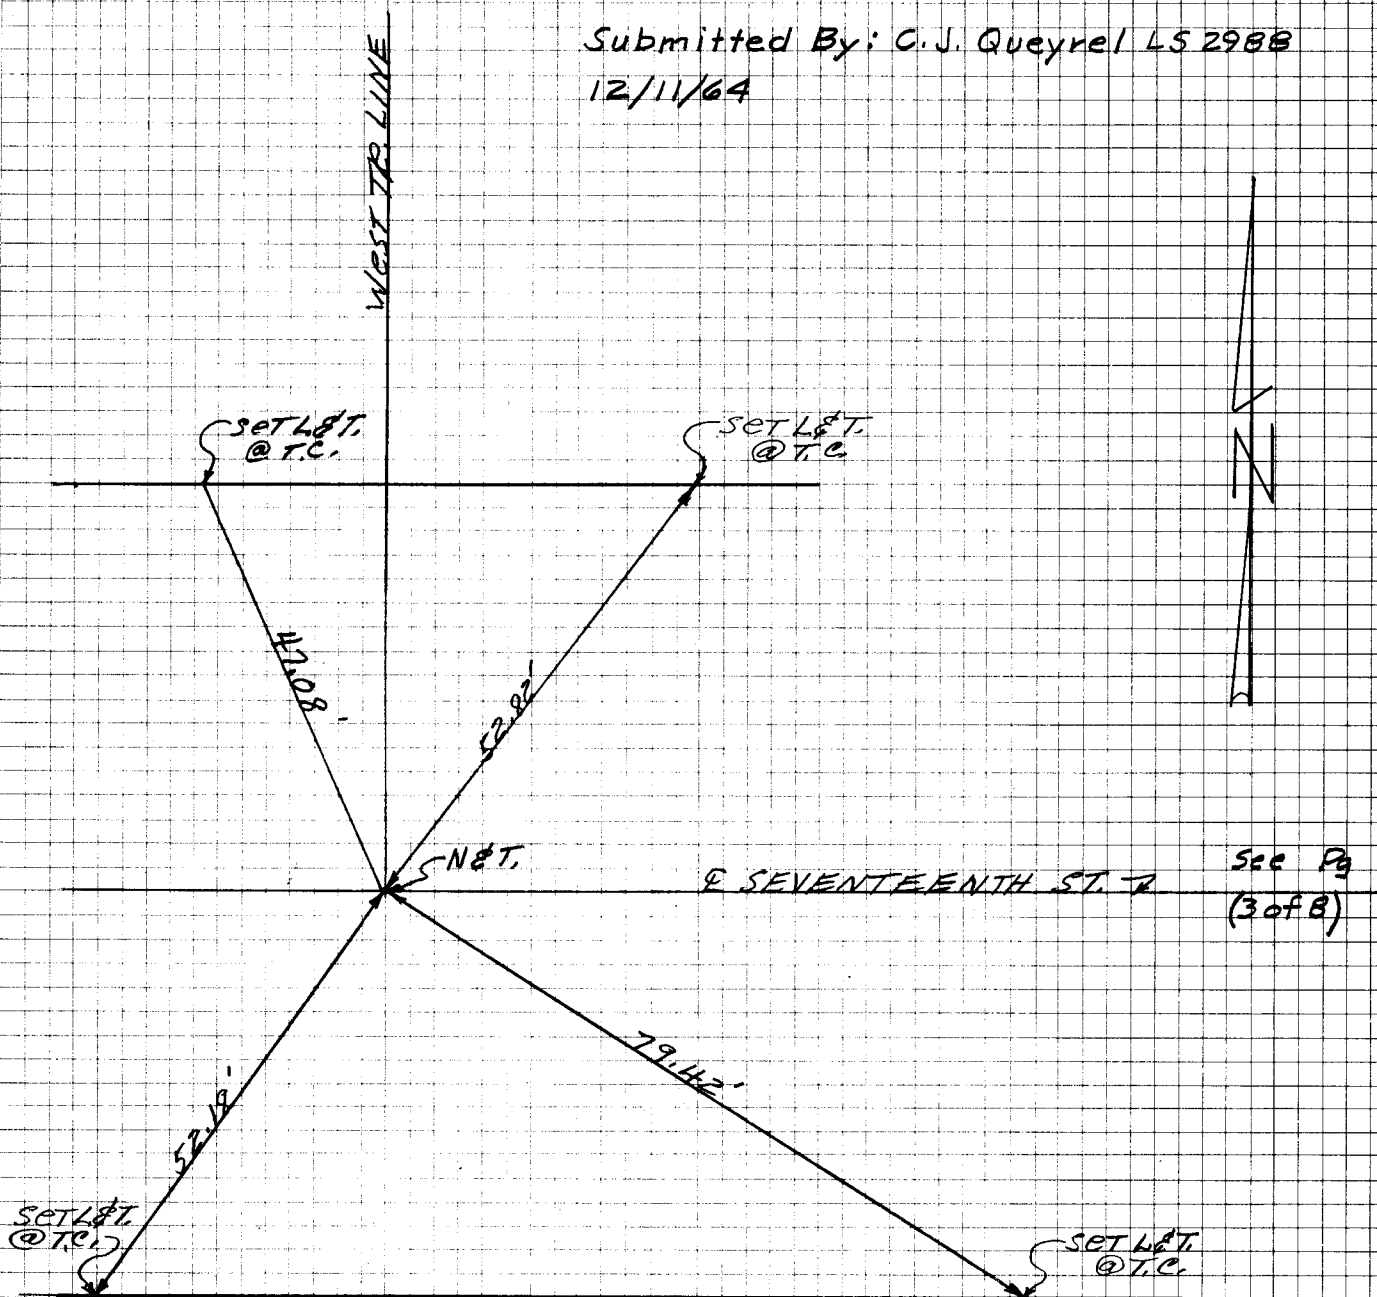


See Pg
(3 of 8)


THESE NOTES NOT FIELD CHECKED
ORANGE COUNTY SURVEYOR

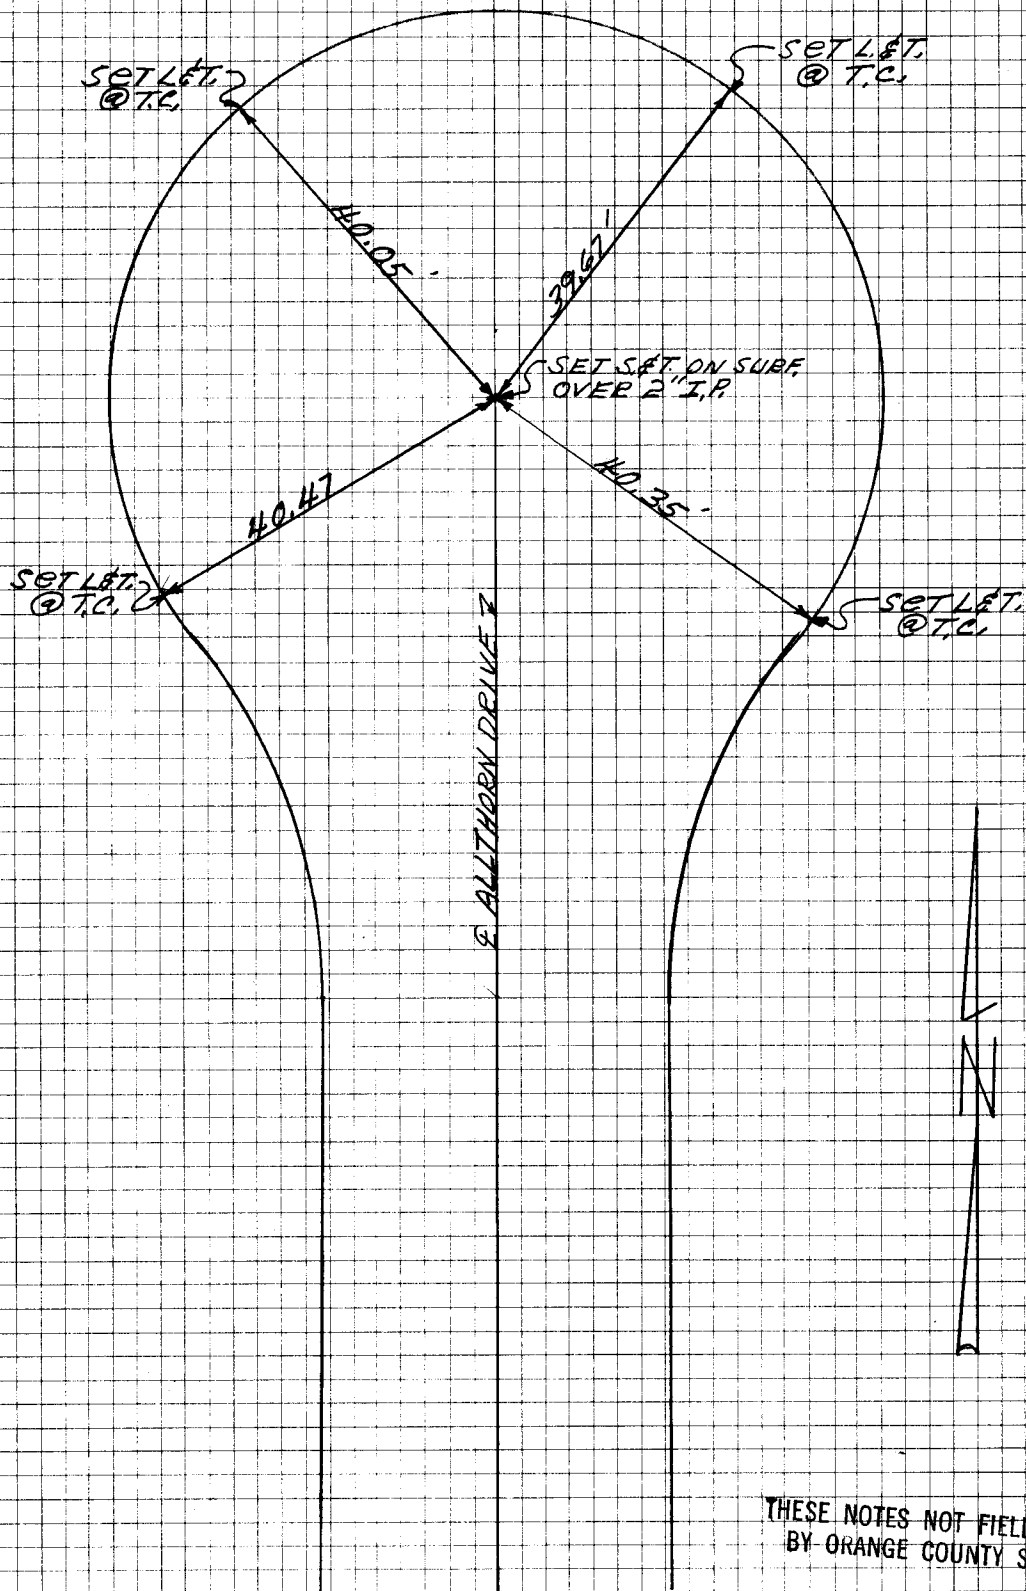


THESE NOTES NOT FIELD CHECKED
BY ORANGE COUNTY SURVEYOR

See Pg
5 of 8

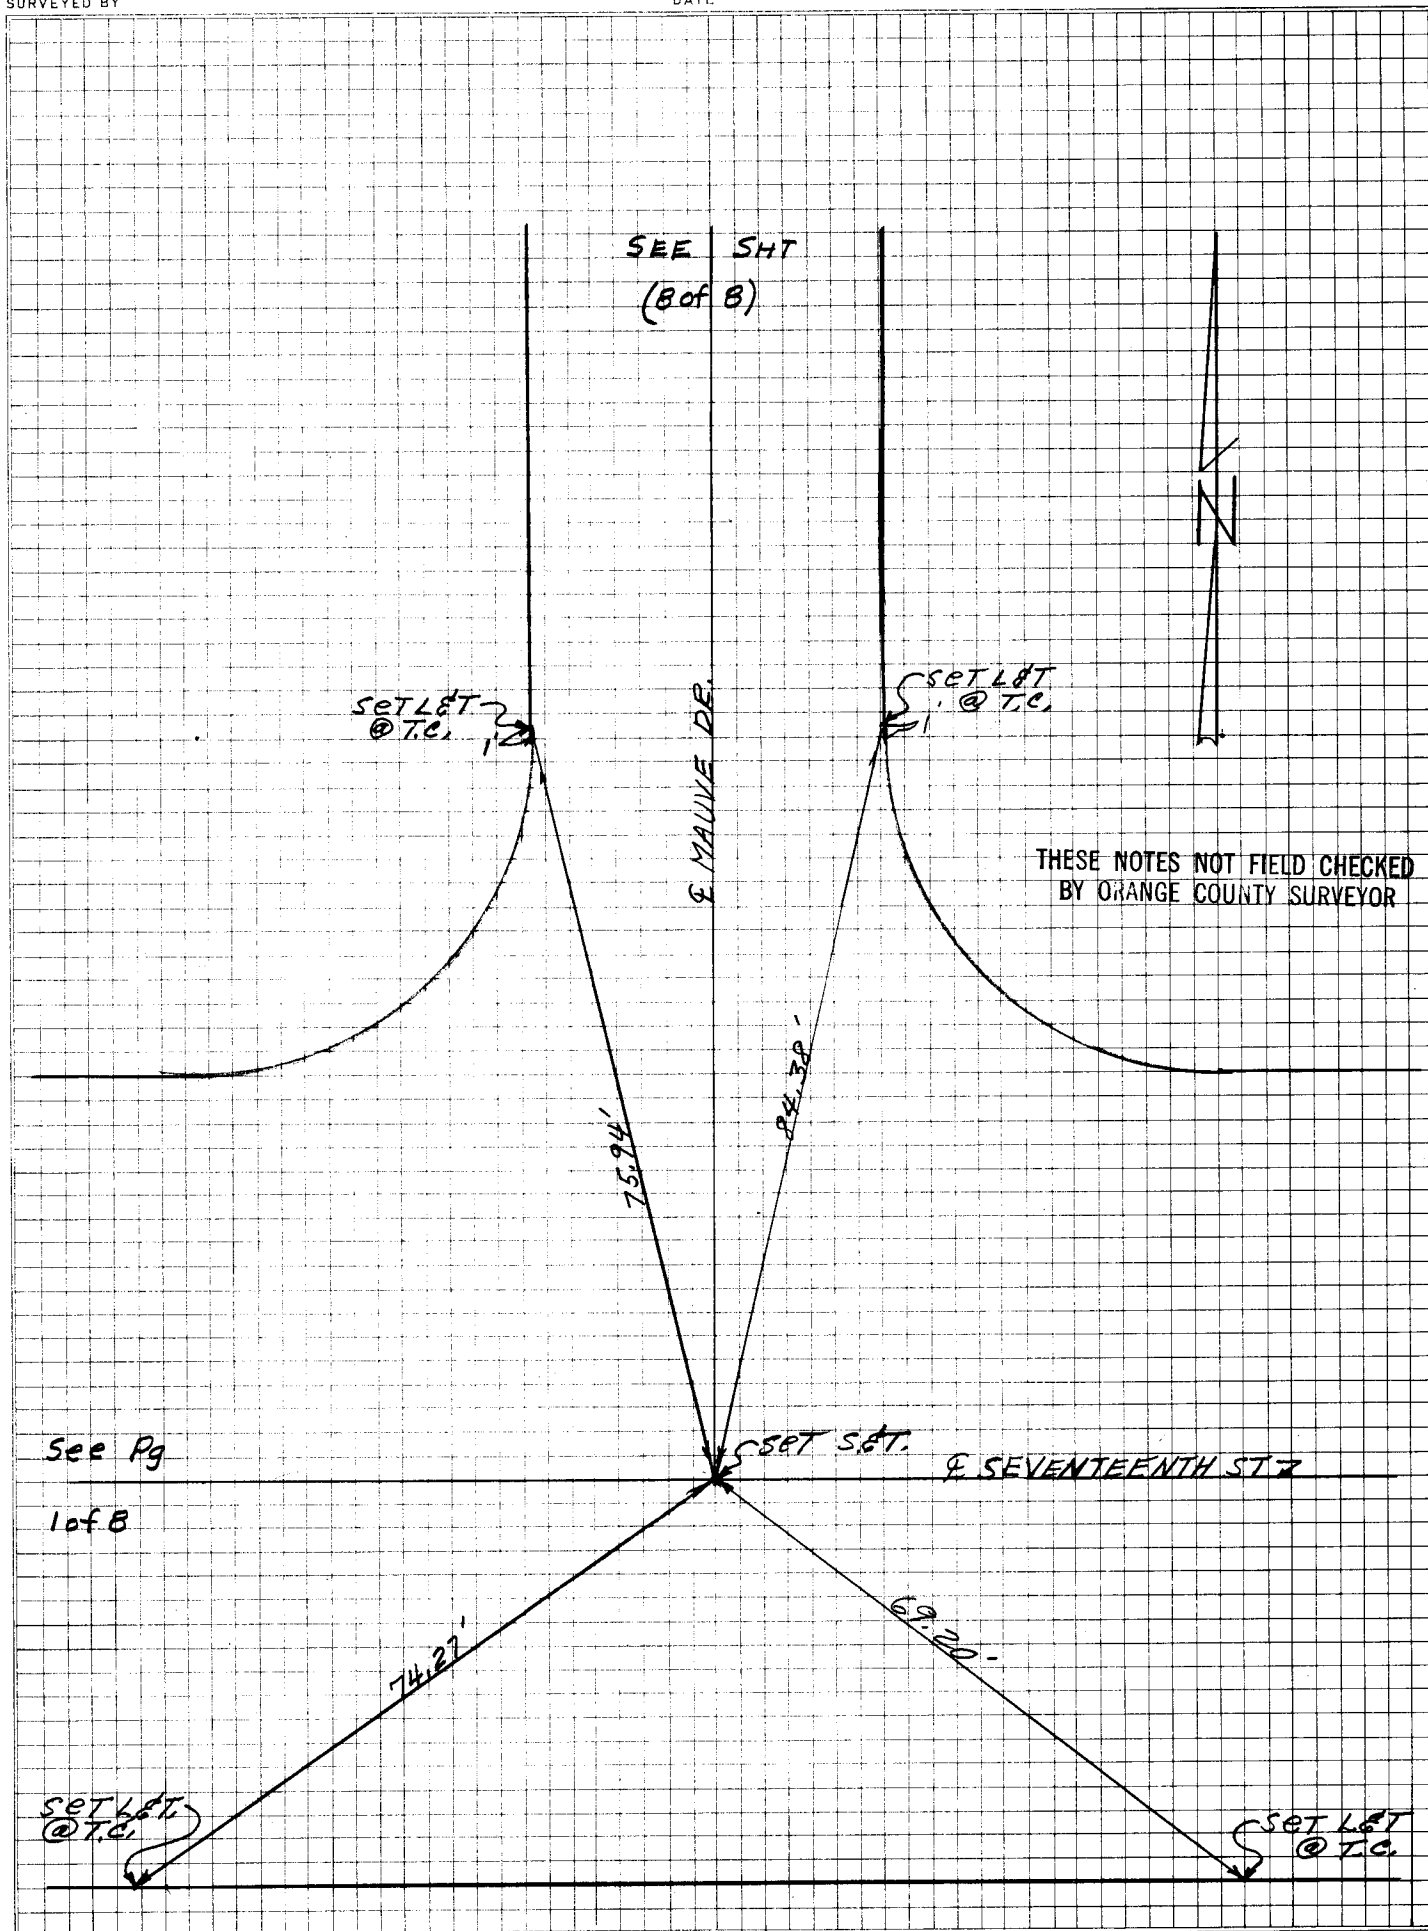

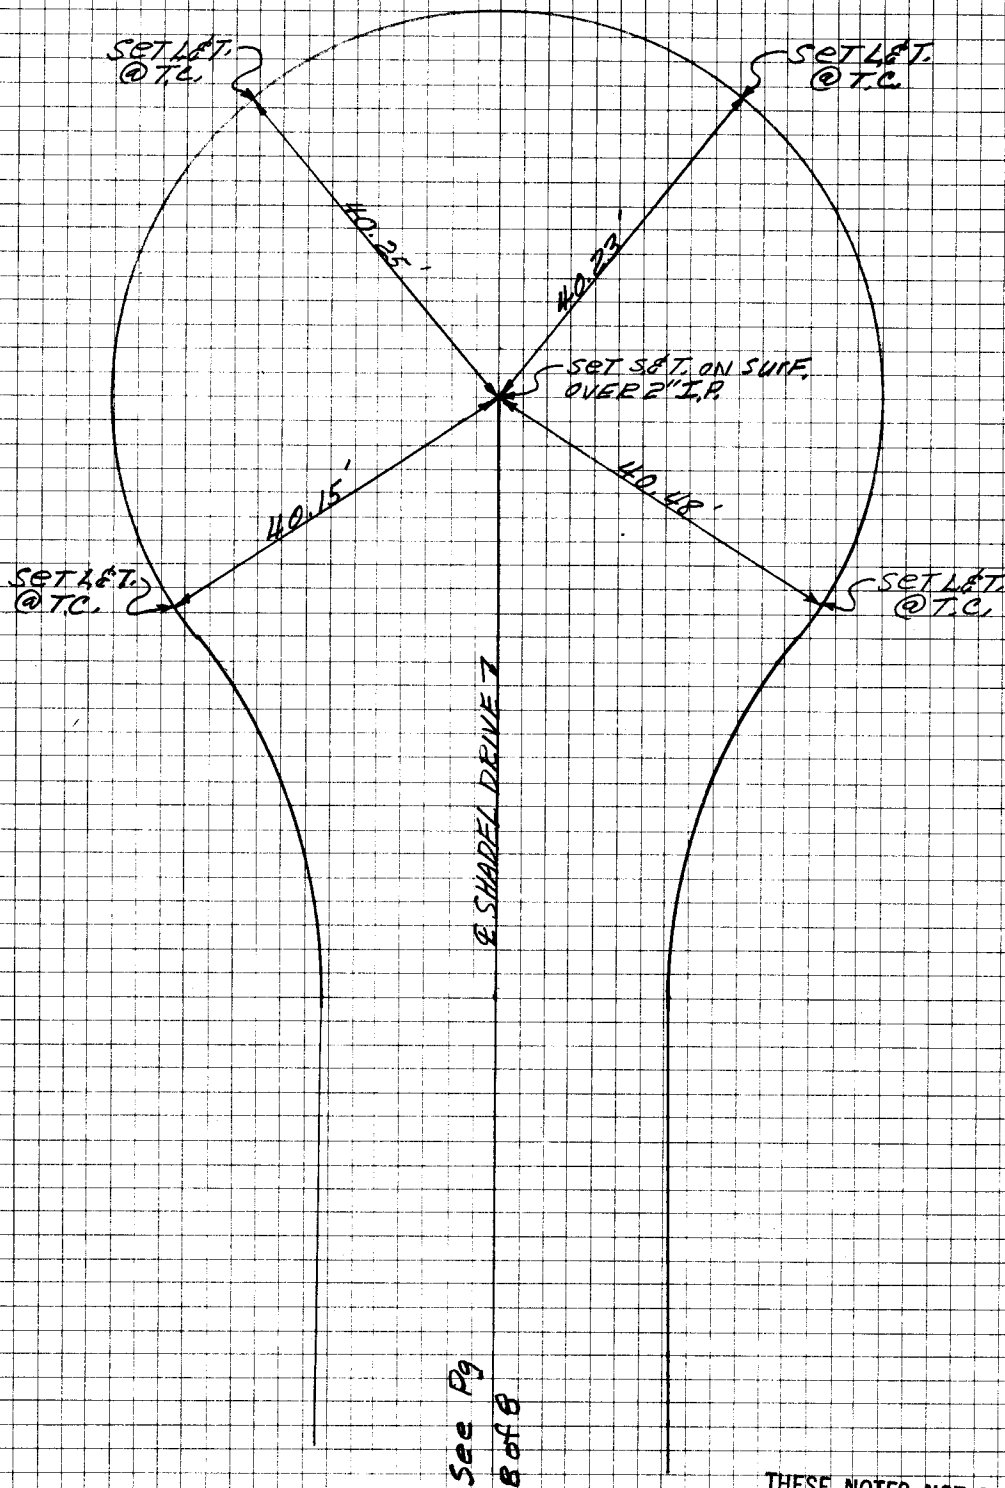


THESE NOTES NOT FIELD CHECKED
BY _____ OR

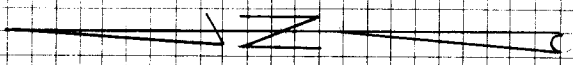


SURVEYED BY


DATE

ORANGE COUNTY SURVEYOR

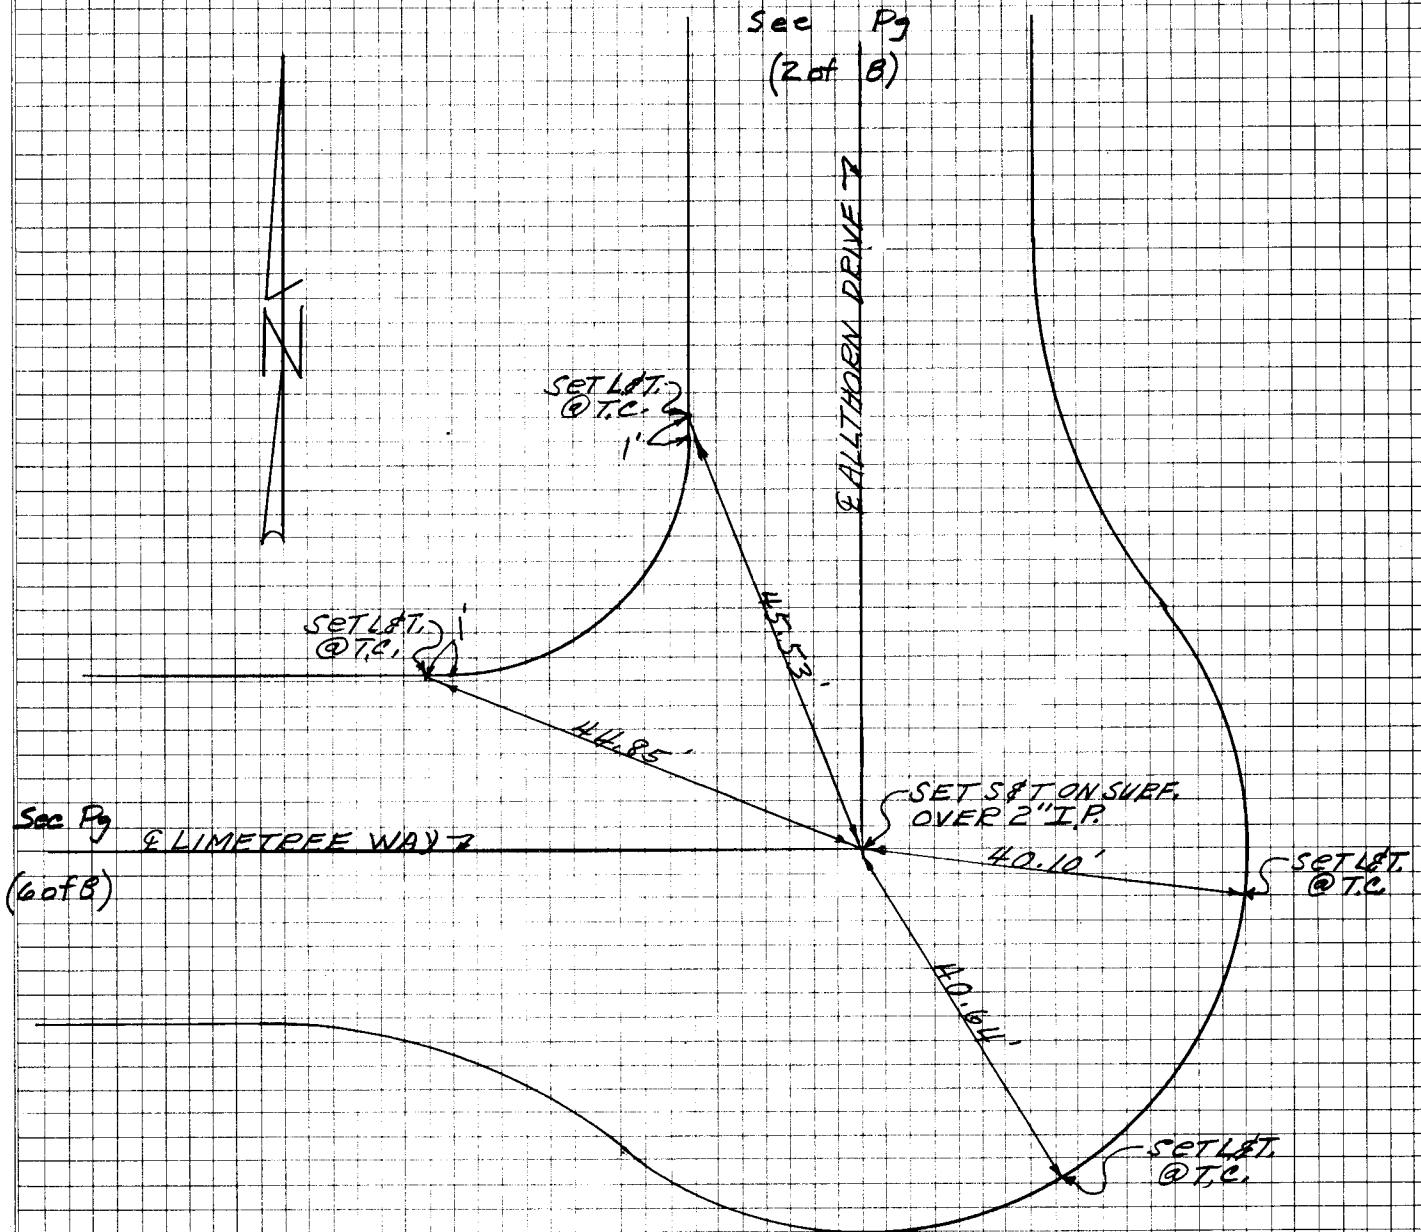

THESE NOTES NOT FIELD CHECKED
BY ORANGE COUNTY SURVEYOR

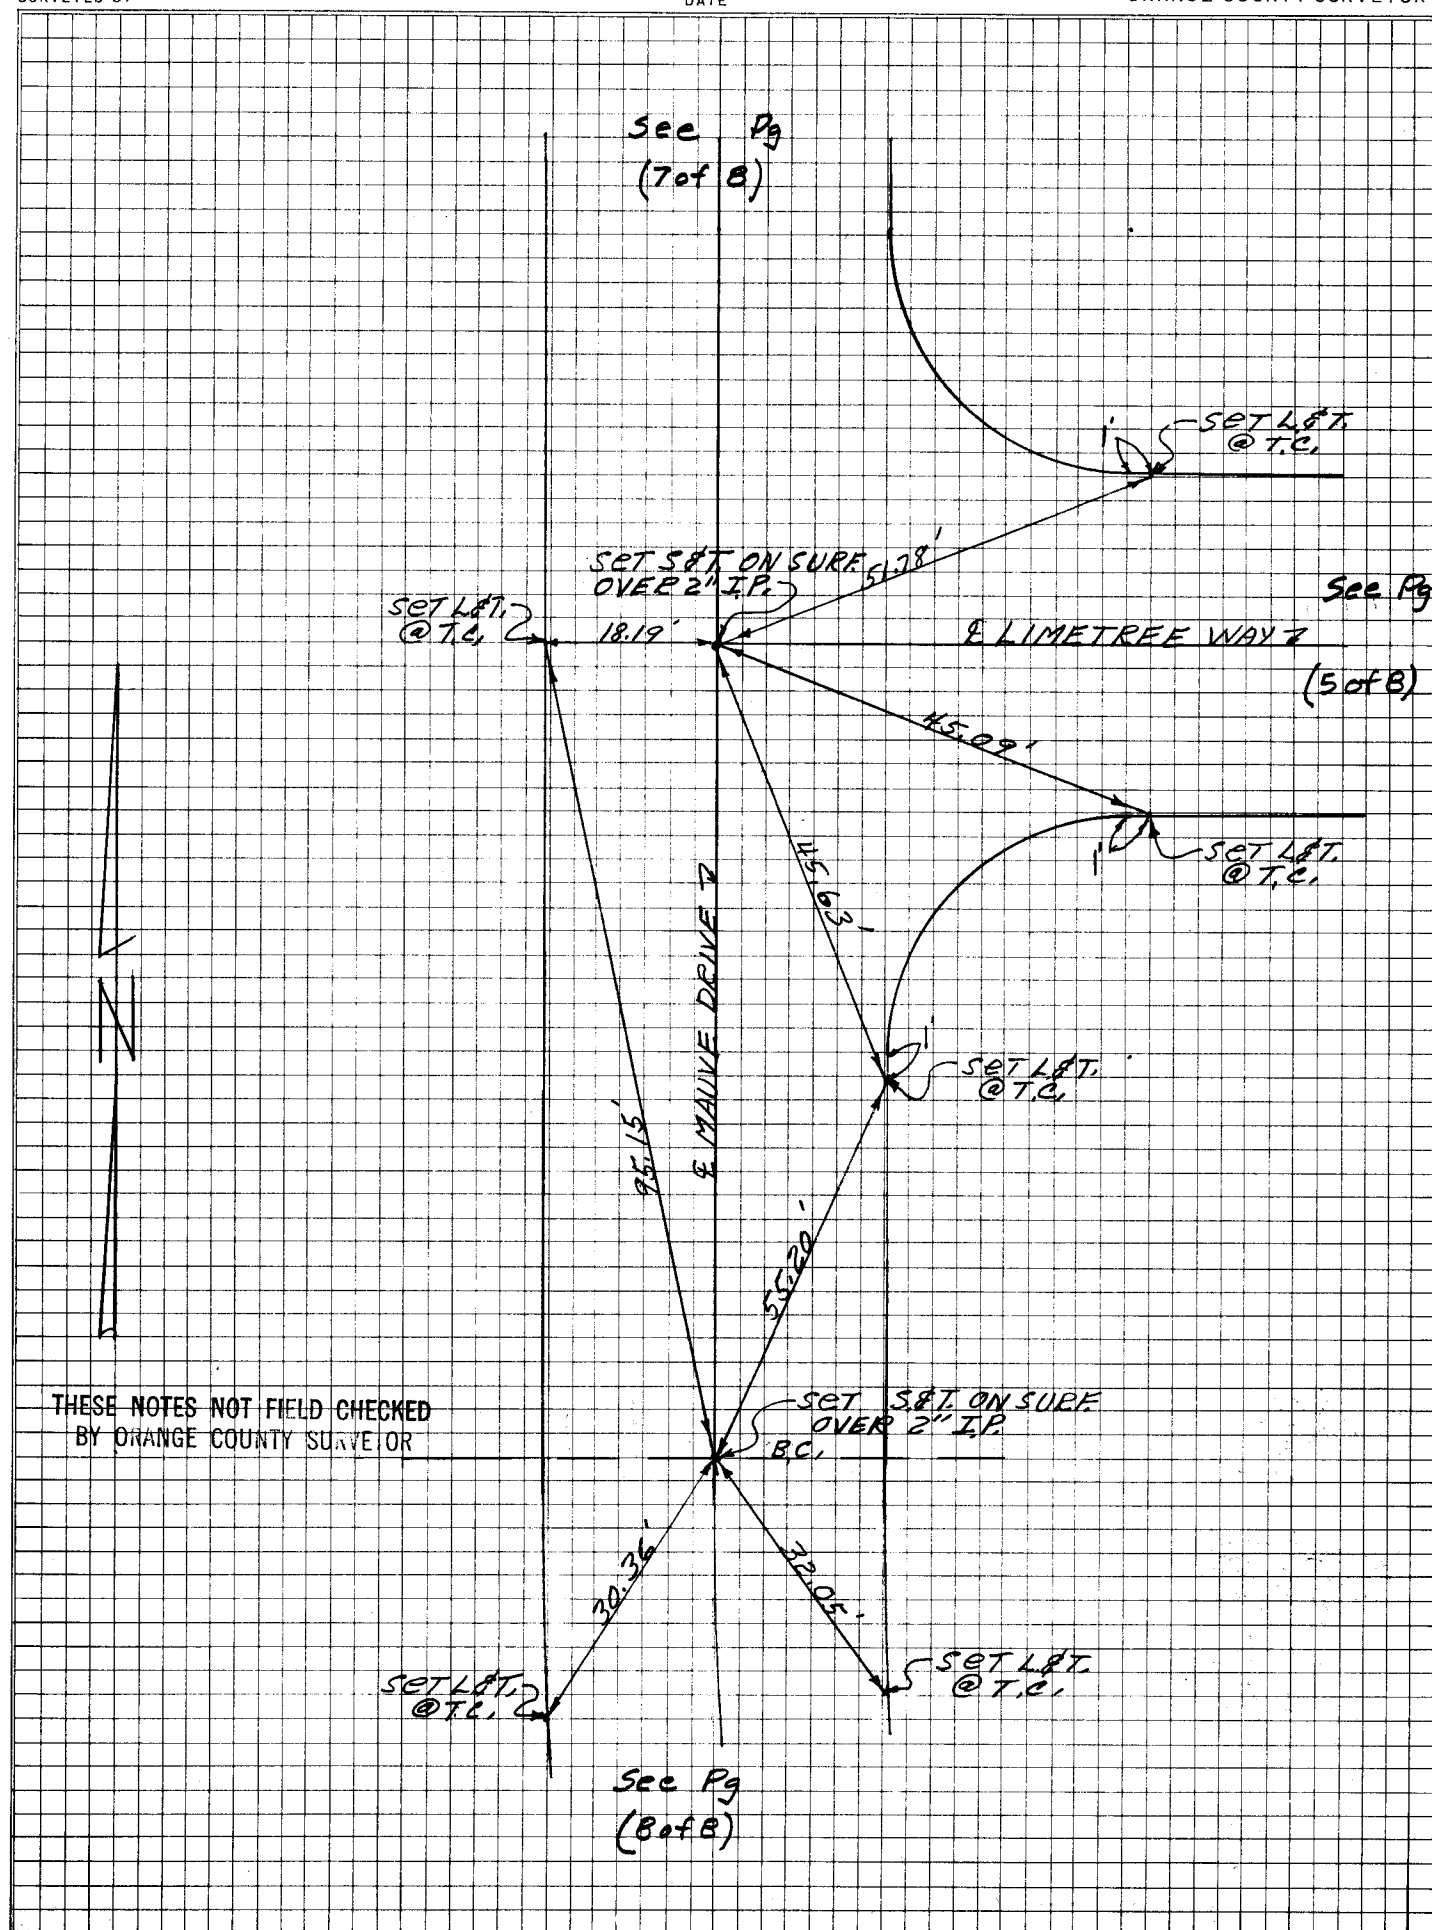

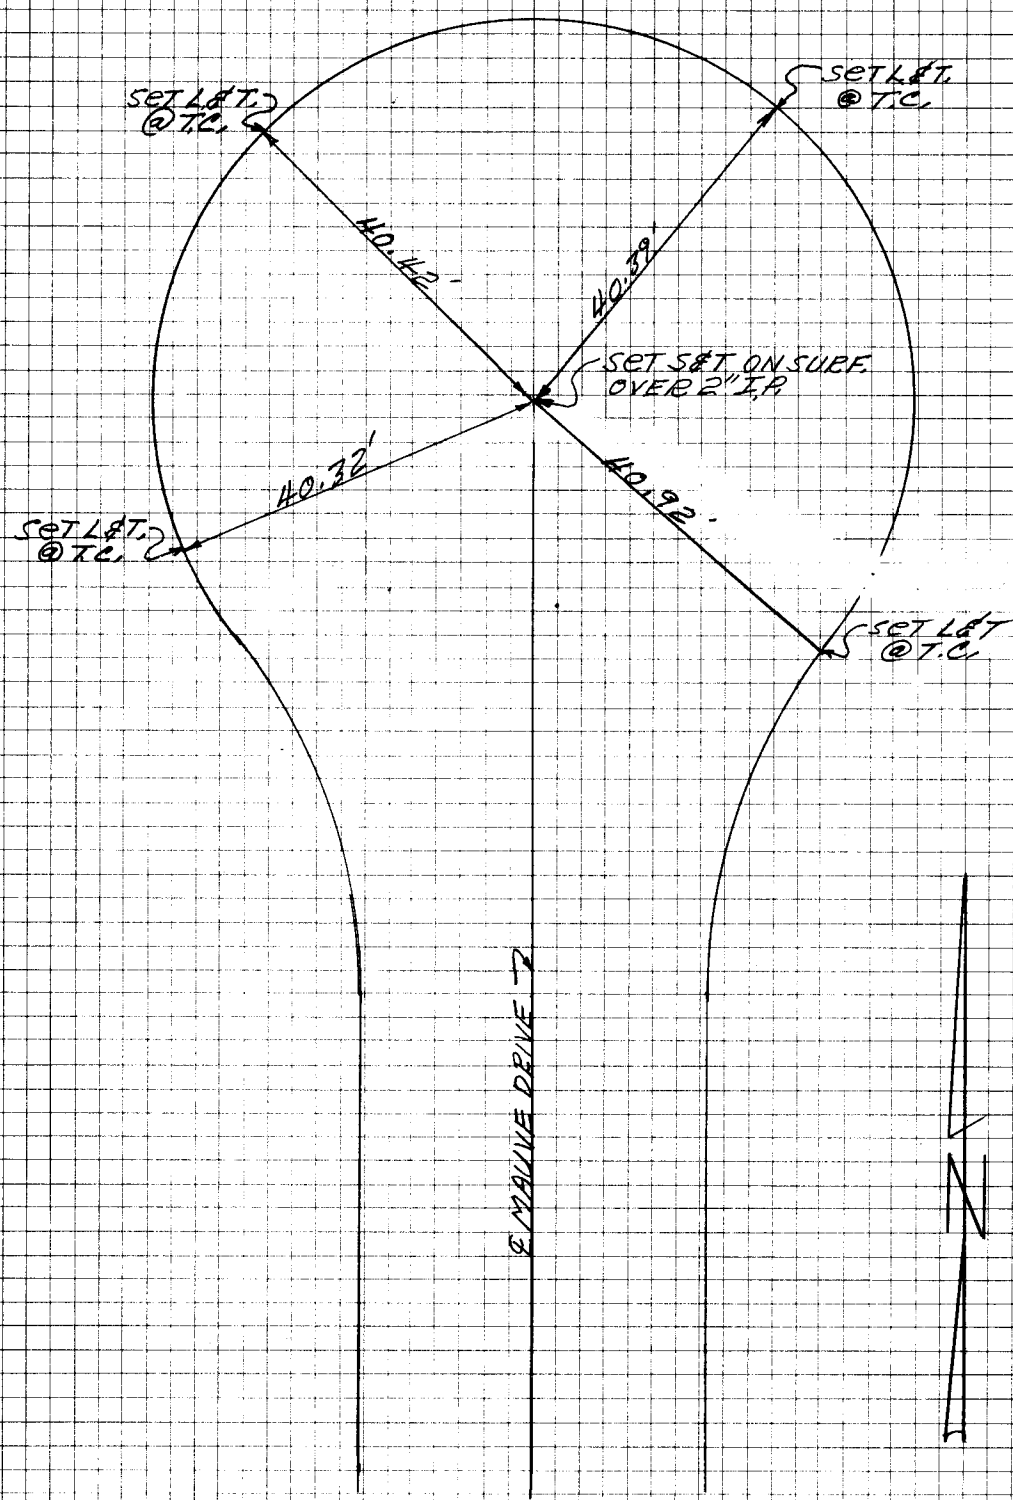

Sec Pg
(6 of 8)

THESE NOTES NOT FIELD CHECKED
BY ORANGE COUNTY SURVEYOR

