TOTAL ACREAGE: 2.66 AC. ALL OF TENT. PM. NO. 87-357 I PARCEL BLOCK: 5852 MODULE: 02,12

# RCEL MAP NO. 87-357

IN THE UNINCORPORATED TERRITORY OF ORANGE COUNTY, STATE OF CAL. BEING A PORTION OF THE LEONOR YORBA DE ROWLAND ALLOTMENT, IN THE RANCHO SANTIAGO DE SANTA ANA, IN THE COUNTY OF ORANGE, STATE OF CALIFORNIA. ACCEPTED AND FILED AT THE REQUEST OF

SHEET I OF 2 SHEETS

HALL & FOREMAN, INC.

JON E. SOLLIE L.S. 5749

DATE OF SURVEY: SEPT. 1987

#### OWNERSHIP STATEMENT

WE, THE UNDERSIGNED, BEING ALL PARTIES HAVING ANY RECORD TITLE INTEREST IN THE LAND COVERED BY THIS MAP, DO HEREBY CONSENT TO THE PREPARATION AND RECORDATION OF SAID MAP, AS SHOWN WITHIN THE DISTINCTIVE BORDER LINE.

UNITY CHURCH OF TRUTH RELIGIOUS EDUCATION CENTER, INC., A CALIFORNIA CORPORATION.

ARTHUR GREEN, PRESIDENT

NOTARY ACKNOWLEDGEMENT STATE OF CALIFORNIA)

COUNTY OF WHICHANGE ) SS ON THIS 3


STATE, PERSONALLY APPEARED DAY FOR SAID

PERSONALLY KNOWN TO ME OR PROVED ON THE

BASIS OF SATISFACTORY EVIDENCE) TO BE THE (VICE) PRESIDENT AND (ASS'T) SECRETARY, RESPECTIVELY, OF THE UNITY CHURCH OF TRUTH RELIGIOUS EDUCATION CENTER INC., THE CORPORATION THAT EXECUTED THE WITHIN INSTRUMENT AND KNOWN TO ME (OR PROVED TO ME ON THE BASIS OF SATISFACTORY EVIDENCE ) TO BE THE PERSONS WHO EXECUTED THE WITHIN INSTRUMENT ON BEHALF OF SAID CORPORATION AND ACKNOWLEDGED TO ME THAT SUCH CORPORATION EXECUTED THE SAME.

WITNESS BY HAND: - (ERRE! !. Mi- millital PRINT NAME

MY PRINCIPLE PLACE OF BUSINESS IS IN TRANSPACE COUNTY MY COMMISSION EXPIRES 12-18-84

#### SURVEYOR'S STATEMENT

THIS MAP WAS PREPARED BY ME OR UNDER MY DIRECTION (AND WAS COMPILED FROM RECORD DATA) OR AND IS BASED UPON A FIELD SURVEY IN CONFORMANCE WITH THE REQUIREMENTS OF THE SUBDIVISION MAP ACT AND LOCAL ORDINANCES AT THE REQUEST OF UNITY CHURCH OF TRUTH RELIGIOUS EDUCATION CENTER, INC., ON SEPT. 1987 . I HEREBY STATE THAT ALL MONUMENTS ARE OF THE CHARACTER AND OCCUPY THE POSITIONS INDICATED, OR THAT THEY WILL BE SET IN SUCH POSITION ON OR BEFORE MARCH, 1990; AND THAT SAID MONUMENTS ARE SUFFICIENT TO ENABLE THE SURVEY TO BE RETRACED. I HEREBY STATE THAT THIS PARCEL MAP SUBSTANTIALLY CONFORMS TO THE APPROVED OR CONDITIONALLY APPROVED TENTATIVE MAP, IF ANY.

JON SOLLIE - L.S. #5749

LICENSE EXPIRATION: 12/31/91

COUNTY SURVEYOR'S STATEMENT

THIS MAP CONFORMS WITH THE REQUIREMENTS OF THE SUBDIVISION MAP ACT AND LOCAL ORDINANCE.

DATED THIS 23 PD DAY OF MARCH , 19 CK.

JOHN CANAS COUNTY SURVEYOR

BY: MARK S. BROWN, DEPUTY L.S. 5655 EXPIRES 9-30-91

COUNTY TREASURER - TAX COLLECTOR'S CERTIFICATE

STATE OF CALIFORNIA) )SS COUNTY OF ORANGE

I HEREBY CERTIFY THAT ACCORDING TO THE RECORDS OF MY OFFICE, THERE ARE NOT LIENS AGAINST THE LAND COVERED BY THIS MAP OR ANY PART THEREOF FOR UNPAID STATE, COUNTY MUNICIPAL OR LOCAL TAXES OR SPECIAL ASSESSMENTS COLLECTED AS TAXES, EXCEPT TAXES OR SPECIAL ASSESSMENTS COLLECTED AS TAXES NOT YET PAYABLE.

7 th DAY OF March, 1990.

ROBERT L. CITRON COUNTY TREASURER-TAX COLLECTOR TAX COLLECTOR

CLERK OF THE BOARD OF SUPERVISORS' CERTIFICATE

STATE OF CALIFORNIA) )SS COUNTY OF ORANGE

I HEREBY CERTIFY TO THE RECORDER OF ORANGE COUNTY THAT THIS MAP WAS PRESENTED FOR APPROVAL TO THE BOARD OF SUPERVISORS OF ORANGE COUNTY AT A REGULAR MEETING THEREOF HELD ON THE 3RD DAY OF APRIL AND THAT THEREUPON SAID BOARD DID, BY AN ORDER DULY PASSED AND ENTERED, APPROVE SAID MAP, DATED THIS 32D DAY OF APRIL , 1990.

LINDA D. RUTH CLERK OF THE BOARD OF SUPERVISORS

CLERK OF THE BOARD OF SUPERVISOR'S TAX CERTIFICATE

STATE OF CALIFORINA) COUNTY OF ORANGE

I HEREBY CERTIFY TO THE RECORDER OF ORANGE COUNTY THAT THE PROVISIONS OF THE SUBDIVISION MAP ACT HAVE BEEN COMPLIED WITH REGARDING DEPOSITS TO SECURE THE PAYMENT OF TAXES OR SPECIAL ASSESSMENTS COLLECTED AS TAXES ON THE LAND COVERED

BY THIS MAP. DATED THIS 3RD DAY OF APRIL, 19 90.

LINDA'D. RUTH CLERK OF THE BOARD OF SUPERVISORS

IMPROVEMENT CERTIFICATE PURSUANT TO THE PROVISIONS OF SECTION 664111 OF THE SUBDIVISION MAP ACT, NOTICE IS HEREBY GIVEN THAT THE FOLLOWING IMPROVEMENTS ARE REQUIRED TO BE CONSTRUCTED PRIOR TO PROCESSING ANY SUBSEQUENT DEVELOPMENT OF THIS PARCEL:

1. A SIDEWALK ON PROSPECT AVENUE ACROSS THE PROPERTY FRONTAGE.

> CF J

TOTAL ACREAGE: 2.66 AC. ALL OF TENT. P.M. NO. 87-357 I PARCEL

BLOCK: \_\_5852 MODULE: 02,12 SCALE: 1" = 40'

SHEET 2 OF 2 SHEETS CEL MAP NO.87-357

IN THE UNINCORPORATED TERRITORY OF THE COUNTY OF ORANGE, STATE OF CALIFORNIA. BEING A PORTION OF THE LEONOR YORBA DE ROWLAND ALLOTMENT, IN THE RANCHO SANTIAGO DE SANTA ANA, IN THE COUNTY OF ORANGE, STATE OF CALIFORNIA.

HALL & FOREMAN, INC.

JON E. SOLLIE L.S. 5749


DATE OF SURVEY: SEPT. 1987

## BASIS OF BEARINGS

BEARINGS SHOWN HEREON ARE BASED ON THE CENTERLINE OF PROSPECT AVENUE BEING NO0°14'10"W PER TRAIT 5658 RELORDED IN BOOK 206, PAGES 36 AND 37 OF MISCECLANEOUS MAPS, IN THE OFFICE OF THE COUNTY RECORDER OF ORANGE COUNTY

### MONUMENT NOTES

1. - Fd. MONUMENT AS NOTED. 2. 6- SET SPIKE & WASHER TAGGED LS. 5749. 3.0- SET I" I.P. TAGGED L.S. 5749 OR LEAD, TACK & TAG TAGGED L.S. 5749.

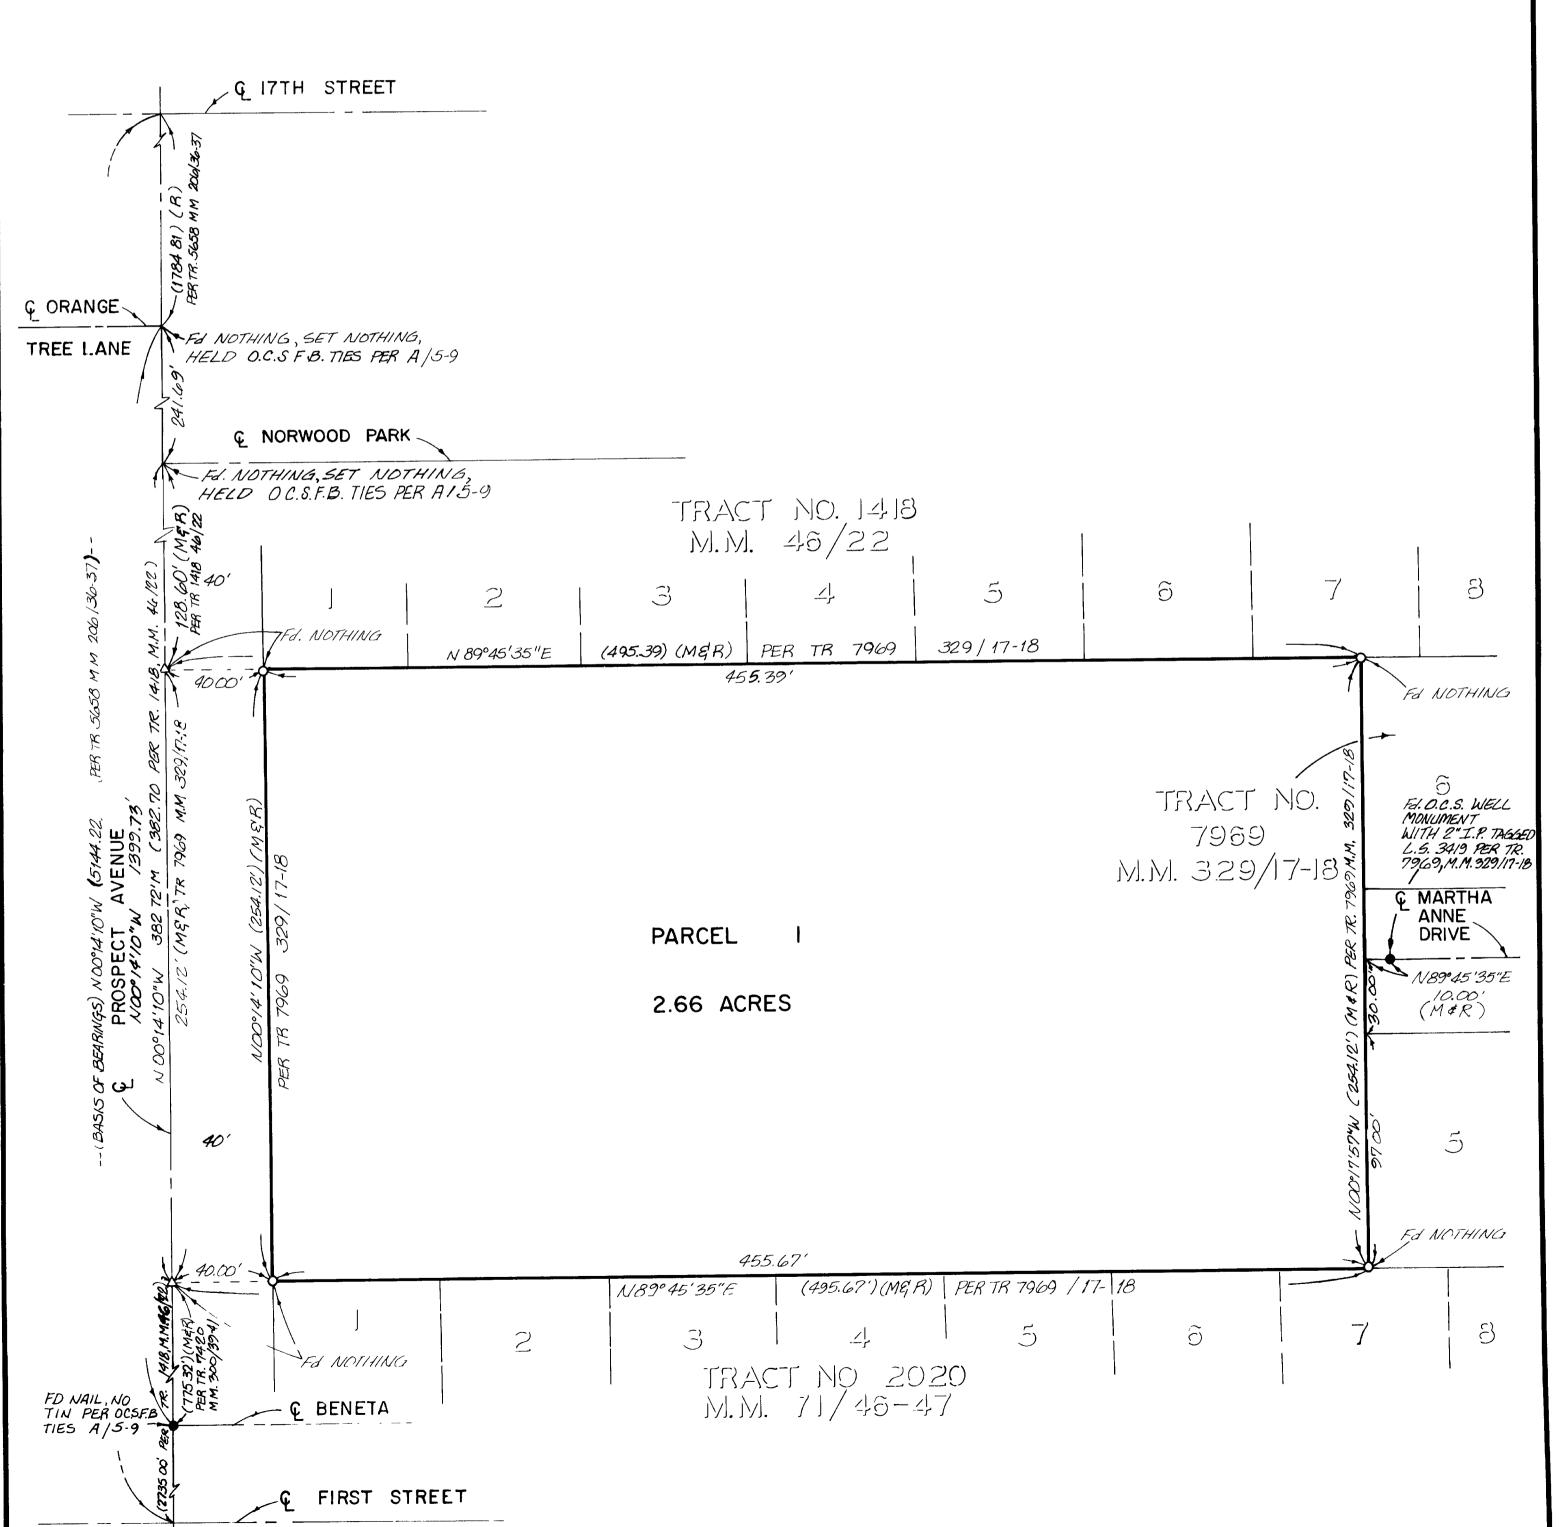

3879