





RECORD OF SURVEY

OF PARCELS SHOWN BELOW GIVING NAME OF OWNER, DATE OF SURVEY, SCALE AND OTHER DATA AS INDICATED

D. D. HILLYARD, LICENSED SURVEYOR

FILED
APR 8 1948

W. K. Hillyard
ORANGE COUNTY RECORDS
Recorder

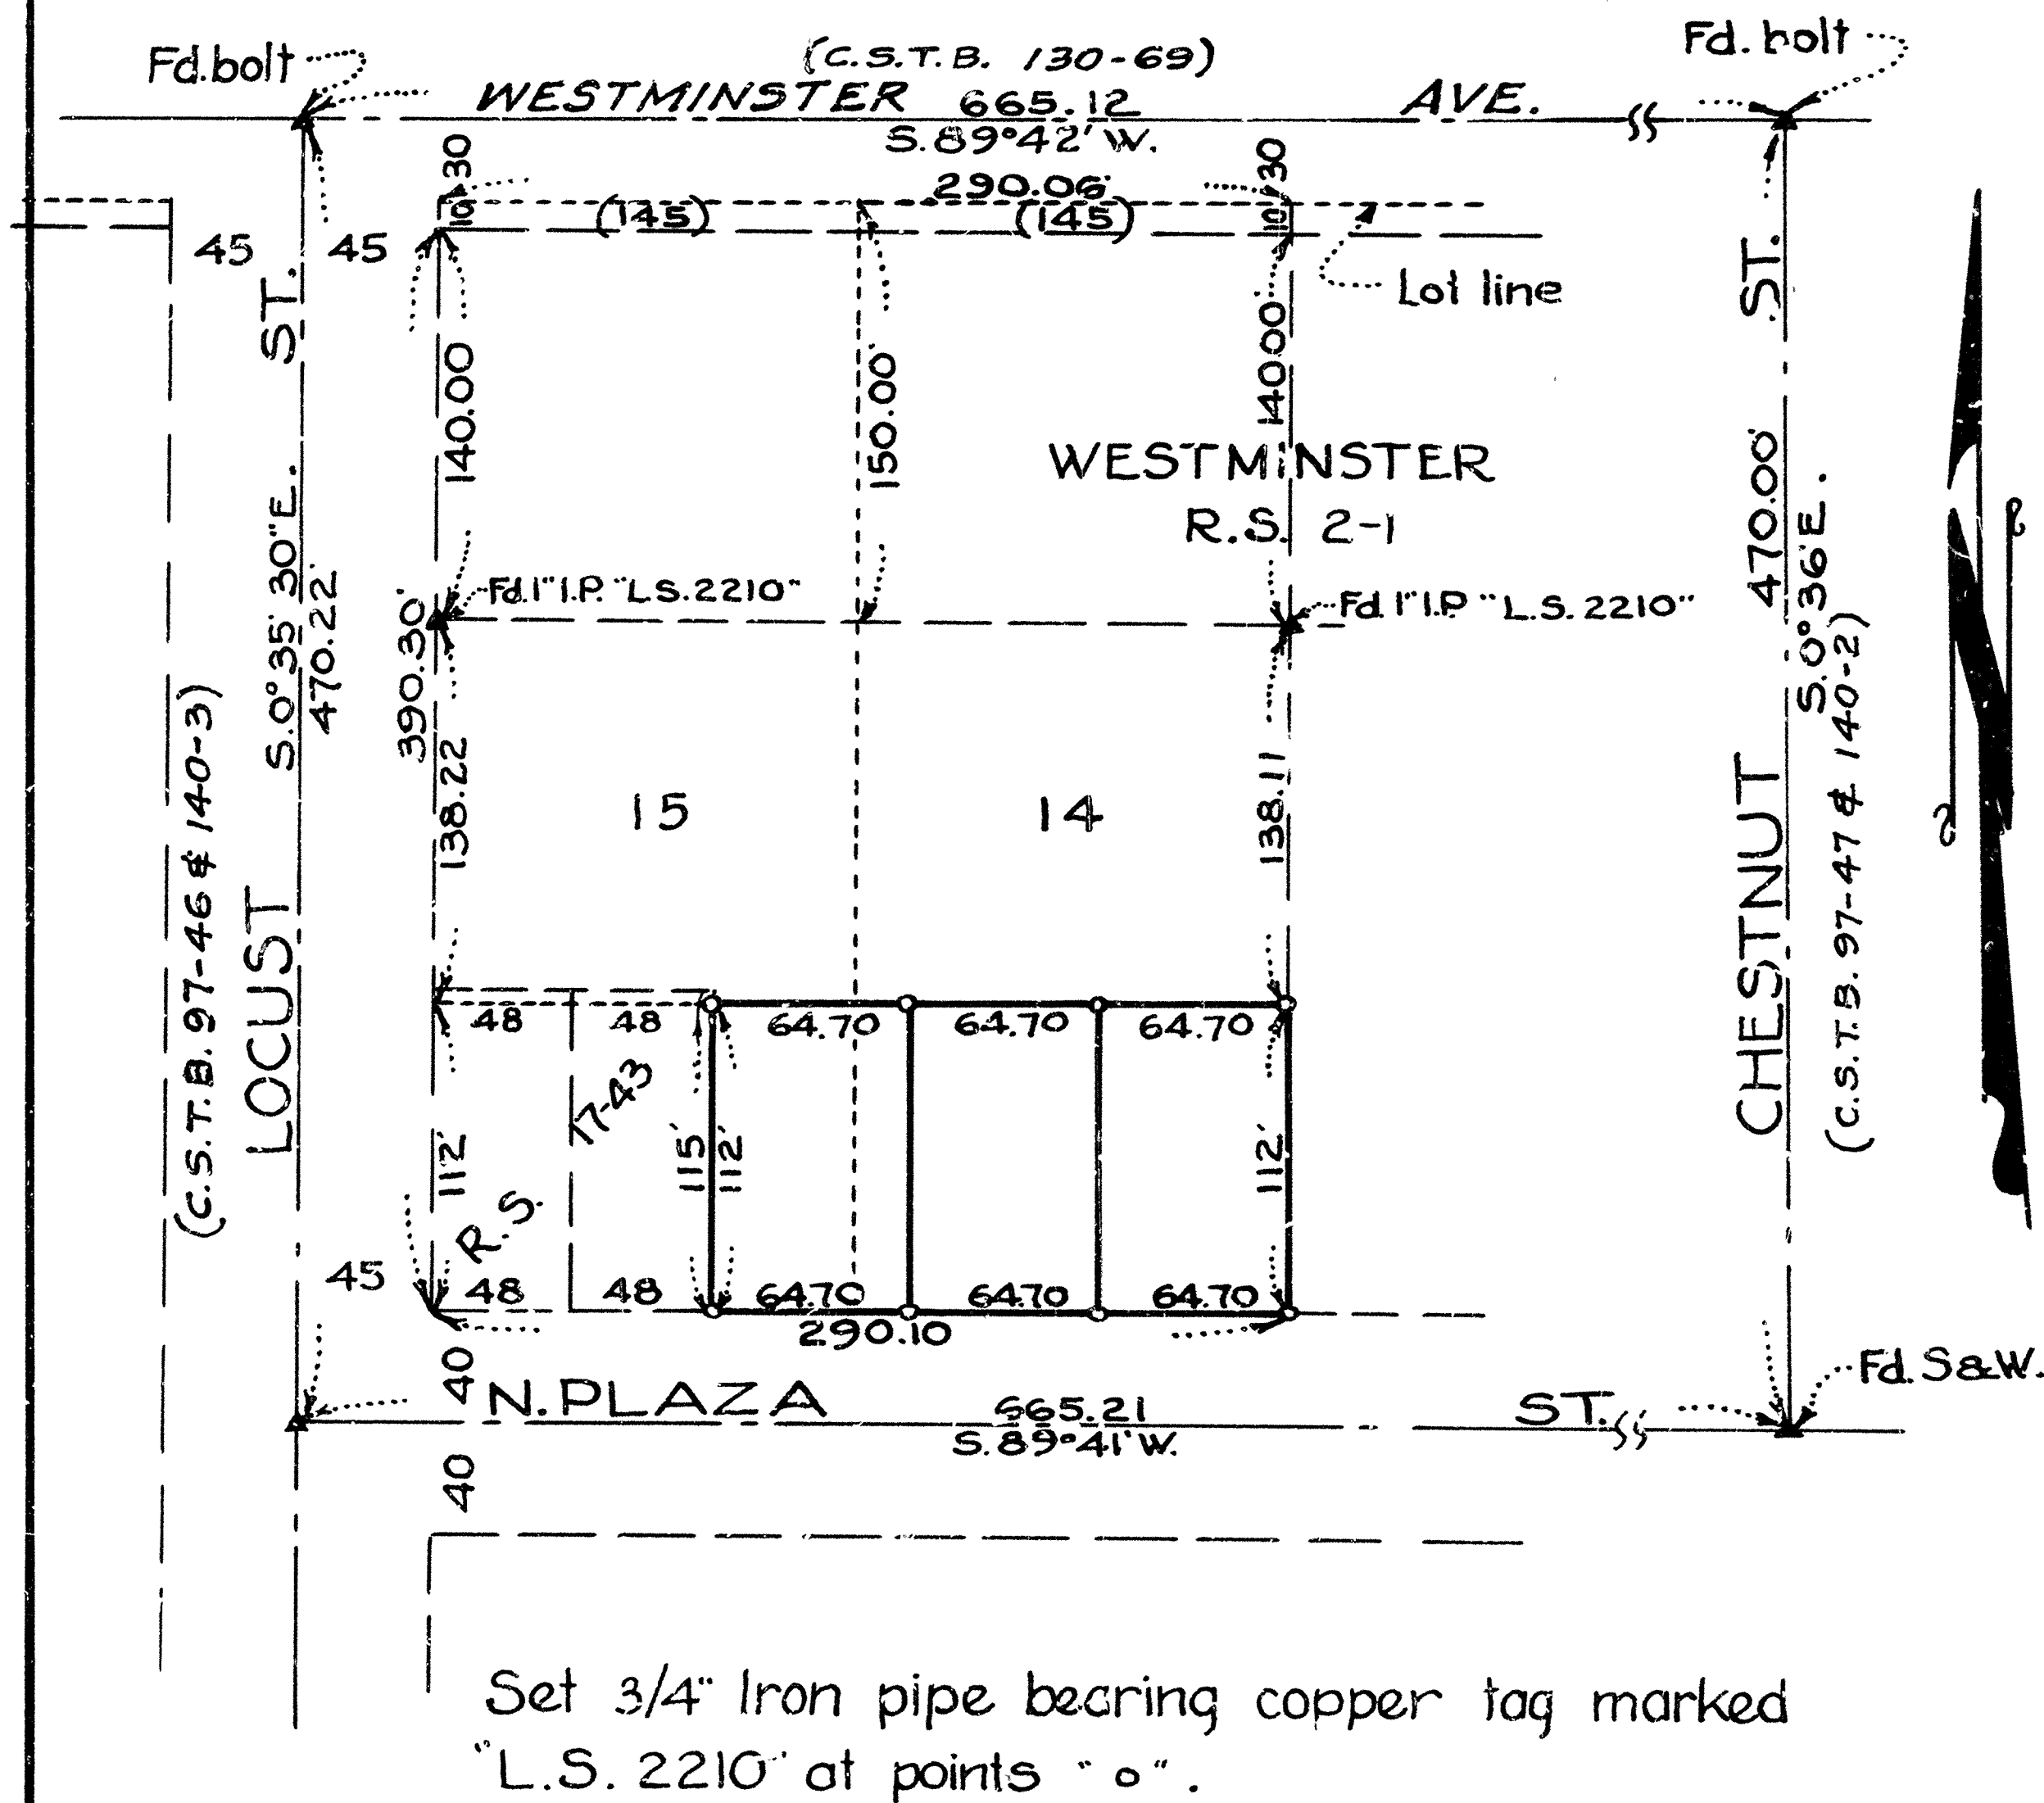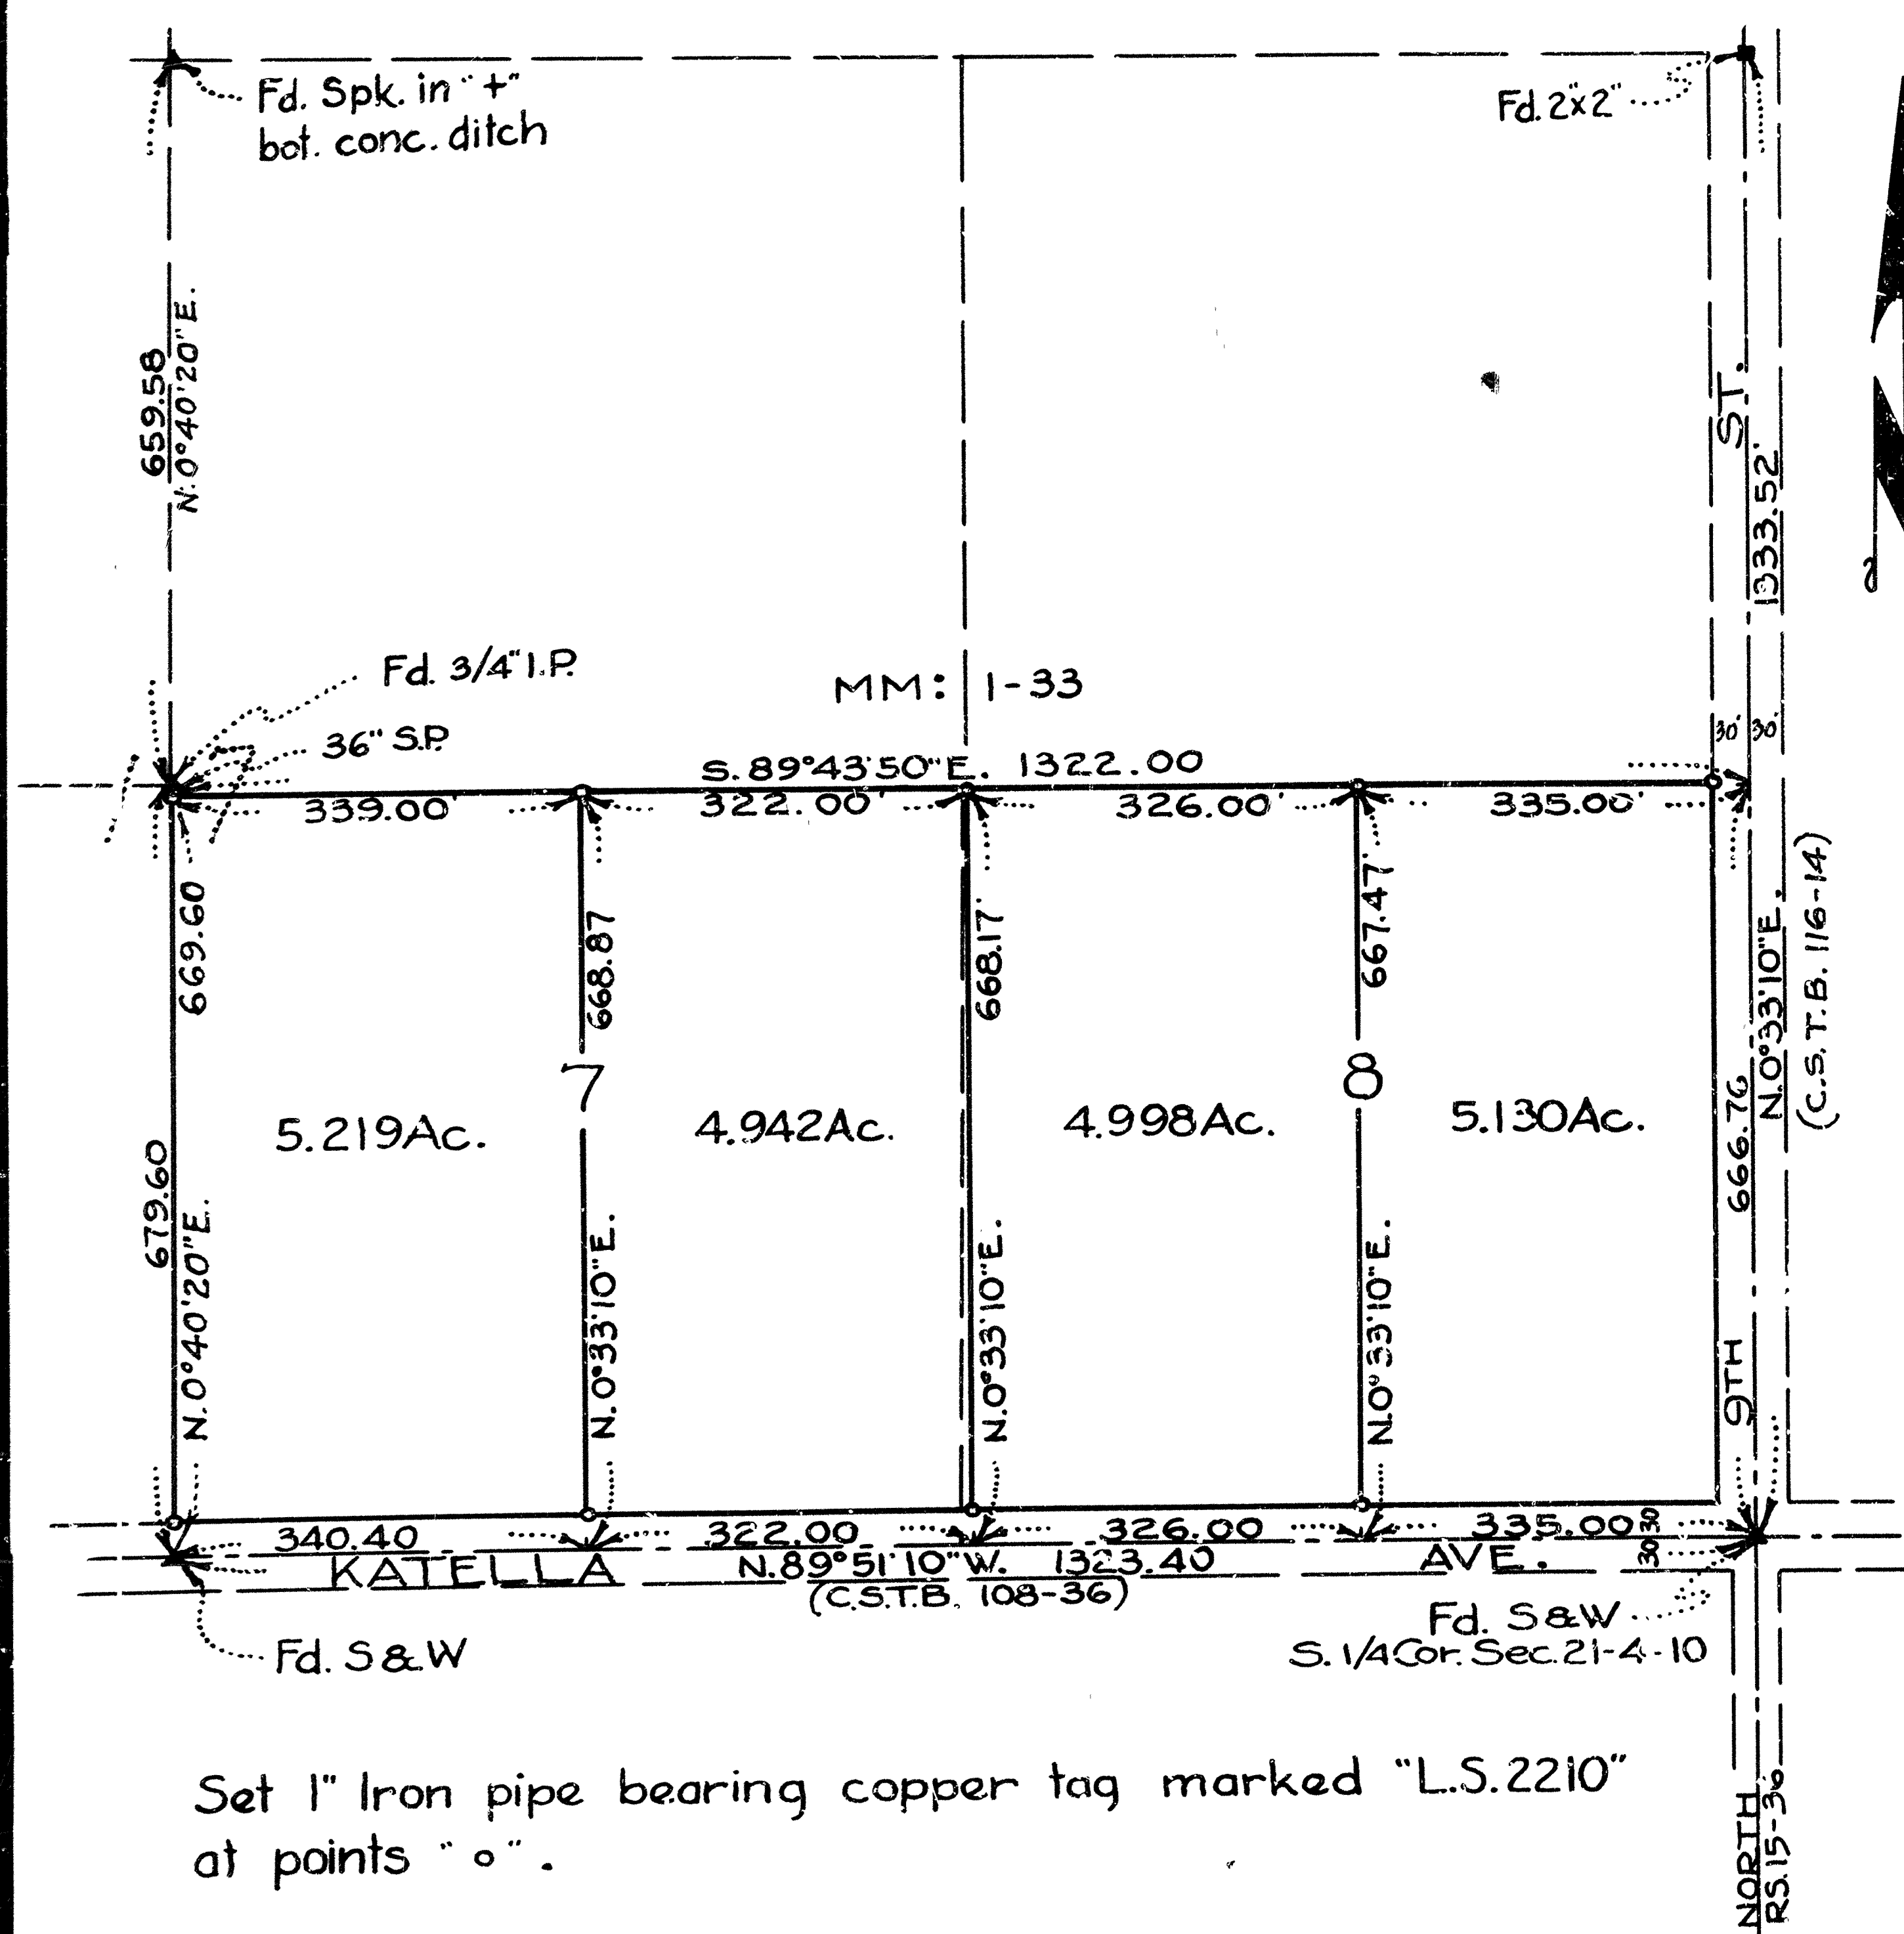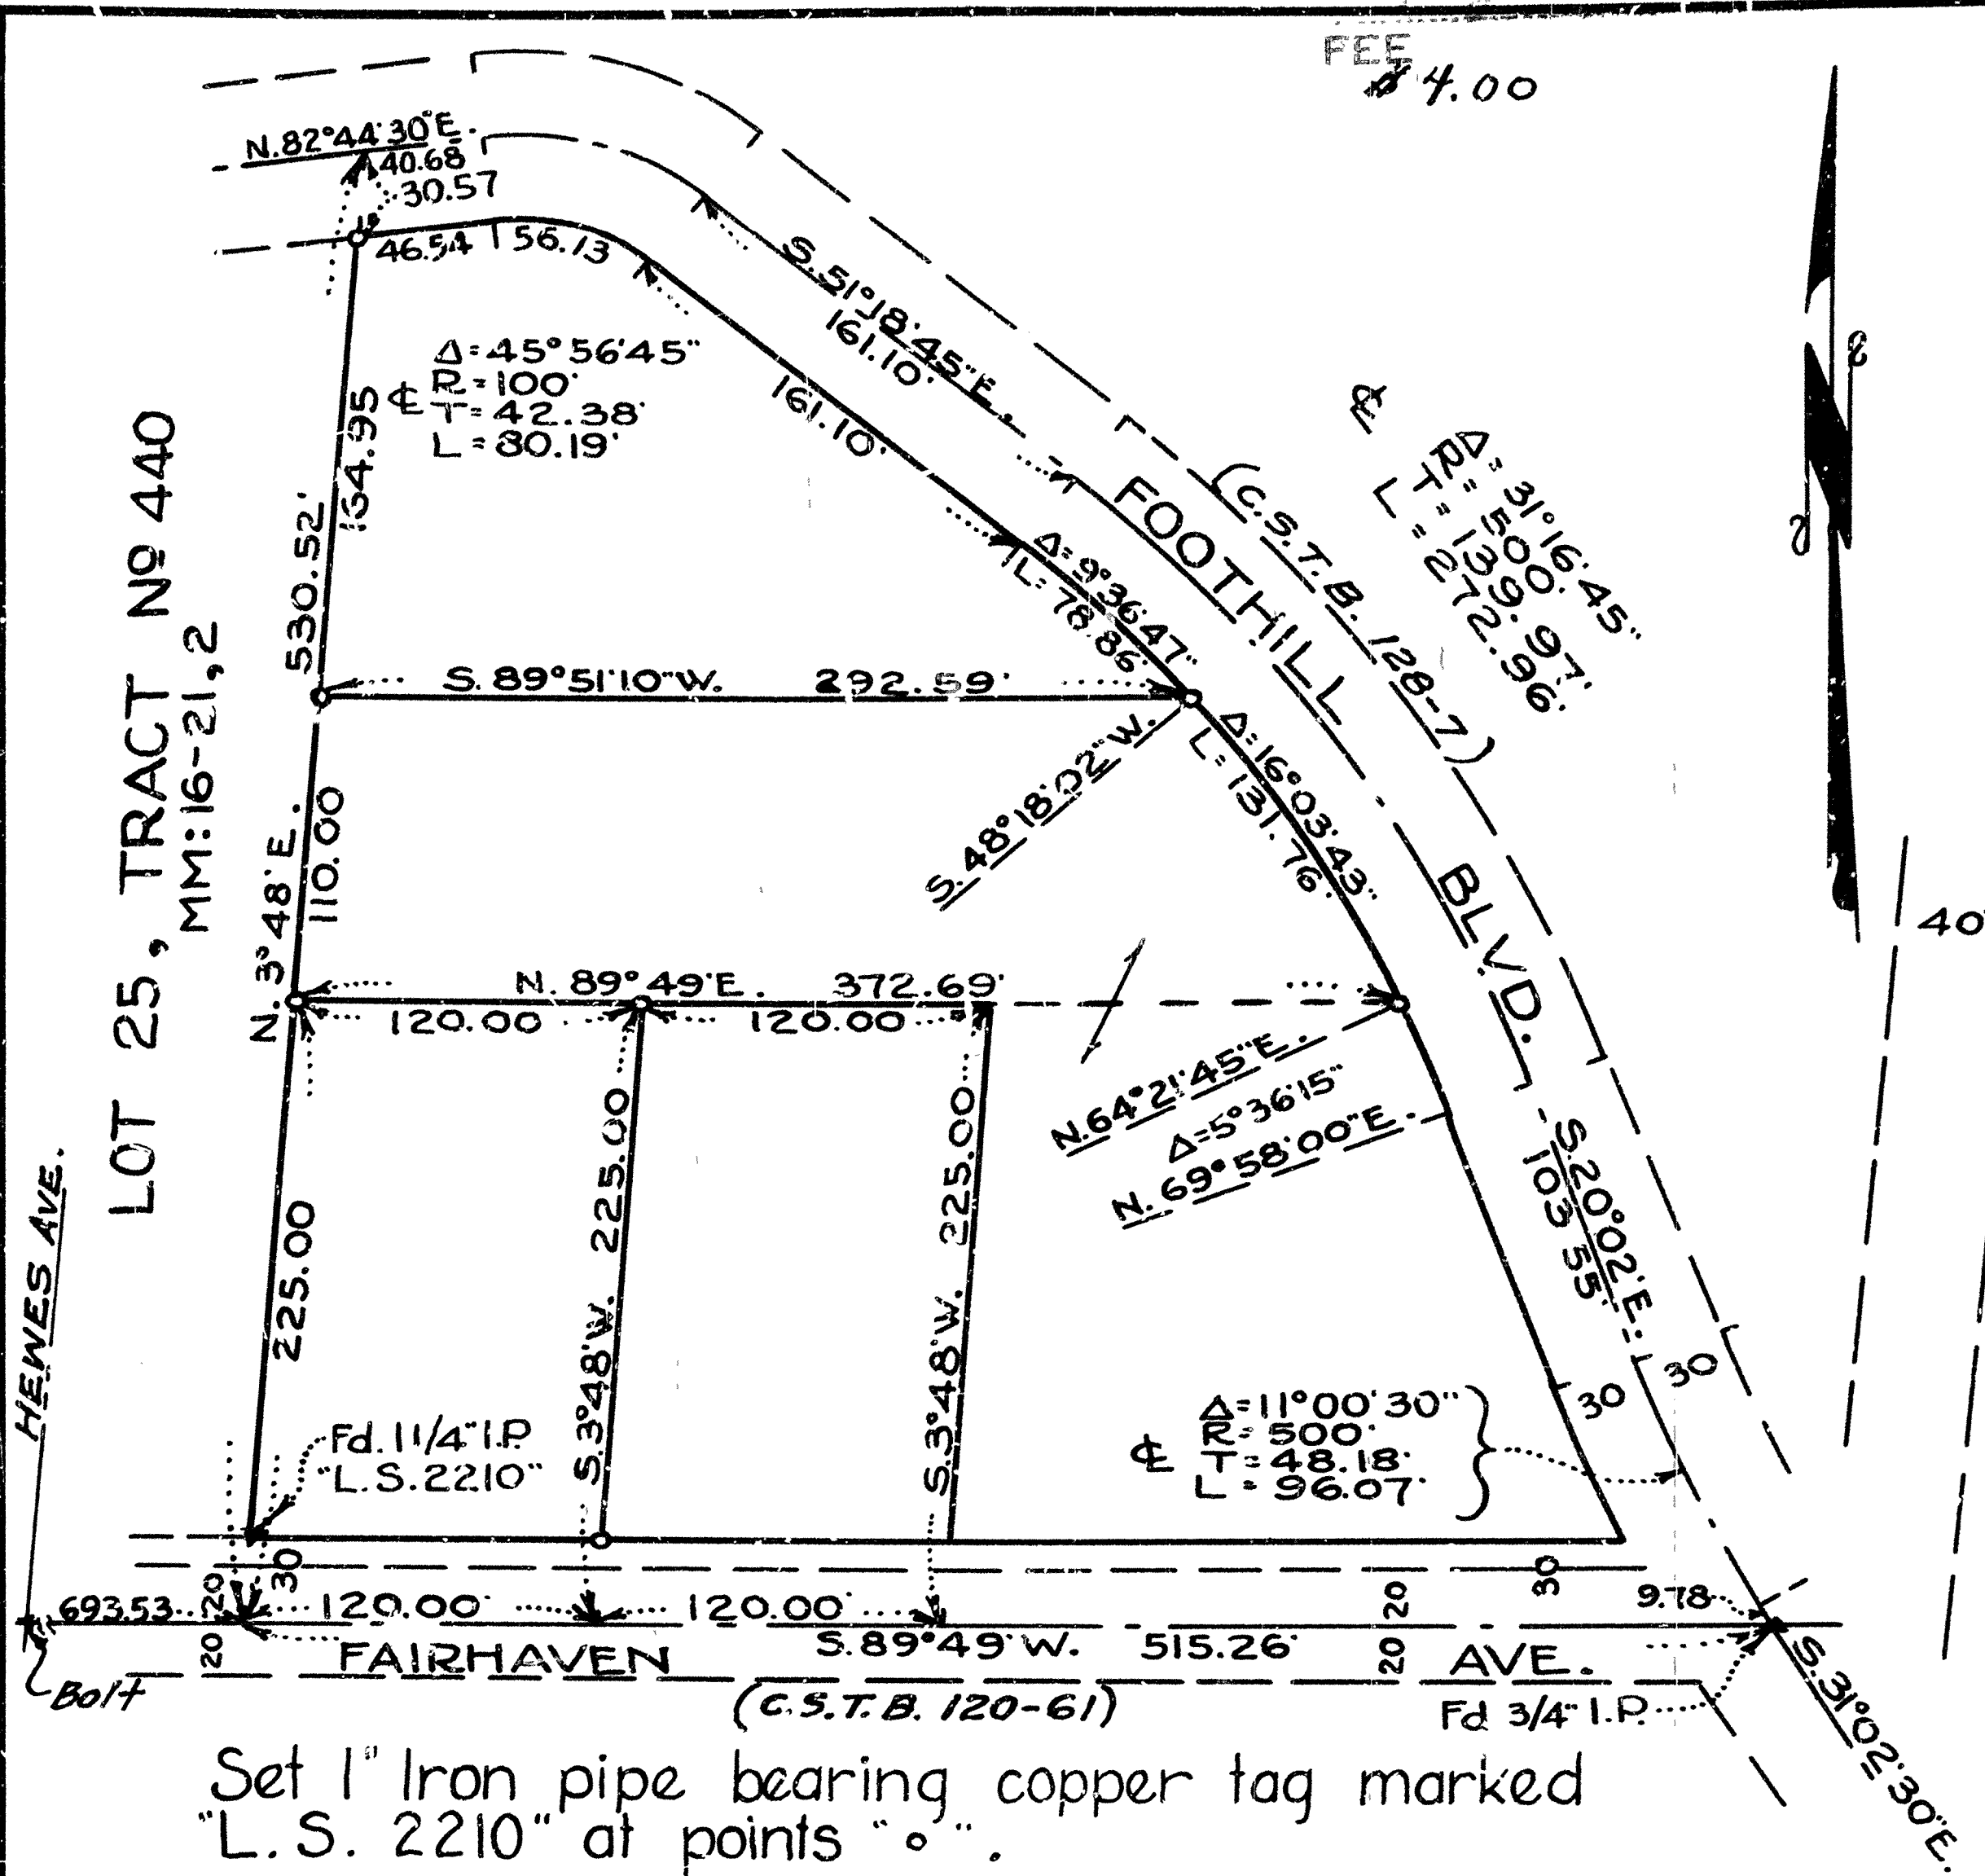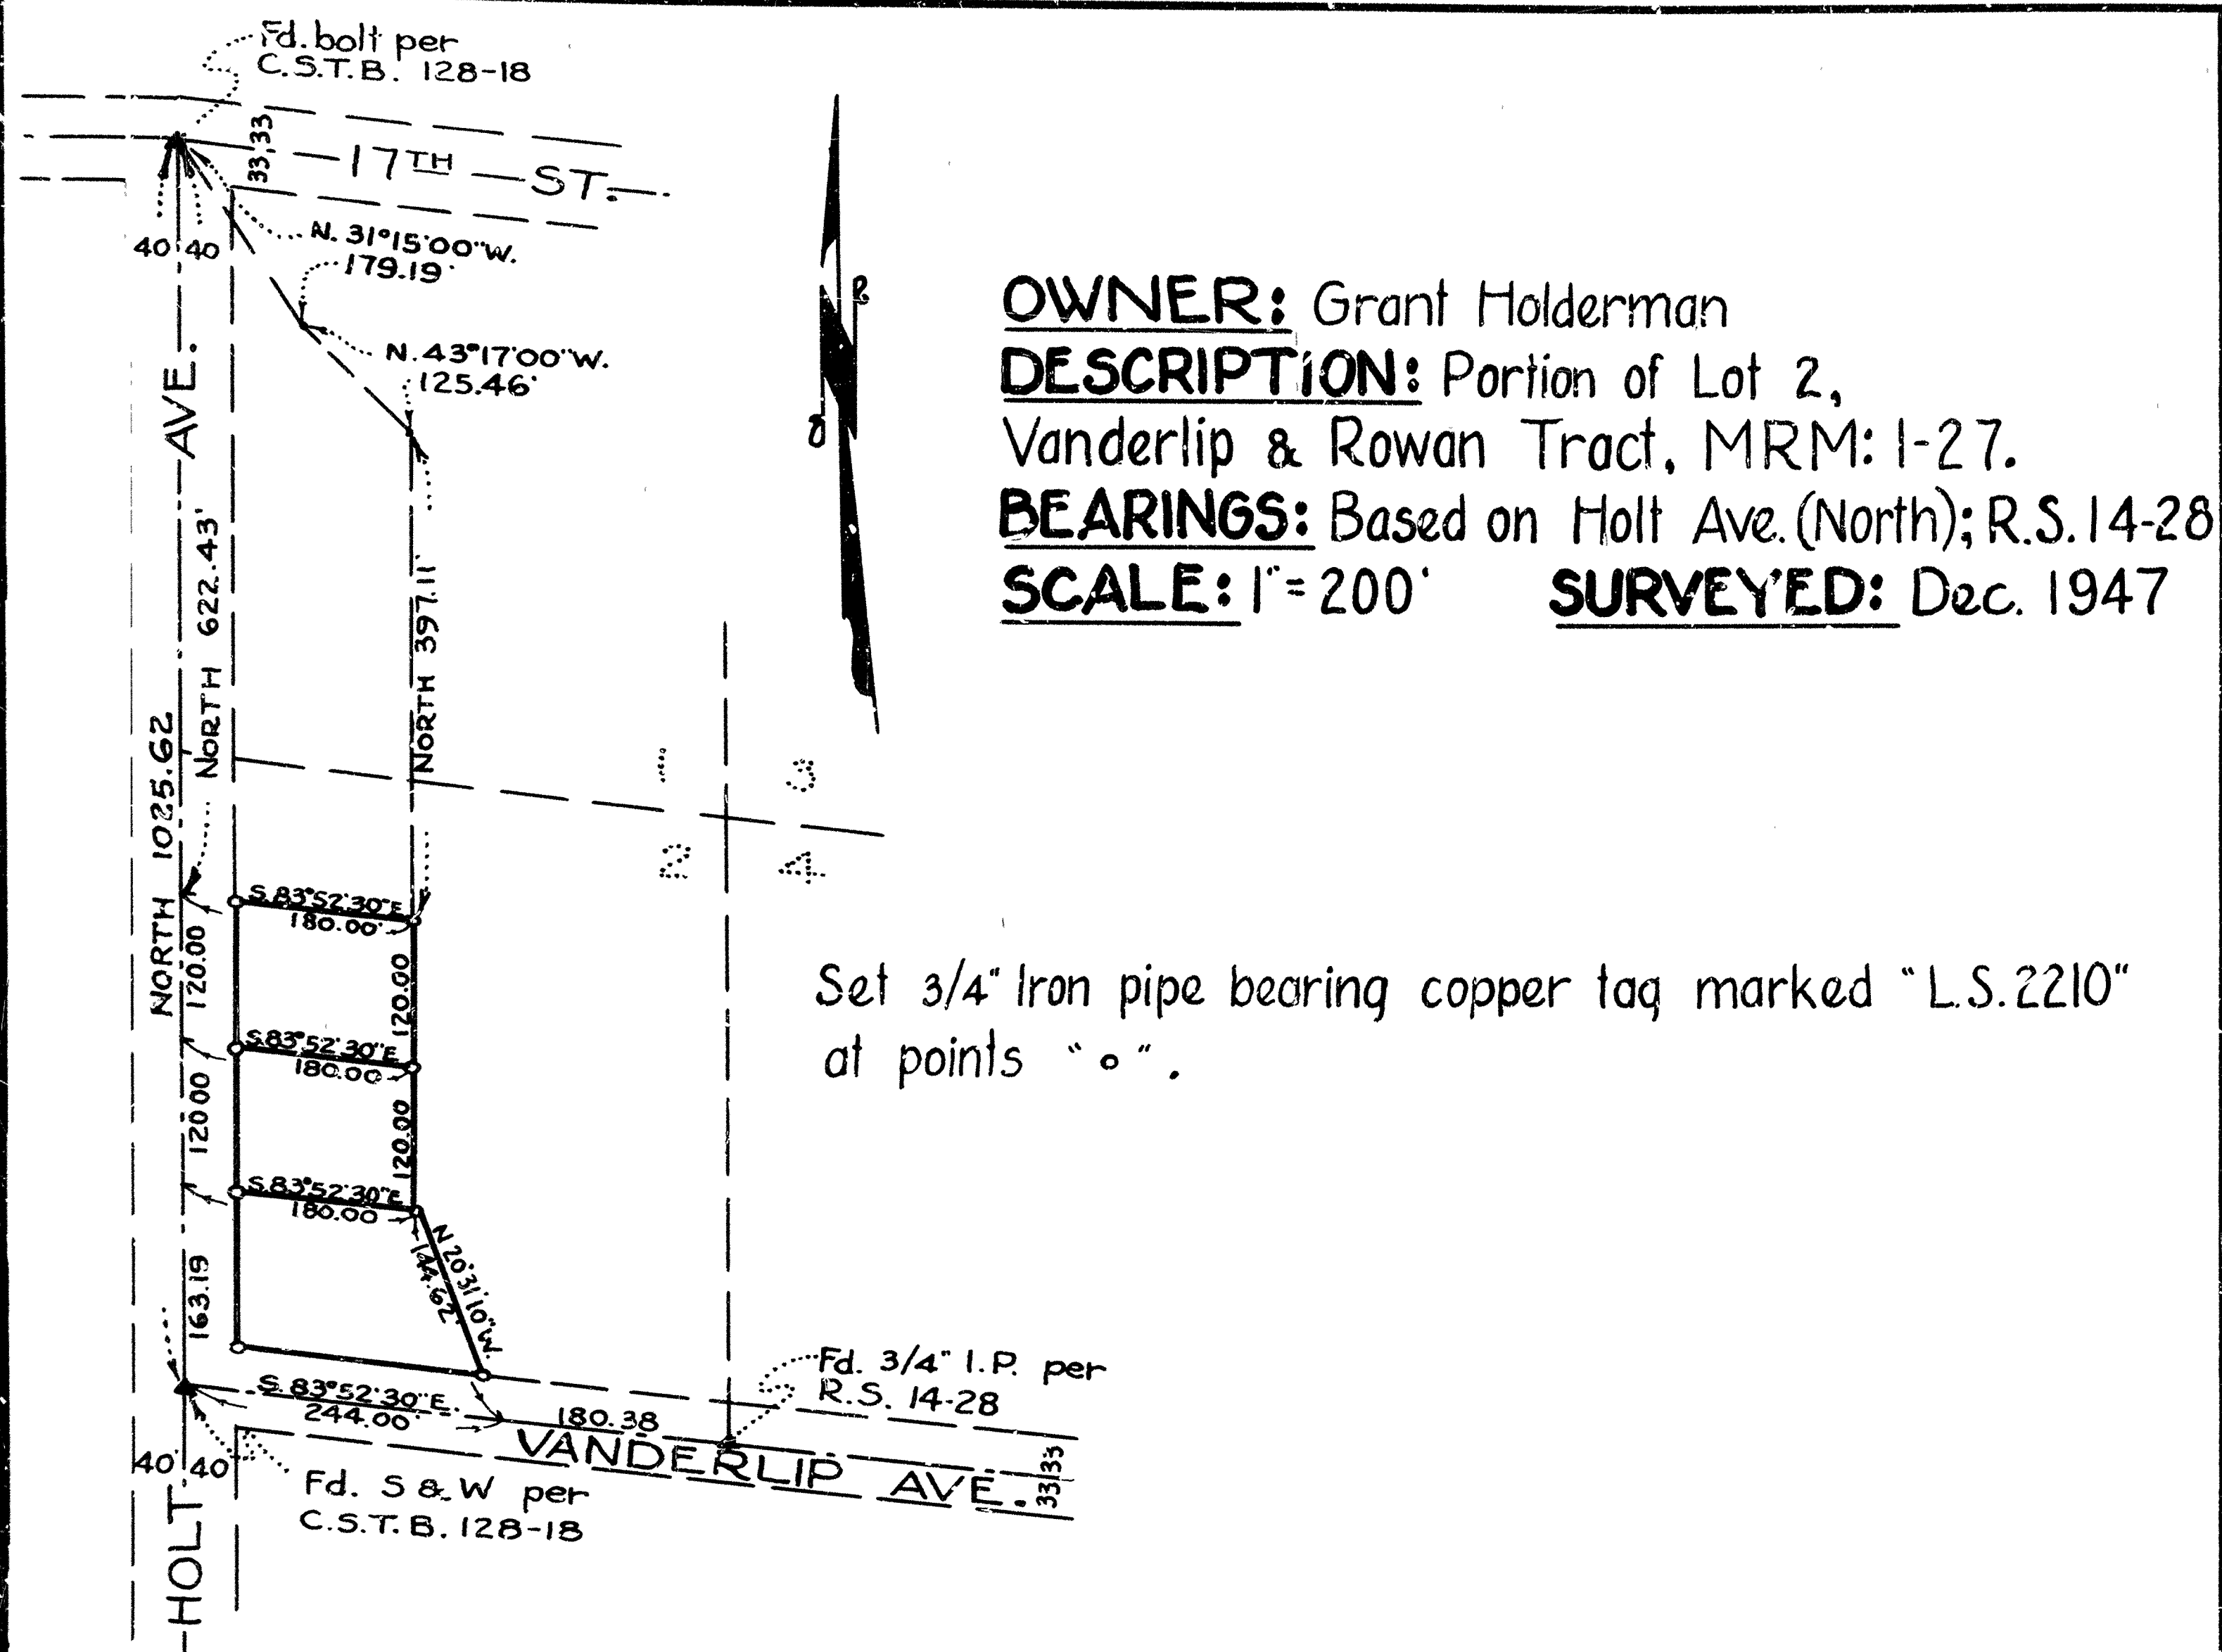

I, D. D. Hillyard, certify: that I am a Licensed Surveyor of the State of California, No 2210; that this map represents surveys made under my supervision at the request of the Owners, and that all monuments shown actually existed at the time of the survey and their position is correctly shown.

D. D. Hillyard
Licensed Surveyor

Examined and approved
this 7th day of April, 1948.

J. E. Lloyd
Deputy County Surveyor