

RECEIVED FROM MCDANIEL ENG. CO. 7/61


THESE NOTES NOT FIELD CHECKED
BY ORANGE COUNTY SURVEYOR

ORANGE COUNTY SURVEYOR

DATE

CHECKED BY

2M 3/57

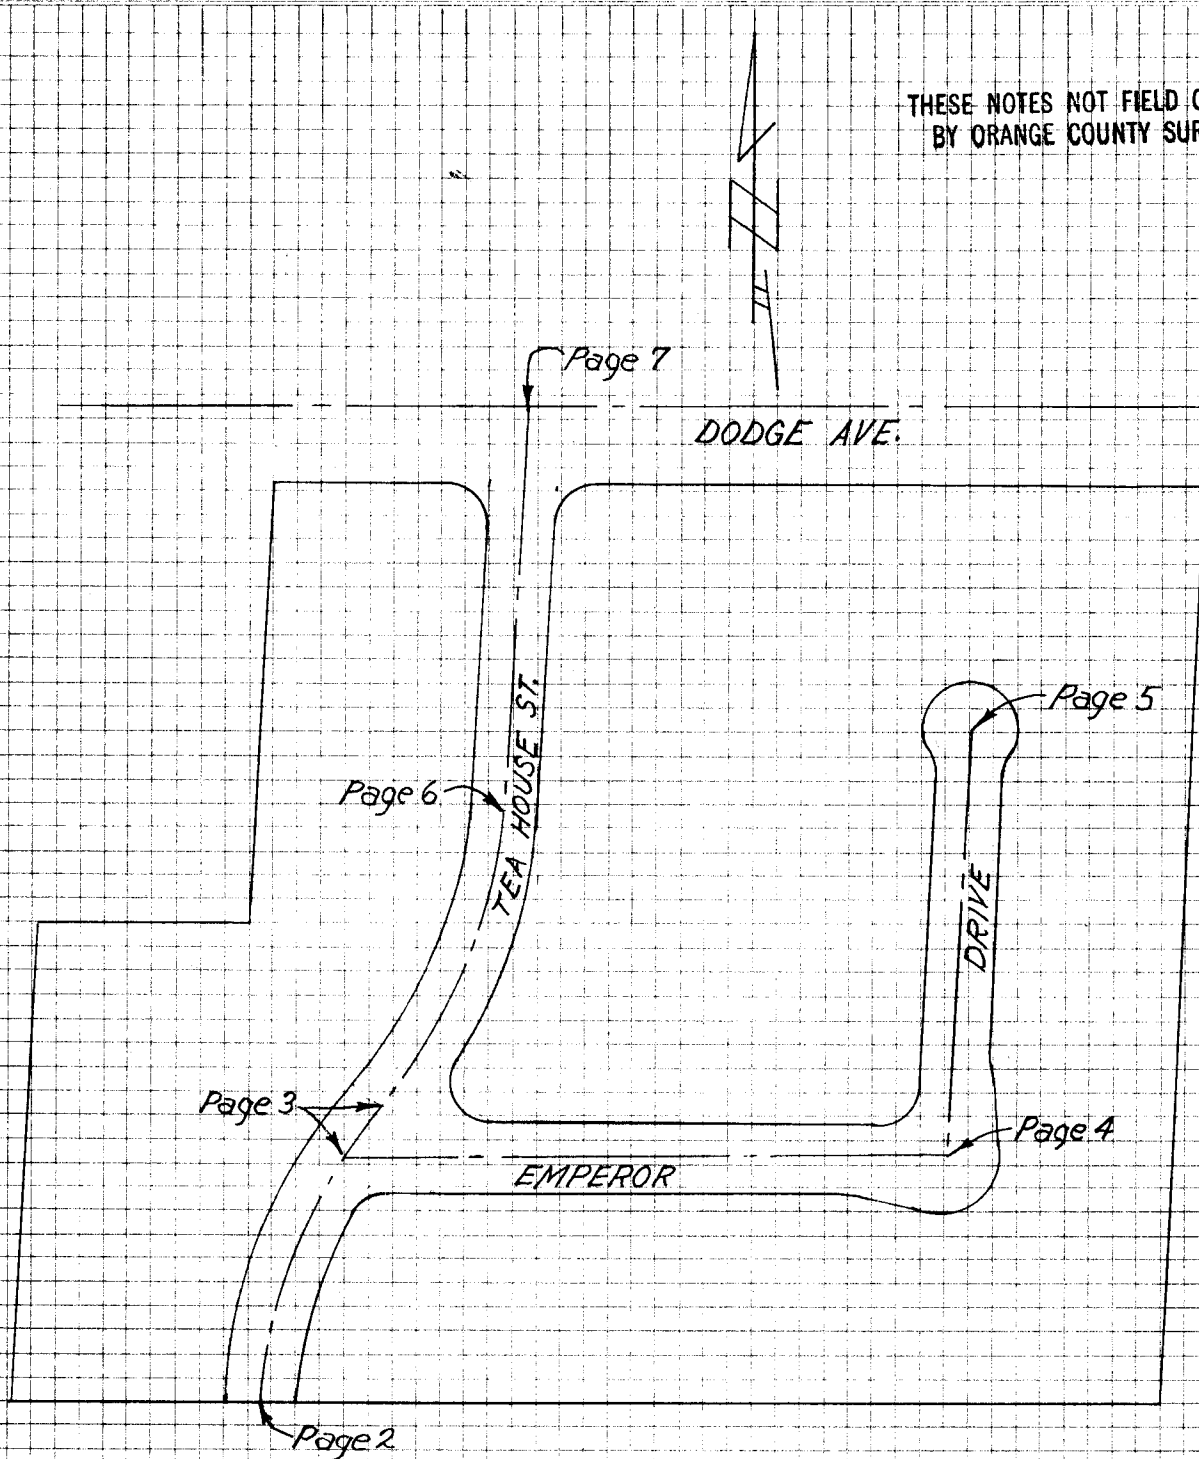

RECEIVED FROM MCDANIEL ENG. CO. 7/61


THESE NOTES NOT FIELD CHECKED
BY ORANGE COUNTY SURVEYOR

ORANGE COUNTY SURVEYOR

DATE


CHECKED BY

2M 3/57

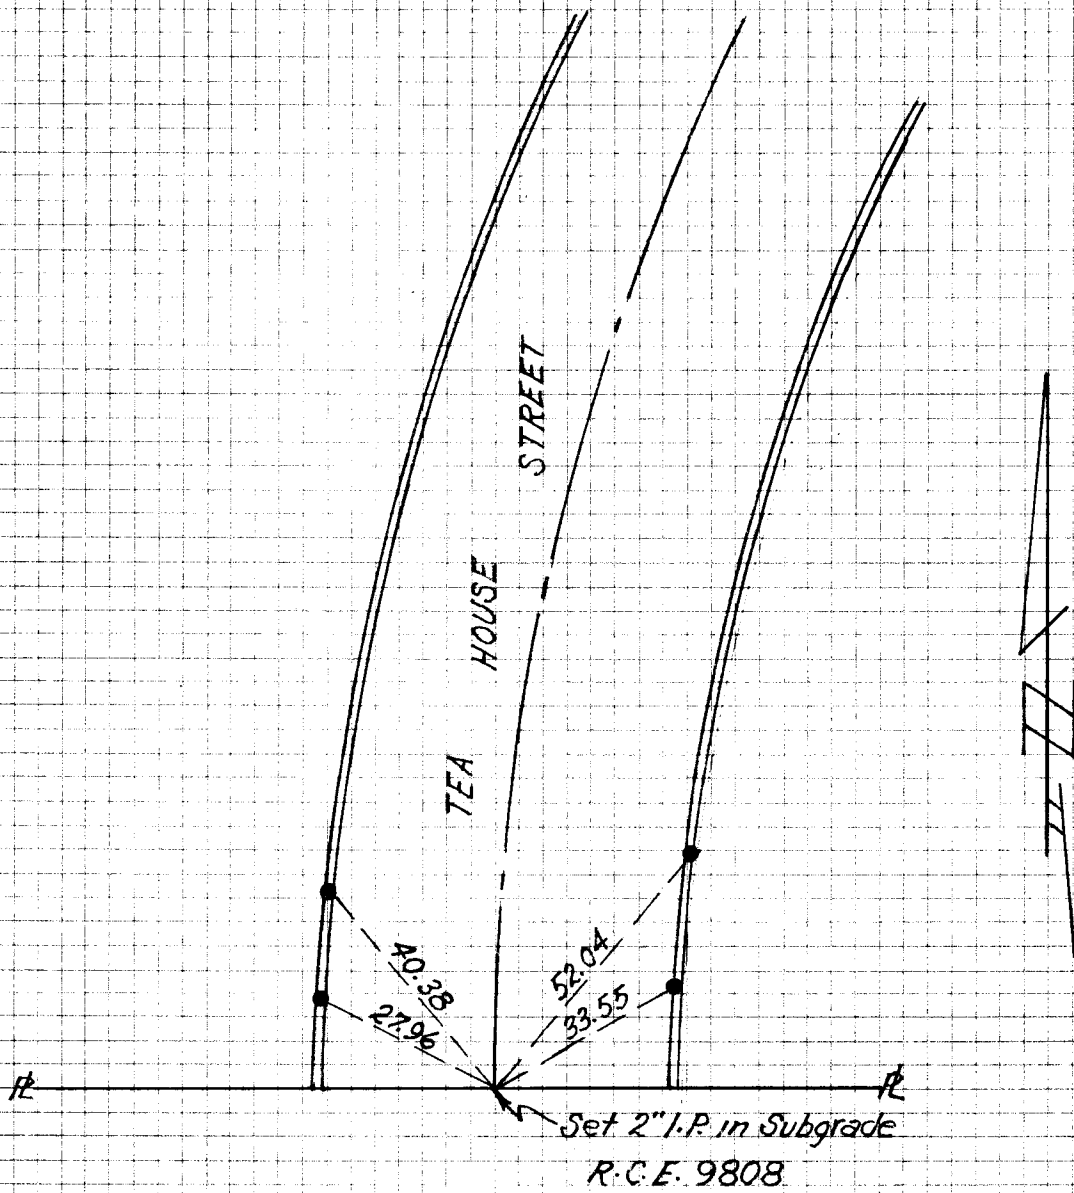

● = Set chis. + in T.C.


RECEIVED FROM MCDANIEL ENG. CO. 7/61

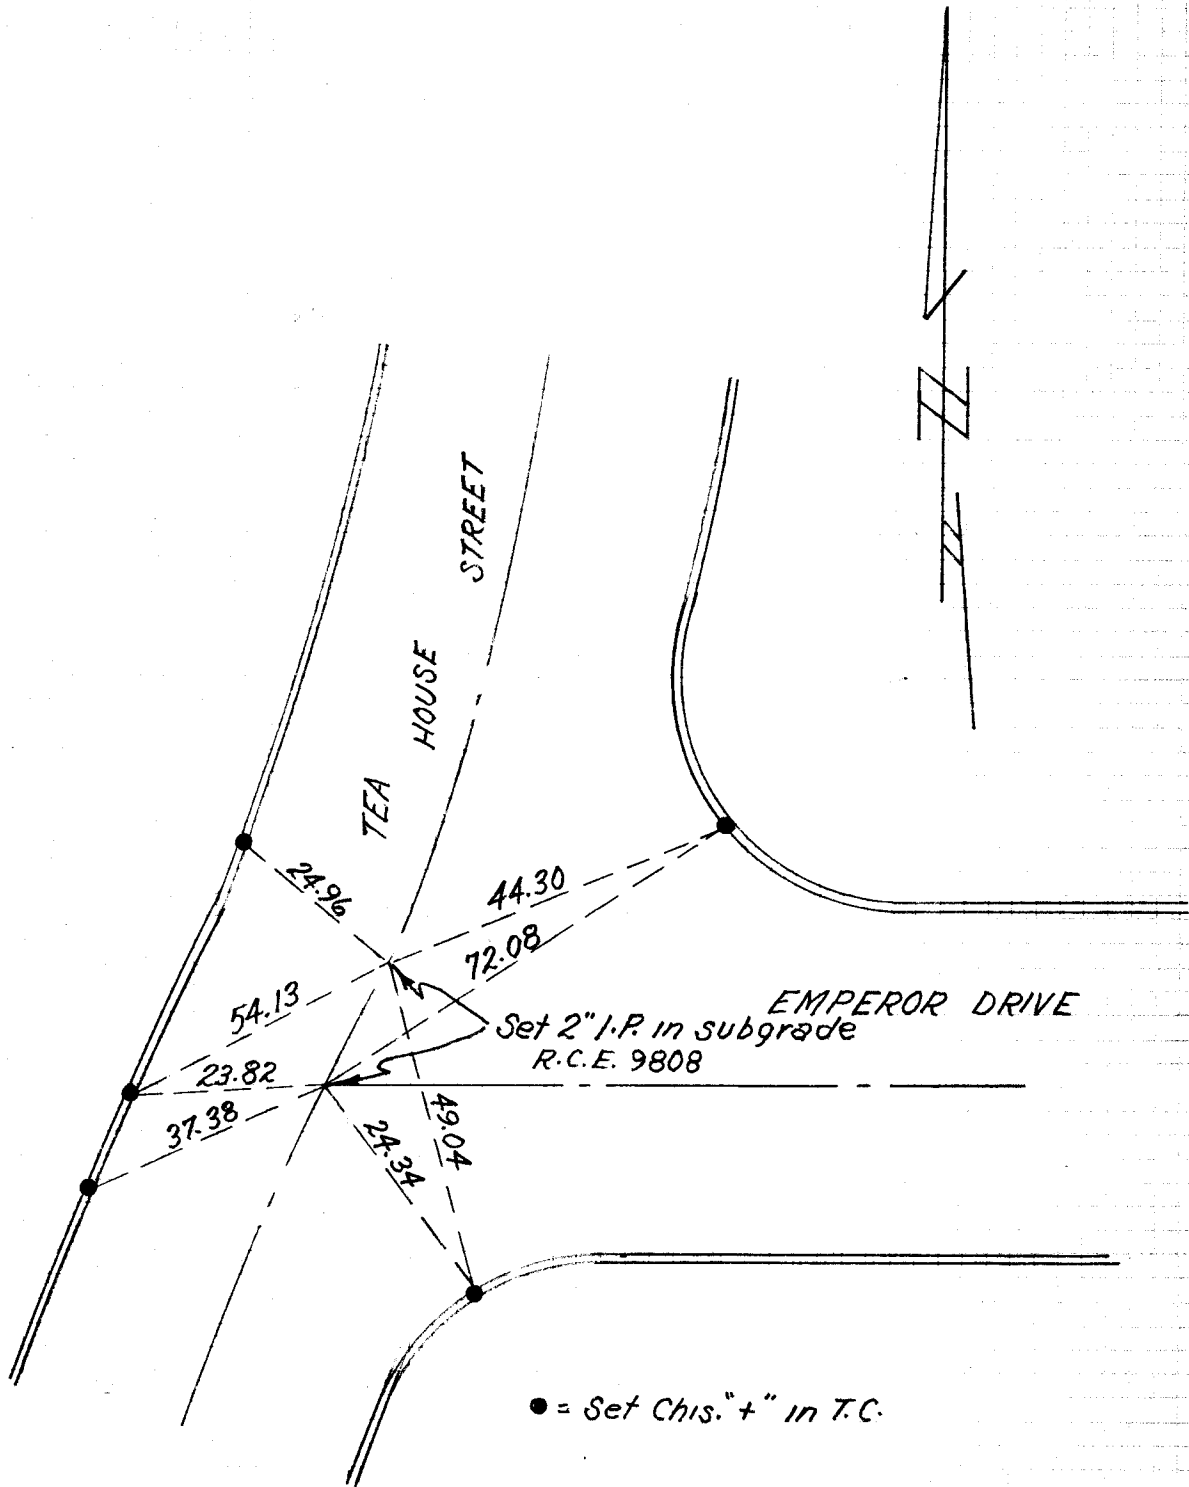THESE NOTES NOT FIELD CHECKED
BY ORANGE COUNTY SURVEYOR

RECEIVED FROM MCDANIEL ENG. CO. 7/61

ORANGE COUNTY SURVEYOR

THESE NOTES NOT FIELD CHECKED
BY ORANGE COUNTY SURVEYOR

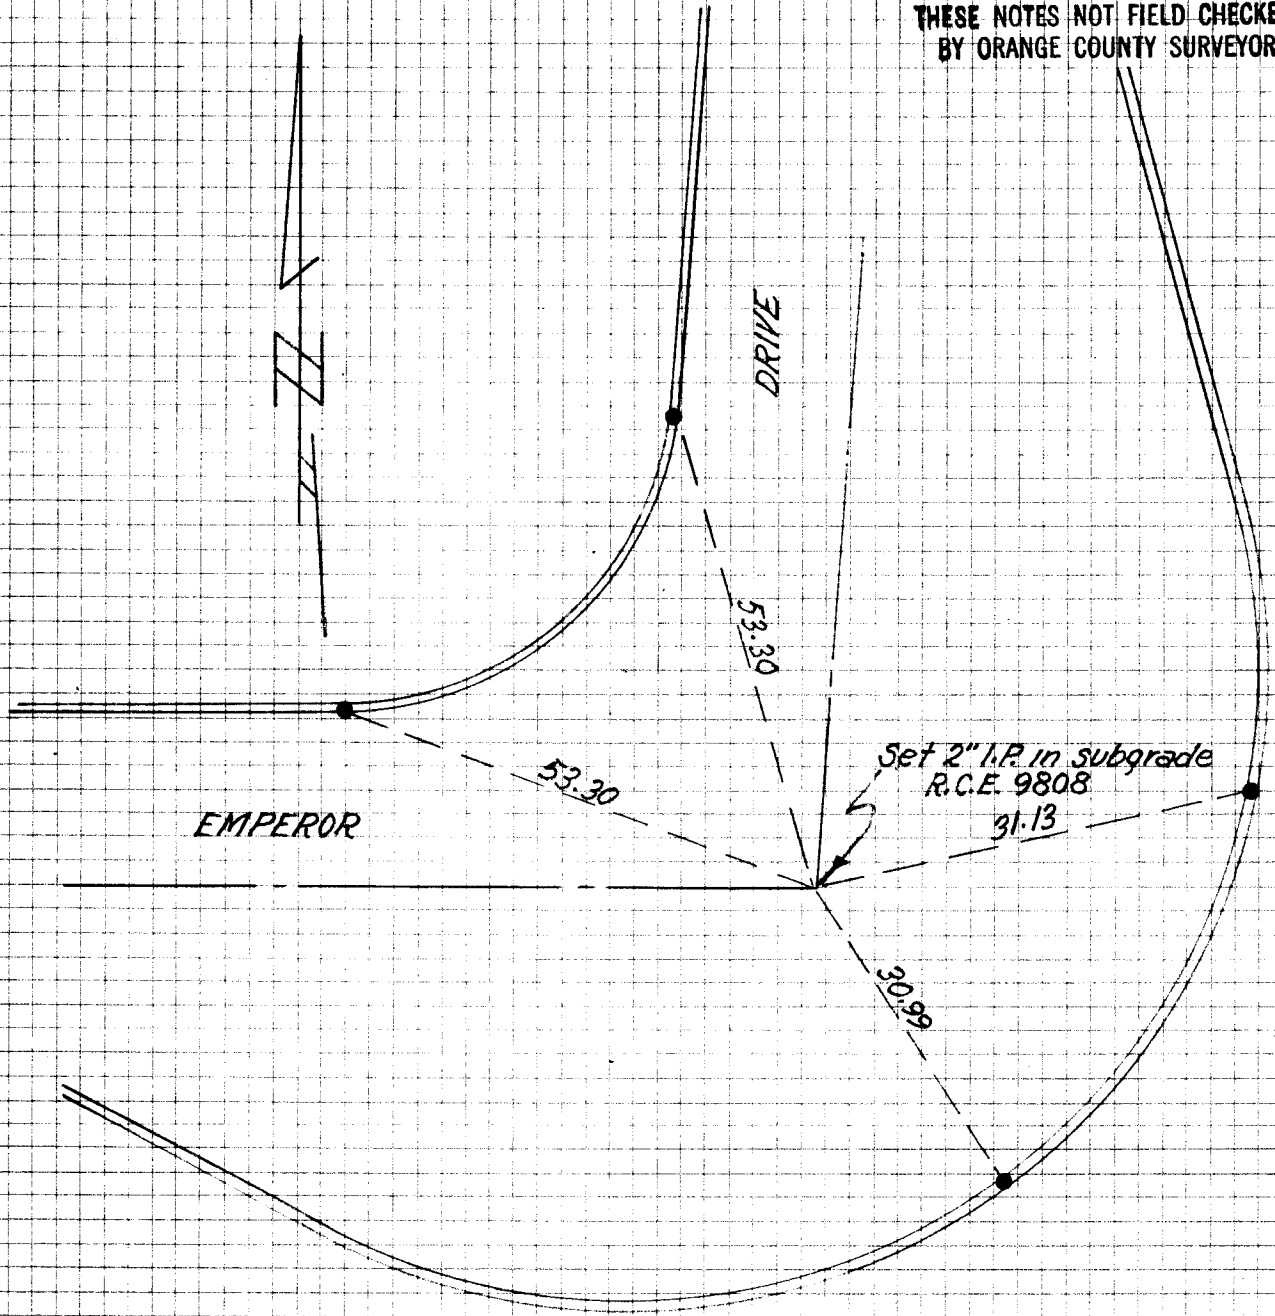


● = Set Chis. "+" in T.C.

DATE

CHECKED BY

RECEIVED FROM MCDANIEL ENG CO. 7/61

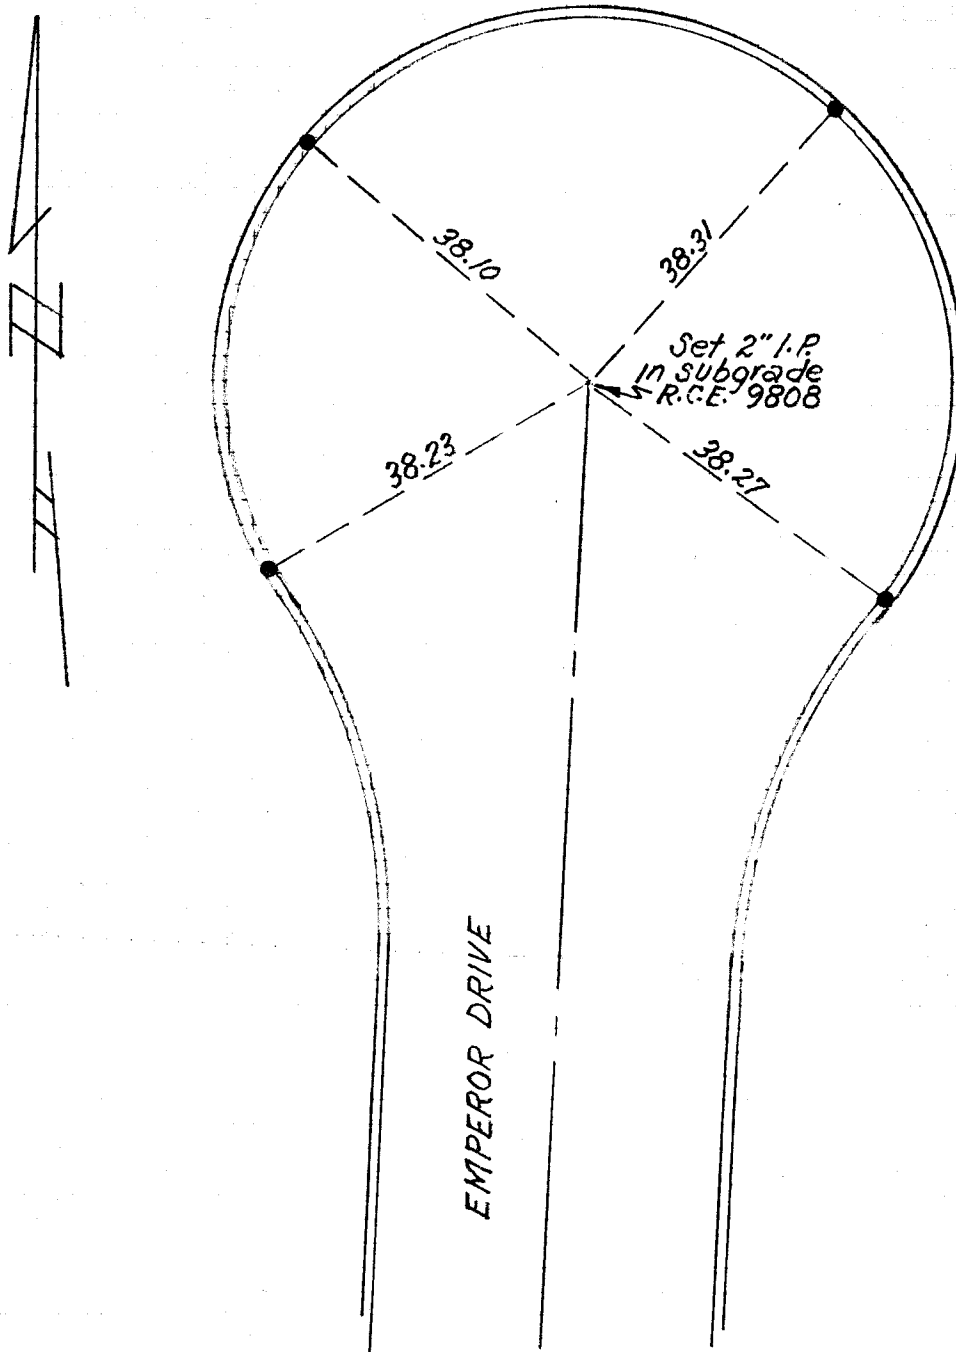THESE NOTES NOT FIELD CHECKED
BY ORANGE COUNTY SURVEYOR

● = Set Chis "+" in T.C.

ORANGE COUNTY SURVEYOR

CHECKED BY _____ DATE _____

RECEIVED FROM MCDANIEL ENG. CO. 7/61


ORANGE COUNTY SURVEYOR

DATE


CHECKED BY

2M 3/57

THESE NOTES NOT FIELD CHECKED
BY ORANGE COUNTY SURVEYOR

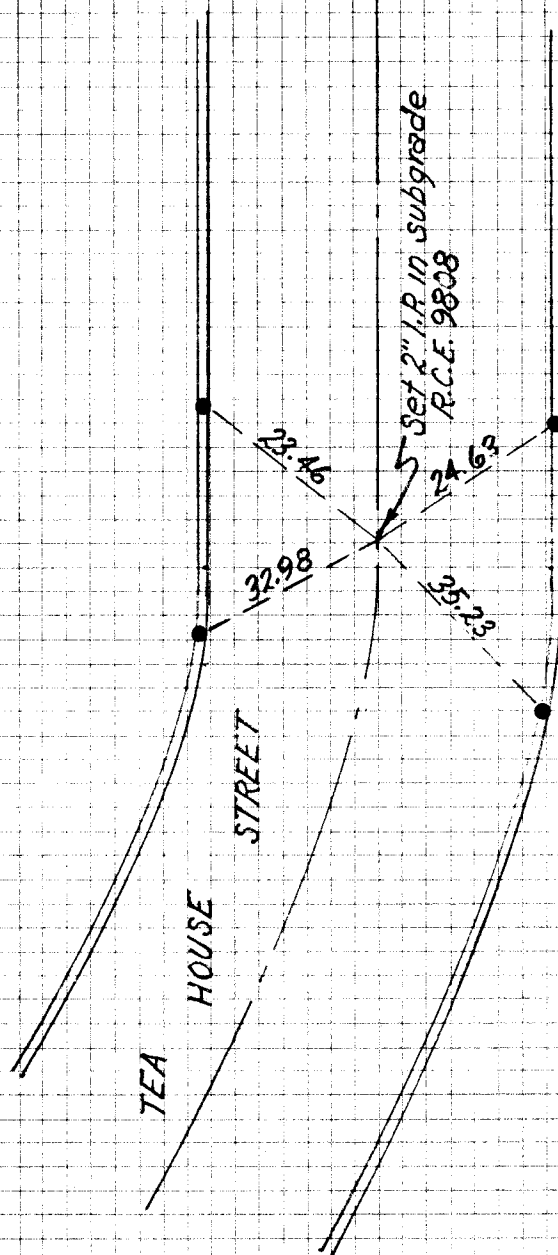

RECEIVED FROM MCDANIEL ENG. CO. 7/61

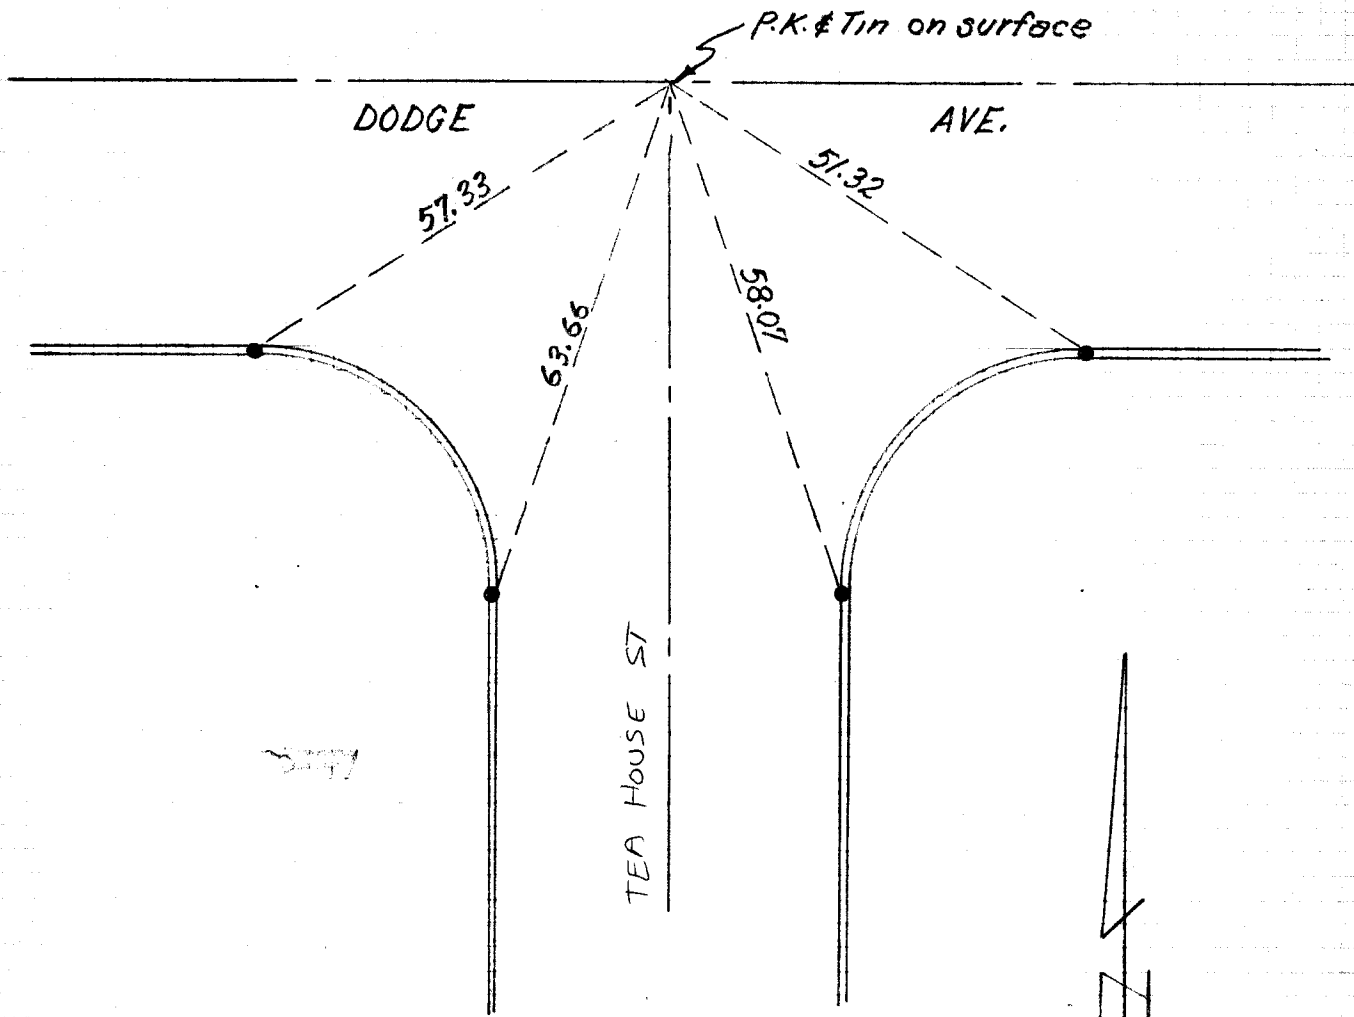THESE NOTES NOT FIELD CHECKED
BY ORANGE COUNTY SURVEYOR

● = Set Chis "+" in T.C.

ORANGE COUNTY SURVEYOR

DATE

CHECKED BY