

SHEET No 1
SAN JUAN CAPISTRANO AND VICINITY
ORANGE CO CALIF.
SCALE, 1" = 600 FEET

[illegible]

I, John F. Duling hereby certify that I am a civil Engineer and Licensed Surveyor of the State of California, and that the map, comparison of the said correctly represents a survey made under my supervision between April 1919 and June, 1920, and that all of the monuments shown thereon actually exist and that their positions are correctly shown.

John P. Duling
Licensed Surgeon

NOTE -
A 2 pipe is set at all corners marked O
unless otherwise noted

SEE SHEET N° 2

$$\begin{array}{r} \text{T.7 S.} \\ \hline \text{T.8 S.} \end{array} \quad \begin{array}{l} \\ \text{Remainder} \end{array}$$

R. 8 W.
R. 8 W.

SEE SHEET No 5

SEE SHEET No 4

SHEET No 2


SAN JUAN CAPISTRANO AND VICINITY


ORANGE CO. CALIF
SCALE, 1" = 600 FEET

Indexed

FILED
JUN 9 1920

Pt. 03 min past 1 o'clock P.
I REQUEST OF
E. T. Duling
CLERK, COUNTY RECORDS
Jessie M. Thompson
Dec 7

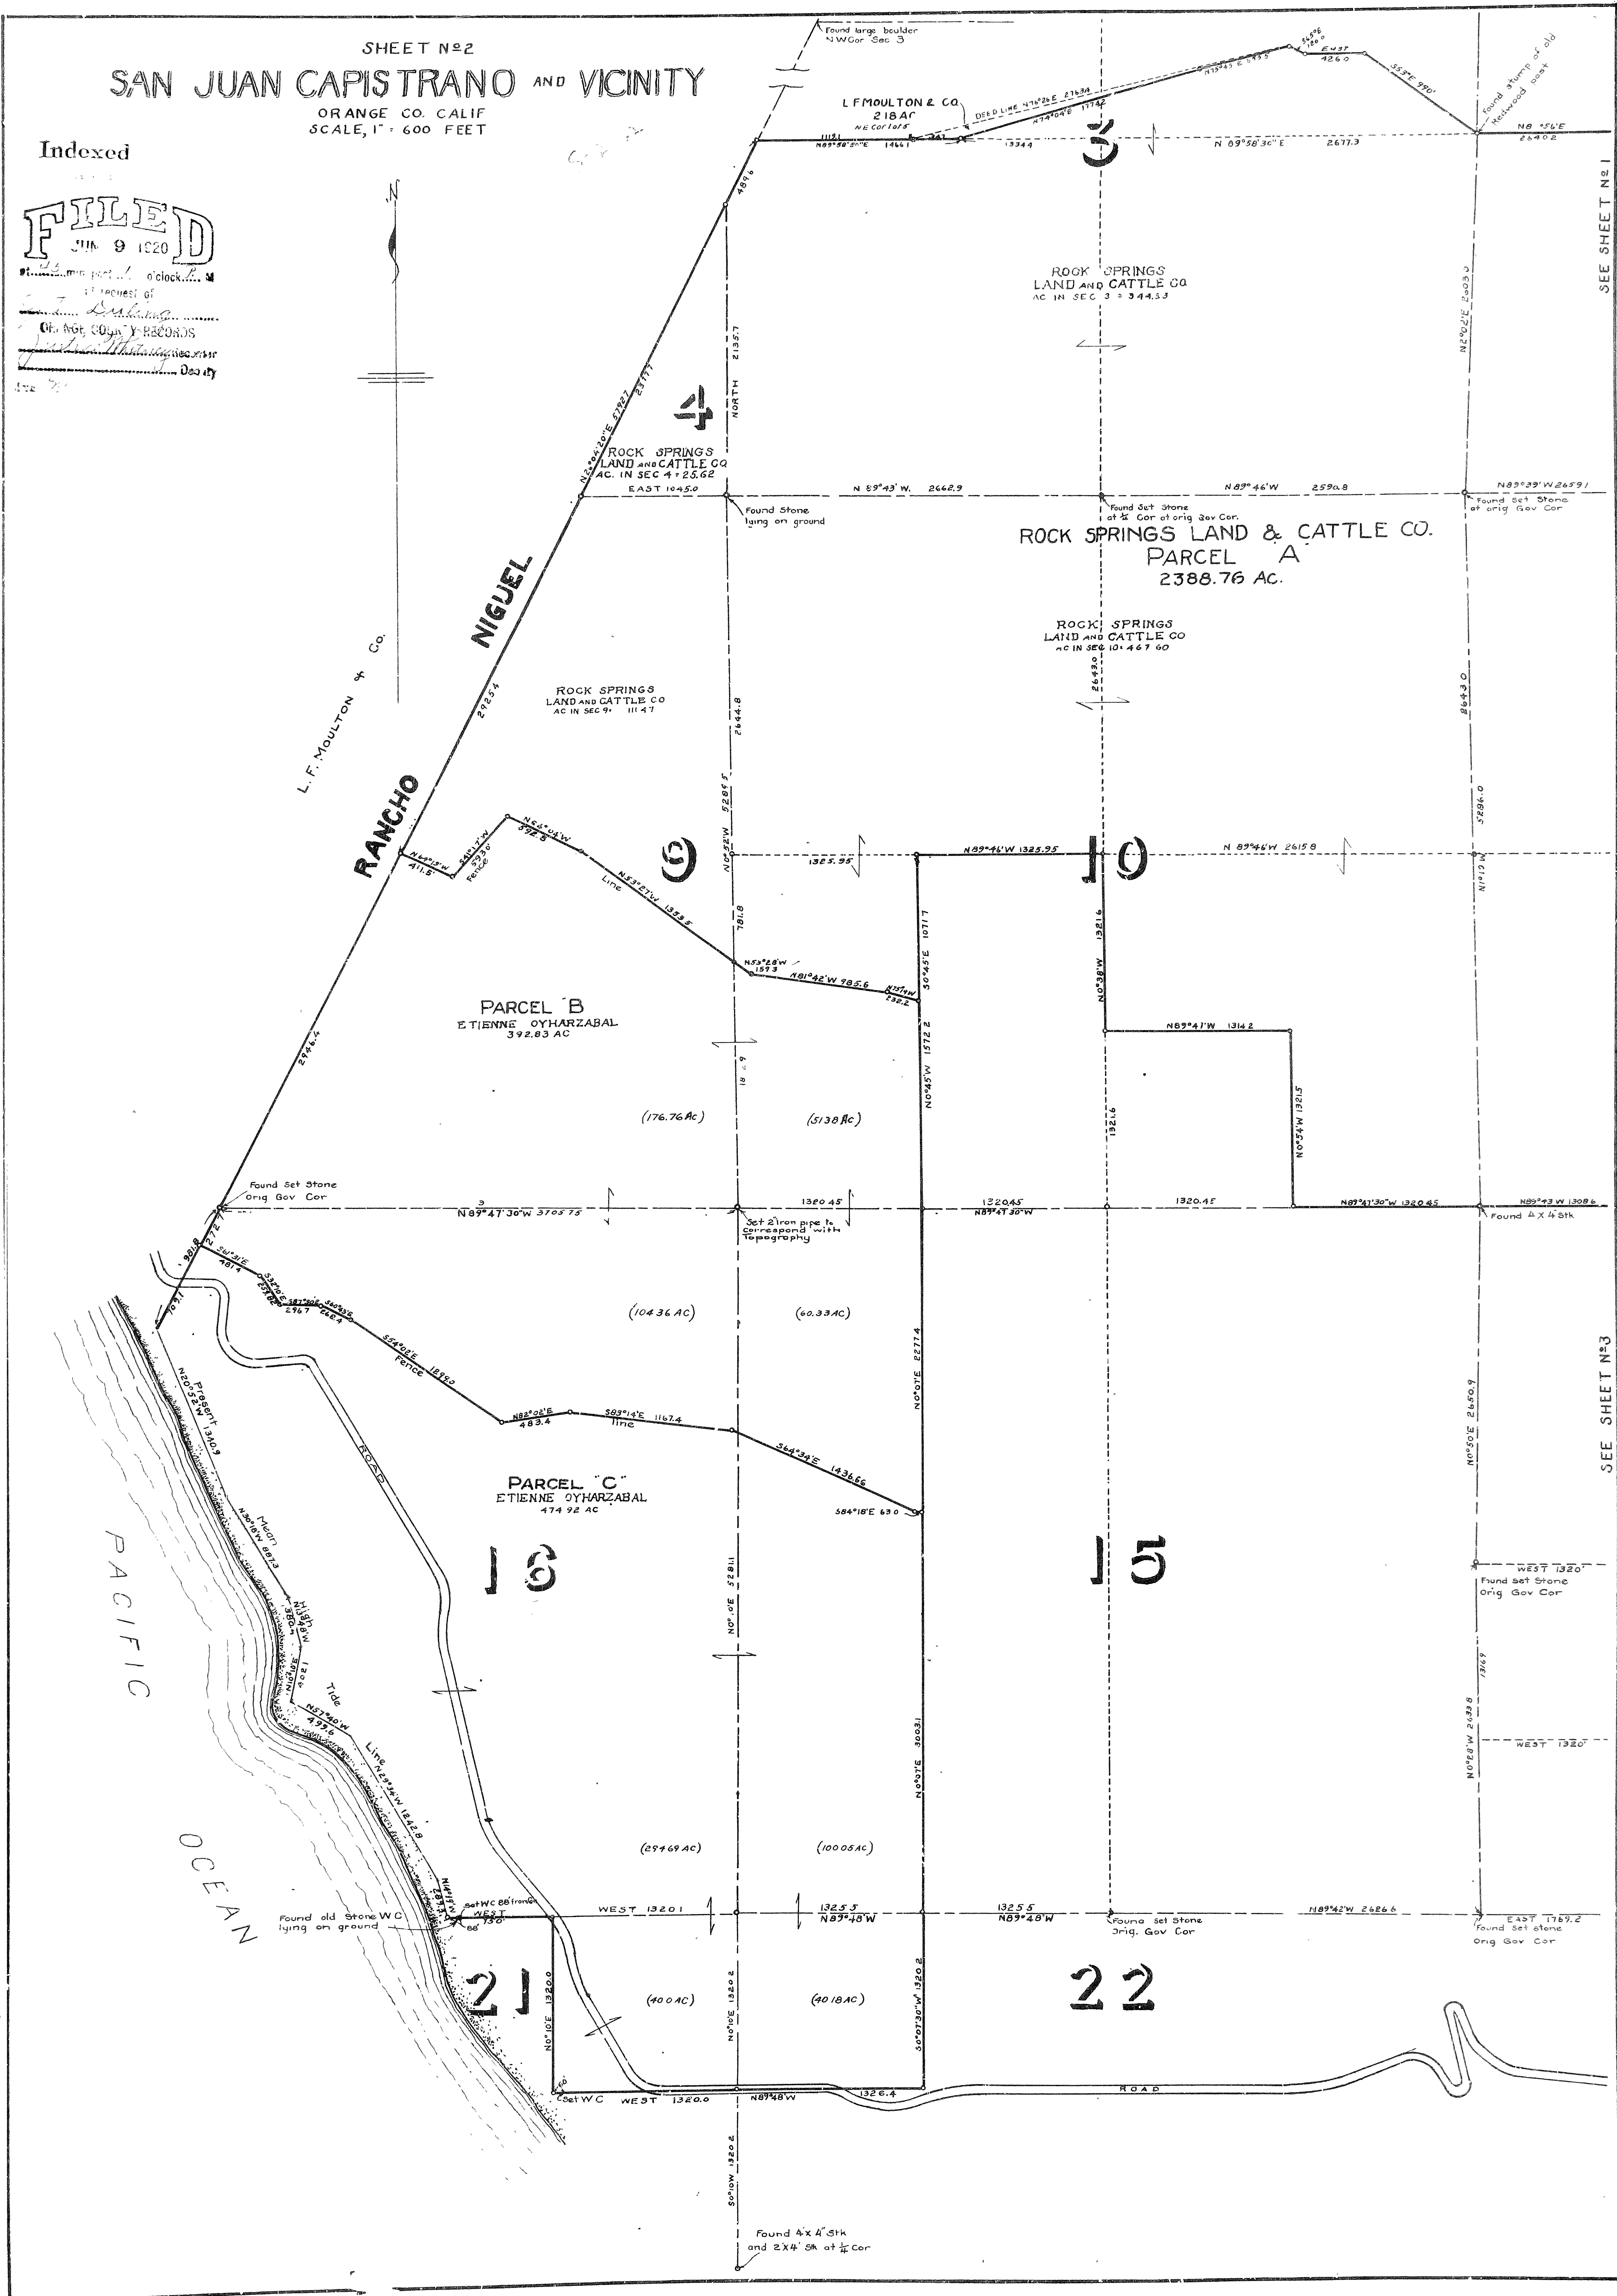

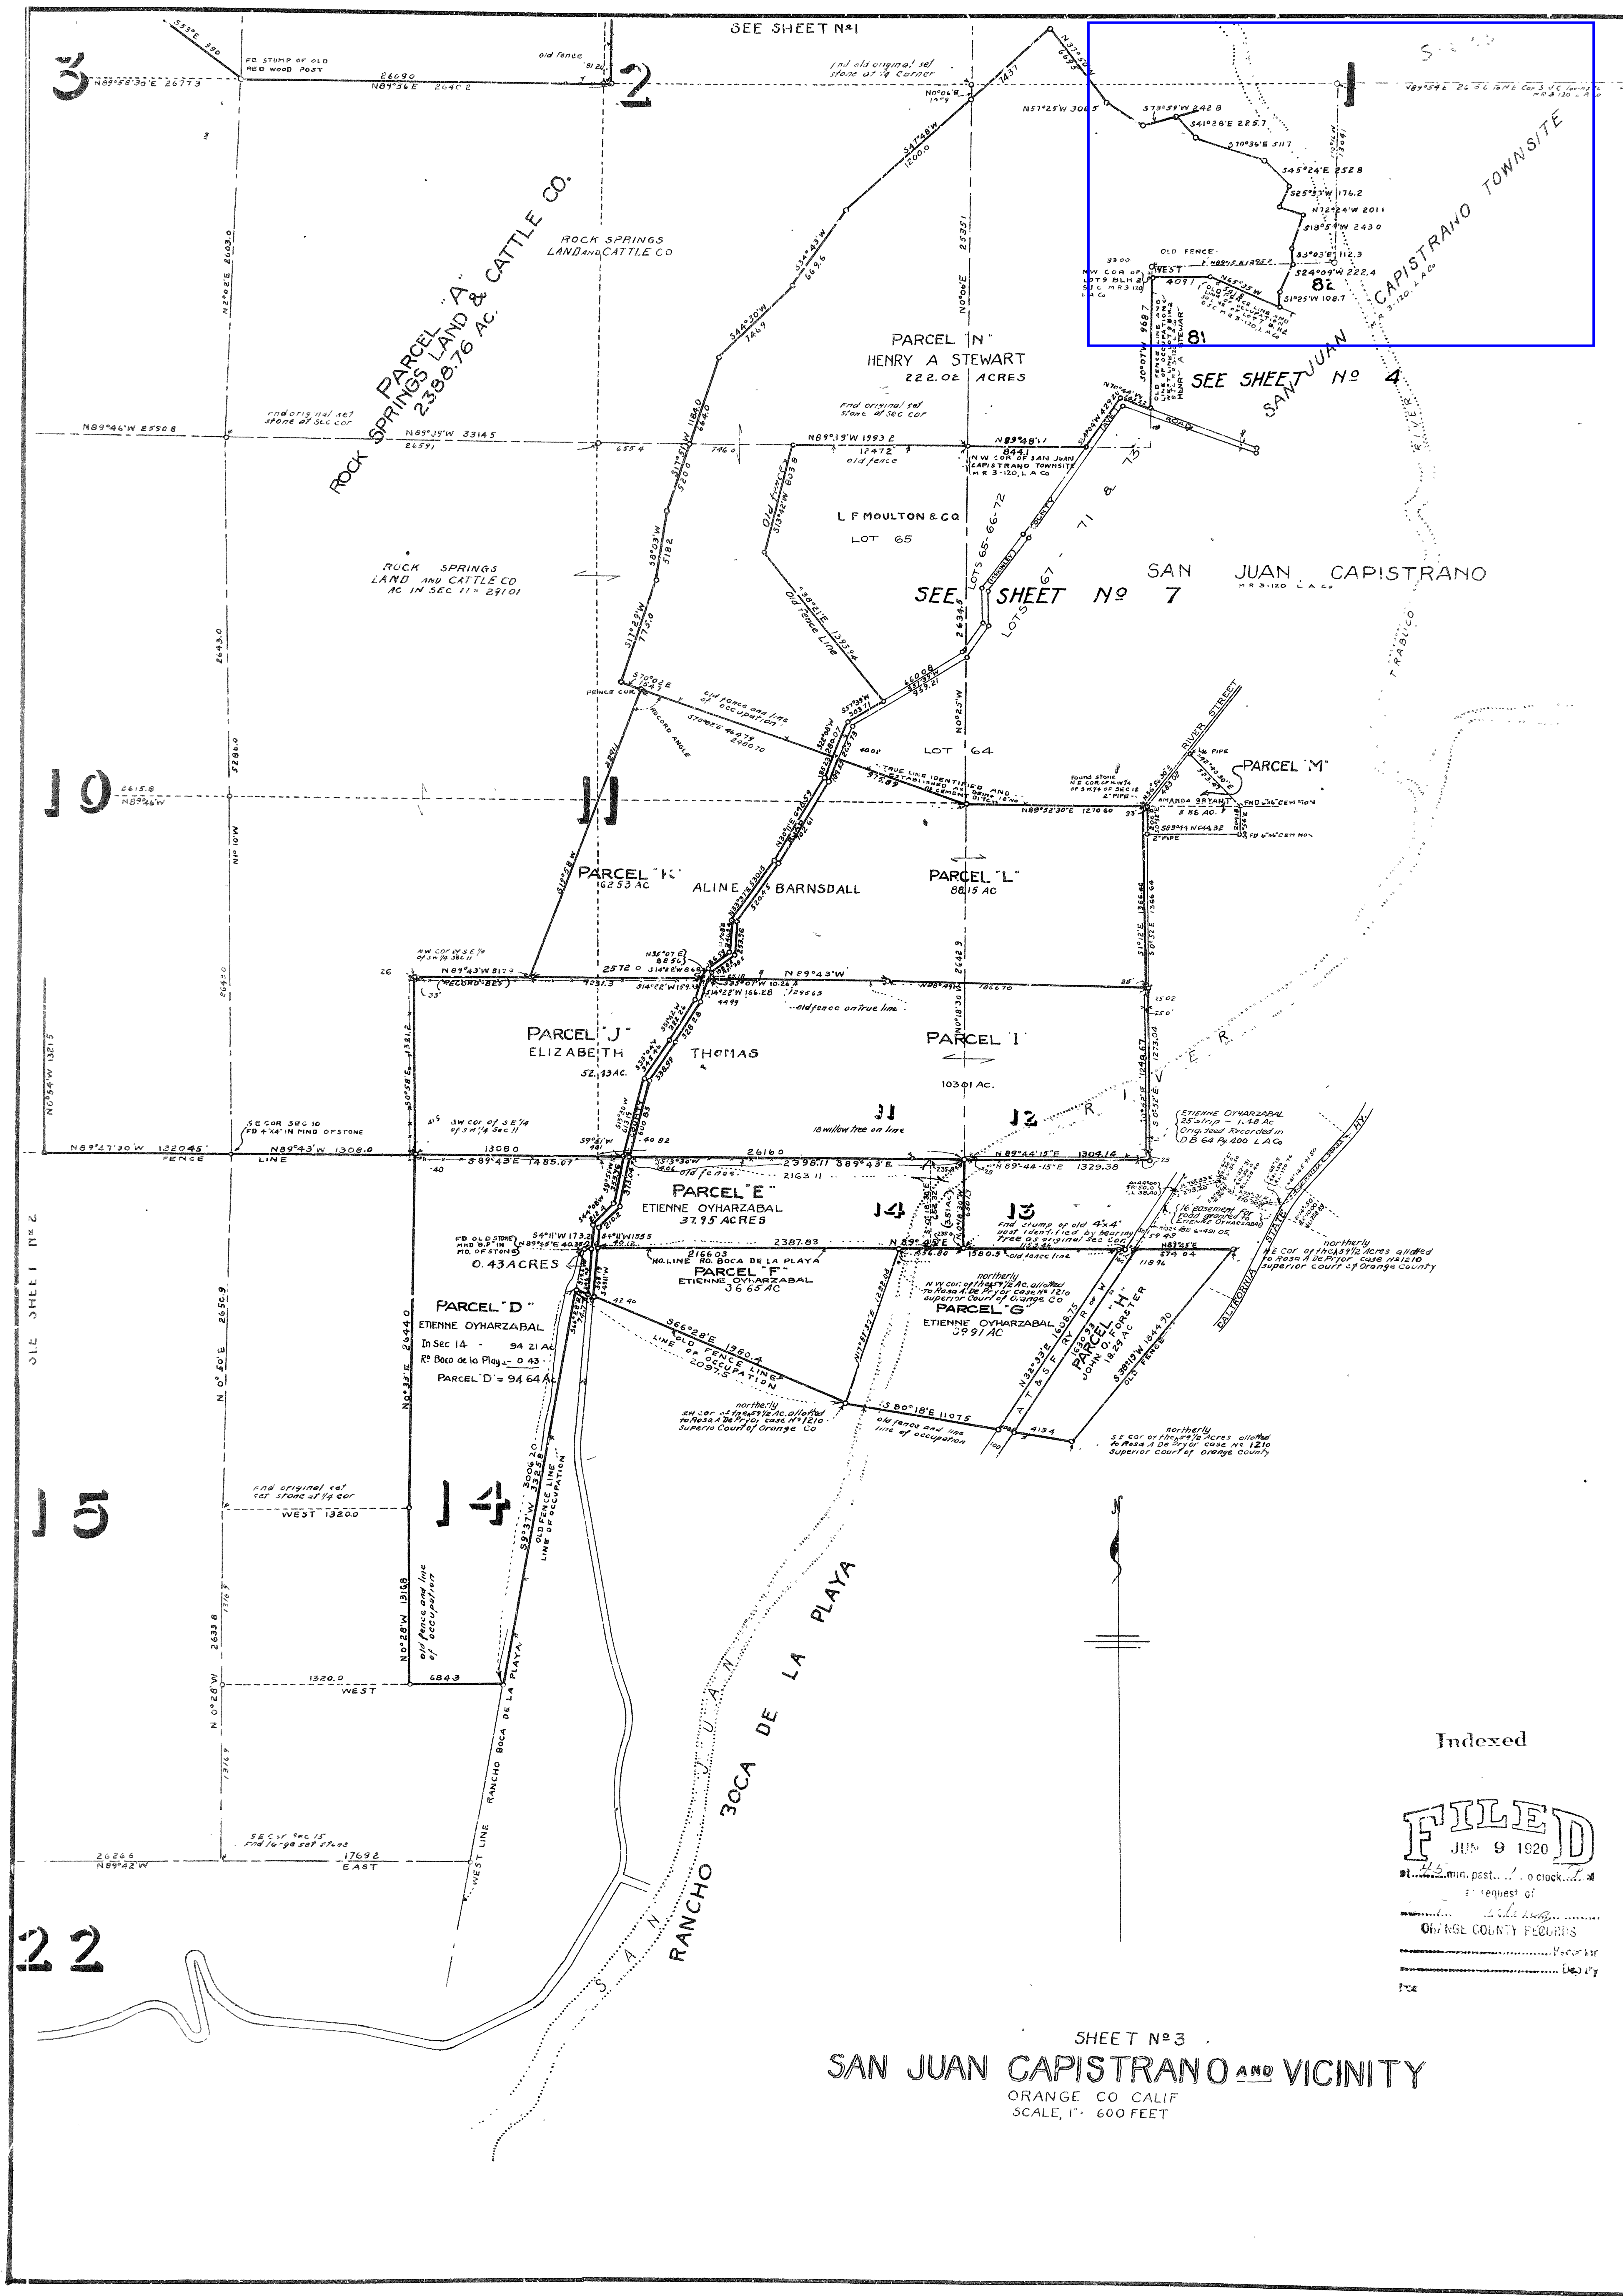

Indexed

FILED
JUN 9 1920

11:45 min past 1 o'clock
request of
CHANGE COUNTY RECORDS
Dep. 17

SHEET NO 4
SAN JUAN CAPISTRANO AND VICINITY
ORANGE COUNTY, CALIF.
Scale 1"=200'


SEE SHEET NO 1

SEE SHEET NO 1 & 3

SEE SHEET NO 5


SEE SHEET NO 7

SEE SHEET NO 6

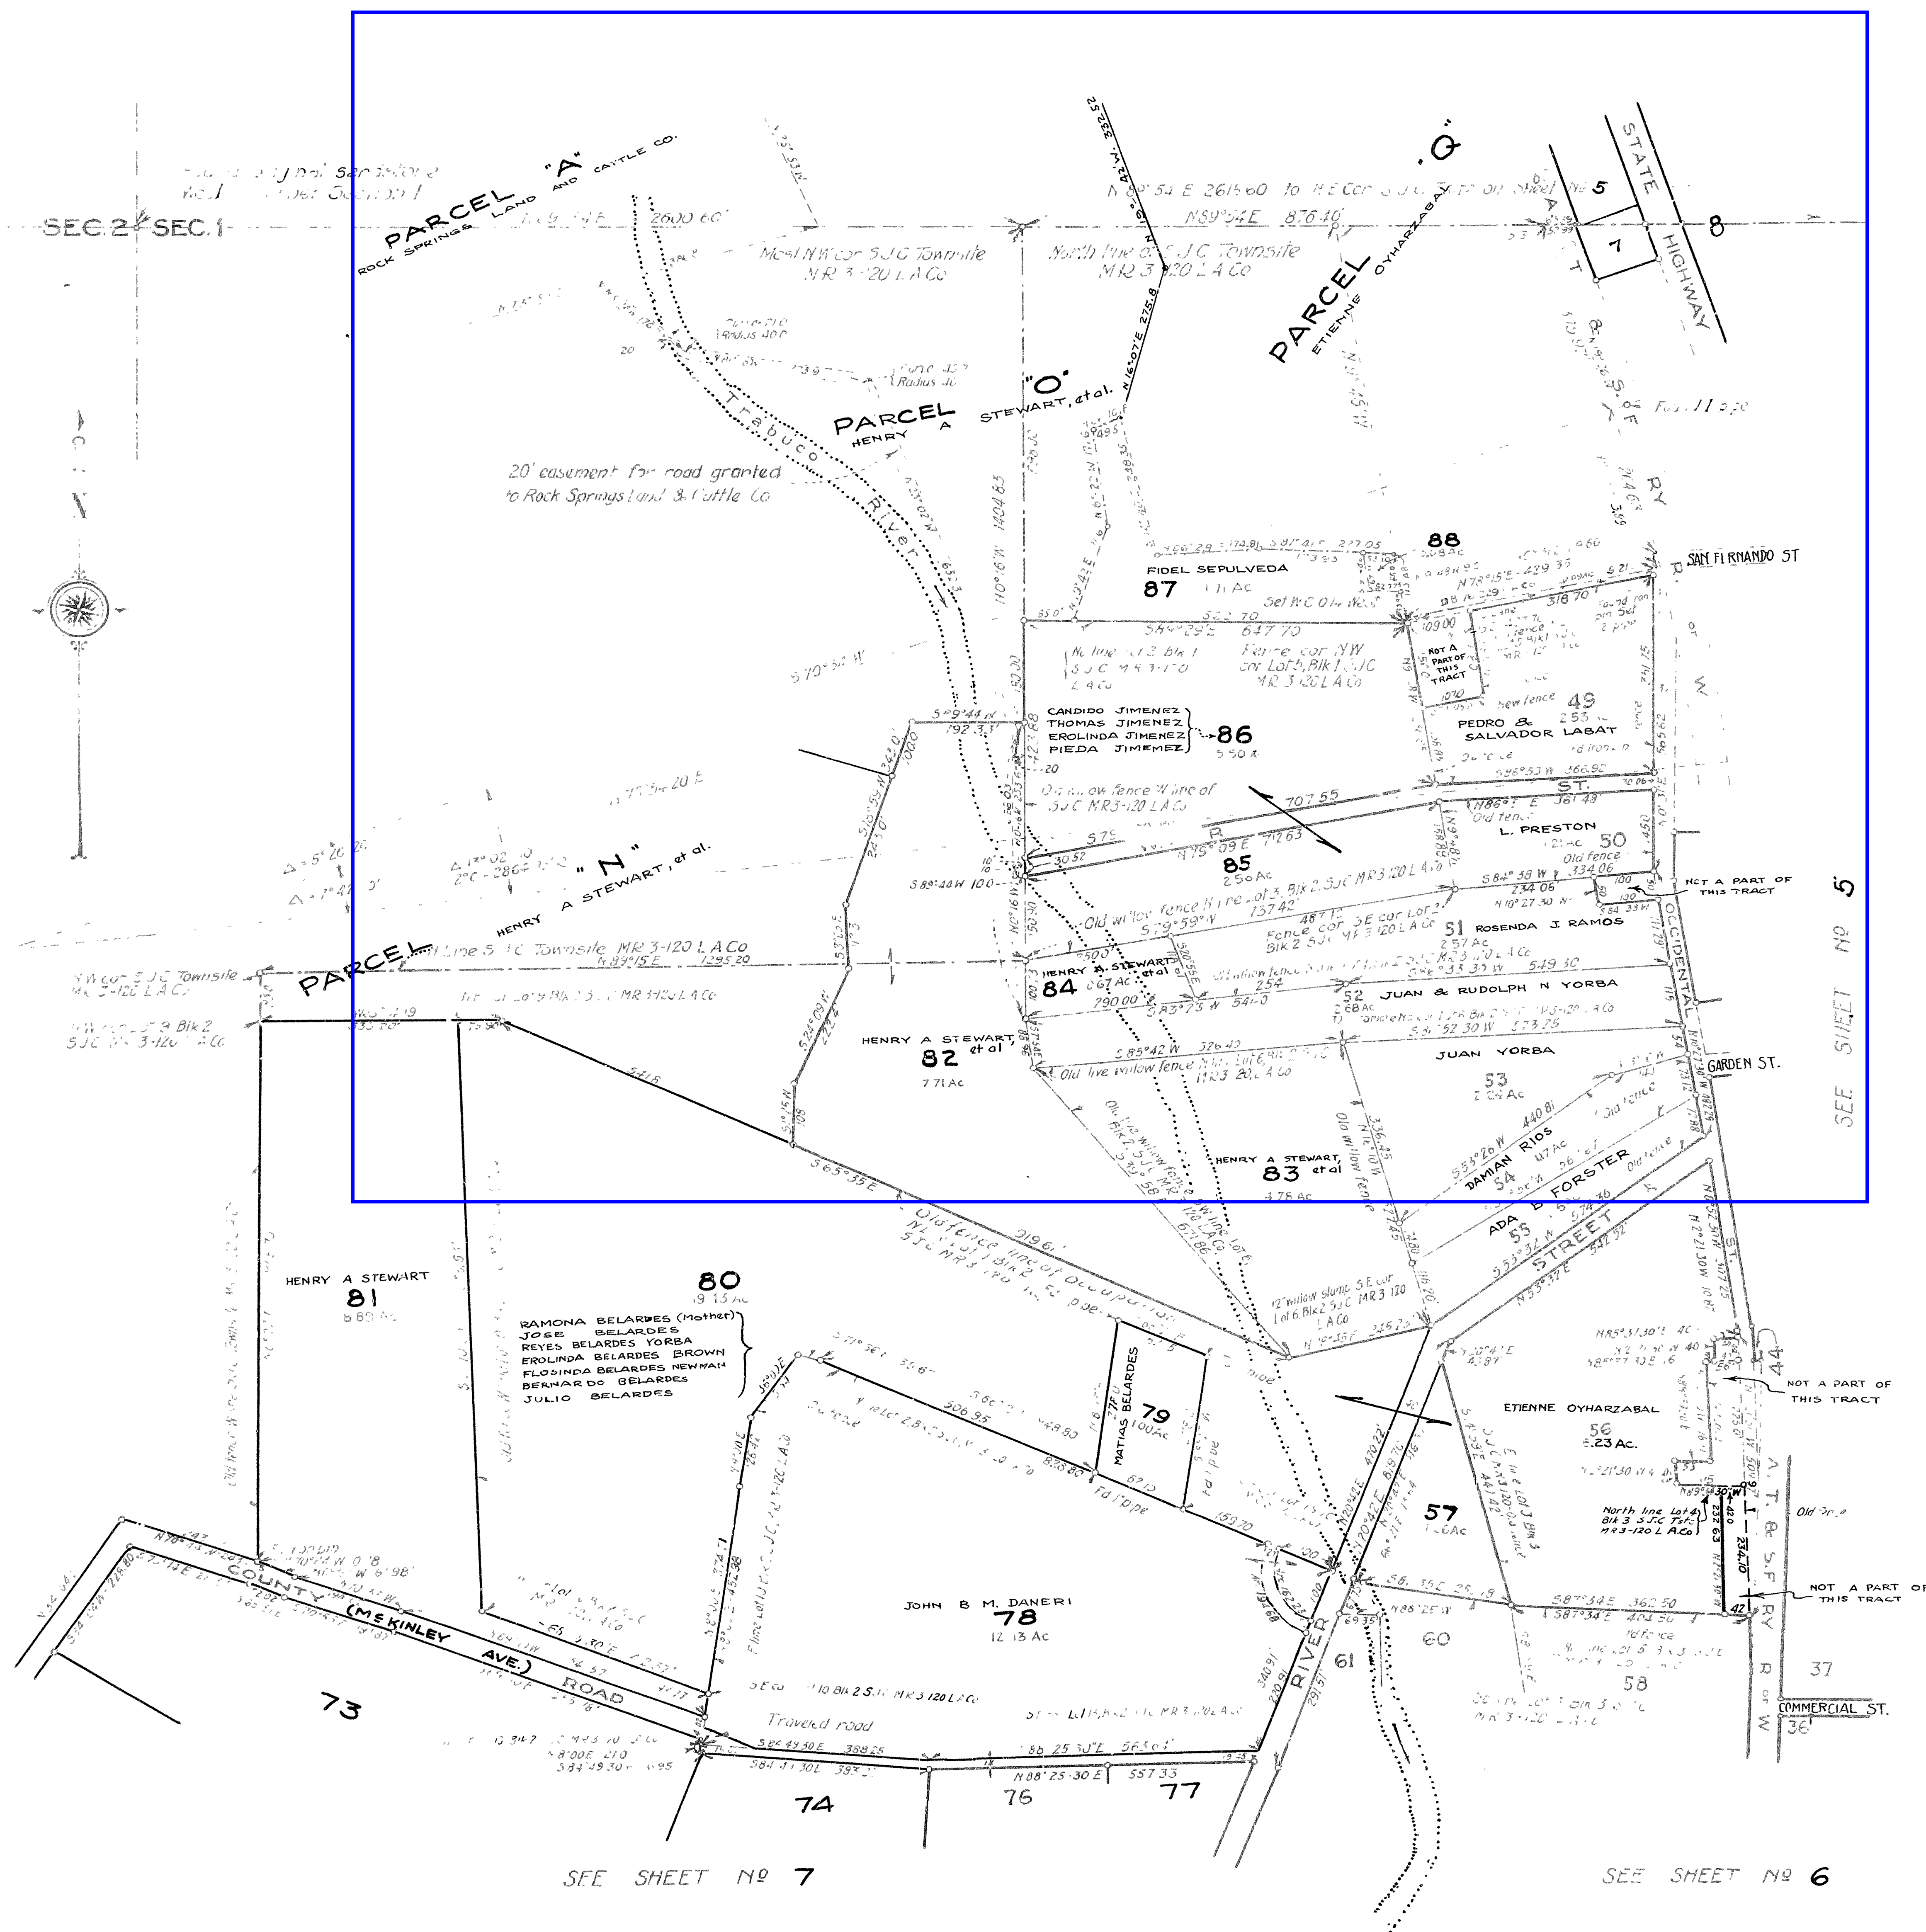

SEE SHEET NO 1

PARCEL "T"

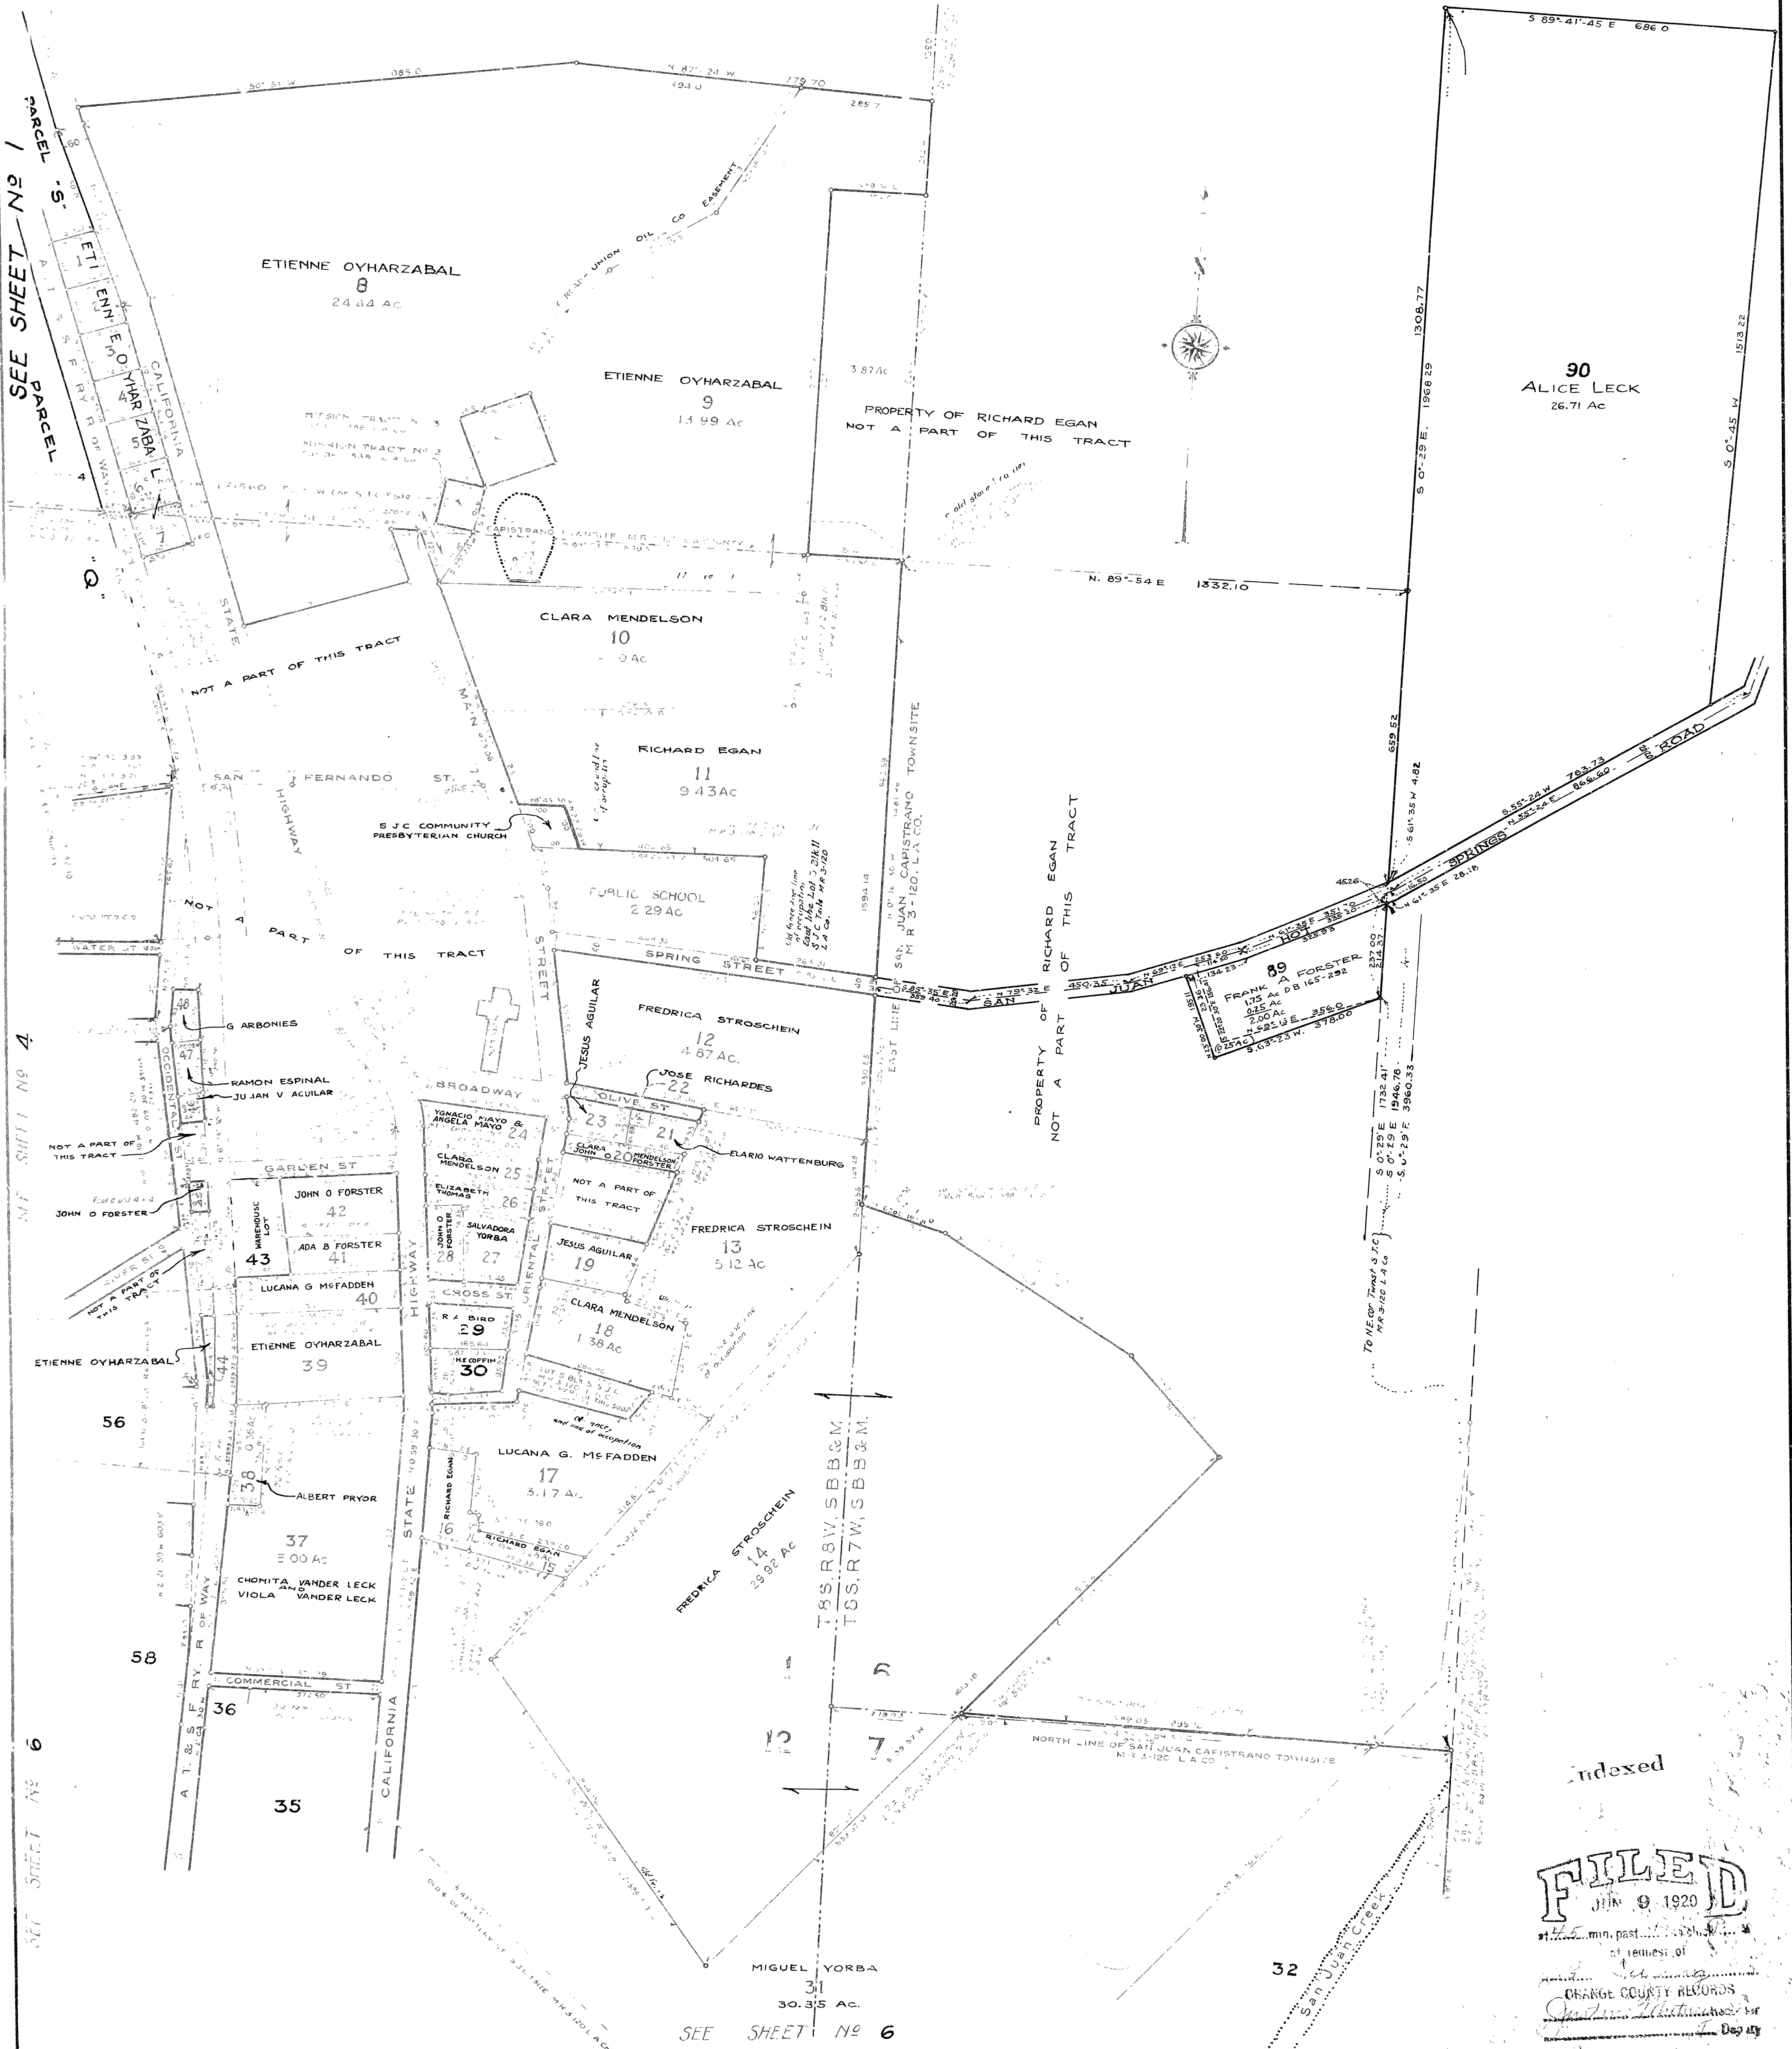


Indexed

FILED
JUN 9 1920
ORANGE COUNTY RECORDS
Dep. 45

SAN JUAN CAPISTRANO VICINITY
SHEET NO 3
ORANGE COUNTY, CALIF.
Scale 1"=200'

Indexed


FILED
JUL 9 1920
at min. past o'clock
at request of
ORANGE COUNTY RECORDS
By

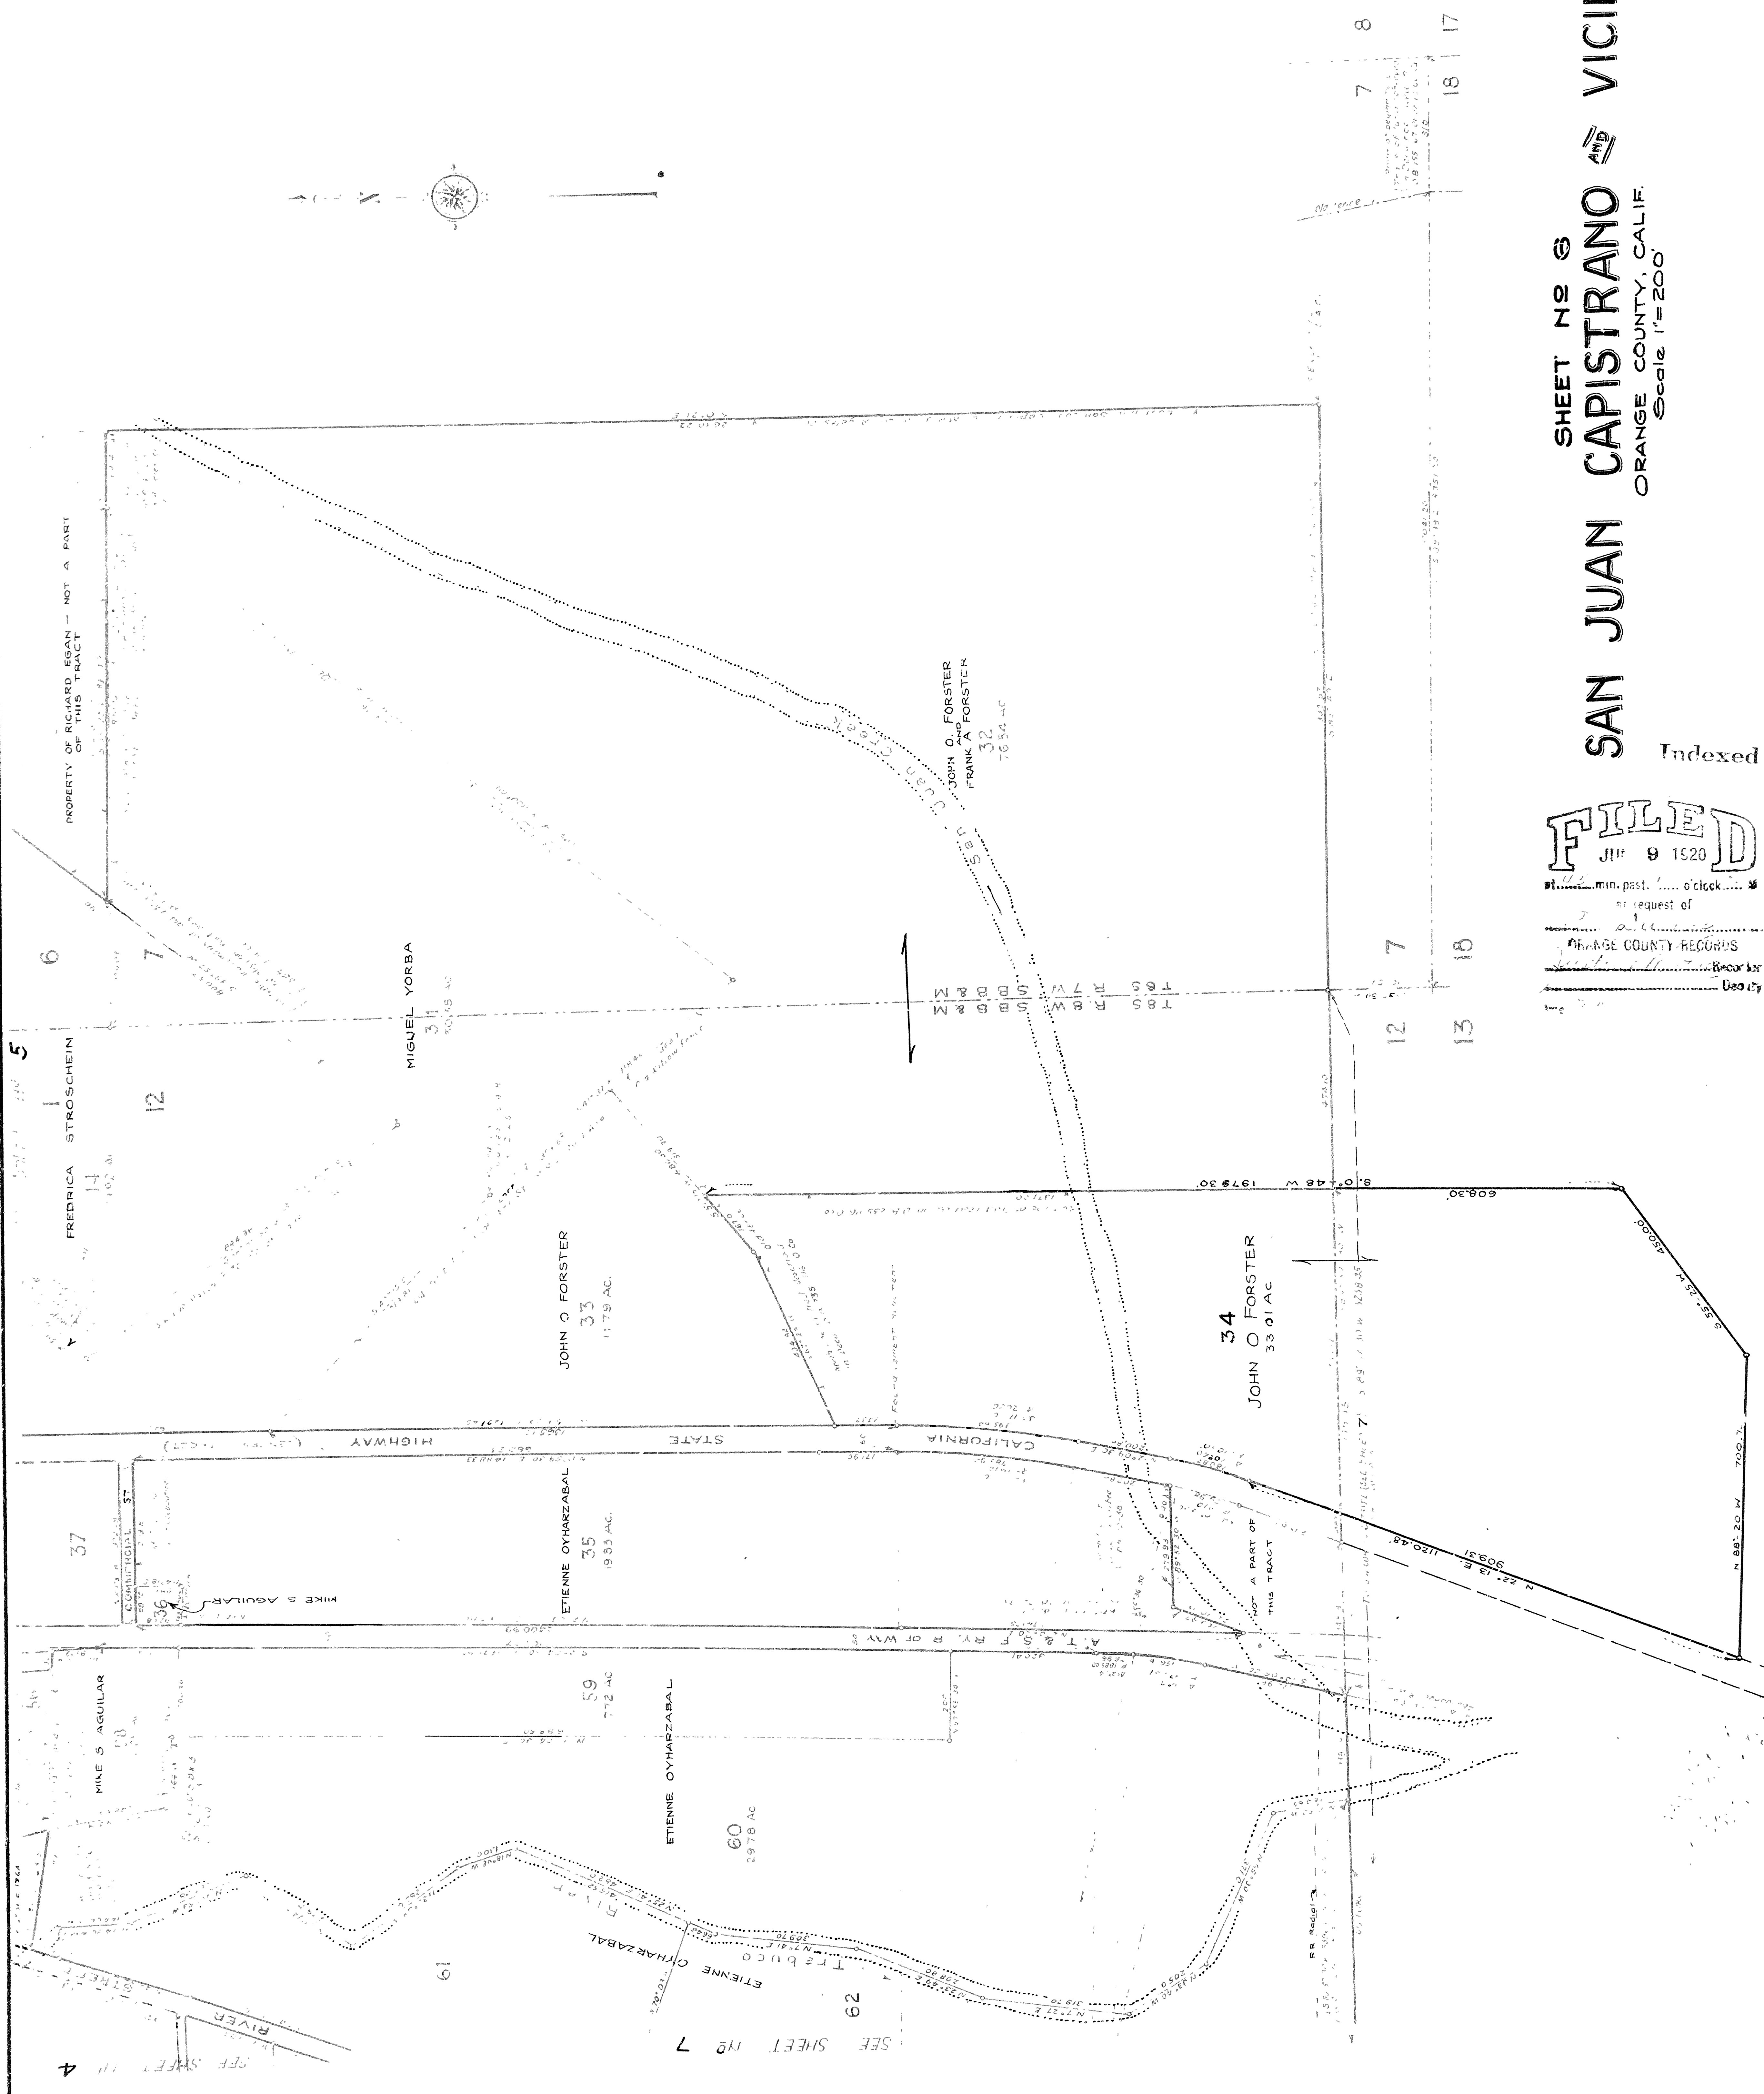

SEE SHEET NO 3

SEE SHEET NO 3

SEE SHEET NO 4

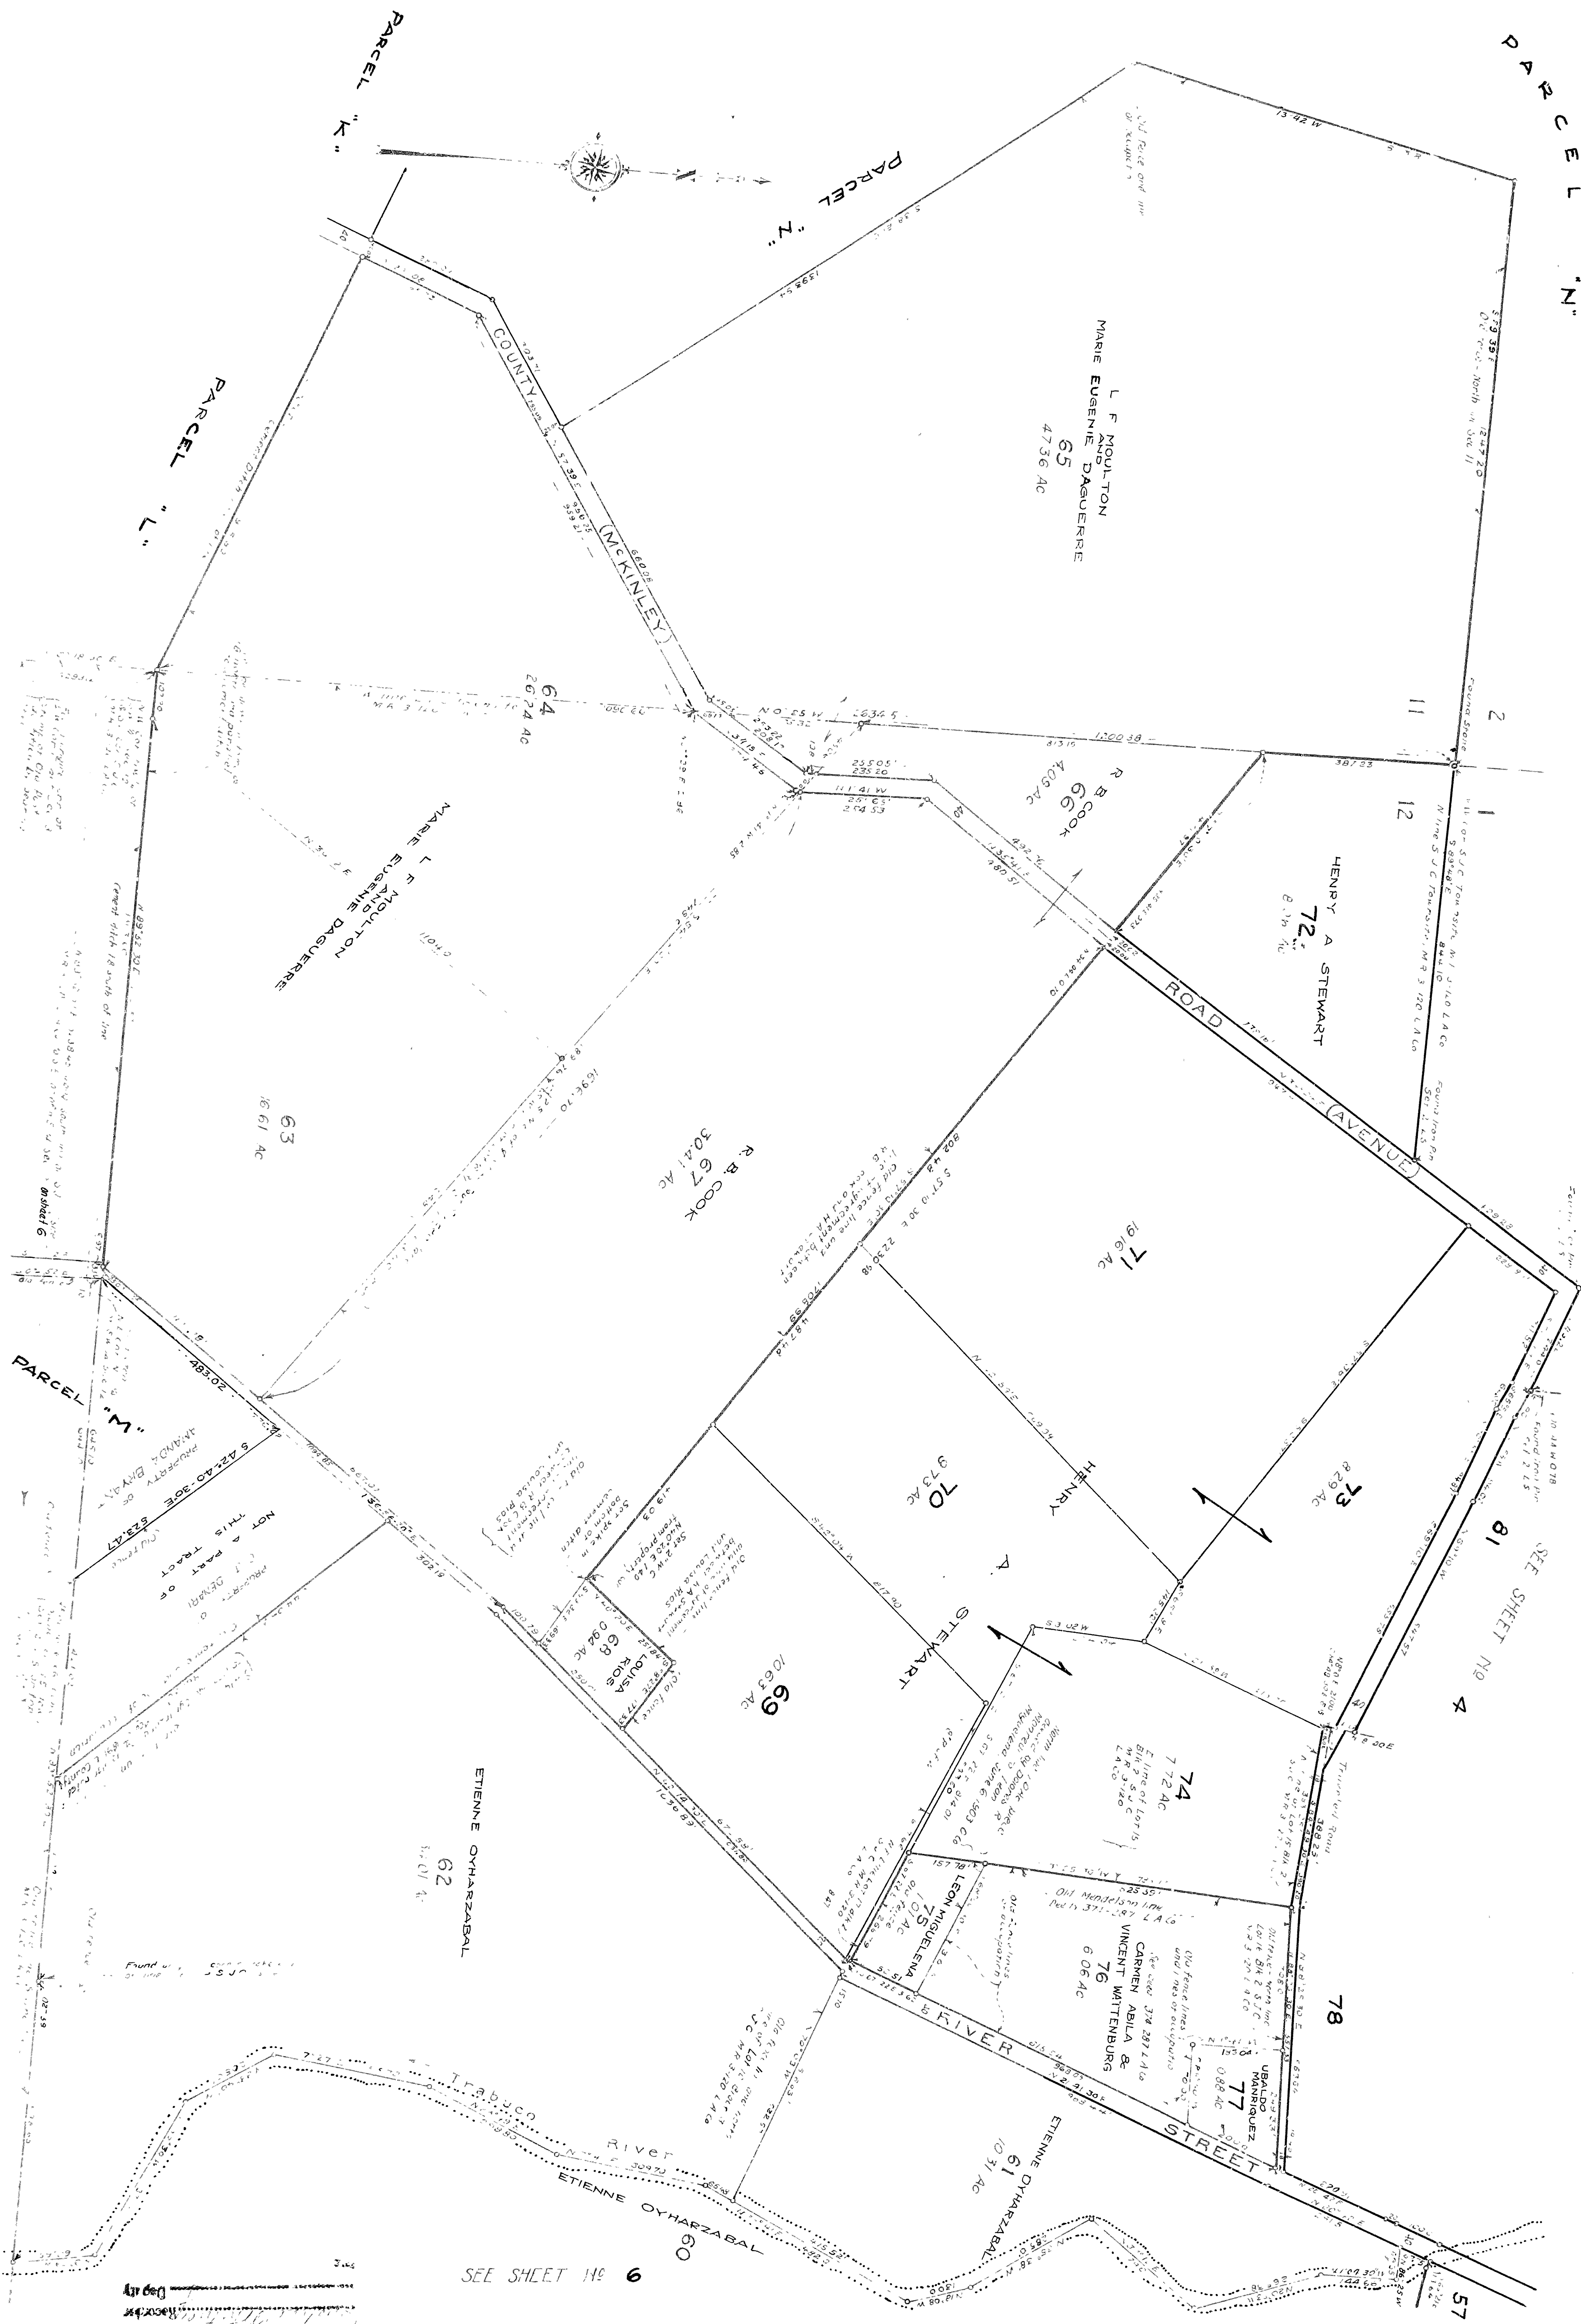

SEE SHEET NO 3

SHEET NO 7
SAN JUAN CAPISTRANO VICINITY
ORANGE COUNTY, CALIF.
Scale 1"=200'

FILED
JUN 9 1920
at request of
Orange County Records
Dep't
Indexed