


HUNSAKER & ASSOCIATES, INC.
LAND SURVEYOR: RORY WILLIAMS L.S. 6654

04-14-00

SEE SHEET 6-10**MONUMENT NOTES**

- SET 1" IRON PIPE OR LEAD, TACK & TAG OR 8" SPIKE & WASHER STAMPED L.S. 6654 OR R.C.E. 23956 (PER CERTIFICATE OF CORRECTION), UNLESS OTHERWISE NOTED.

ALL TIE POINTS ARE LEAD & TACK
TAGGED L.S. 6654 OR R.C.E. 23956
(PER CERTIFICATE OF CORRECTION)
IN TOP OF CURB.

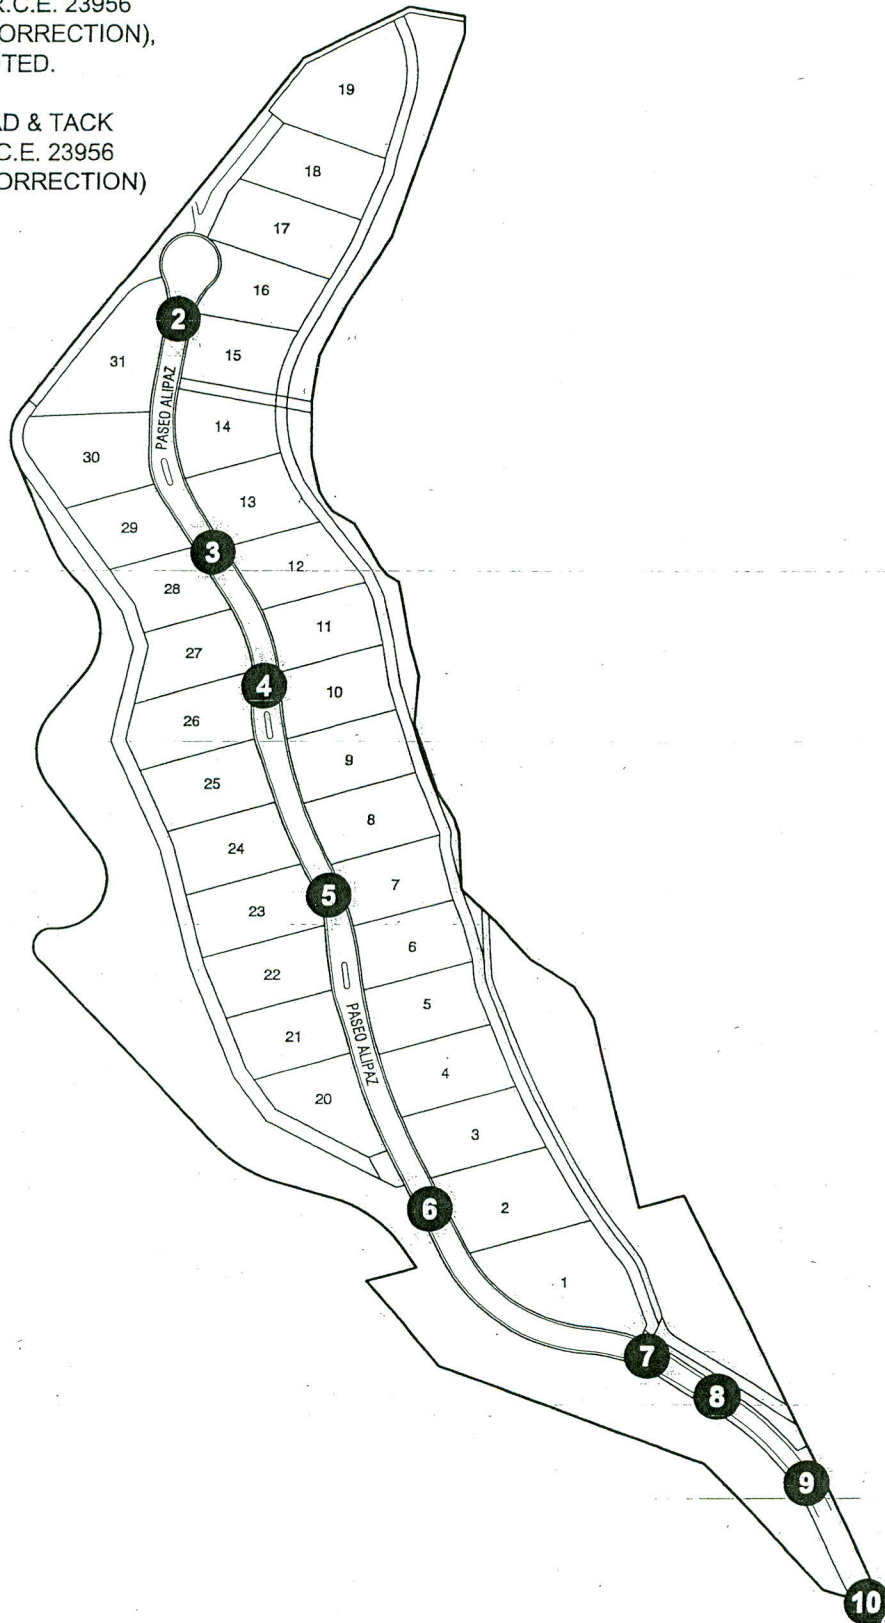

SCALE: 1" = 350'


HUNSAKER & ASSOCIATES, INC.
 LAND SURVEYOR: RORY WILLIAMS L.S.6654

04-14-00

MONUMENT NOTES

- SET 1" IRON PIPE OR LEAD, TACK & TAG OR 8" SPIKE & WASHER STAMPED L.S. 6654 OR R.C.E. 23956 (PER CERTIFICATE OF CORRECTION), UNLESS OTHERWISE NOTED.

ALL TIE POINTS ARE LEAD & TACK TAGGED L.S. 6654 OR R.C.E. 23956 (PER CERTIFICATE OF CORRECTION) IN TOP OF CURB.

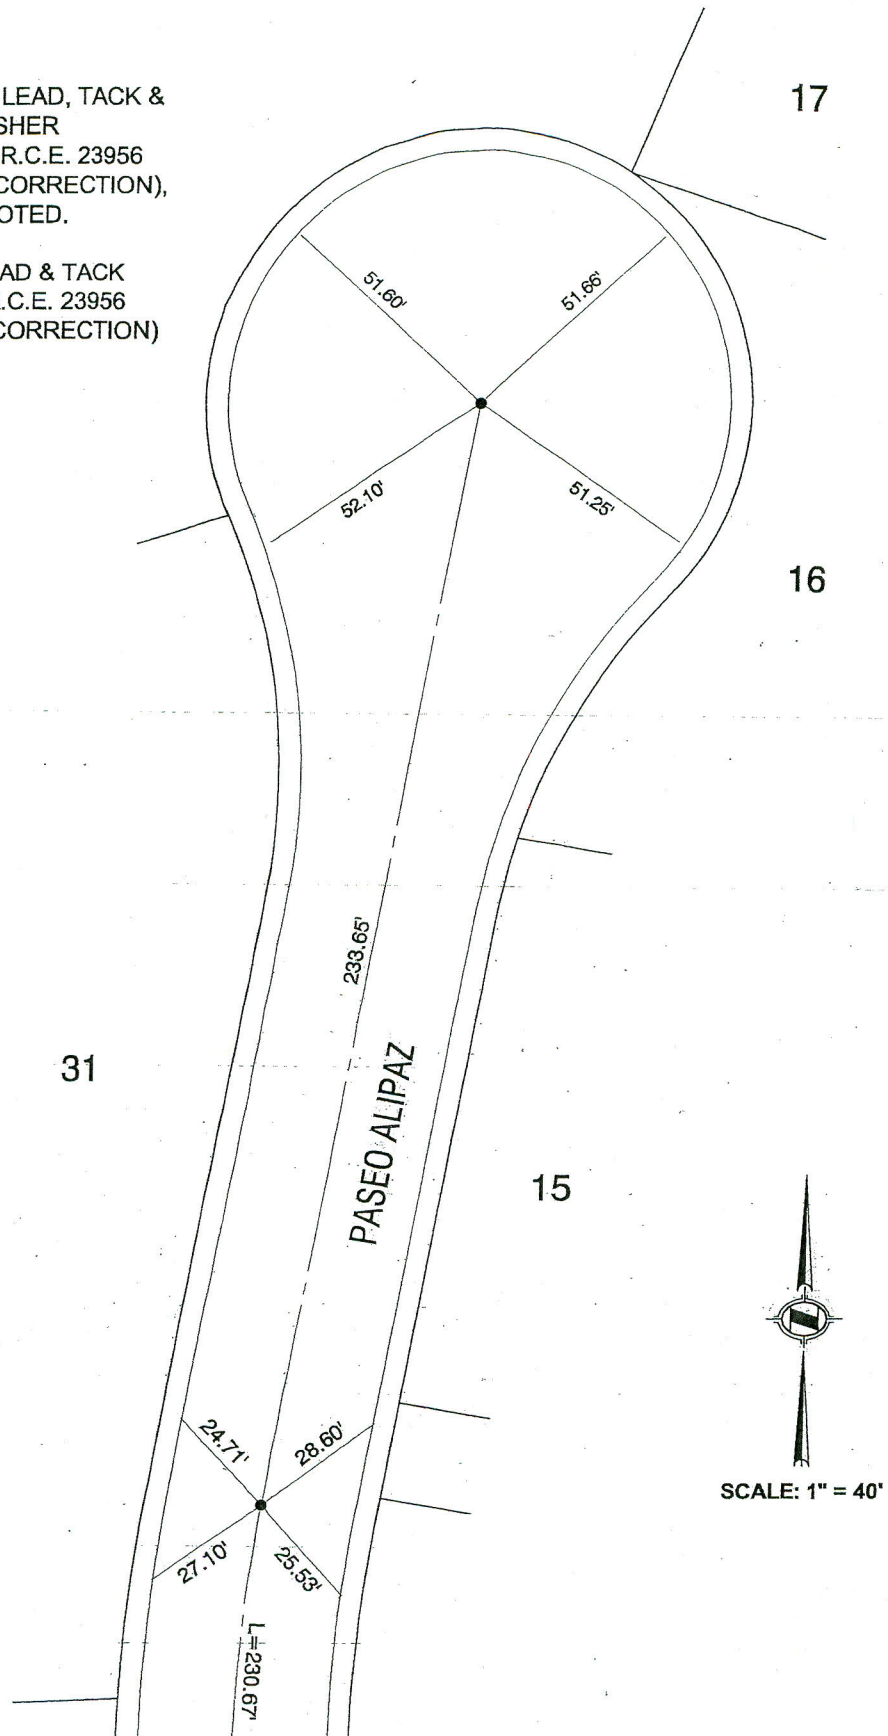

SEE PAGE 3


HUNSAKER & ASSOCIATES, INC.
 LAND SURVEYOR: RORY WILLIAMS L.S.6654

04-14-00

MONUMENT NOTES

- SET 1" IRON PIPE OR LEAD, TACK & TAG OR 8" SPIKE & WASHER STAMPED L.S. 6654 OR R.C.E. 23956 (PER CERTIFICATE OF CORRECTION), UNLESS OTHERWISE NOTED.

ALL TIE POINTS ARE LEAD & TACK
 TAGGED L.S. 6654 OR R.C.E. 23956
 (PER CERTIFICATE OF CORRECTION)
 IN TOP OF CURB.

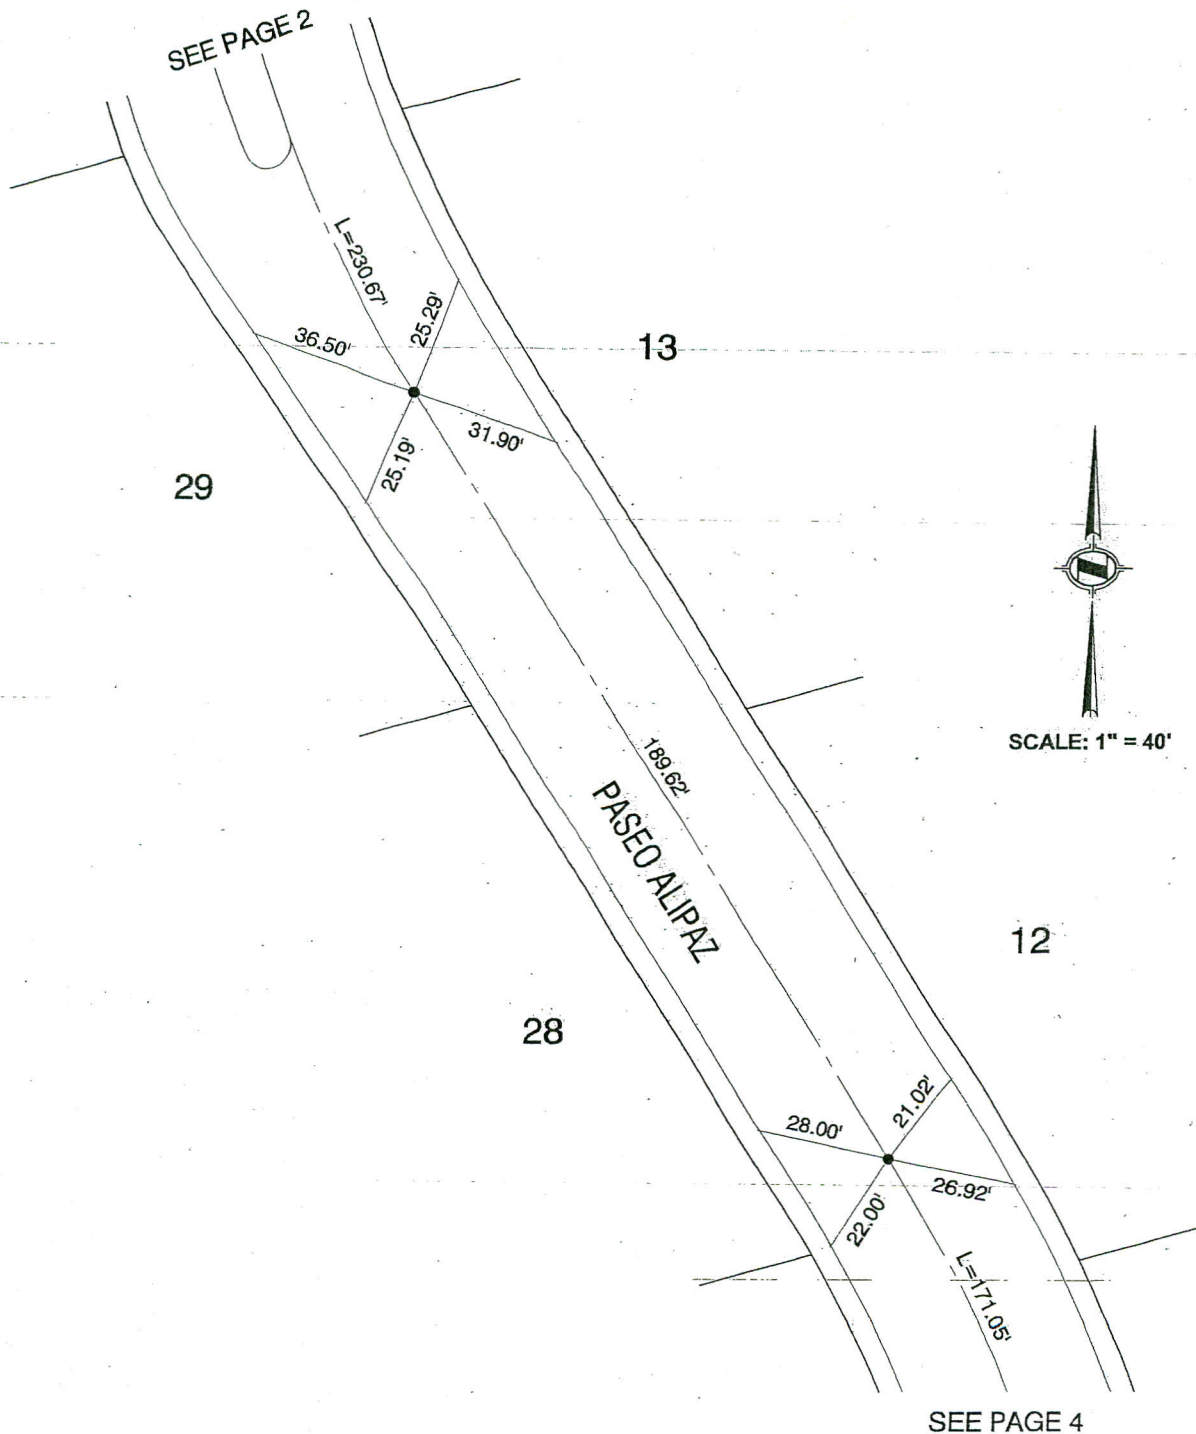


04-14-00

MONUMENT NOTES

- SET 1" IRON PIPE OR LEAD, TACK & TAG OR 8" SPIKE & WASHER STAMPED L.S. 6654 OR R.C.E. 23956 (PER CERTIFICATE OF CORRECTION), UNLESS OTHERWISE NOTED.

ALL TIE POINTS ARE LEAD & TACK
TAGGED L.S. 6654 OR R.C.E. 23956
(PER CERTIFICATE OF CORRECTION)
IN TOP OF CURB.

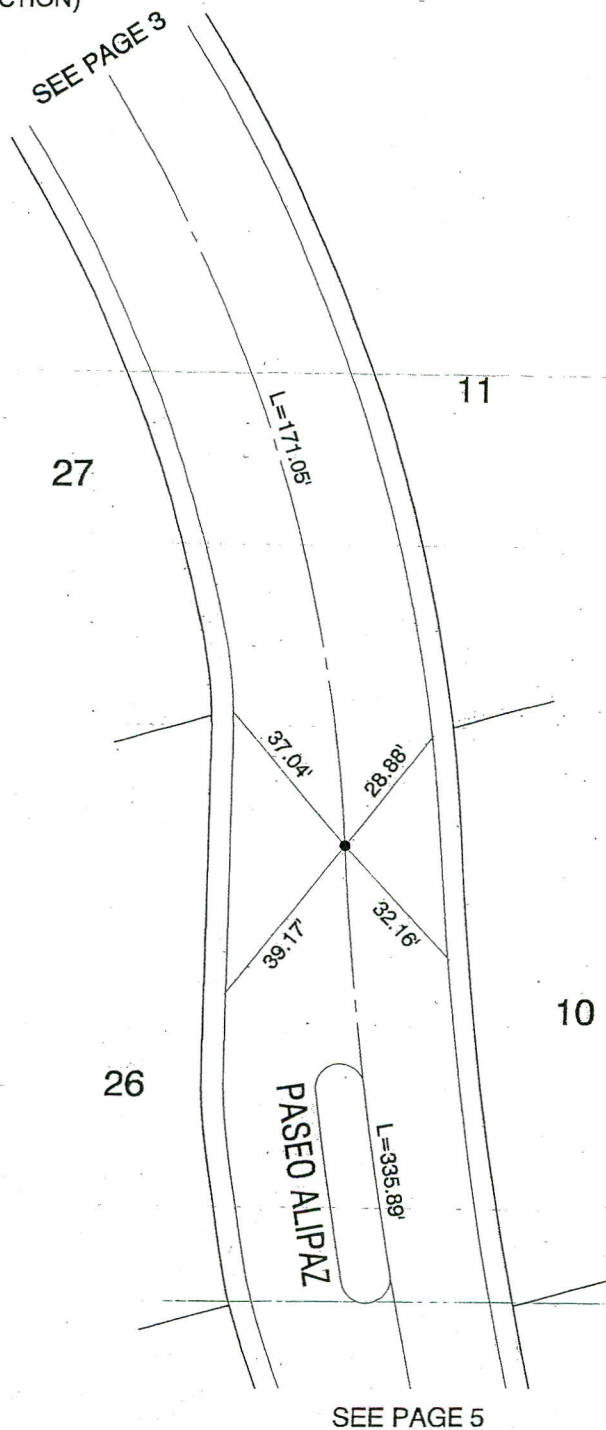


HUNSAKER & ASSOCIATES, INC.
 LAND SURVEYOR: RORY WILLIAMS L.S.6654

04-14-00

MONUMENT NOTES

- SET 1" IRON PIPE OR LEAD, TACK & TAG OR 8" SPIKE & WASHER
 STAMPED L.S. 6654 OR R.C.E. 23956
 (PER CERTIFICATE OF CORRECTION),
 UNLESS OTHERWISE NOTED.

ALL TIE POINTS ARE LEAD & TACK
 TAGGED L.S. 6654 OR R.C.E. 23956
 (PER CERTIFICATE OF CORRECTION)
 IN TOP OF CURB.

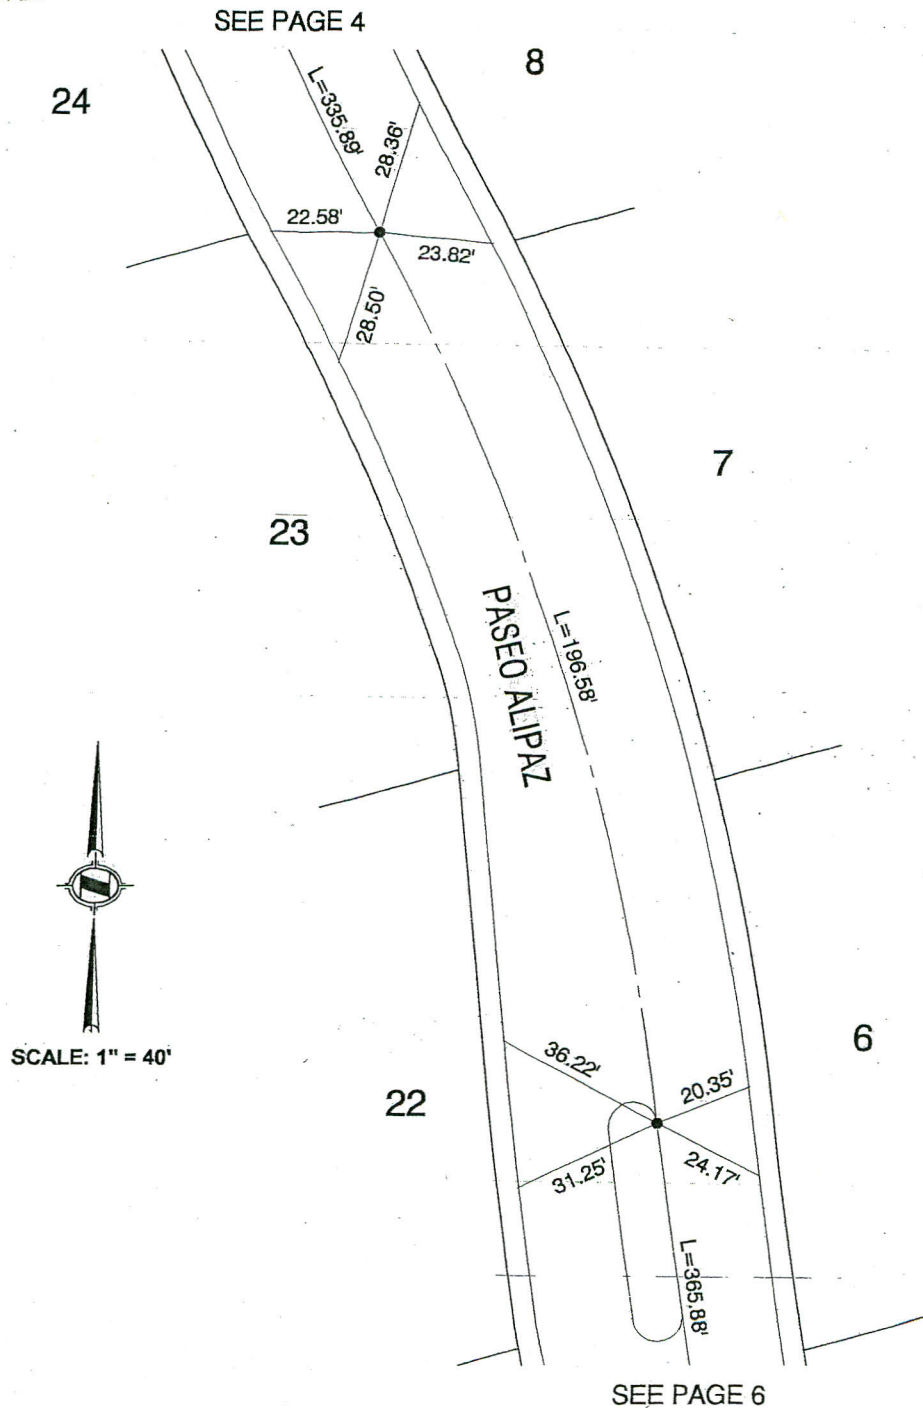


HUNSAKER & ASSOCIATES, INC.
LAND SURVEYOR: RORY WILLIAMS L.S.6654

04-14-00

MONUMENT NOTES

- SET 1" IRON PIPE OR LEAD, TACK & TAG OR 8" SPIKE & WASHER STAMPED L.S. 6654 OR R.C.E. 23956 (PER CERTIFICATE OF CORRECTION), UNLESS OTHERWISE NOTED.

ALL TIE POINTS ARE LEAD & TACK TAGGED L.S. 6654 OR R.C.E. 23956 (PER CERTIFICATE OF CORRECTION) IN TOP OF CURB.

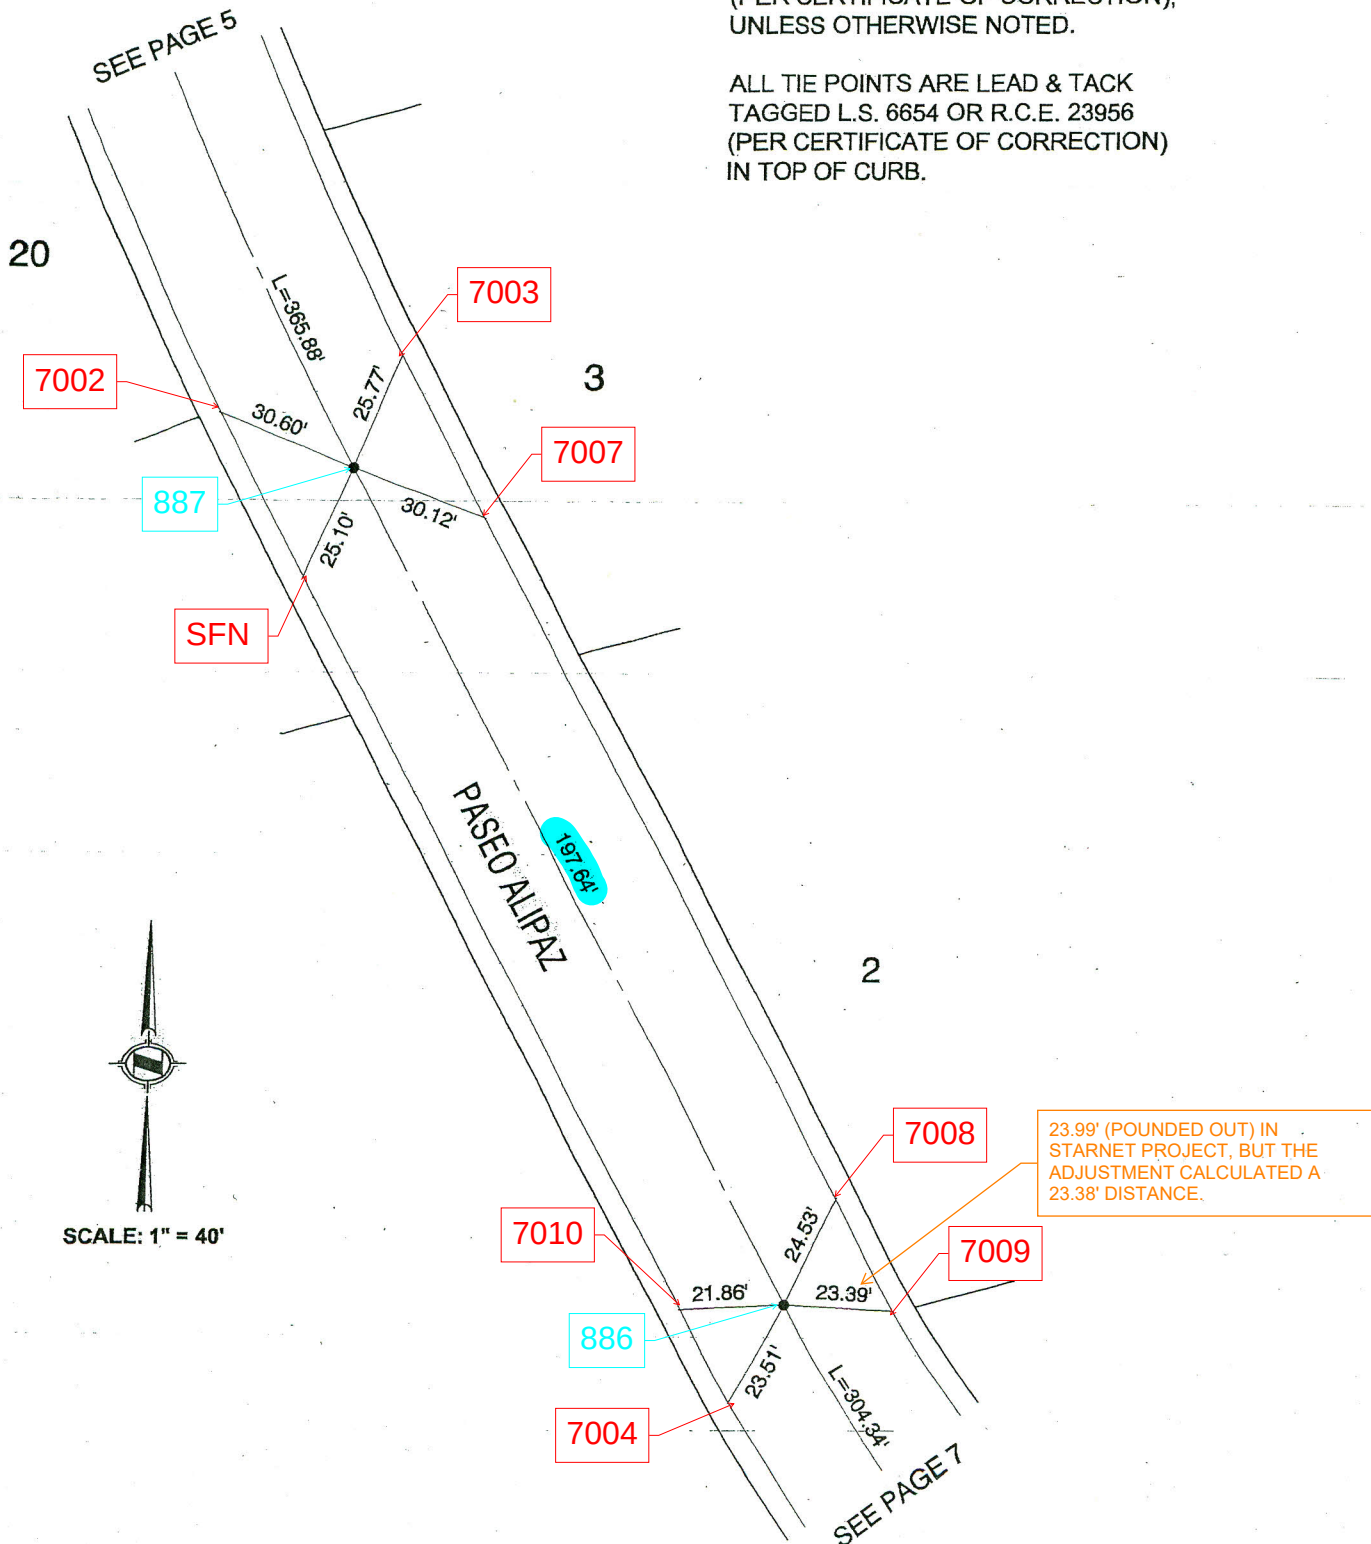


HUNSAKER & ASSOCIATES, INC.
LAND SURVEYOR: RORY WILLIAMS L.S.6654

04-14-00

MONUMENT NOTES

- SET 1" IRON PIPE OR LEAD, TACK & TAG OR 8" SPIKE & WASHER
STAMPED L.S. 6654 OR R.C.E. 23956
(PER CERTIFICATE OF CORRECTION),
UNLESS OTHERWISE NOTED.

ALL TIE POINTS ARE LEAD & TACK
TAGGED L.S. 6654 OR R.C.E. 23956
(PER CERTIFICATE OF CORRECTION)
IN TOP OF CURB.

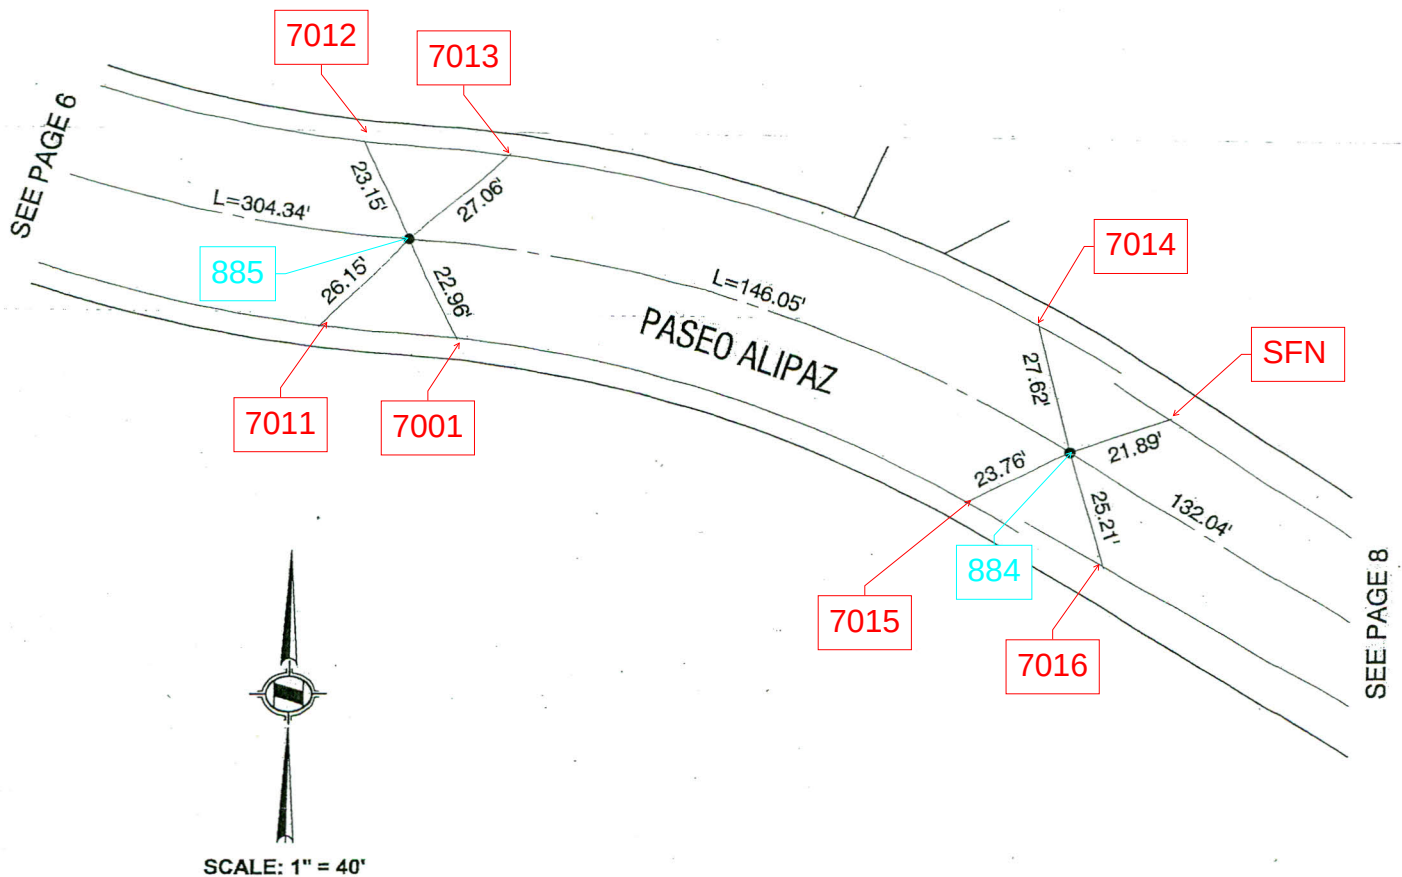


HUNSAKER & ASSOCIATES, INC.
LAND SURVEYOR: RORY WILLIAMS L.S.6654

04-14-00

MONUMENT NOTES

• SET 1" IRON PIPE OR LEAD, TACK &
TAG OR 8" SPIKE & WASHER
STAMPED L.S. 6654 OR R.C.E. 23956
(PER CERTIFICATE OF CORRECTION),
UNLESS OTHERWISE NOTED.

ALL TIE POINTS ARE LEAD & TACK
TAGGED L.S. 6654 OR R.C.E. 23956
(PER CERTIFICATE OF CORRECTION)
IN TOP OF CURB.

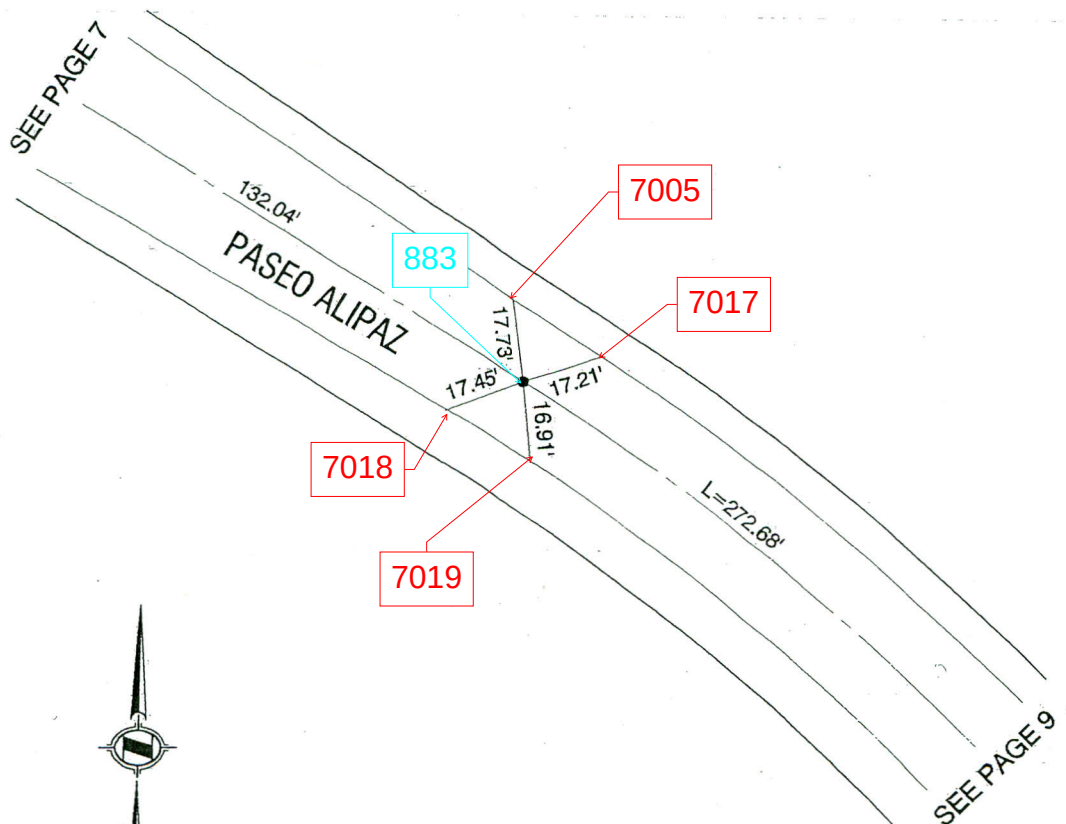

SCALE: 1" = 40'

04-14-00

● SET 1" IRON PIPE OR LEAD, TACK & TAG OR 8" SPIKE & WASHER
STAMPED L.S. 6654 OR R.C.E. 23956
(PER CERTIFICATE OF CORRECTION),
UNLESS OTHERWISE NOTED.

SEE PAGE 8

L=272.68'

TRACT BOUNDARY

7006

7022

7020

882

7021

PASEO ALIPAZ

215.68'

SEE PAGE 10

19.62'

18.72'

17.42'

20.87'



SCALE: 1" = 40'


HUNSAKER & ASSOCIATES, INC.
LAND SURVEYOR: RORY WILLIAMS L.S.6654

04-14-00

MONUMENT NOTES

- SET 1" IRON PIPE OR LEAD, TACK & TAG OR 8" SPIKE & WASHER
STAMPED L.S. 6654 OR R.C.E. 23956
(PER CERTIFICATE OF CORRECTION),
UNLESS OTHERWISE NOTED.

ALL TIE POINTS ARE LEAD & TACK
TAGGED L.S. 6654 OR R.C.E. 23956
(PER CERTIFICATE OF CORRECTION)
IN TOP OF CURB.

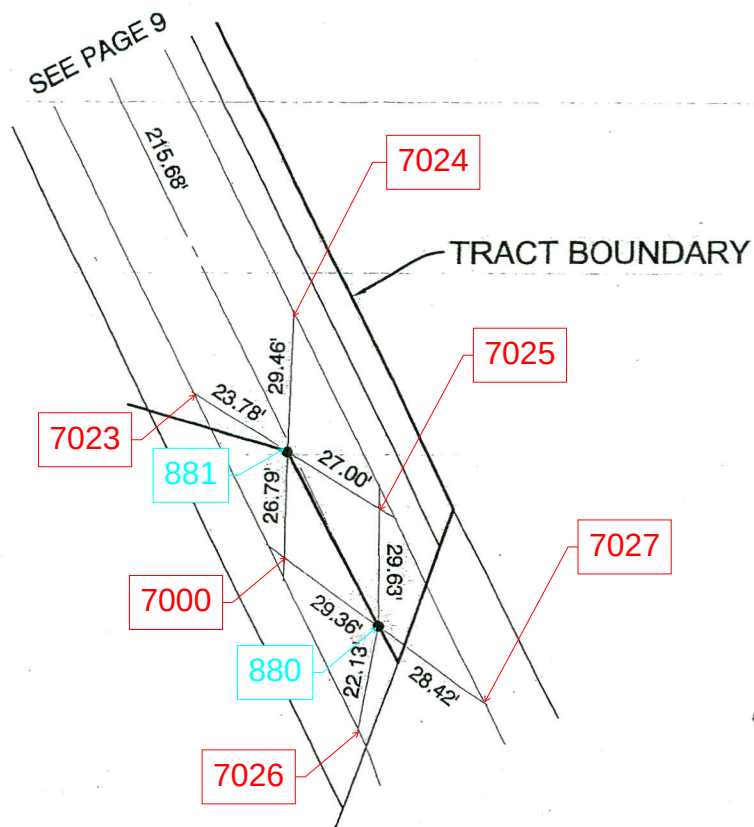

SCALE: 1" = 40'