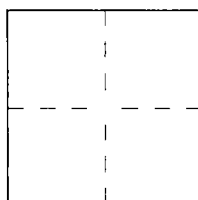


# CORNER RECORD

Document Number 2006-0350 BCity of Costa Mesa County of Orange, CaliforniaBrief Legal Description El Camino Drive @ El Rio Circle

## CORNER TYPE

Government Corner ☐ Control ☒  
Meander ☐ Property ☐  
Rancho ☐ Other ☐  
Date of Survey 01/09/2006

## COORDINATES (Optional)

N. \_\_\_\_\_  
E. \_\_\_\_\_  
Zone \_\_\_\_\_ NAD27 ☐ NAD83 ☐  
NAD83 Epoch \_\_\_\_\_  
Elev. \_\_\_\_\_  
Vert. Datum: NGVD29 ☐ NAVD88 ☐  
Meas. Units: Metric ☐ Imperial ☐  
U.S. Survey foot ☐

Corner — Left as found ☐ Found and tagged ☐ Established ☐ Reestablished ☒ Rebuilt ☐

Identification and type of corner found; Evidence used to identify or procedure used to establish or reestablish the corner:

Set per Corner Record 2006-0037A

A description of the physical condition of the monument as found and as set or reset: \_\_\_\_\_


These ties are for the purpose of perpetuating the found monumentation. No claim is  
made as to the relationship of the points or lines shown hereon to true boundary locations.

## SURVEYOR'S STATEMENT

This Corner Record was prepared by me or under my direction in conformance with  
the Land Surveyor's Act on March 24, 2006

Signed Betty L. Mills L.S. or R.C.E. No. 6970

## COUNTY SURVEYOR'S STATEMENT

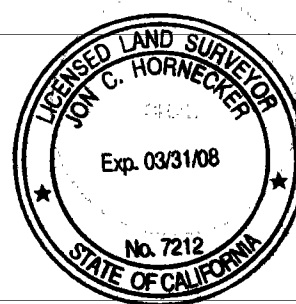This Corner Record was received APR 05 2006and examined and filed MAY 10 2006Signed Jon C. Hornecker L.S. or R.C.E. No. 7212Title DEPUTY COUNTY SURVEYOR

County Surveyor's Comment \_\_\_\_\_

SET FOUR 2.00' MAG NAIL &  
WASHERS (LS 6970) STRADLERS  
ACROSS MANHOLE TO DEFINE  
CENTERLINE INTERSECTION PER  
CORNER RECORD 2006-0037A  
1/9/2006

✕ FOUND CHIS "+" PER CORNER  
RECORD 2006-0037A

● FOUND L,T&T (LS 6970) PER  
CORNER REOCD 2006-0037A

POST CONSTRUCTION



NOTE: TIES ARE NOT TANGENT  
OVER UNLESS DESIGNATED BY A  
Φ SYMBOL. ALL TIES NOT SO  
SHOWN ARE SWING TIES.

